

3/18/81

PERMIT

SEWAGE DISPOSAL SYSTEM

MARYLAND STATE DEPARTMENT OF HEALTH*

HOWARD COUNTY

ELLICOTT CITY

DISTRICT 5th

INDEXED

DATE 3/16/81

Jack Fyock

IS PERMITTED TO INSTALL ALTER X

ADDRESS 13775 Triadelphia Road, Glenelg, Md. 21737 PHONE 988-9270

SUBDIVISION _____ ROAD Route 32 - across from LOT _____
Hall Shop Road

PROPERTY OWNER Mr. Rose

ADDRESS Route 32, Clarksville, Md.

SPECIFICATIONS 3 BR

SEPTIC TANK CAPACITY 1000 GALLONS

DRAIN FIELD _____ DEPTH _____ FEET, BOTTOM AREA _____ SQ. FT.

DEEP TRENCH _____ DEPTH _____ FEET, BOTTOM AREA _____ SQ. FT.

SEEPAGE PITS _____ ABSORBENT SIDE-WALL AREA _____ SQ. FT.

INLET PIPE _____ FT. BELOW ORIGINAL GRADE. MAXIMUM DEPTH _____ FT. BELOW ORIGINAL GRADE

EFFECTIVE DEPTH AT _____ FT. BELOW ORIGINAL GRADE.

LOCATE DISPOSAL AREA _____ FT. FROM _____ LOT LINE AND _____ FT. FROM _____ LOT LINE AS SEEN WHEN
FACING LOT FROM

REPAIR - Call for an appointment when ground is opened up and Sanitarian will
recommend the repair system.

DITCH 120 SQ FT PER BED ROOM
10 FT DEEP 7 FT STONE

PLANS APPROVED BY Palmer F. Wine DATE 3/16/81

COVER NO WORK UNTIL INSPECTED AND APPROVED.

NEITHER THE HOWARD COUNTY COUNCIL NOR THE HEALTH DEPARTMENT IS RESPONSIBLE FOR THE SUCCESSFUL OPERATION OF ANY SYSTEM.

NOTE: IF TRENCH IS USED CALL FOR INSPECTION BEFORE PLACING GRAVEL IN TRENCH.

NOTE: NO DRY WELL SHALL EXCEED 15 FOOT IN DIAMETER.

NOTE: ALL PIPE FROM HOUSE TO DISPOSAL AREA MUST BE CAST IRON.

PERMIT VOID AFTER THREE YEARS.


NOTE: INSTALL STAND PIPE ON SEPTIC TANK AND DRY WELL. STAND PIPES MUST BE 6 INCHES IN DIAMETER. CAST IRON, CONCRETE OR TERRA
COTTA ACCEPTED.

BLDG. PERMIT SIGNED
AND RETURNED 4/8/81

Serial # 46062
Pool

*INSTALLER IS RESPONSIBLE FOR OBTAINING FINAL APPROVAL ON THIS PERMIT.

A 31229

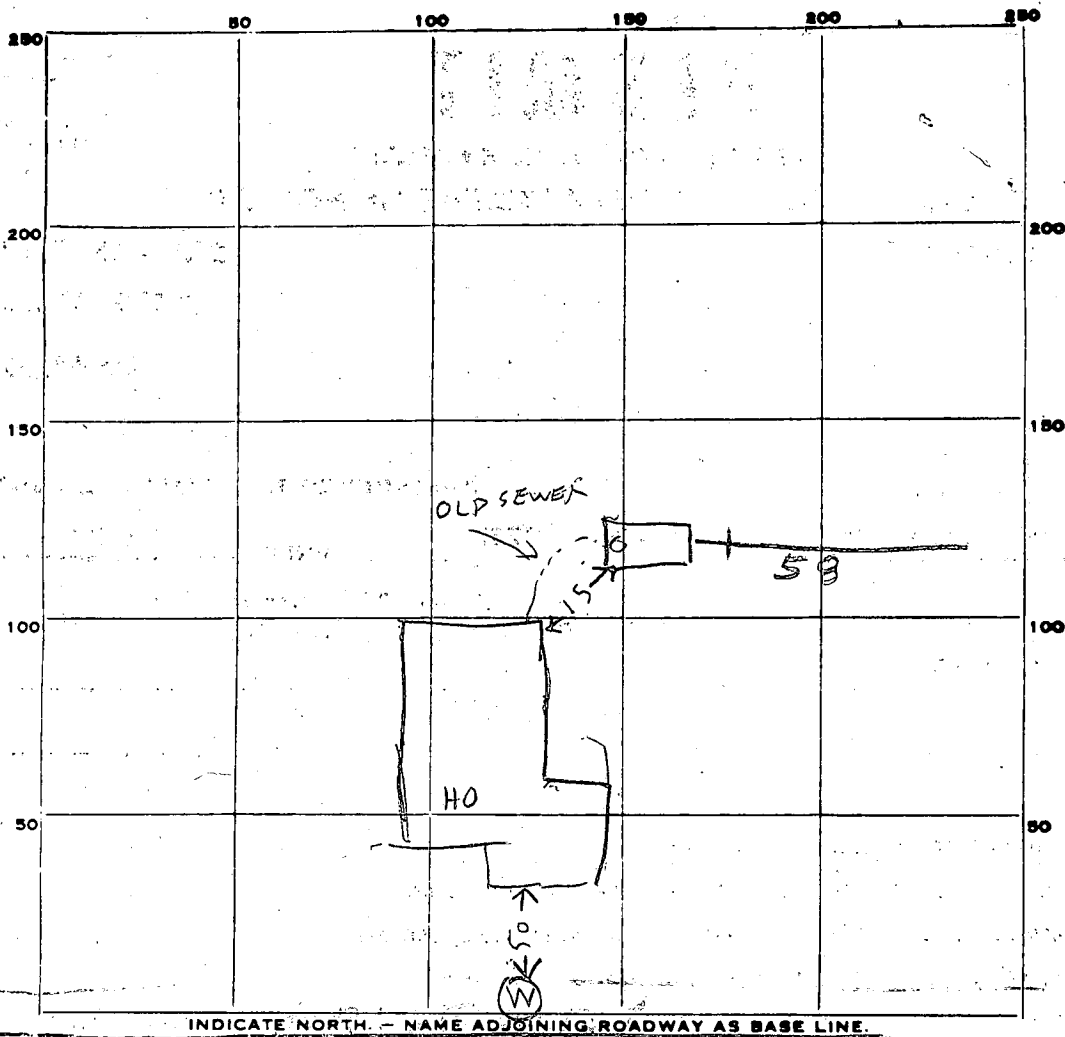

58
7
406

PERMIT CARD

SEPTIC TANK, LEVEL OK concrete 1000

CLEANOUTS ST
OK

DISTRIBUTION BOX, LEVEL

TRENCH
TILE FIELD, DEPTH 10 1/2 FT. TRENCH WIDTH 2 FT.

GRAVEL DEPTH 7 1/2 IN. TOTAL LENGTH 58 FT.

NUMBER OF TRENCHES 1 TOTAL BOTTOM AREA 429

SEEPAGE PITS, INSIDE DIAMETER _____ FT. DEPTH BELOW INLET _____ FT.


ABSORBENT AREA _____ SQ. FT.

REMARKS 3/10/81 ¹¹⁵⁰ TOP 3 FT CLAY BOT 7 1/2 FT SAND IN DITCH
INLET TO DITCH 3 FT BELOW GRADE ADD STONE
3/10/81 ¹²³⁰ - STONE ADDED TO DITCH

DATE SYSTEM APPROVED 3/10/81 INSPECTOR Raymond Hodges



MARYLAND POOLS

POOL ELEVATION: TOP OF COPING 6" ABOVE GROUND @ BM

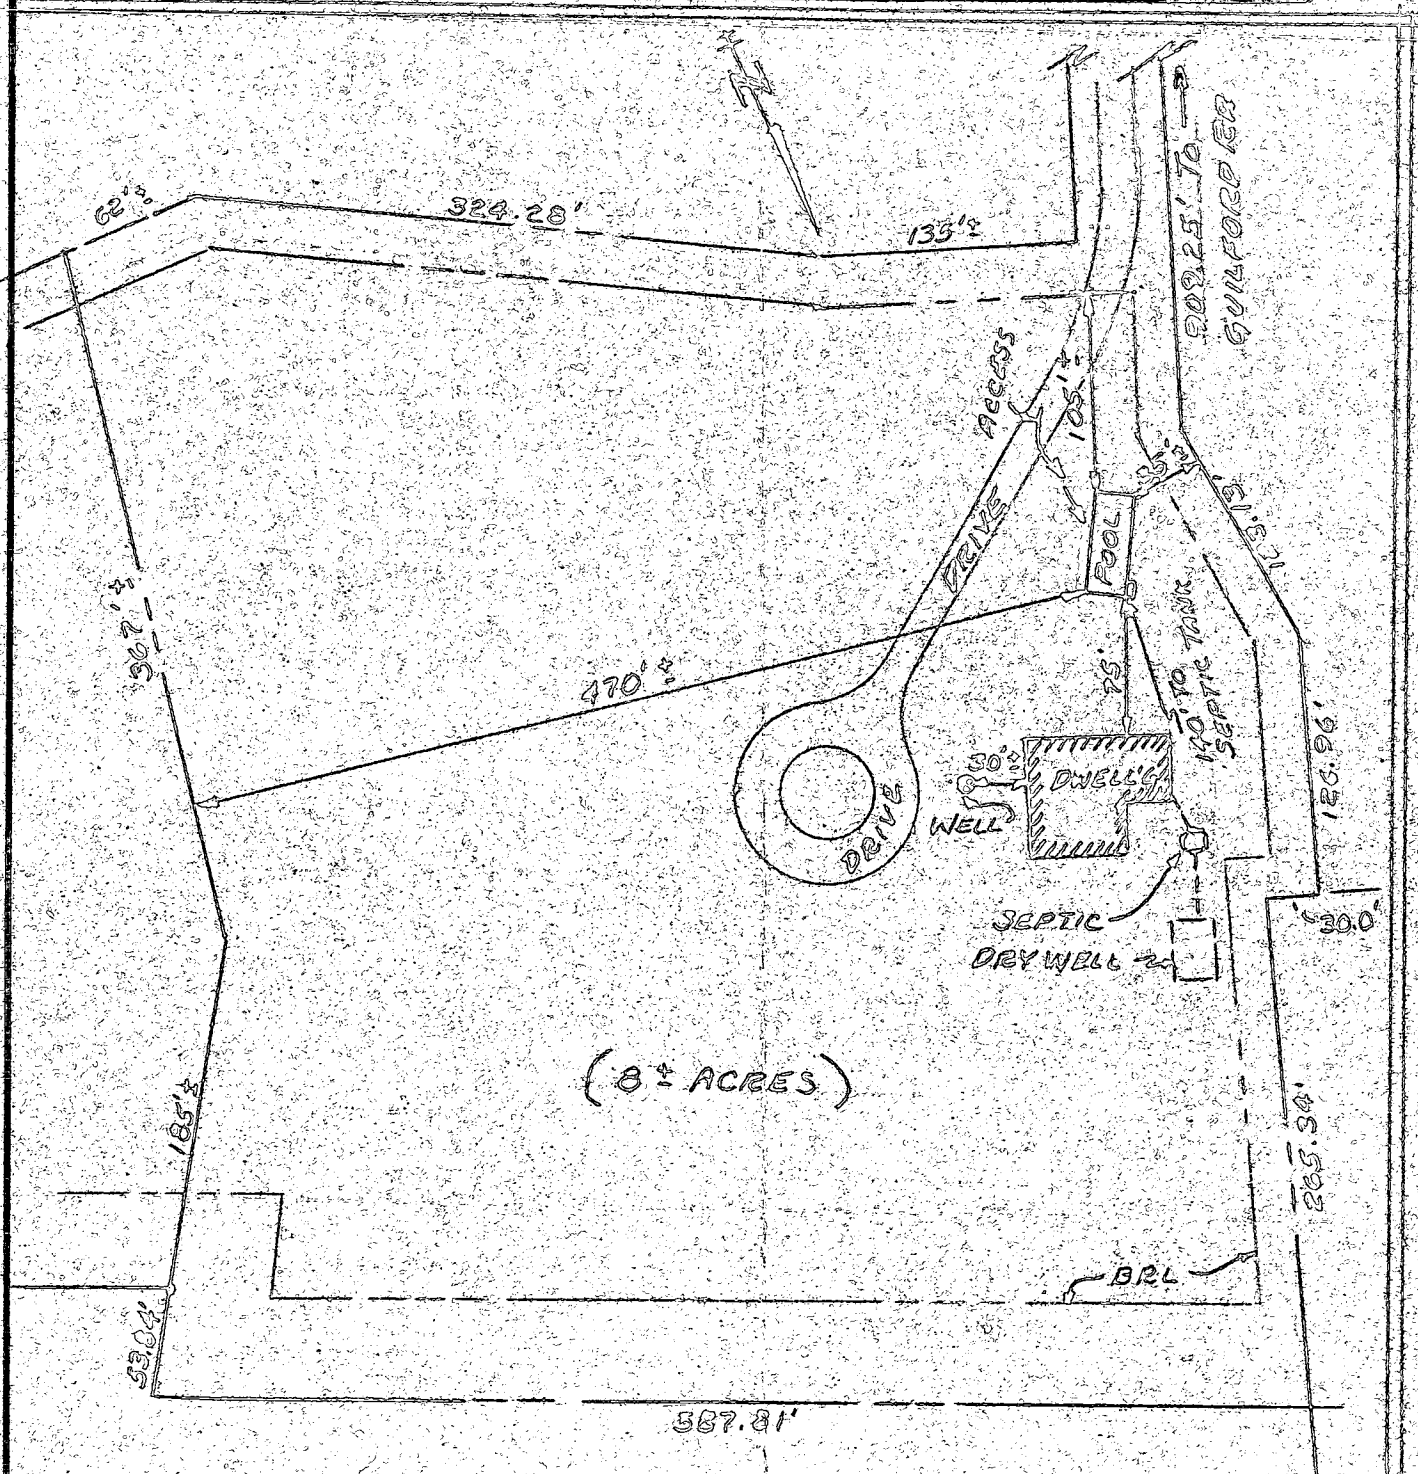

DRIVE
ACCESS

TROTTER ROAD

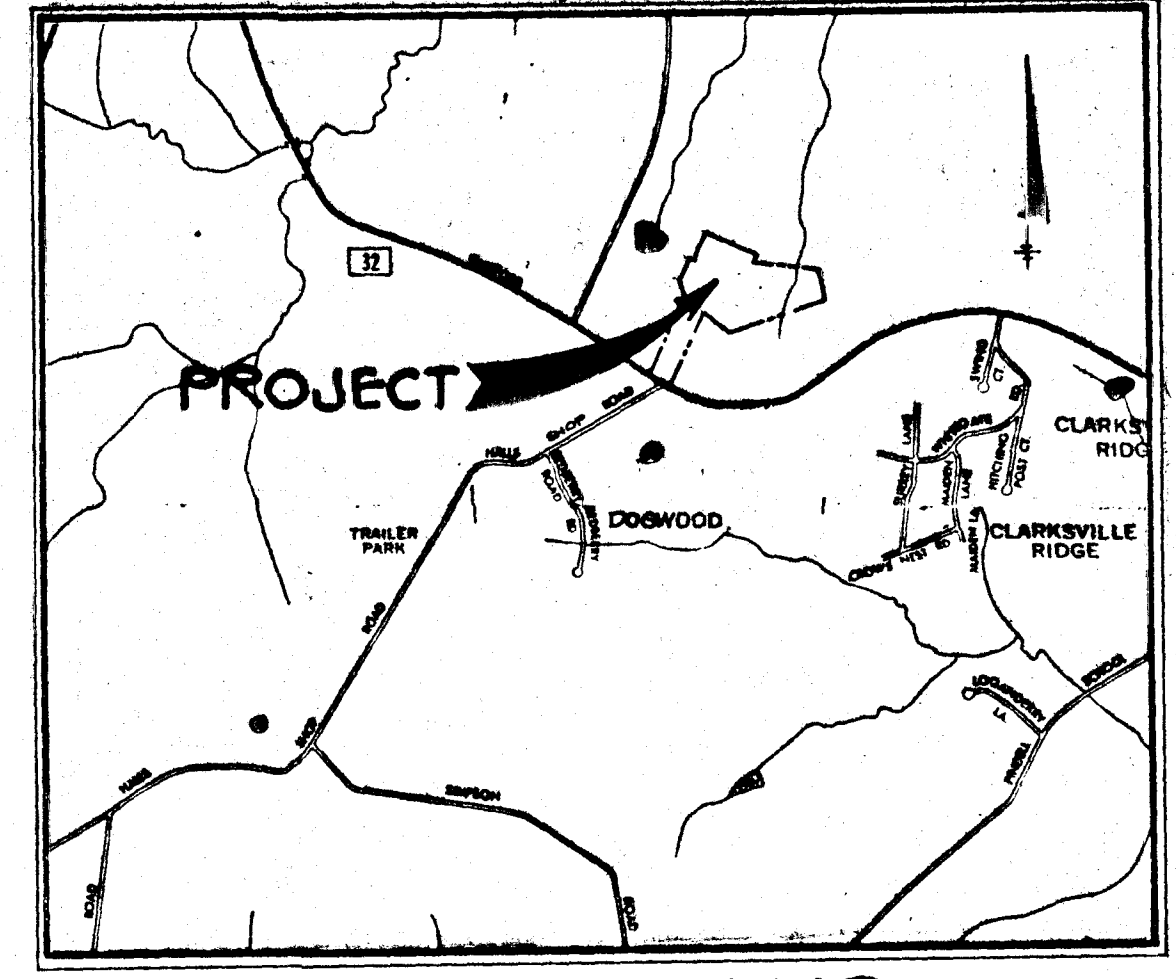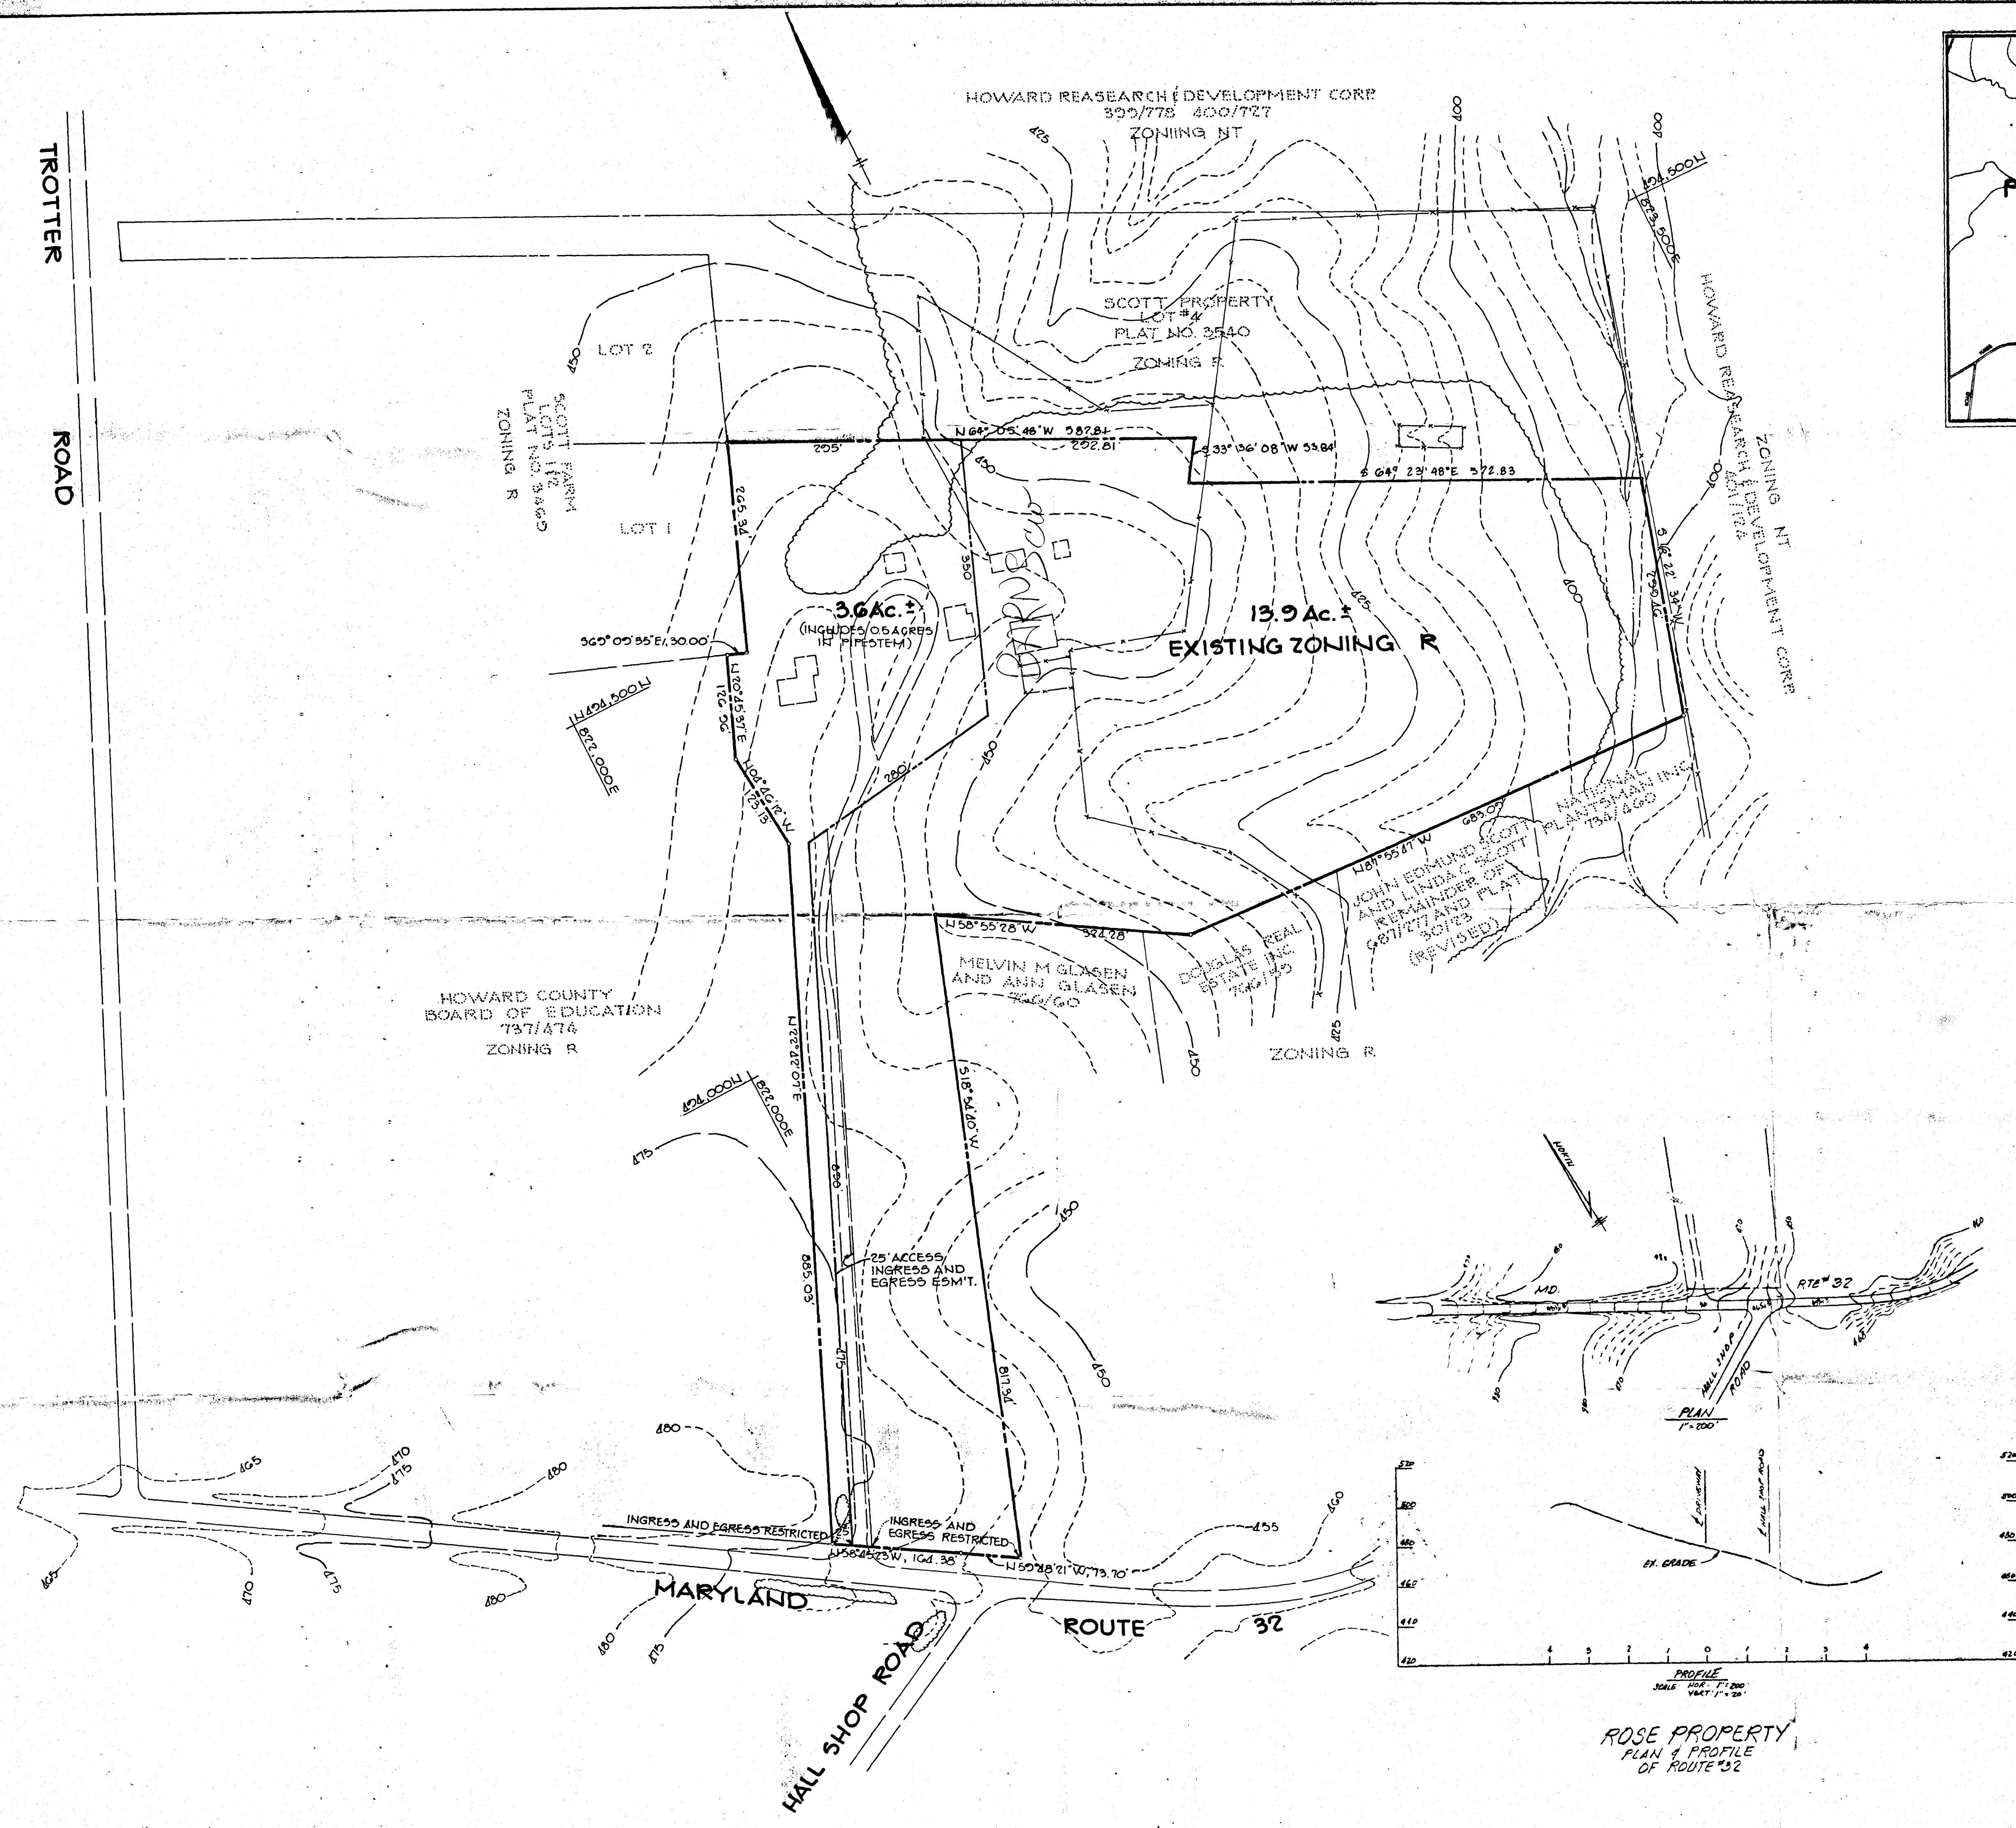

VICINITY MAP
SCALE: 1" = 2,000'

NOTES:
1) PRIVATE WATER AND PRIVATE SEWER TO BE PROVIDED.

RECEIVED
AUG 16 1983
DIVISION OF LAND DEVELOPMENT
OF HOWARD COUNTY

DATE	NO.	REVISION
OWNER	SAMUEL G. & EMILY G. ROSE G701 ROUTE # 32 CLARKSVILLE, MARYLAND 21020	
DEVELOPER:	RICHARD J. WILKINSON EQUITABLE BANK CENTER COLUMBIA, MARYLAND 21044	
PROJECT:	ROSE PROPERTY	
AREA	FIFTH ELECTION DISTRICT HOWARD COUNTY, MARYLAND TAX MAP # 35 PARCEL # 353	
TITLE:	SKETCH PLAN	
THE RIEMER GROUP, INC. The Riemer Group, Inc. A Land Planning, Design & Civil Engineering Firm 8659 Baltimore National Pike, Ellicott City, Maryland, 21043 301 461-2690		
DATE	DESIGNED BY: M.G.R.	
	DRAWN BY: L.J.D.	
	PROJECT NO: 002900	
	DATE: AUGUST 4, 1983	
	SCALE: 1" = 100'	
	DRAWING NO. 1 OF 1	