

4/20/81 ✓
before lunch if possible

4/20/81 FILE APPROVED C.B.S.

PERMIT

SEWAGE DISPOSAL SYSTEM

MARYLAND STATE DEPARTMENT OF HEALTH*

HOWARD COUNTY

02-21317

ELLICOTT CITY

DISTRICT 3rd.

INDEXED

DATE 4/9/81

P 31311
A REPAIR

Jack Fyock IS PERMITTED TO INSTALL ALTER X

ADDRESS 13775 Triadelphia Road, Glenelg, Maryland 21737 PHONE 988-9270

SUBDIVISION _____ ROAD 2629 Turf Valley Road LOT _____

PROPERTY OWNER Glen Mitchel

ADDRESS 2629 Turf Valley Road

SPECIFICATIONS

SEPTIC TANK CAPACITY _____ GALLONS
DRAIN FIELD _____ DEPTH _____ FEET, BOTTOM AREA _____ SQ. FT.
DEEP TRENCH DEPTH 11 1/2 FEET, BOTTOM AREA _____ SQ. FT.
SEEPAGE PITS _____ ABSORBENT SIDE-WALL AREA 400⁺ SQ. FT.
INLET PIPE 3 1/2 FT. BELOW ORIGINAL GRADE, MAXIMUM DEPTH 11 1/2 FT. BELOW ORIGINAL GRADE
EFFECTIVE DEPTH AT 3 1/2 FT. BELOW ORIGINAL GRADE.

⊗ LOCATE DISPOSAL AREA _____ FT. FROM _____ LOT LINE AND _____ FT. FROM _____ LOT LINE AS SEEN WHEN FACING LOT FROM _____

REPAIR - CALL FOR INSPECTION WHEN GROUND IS OPENED UP SO SANITARIAN CAN RECOMMEND

REPAIR. 4/20/81 ⊗ CHECKED - RECOMMEND - TRENCH IN AREA OF DRAWING ON BACK - DUE TO WATER LINE ON LEFT OF EXISTING DRY WELL AND TOPO OF LOT.

PLANS APPROVED BY Palem F. Wine C.B.S. DATE 4/9/81


COVER NO WORK UNTIL INSPECTED AND APPROVED.

NEITHER THE HOWARD COUNTY COUNCIL NOR THE HEALTH DEPARTMENT IS RESPONSIBLE FOR THE SUCCESSFUL OPERATION OF ANY SYSTEM.

- ⊗ NOTE: IF TRENCH IS USED CALL FOR INSPECTION BEFORE PLACING GRAVEL IN TRENCH.
- NOTE: NO DRY WELL SHALL EXCEED 15 FOOT IN DIAMETER.
- NOTE: ALL PIPE FROM HOUSE TO DISPOSAL AREA MUST BE CAST IRON.
- PERMIT VOID AFTER THREE YEARS.
- NOTE: INSTALL STAND PIPE ON SEPTIC TANK AND DRY WELL. STAND PIPES MUST BE 6 INCHES IN DIAMETER. CAST IRON, CONCRETE OR TERRAZO ACCEPTED.

*INSTALLER IS RESPONSIBLE FOR OBTAINING FINAL APPROVAL ON THIS PERMIT.

P 31311

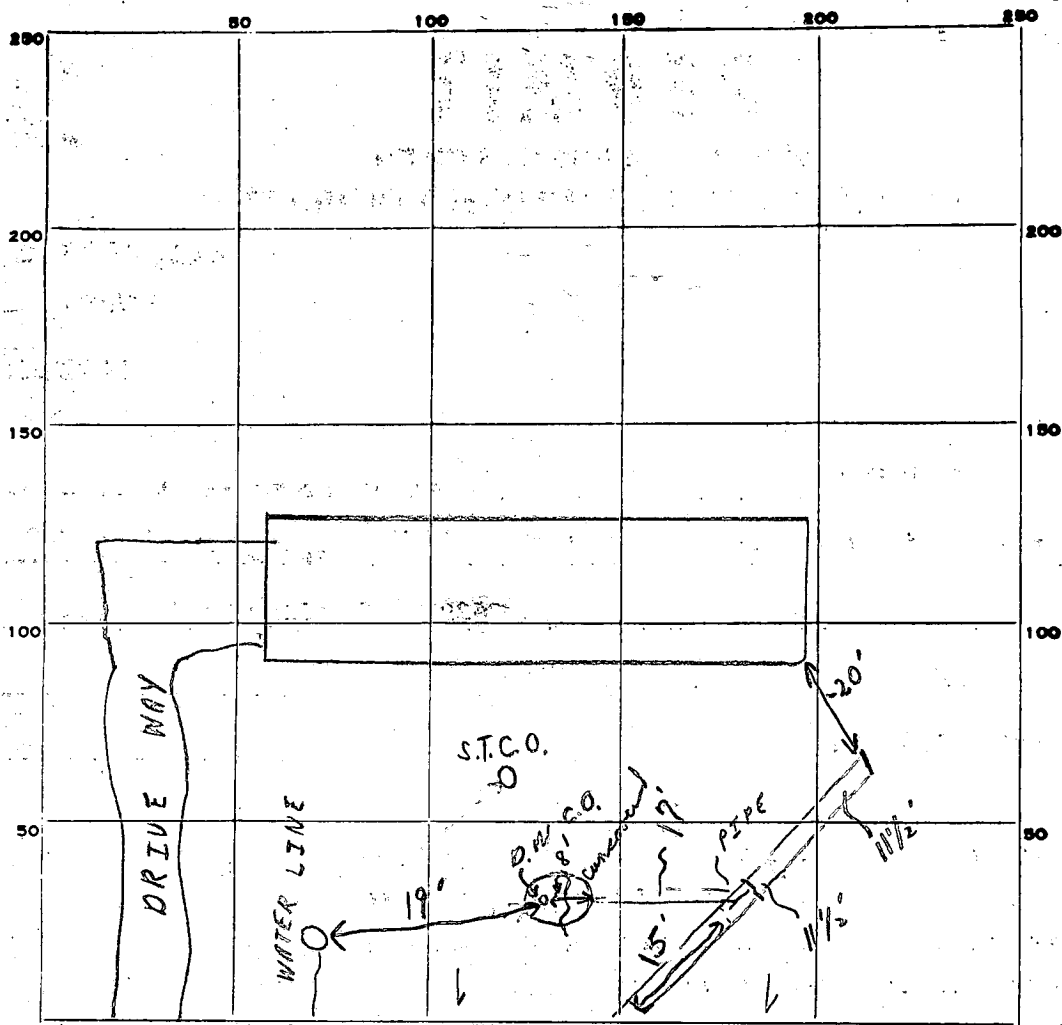

INDICATE NORTH. - NAME ADJOINING ROADWAY AS BASE LINE.
TURF VALLEY ROAD

PERMIT CARD

SEPTIC TANK, LEVEL

CLEANOUTS

DISTRIBUTION BOX, LEVEL

TILE FIELD, DEPTH 1 1/2 FT. TRENCH WIDTH 2 FT.

GRAVEL DEPTH 9 IN. TOTAL LENGTH 58 FT.

NUMBER OF TRENCHES 1 TOTAL BOTTOM AREA _____

SEEPAGE PITS, INSIDE DIAMETER _____ FT. DEPTH BELOW INLET _____ FT.

ABSORBENT AREA 464 SQ. FT.

REMARKS 4/20/81(N) CHECKED - PART OF TRENCH - 24' STONE IN, REMAINDER
OR FOR STONE. (2) SYSTEM INCOMPLETE. TRENCH TO 2 1/2' OF
SURFACE AVERAGE, NEED PAPER ON TRENCH, (3) SYSTEM COMPLETE.
 C.B.S. C.B.S. C.B.S.

DATE SYSTEM APPROVED 4/20/81

INSPECTOR C.B. Stresker