

PERMIT

SEWAGE DISPOSAL SYSTEM

MARYLAND STATE DEPARTMENT OF HEALTH

HOWARD COUNTY

04-312465

ELLICOTT CITY

DISTRICT 4th

DATE

INDEXED

Page 1 of 2 FILE

6/19/81

P 31368

APPROVED - C.B.V.

A Repair

Arnold Septic Tank Service IS PERMITTED TO INSTALL ALTER X

ADDRESS Jacobs Road, Mt. Airy, Md. 21771 PHONE 795-7873

SUBDIVISION ROAD 916 Watersville Rd. LOT

PROPERTY OWNER E. H. Crocker

ADDRESS 916 Watersville Rd, Mt. Airy, Md. Ph. 442-3038

SPECIFICATIONS

SEPTIC TANK CAPACITY 1000 GALLONS

DRAIN FIELD DEPTH FEET, BOTTOM AREA SQ. FT.

DEEP TRENCH DEPTH FEET, BOTTOM AREA SQ. FT.

(1) SEEPAGE PITS 15'x15' ABSORBENT SIDE-WALL AREA 480 SQ. FT.

INLET PIPE 3 1/2' FT. BELOW ORIGINAL GRADE. MAXIMUM DEPTH 11'-12' FT. BELOW ORIGINAL GRADE [8' EFFECTIVE VERTICAL]

EFFECTIVE DEPTH AT 3 1/2' FT. BELOW ORIGINAL GRADE.

LOCATE DISPOSAL AREA 24 FT. FROM PROPOSED REAR LOT LINE AND 10 FT. FROM PROPOSED RIGHT LOT LINE AS SEEN WHEN

FACING LOT FROM WATERSVILLE ROAD [NOTE: #2 HOLE TO BE USED]

Repair

(See page 2)

PLANS APPROVED BY (See page 2) DATE (See page 2)

COVER NO WORK UNTIL INSPECTED AND APPROVED.

NEITHER THE HOWARD COUNTY COUNCIL NOR THE HEALTH DEPARTMENT IS RESPONSIBLE FOR THE SUCCESSFUL OPERATION OF ANY SYSTEM.

NOTE: IF TRENCH IS USED CALL FOR INSPECTION BEFORE PLACING GRAVEL IN TRENCH.


NOTE: NO DRY WELL SHALL EXCEED 15 FOOT IN DIAMETER.

NOTE: ALL PIPE FROM HOUSE TO DISPOSAL AREA MUST BE CAST IRON.

PERMIT VOID AFTER THREE YEARS.

NOTE: INSTALL STAND PIPE ON SEPTIC TANK AND DRY WELL. STAND PIPES MUST BE 6 INCHES IN DIAMETER. CAST IRON, CONCRETE OR TERRA COTTA ACCEPTED.

*INSTALLER IS RESPONSIBLE FOR OBTAINING FINAL APPROVAL ON THIS PERMIT.

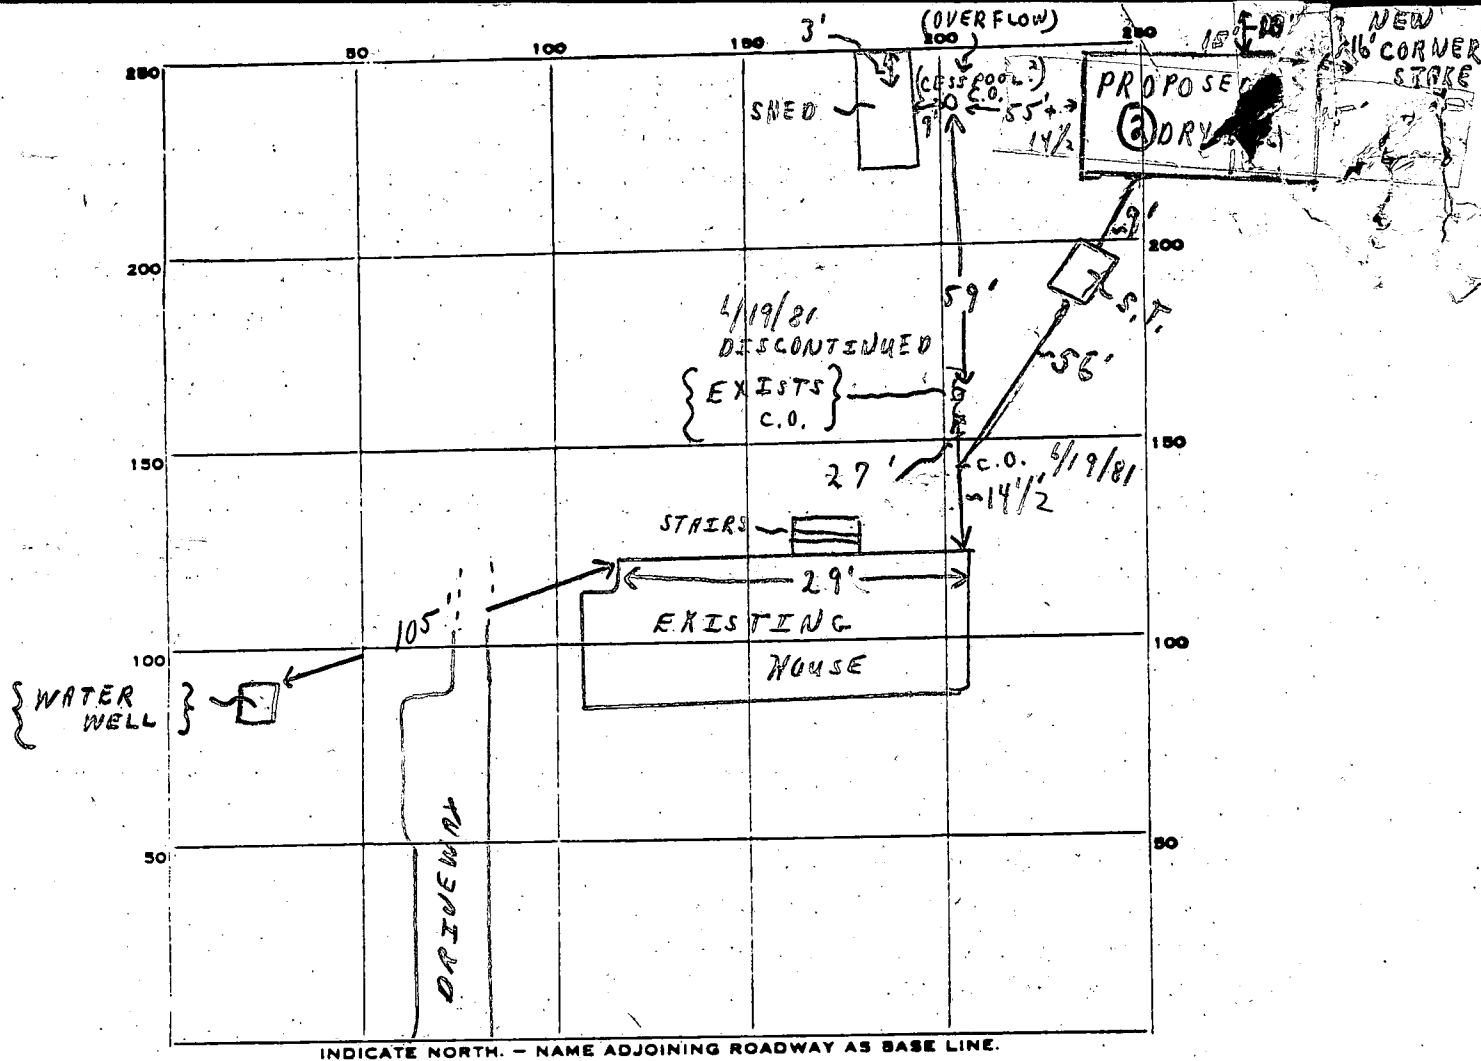

PERMIT CARD

6/19/81

5/12/81 before Noon
5/12/81
211

PERMIT

SEWAGE DISPOSAL SYSTEM

MARYLAND STATE DEPARTMENT OF HEALTH

HOWARD COUNTY

Page 2 of 2
P 31368
A Repair

ELLICOTT CITY

DISTRICT 4th

DATE 5/5/81

Arnold Septic Tank Service

IS PERMITTED TO INSTALL ALTER ☒

ADDRESS Jacobs Road, Mt. Airy, Md. 21771

PHONE 795-7873

SUBDIVISION ROAD 916 Watersville Road LOT

PROPERTY OWNER E. H. Crocker

ADDRESS 916 Watersville Road, Mt. Airy, Md.

Phone: 442-2038

SPECIFICATIONS

SEPTIC TANK CAPACITY 1000 GALLONS

DRAIN FIELD DEPTH FEET, BOTTOM AREA SQ. FT.

DEEP TRENCH DEPTH FEET, BOTTOM AREA SQ. FT.

(1) SEEPAGE PITS 15' X 15' ABSORBENT SIDE-WALL AREA 480 SQ. FT.

INLET PIPE 3 1/2' FT. BELOW ORIGINAL GRADE. MAXIMUM DEPTH 11'-12' FT. BELOW ORIGINAL GRADE

EFFECTIVE DEPTH AT 3 1/2' FT. BELOW ORIGINAL GRADE

LOCATE DISPOSAL AREA 24 FT. FROM { PROPOSED REAR LOT LINE AND 10 FT. FROM { PROPOSED RIGHT LOT LINE AS SEEN WHEN

FACING LOT FROM ROAD

[NOTE: (#2) Note TO BE USED]

REPAIR - Call for an appointment when ground is opened up and Sanitarian will

recommend the repair system. 1 DRY WELL ONLY DUE TO FIELD

CONDITIONS ; 15' X 15' SEE ABOVE

C.B. Thacker for

PLANS APPROVED BY Palmer F. Wine on 5/12/81

DATE 5/5/81

COVER NO WORK UNTIL INSPECTED AND APPROVED.

NEITHER THE HOWARD COUNTY COUNCIL NOR THE HEALTH DEPARTMENT IS RESPONSIBLE FOR THE SUCCESSFUL OPERATION OF ANY SYSTEM.

NOTE: IF TRENCH IS USED CALL FOR INSPECTION BEFORE PLACING GRAVEL IN TRENCH.

NOTE: NO DRY WELL SHALL EXCEED 15 FOOT IN DIAMETER.

NOTE: ALL PIPE FROM HOUSE TO DISPOSAL AREA MUST BE CAST IRON.

PERMIT VOID AFTER THREE YEARS.

NOTE: INSTALL STAND PIPE ON SEPTIC TANK AND DRY WELL. STAND PIPES MUST BE 6 INCHES IN DIAMETER. CAST IRON, CONCRETE OR TERRA COTTA ACCEPTED.

*INSTALLER IS RESPONSIBLE FOR OBTAINING FINAL APPROVAL ON THIS PERMIT.

