

7/6/81 app'd F.S.

31466

PERMIT

SEWAGE DISPOSAL SYSTEM

MARYLAND STATE DEPARTMENT OF HEALTH

HOWARD COUNTY

ELLICOTT CITY

DISTRICT _____

DATE _____

A.C. Myers

Indexed

IS PERMITTED TO INSTALL _____ ALTER _____

ADDRESS _____

PHONE _____

SUBDIVISION _____

Joseph A. Ciotola

ROAD _____

LOT _____

26

PROPERTY OWNER _____

3986 View Top Rd.

E.C. Md. 21043

ADDRESS _____

SPECIFICATIONS

SEPTIC TANK CAPACITY _____ GALLONS

DRAIN FIELD _____ DEPTH _____ FEET, BOTTOM AREA _____ SQ. FT.

DEEP TRENCH _____ DEPTH _____ FEET, BOTTOM AREA _____ SQ. FT.

SEEPAGE PITS _____ ABSORBENT SIDE-WALL AREA _____ SQ. FT.

INLET PIPE _____ FT. BELOW ORIGINAL GRADE, MAXIMUM DEPTH _____ FT. BELOW ORIGINAL GRADE

EFFECTIVE DEPTH AT _____ FT. BELOW ORIGINAL GRADE.

LOCATE DISPOSAL AREA _____ FT. FROM _____ LOT LINE AND _____ FT. FROM _____ LOT LINE AS SEEN WHEN

60 ft. facing lot from 10 ft. deep, 2 ft. wide with 6-6 1/2 ft of #2 steel
below perfect 4" diameter distribution pipe. Old system
trench must be disconnected. Trench must be inspected
before gravel is installed and also before covering any work
F. Skinner 7/4/81

PLANS APPROVED BY _____

DATE _____

COVER NO WORK UNTIL INSPECTED AND APPROVED.

NEITHER THE HOWARD COUNTY COUNCIL NOR THE HEALTH DEPARTMENT IS RESPONSIBLE FOR THE SUCCESSFUL OPERATION OF ANY SYSTEM.

NOTE: IF TRENCH IS USED CALL FOR INSPECTION BEFORE PLACING GRAVEL IN TRENCH.

NOTE: NO DRY WELL SHALL EXCEED 15 FOOT IN DIAMETER.

NOTE: ALL PIPE FROM HOUSE TO DISPOSAL AREA MUST BE CAST IRON.

PERMIT VOID AFTER THREE YEARS.

NOTE: INSTALL STAND PIPE ON SEPTIC TANK AND DRY WELL. STAND PIPES MUST BE 6 INCHES IN DIAMETER. CAST IRON, CONCRETE OR TERRA

COTTA ACCEPTED.

*INSTALLER IS RESPONSIBLE FOR OBTAINING FINAL APPROVAL ON THIS PERMIT.


HD - 23

BLDG. PERMIT SIGNED
AND RETURNED 9/28/83

Seign #53847
Sun Room

Building Permit for Pool
46912 signed on 7/6/81
Pool

P. 31466

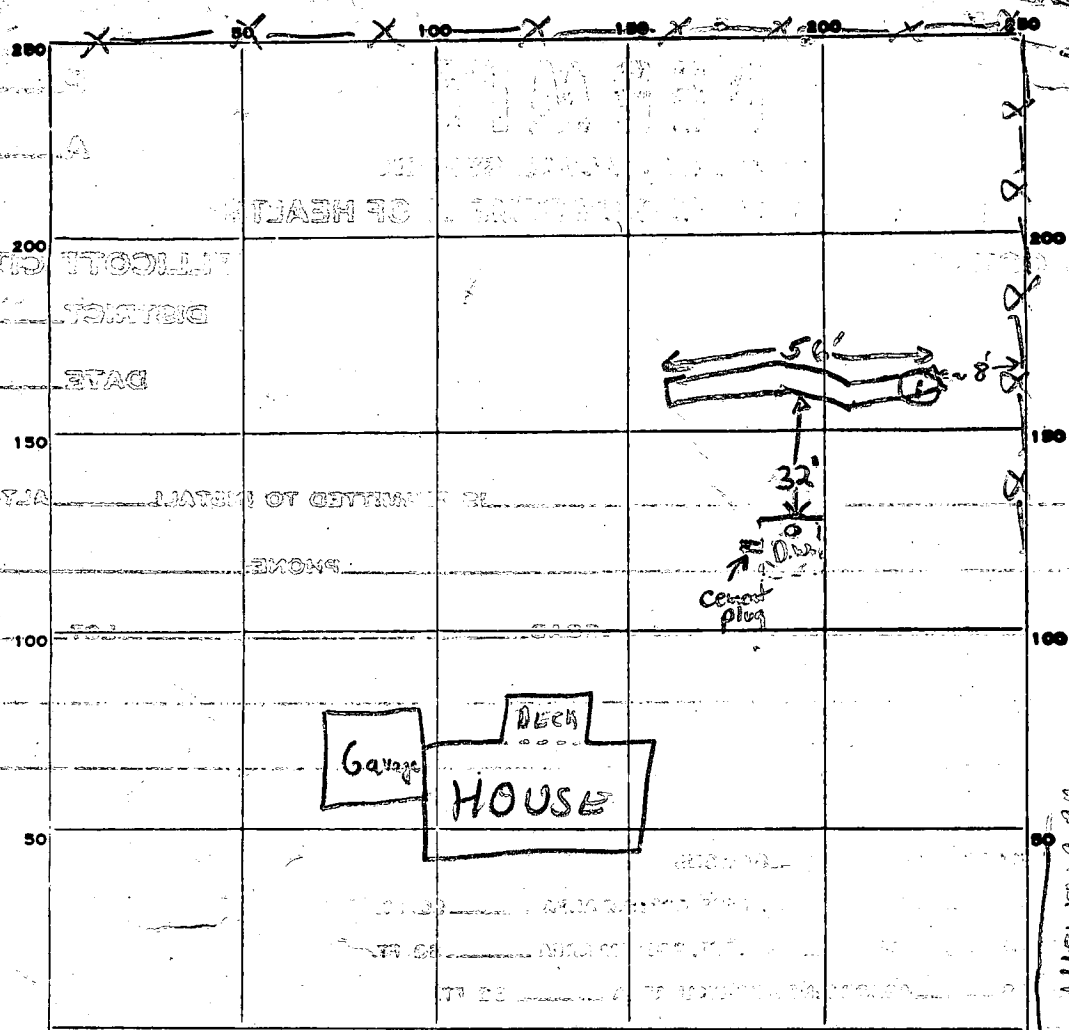

7/1/81
 ① 14 1/2' deep
 clayey to
 sandy loam
 below
 G.S.

PERMIT CARD ☒ CA 2241 TO MOORE TR QUA EX 101 MOORE TR QUA EX 101

SEPTIC TANK, LEVEL existing CLEANOUTS existing

DISTRIBUTION BOX, LEVEL na

TILE FIELD, DEPTH 10 FT. TRENCH WIDTH 2 FT.

GRAVEL DEPTH 6 1/2 FT. TOTAL LENGTH 56 FT.

NUMBER OF TRENCHES 1 1/2 SIDEWALL
 TOTAL BOTTOM AREA _____

SEEPAGE PITS, INSIDE DIAMETER _____ FT. DEPTH BELOW INLET 6-6 1/2 FT.

ABSORBENT AREA 2336 SQ. FT.

REMARKS 7/2/81 O.K. to add pipe & gravel in trench F.S.

7/6/81 Original trench connecting pipe broken off (4-5' section) and end to drywell plugged a cement. New trench installed, O.K. to cover all work F.S.

DATE SYSTEM APPROVED

7/6/81

INSPECTOR

F. Skinner

NOTES:


- 1)
- 2)
- 3)
- 4)

RECEIVED
HOWARD COUNTY
HEALTH DEPT.

JUN 16 9 32 AM '81

DIVISION OF
ENVIRONMENTAL
HEALTH

SCALE
1"=30'

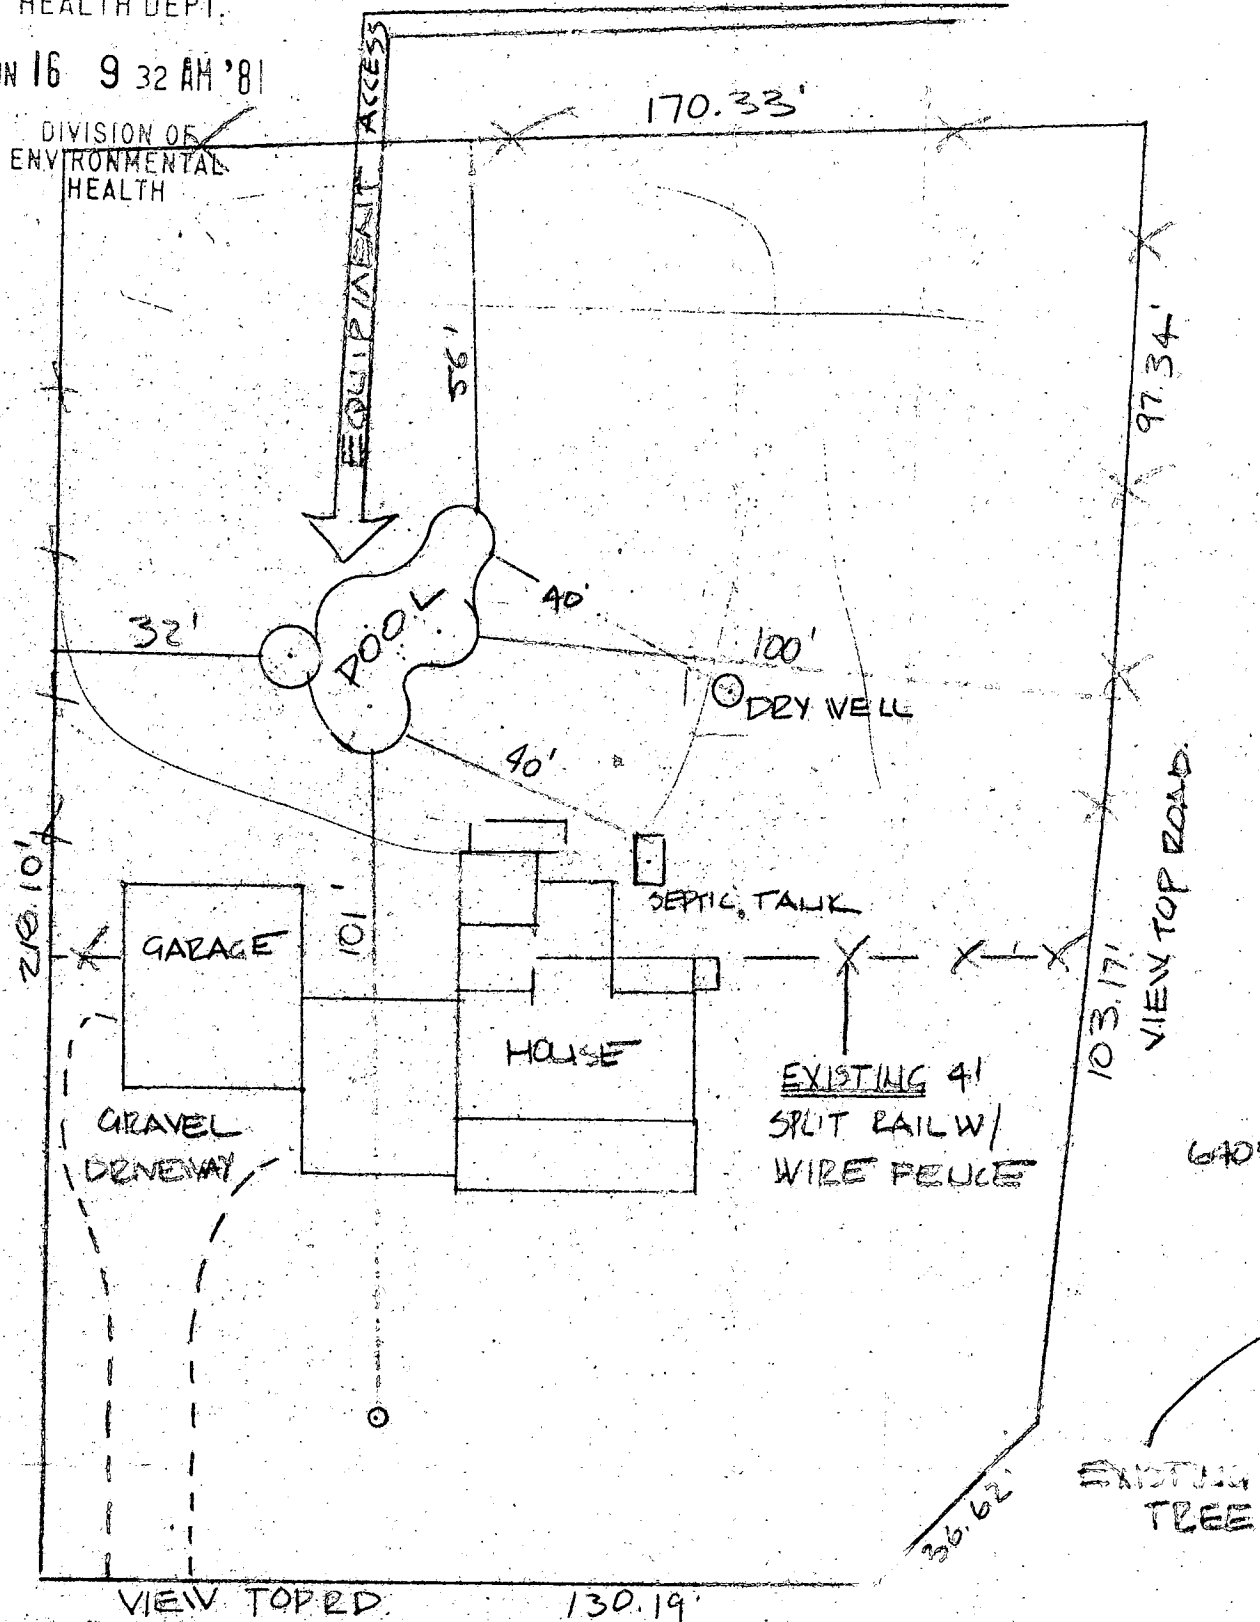

SETBACKS

REAR	10'
SIDE	10'
HOUSE	10'
WELL	10'
SEPTIC	20'
FENCE	3' MIN.

HOWARD COUNTY
WELL & SEPTIC

8/26/81 T.C. Allen Brown, of D.P.
Bar End Const. Mgmt

Approved
GLK 2 Aug. 79

7/25/78 P.C. 0
c. 62

PERMIT

SEWAGE DISPOSAL SYSTEM

MARYLAND STATE DEPARTMENT OF HEALTH*

HOWARD COUNTY

ELLICOTT CITY

DISTRICT 2nd

DATE 7/21/78

INDEXED

R. L. Orndorff

IS PERMITTED TO INSTALL ☒ ALTER

ADDRESS

PHONE

SUBDIVISION Tarasca/Schlee property

ROAD 3986 View Top Road LOT 2

PROPERTY OWNER Mr. Ciotoia Hobby Building Systems

ADDRESS 3986 View Top Rd., E.C., Md. 21043
9408 Merryrest Lane, Columbia, Md. Phone: 596-3637

SPECIFICATIONS 4 bedrooms

SEPTIC TANK CAPACITY 1250 GALLONS

DRAIN FIELD DEPTH FEET, BOTTOM AREA SQ. FT.

DEEP TRENCH DEPTH FEET, BOTTOM AREA SQ. FT.

SEEPAGE PITS ABSORBENT SIDE-WALL AREA SQ. FT.

INLET PIPE FT. BELOW ORIGINAL GRADE. MAXIMUM DEPTH FT. BELOW ORIGINAL GRADE

EFFECTIVE DEPTH AT FT. BELOW ORIGINAL GRADE.

LOCATE DISPOSAL AREA FT. FROM LOT LINE AND FT. FROM LOT LINE AS SEEN WHEN

12611
FACING LOT FROM
DRY WELL AND TRENCH - The system will contain no less than 175 sq. ft. of absorbent side-wall area per bedroom below inlet. Locate the dry well 35 ft. from the right property line as seen from the 130 ft. property line and 150 ft. from the 130 ft. property line. The invert will enter the dry well at 3 ft. below original grade and the maximum depth of the dry well will not exceed 9 ft. below original grade. Begin the trench after a 5 ft. earth buffer and follow the contour of the land. The trench will be 2 ft. wide, 9 ft. deep, and contain 6 ft. of stone under pipe. 10' long if 3'

PLANS APPROVED BY Robert T. Moorefield

DATE 7/15/77

COVER NO WORK UNTIL INSPECTED AND APPROVED.

NEITHER THE HOWARD COUNTY COUNCIL NOR THE HEALTH DEPARTMENT IS RESPONSIBLE FOR THE SUCCESSFUL OPERATION OF ANY SYSTEM.

NOTE: IF TRENCH IS USED CALL FOR INSPECTION BEFORE PLACING GRAVEL IN TRENCH.

NOTE: NO DRY WELL SHALL EXCEED 15 FOOT IN DIAMETER.

NOTE: ALL PIPE FROM HOUSE TO DISPOSAL AREA MUST BE CAST IRON.

PERMIT VOID AFTER THREE YEARS.

NOTE: INSTALL STAND PIPE ON SEPTIC TANK AND DRY WELL. STAND PIPES MUST BE 6 INCHES IN DIAMETER. CAST IRON, CONCRETE OR TERRA COTTA ACCEPTED.

*INSTALLER IS RESPONSIBLE FOR OBTAINING FINAL APPROVAL ON THIS PERMIT.

HD - 23

BLDG. PERMIT SIGNED

AND RETURNED 8/24/79

Serial No. 41029

BLDG. PERMIT SIGNED

AND RETURNED 5/15/80

Serial # 43234
Garage & Fireplace

23273


2 Aug 78

Final OK

(61)

145
14
700

High Point Road

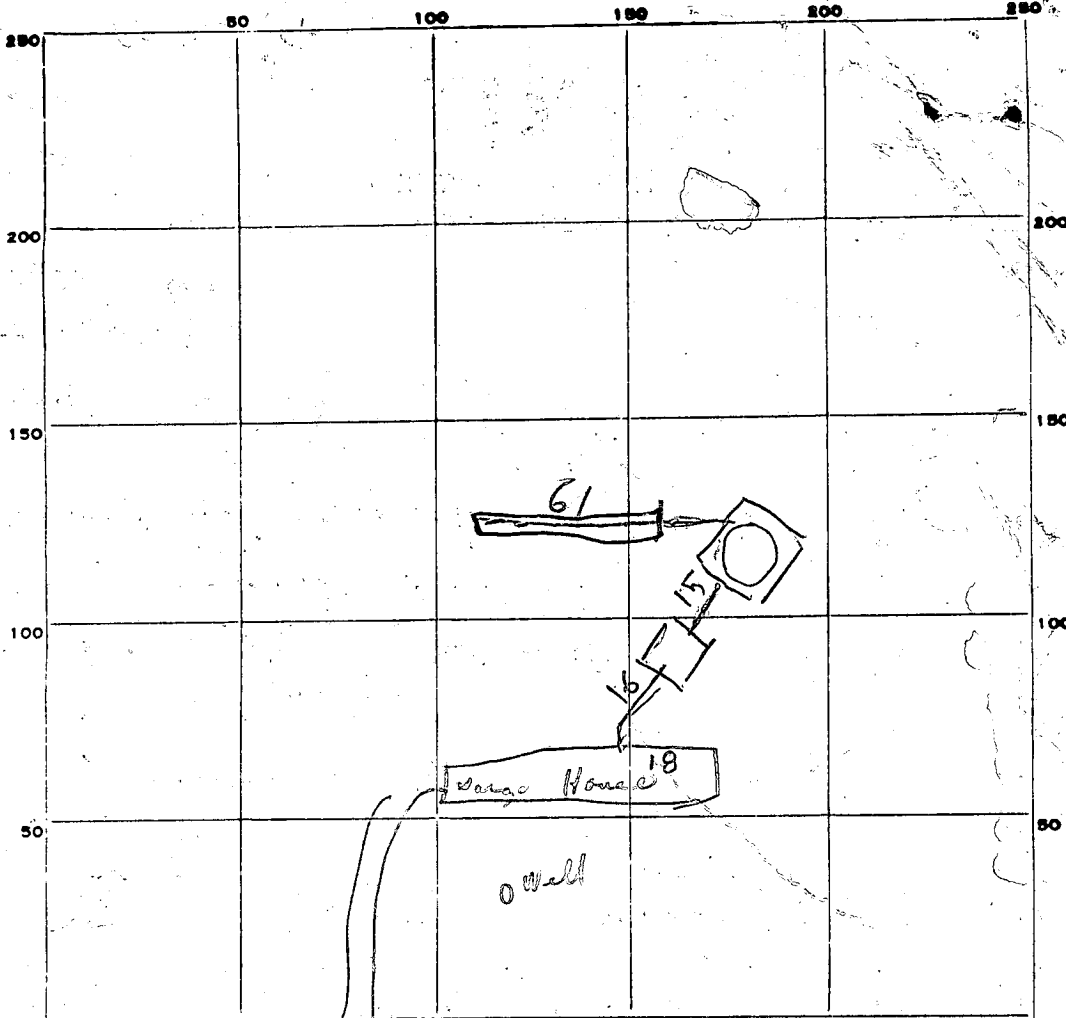

INDICATE NORTH - NAME ADJOINING ROADWAY AS BASE LINE.

PERMIT CARD

SEPTIC TANK, LEVEL OK TOP 2F7

DISTRIBUTION BOX, LEVEL

DITCH
TILE FIELD, DEPTH 10 FT. TRENCH WIDTH 2 FT.

GRAVEL DEPTH 6 F7 IN. TOTAL LENGTH 61 FT.

NUMBER OF TRENCHES 1 TOTAL BOTTOM AREA

SEEPAGE PITS, INSIDE DIAMETER 56 FT. DEPTH BELOW INLET 6 FT.

ABSORBENT AREA ± 702 SQ. FT.

REMARKS

7/25/78 P.M. No trench ready - due to rain - however discussed system at site with digger - d. 60' of trench + 15' x 15' area needed. To call for trench

7/26/78 - INLET DW 2F7 BELOW GRADE ADD STONES & CALL FOR REINSPECTION BY BH

7/29/78 INLET TO DW 3F7 PIPE IN DITCH LAYED ON TOP OF STONE COVER PIPE WITH 21 STONE

DATE SYSTEM APPROVED 2 Aug 78 INSPECTOR S. Keller

CALL. OK TO COVER TANK & DW

APPLICATION

A 23273

SEWAGE DISPOSAL TESTING

P _____

STATE OF MARYLAND - DEPARTMENT OF HEALTH AND MENTAL HYGIENE

HOWARD COUNTY HEALTH DEPARTMENT
ENVIRONMENTAL HEALTH SERVICES

P. O. BOX 476, ELLICOTT CITY, MARYLAND 21043
TELEPHONE: 465-5000, EXT. 356

DISTRICT 2ND

DATE MARCH 24, 1976

TO: THE COUNTY HEALTH OFFICER
ELLICOTT CITY, MARYLAND

I, HEREBY, APPLY FOR THE NECESSARY TEST IN ORDER TO CONSTRUCT (OR RECONSTRUCT) A SEWAGE DISPOSAL SYSTEM.

PROPERTY OWNER

MR. GARY SCHLEE

ADDRESS

3994 VIEW TOP RD.

PHONE

461-9088

461 9326

PROPERTY LOCATION:

SUBDIVISION

LOT NO.

2

ROAD AND DESCRIPTION

VIEW TOP RD.

SIZE OF LOT

TYPE BLDG.

3

NUMBER OF BEDROOMS

IF NOT SINGLE RESIDENCE DESCRIBE

THE SYSTEM INSTALLED UNDER THIS APPLICATION IS ACCEPTABLE ONLY UNTIL PUBLIC FACILITIES BECOME AVAILABLE.

SIGNATURE OF APPLICANT

Gary A. Schlee

APPROVED BY

FOR

DATE

(KIND OF SYSTEM)

REJECTED BY

FOR

DATE

(KIND OF SYSTEM)

HOLD PENDING FURTHER TESTS

DATE

REASONS FOR REJECTION OR HOLDING


THIS IS NOT A PERMIT

①
0
1-2
sandy clay
sand
13

②
0
clay
sand
8
13

③
0
clay
sandy
2
13

④
0
clay
sandy
2-3
13

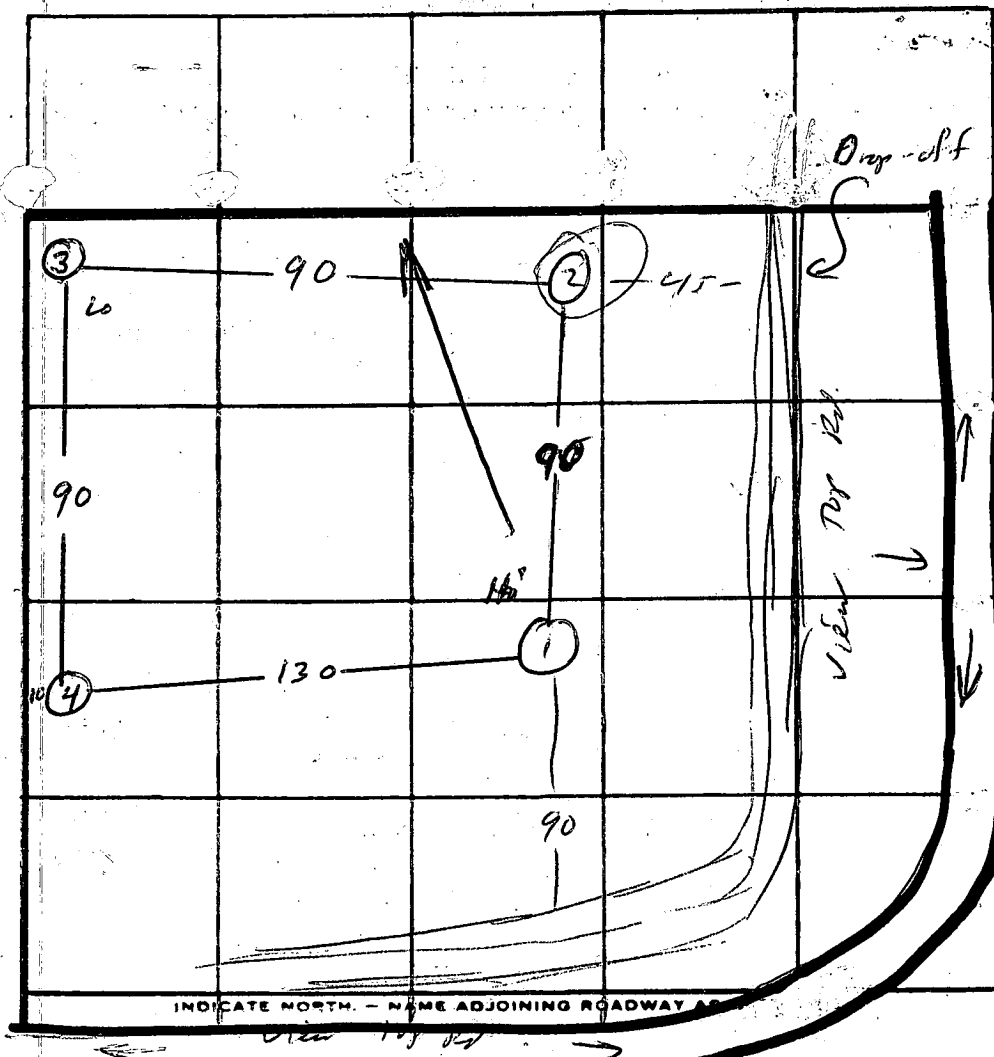

N
Lot 2

DATE	TEST NO.	DEPTH	PRE-WET		TEST - 1" DROP		TIME
			START	STOP	START	STOP	
5/18/76	1	3	2 ⁵⁵	2 ⁵⁸	2 ⁵⁸	3 ⁰³	5
	1A	13	2 ⁵⁵	2 ⁵⁸	2 ⁵⁸	3 ⁰⁵	7
	2	3	3 ²⁰				3:30
	2A	13	3 ¹⁰	3 ¹⁸	3 ¹⁸	3 ³⁰	12
5/19	2B	4	3 ⁵⁹	4 ⁰²	4 ⁰²	4 ¹⁰	8
	3	3	3 ²²	3 ²⁴	3 ²⁴	3 ²⁸	4
	3A	12	3 ²²	3 ²⁴	3 ²⁴	3 ²⁷	3
	4	3	2 ²⁰	2 ³³	2 ³³	2 ³⁸	5
	4A	12	2 ³⁵	2 ⁴⁰	2 ⁴⁰	2 ⁵⁵	15

in a clay/sand area
10 min or
3' max depth

REMARKS use a higher ave time as a safety margin
TYPE OF SOIL
TESTED BY J.M. / R.B. ALSO PRESENT:

170'


serial no. 33861

10-27-77
S. J. & Associates
P.C.



218'


DRAIN
5' LONG 2' WIDE
9' DEEP 6" STONE

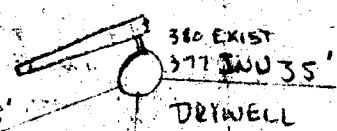

1250 GAL
TANK

380 EXIST
37.8 INU

TW 37.8

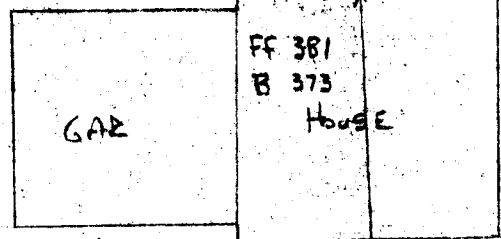

125'

200'

VIEW TOP

EXIST 381

WELL

50'

25'

37'

130'

VIEW TOP

LOT 2 VIEW TOP
HOBBY BUILDING
SYSTEM

B 1 1 2 3 (SEQ. NO.) 6 8346 (THIS NUMBER IS TO BE PUNCHED IN COLS. 3-6 ON ALL CARDS)	SEQUENCE NO. (WRA USE ONLY) 12/14/77 9:30 a.m.	STATE OF MARYLAND WATER RESOURCES ADMINISTRATION TAWES STATE OFFICE BLDG., ANNAPOLIS, MARYLAND 21401 APPLICATION FOR PERMIT TO DRILL WELL	WRA PERMIT NUMBER 40-73-2396 FILL IN THIS FORM COMPLETELY
---	--	--	---

DATE RECEIVED (WRA USE ONLY)	OWNER	COL 15 LAST NAME	FIRST NAME
12/14/77 9:30 a.m.	Habbes Building Contractors	COL 36	COL 34
	STREET OR RFD	COL 36	COL 55
	POST OFFICE	COL 57	COL 76
		Columbia Md.	

B 1	CONTINUED	DRILLER INFORMATION
1 2 3 (SEQ. NO.) 6		
DATE	LICENSE NUMBER	
10/12/77	42	
	77	80
FIRST NAME	DRILLER	LAST NAME
S. J. Kesterday		
SIGNATURE		
S. J. Kesterday		

B 2	CONTINUED	WELL INFORMATION
1 2 3 (SEQ. NO.) 6		
MAXIMUM PUMPING RATE (GALLONS PER MINUTE)		
8	12	
AVERAGE DAILY QUANTITY NEEDED (GALLONS PER DAY)		
1	20	
USE FOR WATER (CIRCLE APPROPRIATE BOX)		
☒ HOME (SINGLE OR DOUBLE HOUSEHOLD UNIT ONLY)		
☐ FARMING, AGRICULTURE, IRRIGATION		
☐ INDUSTRIAL, COMMERCIAL, STATE AND FEDERAL GOVERNMENT.		
☐ MUNICIPAL WATER SUPPLY		
☐ PRIVATE WATER COMPANY		
☐ TEST		
MUST HAVE STATE HEALTH DEPT. APPROVAL		

APPROXIMATE DEPTH OF WELL	24	150	28	FEET
---------------------------	----	-----	----	------

APPROXIMATE DIAMETER OF WELL	6	(NEAREST INCH)
------------------------------	---	----------------

METHOD OF DRILLING USED (CIRCLE APPROPRIATE METHOD)		
☒ BORED (OR AUGERED)	☐ JETTED	☐ DRIVEN
30-37 ☒ AIR-ROTARY	☐ AIR-PERCUSSION	☐ ROTARY (HYDRAULIC ROTARY)
☐ CABLE	☐ REVERSE-ROTARY	☐ DRIVE-POINT
OTHER (DESCRIBE)		

REPLACEMENT OR DEEPEND WELLS (CIRCLE APPROPRIATE BOX)		
☐ N. THIS WELL WILL NOT REPLACE AN EXISTING WELL		
☐ Y. THIS WELL WILL REPLACE A WELL THAT WILL BE ABANDONED AND SEALED		
☐ S. THIS WELL WILL REPLACE A WELL THAT WILL BE USED AS A STANDBY		
☐ D. THIS WELL WILL DEEPEEN AN EXISTING WELL		
PERMIT NUMBER OF WELL TO BE REPLACED OR DEEPEND (IF AVAILABLE)		
41	52	

NOT TO BE FILLED IN BY DRILLER (WRA USE ONLY)		
APPROPRIATION PERMIT NUMBER	ENGINEER REVIEW DISTRICT NO.	
54	63	65
FORCE	WRITE INITIALS IN BOX	CONDITIONS
67 68		70 71 72 73 74 75 76 77 78 79

B 4	CONTINUED	HEALTH DEPARTMENT APPROVAL
1 2 3 (SEQ. NO.) 6		
41	STATE HEALTH (CIRCLE BOX)	COUNTY NAME
		COUNTY NO.
DATE	MO.	DAY
10	7	
43	48	APPROVED BY
		F. L. Linnert

B 5	CONTINUED	SPECIAL CONDITIONS 8-63 (WRA USE ONLY)
1 2 3 (SEQ. NO.) 6		

B 3	CONTINUED	LOCATION OF WELL
1 2 3 (SEQ. NO.) 6		
COUNTY	Howard	
SUBDIVISION	21	
SECTION	42	
NEAREST TOWN	48	
MILES FROM TOWN (ENTER 0 IF IN TOWN)	71	
	76 77 78	

B 4	CONTINUED	DIRECTION FROM TOWN (CIRCLE APPROPRIATE BOX)
1 2 3 (SEQ. NO.) 6		
☒ N NORTH	☒ E EAST	☐ NE NORTHEAST
☐ S SOUTH	☒ W WEST	☐ SE SOUTHEAST
☐ NW NORTHWEST	☐ SW SOUTHWEST	
NEAR WHAT ROAD	St. Jones Lane	
ON WHICH SIDE OF ROAD (CIRCLE APPROPRIATE BOX)	N 32 S 32 E 32 W 32	
DISTANCE FROM ROAD (ENTER DISTANCE AND CIRCLE APPROPRIATE BOX)	100	
	34 37 38 39	

DRAW A SKETCH BELOW SHOWING LOCATION OF WELL IN RELATION TO NEARBY TOWNS, ROADS AND STREAMS WITH NORTH IN THE DIRECTION OF THE ARROW, AND GIVE DISTANCE FROM WELL TO NEAREST ROAD, JUNCTION OR STREAM CROSSING SHOWN ON THE SKETCH. ALSO SHOW, BY MEANS OF AN "X", THE WELL LOCATION IN THE BOX BELOW AND THE BOX NUMBER FROM THE WELL LOCATION MAP.

N

↑

St. Jones Lane

Well OK

12/16/77

See other side

R/H

BOX NUMBER	E	N	0/5	5/5
	9 50	510		
NORTH COORDINATE	50 51 52 53 54 55			
EAST COORDINATE	57 58 59 60 61 62 63			
ELEVATION AT WELL HEAD (FEET)	65 66 67 68			
	0/0 5/0			

560 PLT

W

90

25

VIEW TOP

ORD

12/16/77

- ① 45 ft casing with 2 ft out of ground
- ② 43 ft is depth of open hole to be grouted
- ③ Location appears OK Well on highest part of lot
- ④ 15 bags
- ⑤ Well OK

Raymond Rodger

16
14
13
13
56

175
4
700

61
7
427

364
427
798

56
65
280
336
3640

364 17W
61 11

C 1	6375	SEQUENCE NO. (WRA USE ONLY)	STATE OF MARYLAND WATER RESOURCES ADMINISTRATION TAWES STATE OFFICE BLDG., ANNAPOLIS, MD. 21401 WELL COMPLETION REPORT	THIS REPORT MUST BE SUBMITTED WITHIN 30 DAYS AFTER WELL COMPLETION. FILL IN THIS FORM COMPLETELY COUNTY / NUMBER
1 2 3 (SEQ. NO.) 6	DATE RECEIVED (WRA USE ONLY)		DEPTH OF WELL 120 22 (TO NEAREST FOOT) 26	PERMIT NO. FROM "PERMIT TO DRILL WELL" 40-73-2390 28 29 30 31 32 33 34 35 36 37
DATE WELL COMPLETED 12/16/77 15 20		DRILLERS IDENTIFICATION NO. 47		

OWNER HARRY BING SYSTEMS LAST NAME FIRST NAME
 STREET OR RFD 4408 MERRYFIST RD. POST OFFICE COLUMBIA, MD.

WELL LOG STATE THE KIND OF FORMATIONS PENETRATED, THEIR COLOR, DEPTH, THICKNESS AND IF WATER-BEARING <table border="1" style="width:100%; border-collapse: collapse;"> <thead> <tr> <th rowspan="2">DESCRIPTION (USE ADDITIONAL SHEETS IF NECESSARY)</th> <th colspan="2">FEET</th> <th rowspan="2">CHECK IF WATER BEARING</th> </tr> <tr> <th>FROM</th> <th>TO</th> </tr> </thead> <tbody> <tr> <td>TOP SOIL</td> <td>0</td> <td>2</td> <td></td> </tr> <tr> <td>S. SHALE</td> <td>2</td> <td>8</td> <td></td> </tr> <tr> <td>BROWNSLATE</td> <td>8</td> <td>43</td> <td></td> </tr> <tr> <td>GRANITE</td> <td>43</td> <td>120</td> <td>✓</td> </tr> </tbody> </table>	DESCRIPTION (USE ADDITIONAL SHEETS IF NECESSARY)	FEET		CHECK IF WATER BEARING	FROM	TO	TOP SOIL	0	2		S. SHALE	2	8		BROWNSLATE	8	43		GRANITE	43	120	✓	GROUTING RECORD YES NO WELL HAS BEEN GROUTED (CIRCLE APPROPRIATE BOX) ☒ Y ☐ N TYPE OF GROUTING MATERIAL (CIRCLE BOX) CEMENT ☒ M BENTONITE CLAY ☐ B C NO. OF BAGS <u>15</u> NO. OF POUNDS <u>1500</u> GALLONS OF WATER <u>75</u> DEPTH OF GROUT SEAL (TO NEAREST FOOT) FROM <u>0</u> FT. TO <u>43</u> FT. (ENTER 0 IF FROM SURFACE) CASING RECORD INSERT APPROPRIATE CODE BELOW STEEL ☐ S T CONCRETE ☐ C O PLASTIC ☐ P L OTHER ☐ O T MAIN CASING TYPE ☒ S T NOMINAL DIAMETER TOP (MAIN) CASING (NEAREST INCH) <u>6</u> TOTAL DEPTH OF MAIN CASING (NEAREST FOOT) <u>45</u> OTHER CASING (IF USED) DIAMETER (INCH) DEPTH (FEET) FROM TO SCREEN TYPE OR OPEN HOLE INSERT APPROPRIATE CODE BELOW STEEL ☐ S T BRASS ☐ B R OPEN HOLE ☐ H O OR BRONZE ☐ P L PLASTIC ☐ O T OTHER ☐ O T	PUMPING TEST 1 2 3 (SEQ. NO.) 6 HOURS PUMPED (TO NEAREST HOUR) <u>2</u> PUMPING RATE (GALLONS PER MINUTE TO NEAREST GALLON) <u>15</u> METHOD USED TO MEASURE PUMPING RATE <u>BUCKET</u> WATER LEVEL: (DISTANCE FROM LAND SURFACE) BEFORE PUMPING <u>45</u> (NEAREST FOOT) WHEN PUMPING <u>120</u> (NEAREST FOOT) TYPE OF PUMPED USED (CIRCLE APPROPRIATE BOX) (FOR PUMPING TEST) ☒ A AIR ☐ P PISTON ☐ T TURBINE ☐ C CENTRIFUGAL ☐ R ROTARY ☐ O OTHER (DESCRIBE BELOW) ☐ J JET ☐ S SUBMERSIBLE PUMP INSTALLED TYPE OF PUMP (WRITE APPROPRIATE LETTER IN BOX - SEE ABOVE: A, C, J, P, R, S, T, O) DRILLER WILL INSTALL PUMP (CIRCLE APPROPRIATE BOX) YES ☒ Y NO ☐ N CAPACITY: GALLONS PER MINUTE (TO NEAREST GALLON) <u>31</u> <u>35</u> PUMP HORSE POWER <u>37</u> <u>41</u> PUMP COLUMN LENGTH (NEAREST FOOT) <u>43</u> <u>47</u> CASING HEIGHT (CIRCLE APPROPRIATE BOX AND ENTER CASING HEIGHT) ☒ + ABOVE ☐ - BELOW LAND SURFACE <u>2</u> (NEAREST FOOT) LOCATION OF WELL ON LOT SHOW PERMANENT STRUCTURE SUCH AS BUILDINGS, SEPTIC TANKS, AND/OR OTHER LAND MARKS AND INDICATE NOT LESS THAN TWO DISTANCES (MEASUREMENTS TO WELL). 20' WELL 25'
DESCRIPTION (USE ADDITIONAL SHEETS IF NECESSARY)		FEET			CHECK IF WATER BEARING																			
	FROM	TO																						
TOP SOIL	0	2																						
S. SHALE	2	8																						
BROWNSLATE	8	43																						
GRANITE	43	120	✓																					

CIRCLE APPROPRIATE BOXES ☐ A A WELL WAS ABANDONED AND SEALED WHEN THIS WELL WAS COMPLETED. ☐ E ELECTRIC LOG OBTAINED. ☐ P TEST WELL CONVERTED TO PRODUCTION WELL. I HEREBY CERTIFY THAT I HAVE COMPLIED WITH ALL CONDITIONS STATED ON THE ABOVE-CAPTIONED "PERMIT TO DRILL WELL", AND THAT INFORMATION CONTAINED IN THIS REPORT IS TRUE, ACCURATE, AND COMPLETE TO THE BEST OF MY KNOWLEDGE, INFORMATION AND BELIEF. DRILLERS NAME (PLEASE PRINT) <u>L.F. FASTERDAU</u> SIGNATURE <u>L.F. FASTERDAU</u>	SCREEN RECORD 1 2 3 (SEQ. NO.) 6 DEPTH (NEAREST WHOLE FOOT) FROM <u>43</u> TO <u>120</u> EACH SCREEN 1 <u>H O</u> 23 24 26 30 32 36 2 <u>H O</u> 38 39 41 45 47 51 SLOT SIZE 1. <u> </u> 2. <u> </u> 3. <u> </u> DIAMETER OF SCREEN <u>56</u> <u>60</u> (NEAREST INCH) FROM TO GRAVEL PACK <u> </u> IF WELL DRILLED WAS A FLOWING WELL, CIRCLE BOX <u>68</u> ☐ F WRA USE ONLY (NOT TO BE FILLED IN BY DRILLER) T ☐ 70 (E.R.O.S.) W ☐ 72 Q ☐ 74 75 76 TELESCOPE CASING LOG INDICATOR OTHER DATA AVAILABLE	LEFT LOT LINE 20' WELL 25'
--	---	----------------------------------

HOWARD COUNTY HEALTH DEPARTMENT
Division of Environmental Health
3450 Court House Drive
Ellicott City, Maryland
Tel: 465-5000, Ext. 356

DATE:

2/23/83

TO:

- ☐ MD. STATE DEPT. OF HEALTH
☐ COUNTY EXECUTIVE
☐ DEPT. OF PUBLIC WORKS
☐ BUREAU OF WATER & SEWERS
☐ OTHERS:

- ☐ BOARD OF EDUCATION
☒ OFFICE OF PLANNING & ZONING
☐ DIVISION OF LAND DEVELOPMENT
☐ BUILDING ENGINEER
☐ BUREAU OF LICENSES, INSPECTION & PERMITS

RE:

F-83-77 Tarasca-Schlee Est.

The above referenced:

- ☒ Final Plat
☐ Preliminary Plat
☐ Site Development Plan
☐ Building Plans
☐ Other:

IS:

- ☐ Approved
☐ Disapproved
☒ Approved, if public water and sewerage are provided.
☐ Approved, provided State Health Department notifies the Health Officer that he can sign the plat or bldg. permit.
☐ May the Health Officer sign the above referenced plat?

☒ Others: see below

COMMENTS:

- ☐ Preliminary plat needs revising.
☒ Final plat needs revising.
☐ Request that Engineer come to this office for conference.
☐ Submit completed Food Establishment check list.
☐ Percolation tests not performed
☐ State Subdivision Regulations not complied with.
☐ Submit complete plans and specifications.
☐ See attached Regulations or literature.

OTHER COMMENTS:

D.P.W. signature block must also indicate approval for public water & public sewerage systems

Signed:

E. Skinner


Plot No. 3701
Lot 3

$S 83^{\circ} 22' 16'' E$

170.33'

218.10'

$N 08^{\circ} 57' 28'' E$

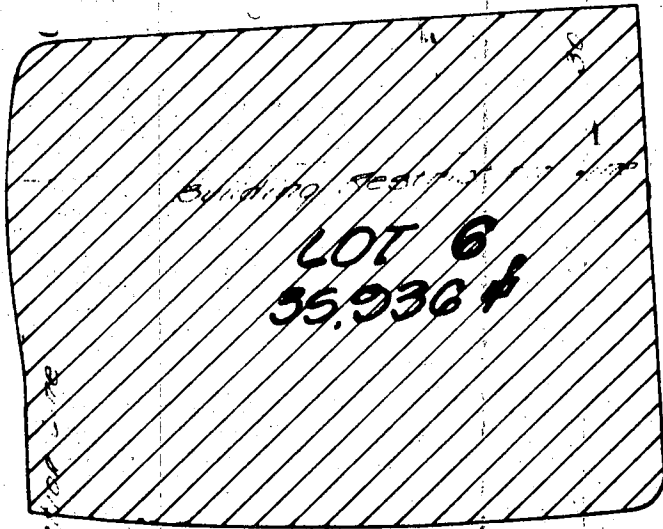

GARAGE

Existing House

9/28/83 Proposed Addition
Sketch OK for addition

24'

37'6"

30'6"

15'6"

48'

Building Restriction Line

61'

$N 81^{\circ} 02' 32'' W$ 130.19'

VIEW TOP ROAD

$S 55^{\circ} 54' 19'' E$ 36.62'
 $S 13^{\circ} 57' 24'' W$ 103.17'



$S 11^{\circ} 27' 36'' W$ 97.34'

VIEW TOP ROAD

2011 PIN 21-1-1

COORDINATES *		
No	North	East
1	520,191.07	850,562.40
2	520,172.31	850,731.80
3	520,076.21	850,718.25
4	512,076.75	850,687.37
5	512,056.76	850,657.04
6	512,076.53	850,628.48

* Md State Plane System

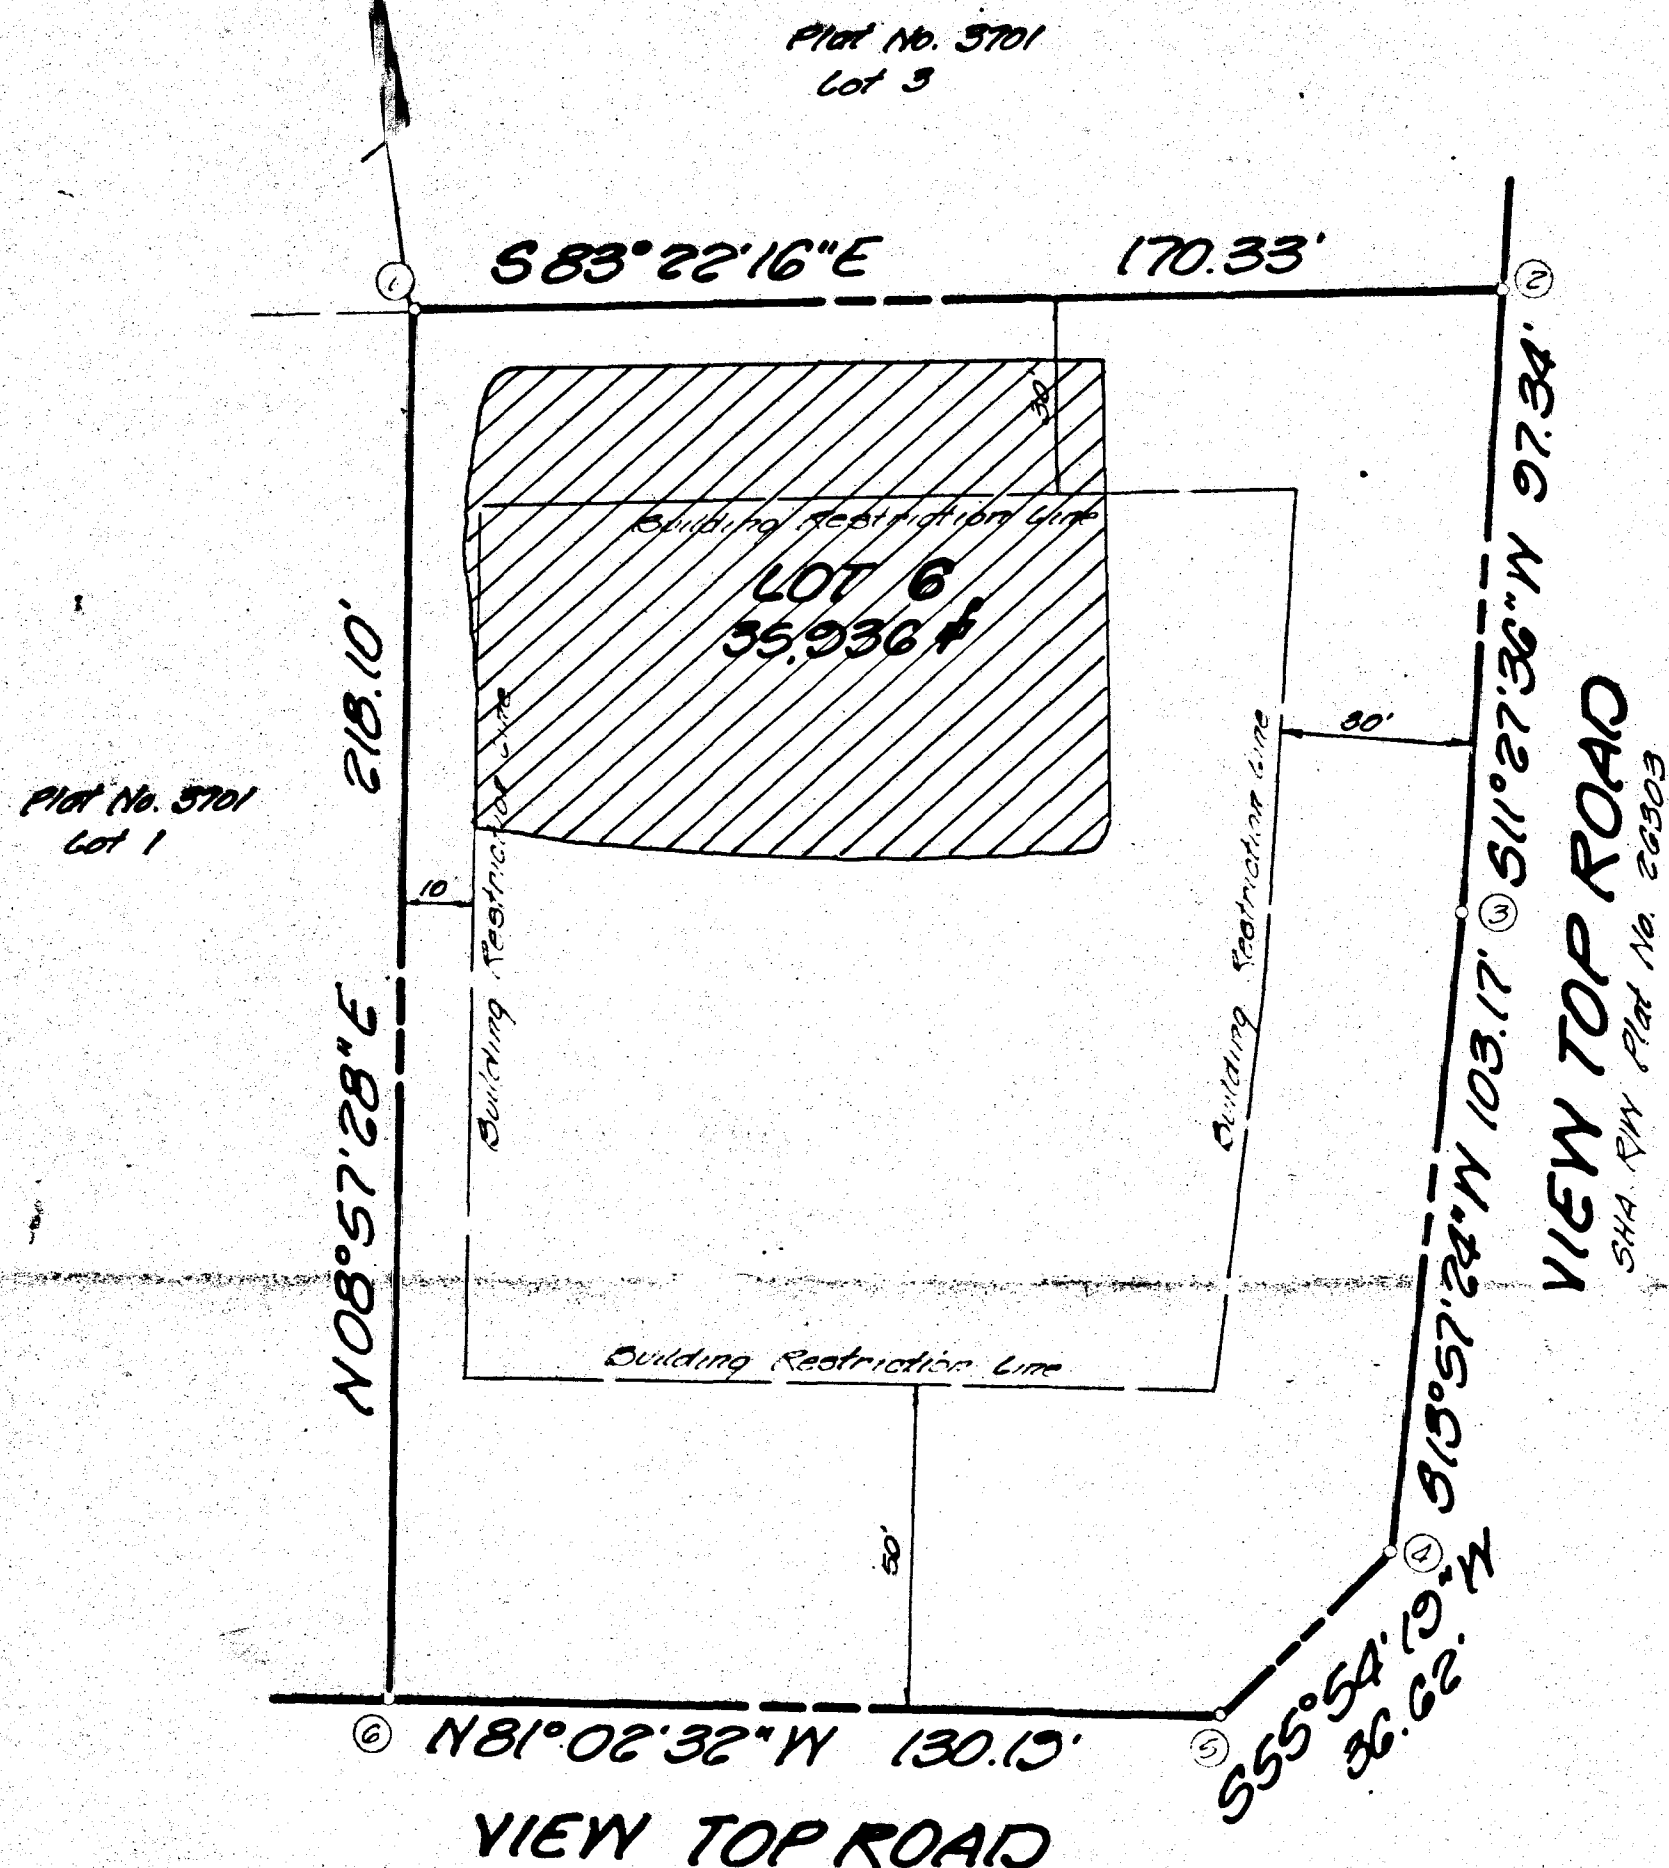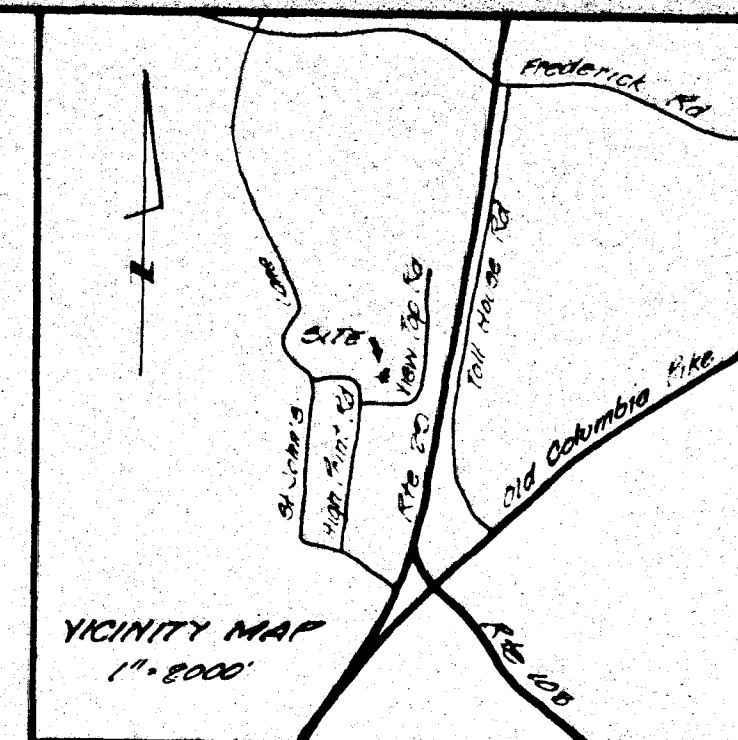

Notes:

1. The purpose of this plat is to redefine the building restriction lines.
2. Existing structure on Lot 6
3. Subject property zoned R-20 per 10-3-77, Comprehensive Zoning Plan.
4. [Hatched Area] This area designates a private sewage easement of approximately 10,000 sq ft as required by the Maryland State Health Department for individual sewage disposal. Improvements of any nature are restricted until public sewage is available and servicing any residential structure constructed on these building sites. This easement shall become null and void upon connection to a public sewage system.

Approved For Howard County Health Department for private water and public sewage systems

Joseph M. Boyd, M.D., per J.S.
County Health Officer
8/23/83
Date

Approved Howard County Office of Planning and Zoning

Arthur Amash-Randell
Director
8-26-83
Date

Approved Howard County Department of Public Works for storm drainage systems and public roads

Walter F. Neuman
Director
4-7-83
Date

OWNER'S CERTIFICATE

We, Joseph A. & Linda A. Ciotola, owners of the property shown and described herein, hereby adopt this plan of subdivision, and in consideration of the approval of this Plat by the Office of Planning and Zoning establish the minimum building restriction lines.

All easements of rights-of-way affecting the property are included in this plan of subdivision.

Witness our hands this 17th day of February 1983

Joseph A. Ciotola
Linda A. Ciotola
Witness to Subdiv

SURVEYOR'S CERTIFICATE

I hereby certify that the final plat shown herein is correct, that it is a resubdivision of Lot 2, Tarasca & Schlee Estates as recorded in Plat 5701, that it is the land conveyed by Hobby Building Systems, Inc. to Joseph A. and Linda A. Ciotola by deed dated December 14, 1978 and recorded in the Land Records of Howard County, Maryland in Liber 981 at Folio 35, and that all requirements are in place or will be in place prior to the acceptance of the streets in the subdivision by the County as shown, in accordance with the Annotated Code of Maryland as amended.

Jefferson O. Lawrence
Surveyor
Date

Recorded among the Land Records of Howard County, Maryland as Plat No. 5591 on 8-30-83

Lot 6, a resubdivision of Lot 2
TARASCA & SCHLEE ESTATES

SECTION 1
Second Election District
Howard County, Maryland
Scale: 1" = 30'
September 1982

Owner
Joseph A. Ciotola
Linda A. Ciotola
3000 View Top Road
Ellicott City, MD 21043
DEVELOPMENT CONSULTANTS GROUP, INC.
10400 E. 100th St. Suite 200
Overland Park, KS 66214