

# PERMIT

SEWAGE DISPOSAL SYSTEM

MARYLAND STATE DEPARTMENT OF HEALTH

HOWARD COUNTY

ELLICOTT CITY

DISTRICT 5th

DATE 9/8/81

approved 6/29/81  
Stager P 31610  
A Repair

9/18/81  
3/30/82  
Do not provide

## INDEX

Jack Fyock

IS PERMITTED TO INSTALL \_\_\_\_\_ ALTER X

ADDRESS 13775 Triadelphia Road, Glenelg, Md. 21737 PHONE 988-9270

SUBDIVISION Across from Byfield Rd ROAD Route 108 LOT \_\_\_\_\_

PROPERTY OWNER Peter Scheidt

ADDRESS Route 108, Highland, Maryland 20777

SPECIFICATIONS 5-6 BED ROOMS FOR TOTAL SYSTEM SERVES BOTH A TRAILER AND A HOUSE

SEPTIC TANK CAPACITY \_\_\_\_\_ GALLONS

DRAIN FIELD \_\_\_\_\_ DEPTH \_\_\_\_\_ FEET, BOTTOM AREA \_\_\_\_\_ SQ. FT.

DEEP TRENCH \_\_\_\_\_ DEPTH \_\_\_\_\_ FEET, BOTTOM AREA \_\_\_\_\_ SQ. FT.

SEEPAGE PITS \_\_\_\_\_ ABSORBENT SIDE-WALL AREA \_\_\_\_\_ SQ. FT.

INLET PIPE \_\_\_\_\_ FT. BELOW ORIGINAL GRADE. MAXIMUM DEPTH \_\_\_\_\_ FT. BELOW ORIGINAL GRADE

EFFECTIVE DEPTH AT \_\_\_\_\_ FT. BELOW ORIGINAL GRADE.

LOCATE DISPOSAL AREA \_\_\_\_\_ FT. FROM \_\_\_\_\_ LOT LINE AND \_\_\_\_\_ FT. FROM \_\_\_\_\_ LOT LINE AS SEEN WHEN FACING LOT FROM \_\_\_\_\_

REPAIR - Call for an appointment when ground is opened up and Sanitarian will

recommend the repair ~~XXXX~~ system.

100 FT LONG DITCH 120 SQ FT

PER BED ROOM PR

PLANS APPROVED BY Palmer F. Wine DATE 9/8/81

COVER NO WORK UNTIL INSPECTED AND APPROVED.

NEITHER THE HOWARD COUNTY COUNCIL NOR THE HEALTH DEPARTMENT IS RESPONSIBLE FOR THE SUCCESSFUL OPERATION OF ANY SYSTEM.

NOTE: IF TRENCH IS USED CALL FOR INSPECTION BEFORE PLACING GRAVEL IN TRENCH.

NOTE: NO DRY WELL SHALL EXCEED 15 FOOT IN DIAMETER.


NOTE: ALL PIPE FROM HOUSE TO DISPOSAL AREA MUST BE CAST IRON.

PERMIT VOID AFTER THREE YEARS.

NOTE: INSTALL STAND PIPE ON SEPTIC TANK AND DRY WELL. STAND PIPES MUST BE 6 INCHES IN DIAMETER. CAST IRON, CONCRETE OR TERRAZO ACCEPTED.

\*INSTALLER IS RESPONSIBLE FOR OBTAINING FINAL APPROVAL ON THIS PERMIT.

31610

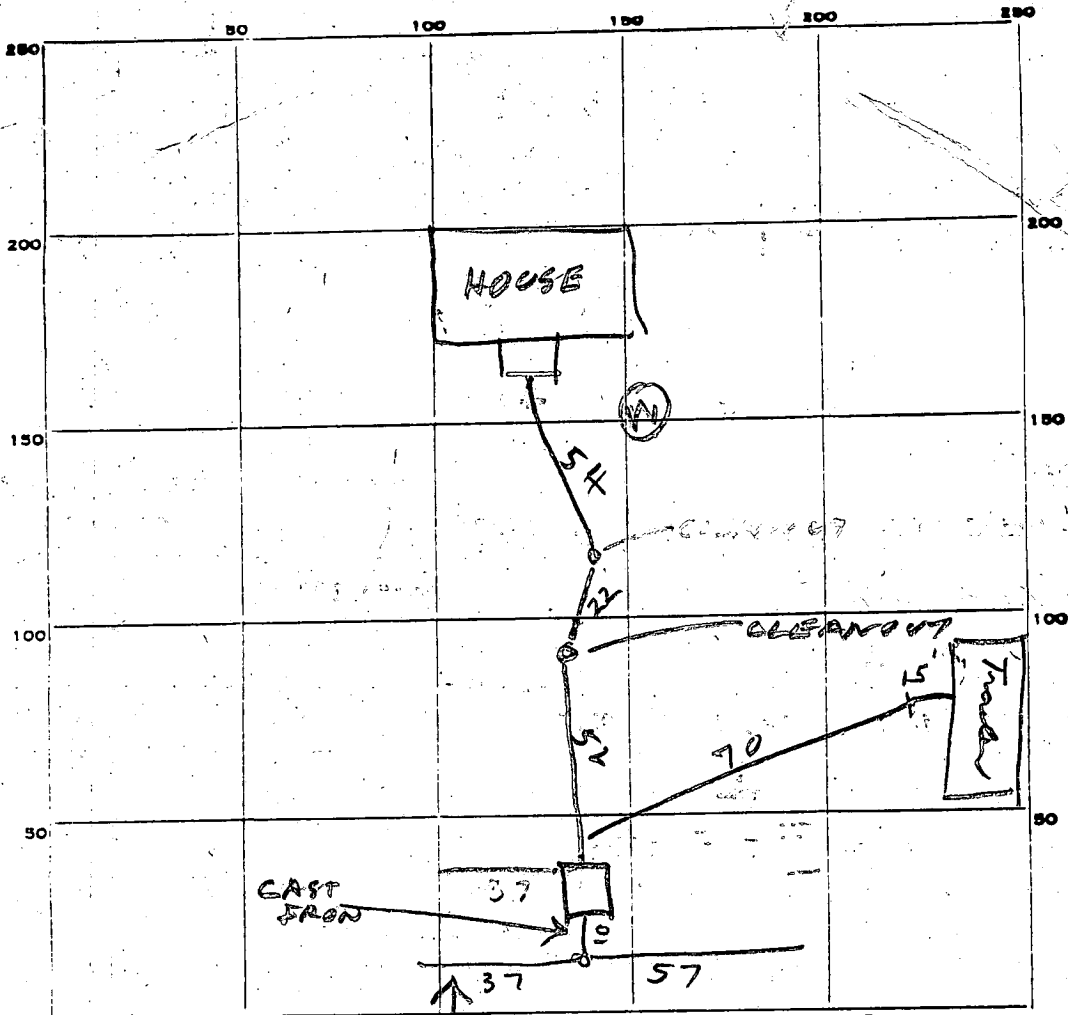

PERMIT CARD NO STONED 9/17 YES SEWER

SEPTIC TANK, LEVEL 1500 9/17 NO TANK 9/18 YES TANK

DISTRIBUTION BOX, LEVEL \_\_\_\_\_

TILE FIELD, DEPTH 13-16 FT. TRENCH WIDTH 2 FT.

GRAVEL DEPTH 8-11 FT. TOTAL LENGTH 94 FT.

NUMBER OF TRENCHES 1 TOTAL BOTTOM AREA 705 ONE SIDE EFFECTIVE

SEEPAGE PITS, INSIDE DIAMETER \_\_\_\_\_ FT. DEPTH BELOW INLET \_\_\_\_\_ FT. BELOW TOP  
5 1/2 FT CLAY

ABSORBENT AREA \_\_\_\_\_ SQ. FT.

REMARKS 9/17/81 INLET TO DITCH 5 FT BOG

DITCH DUG SOIL OK TOP SFT CLAY BOT 9 1/2 SAND

DITCH IS 13 FT DEEP EXCEPT 16 FT AT ONE END

3:7 FT PART OF DITCH STONED; PUT STONE IN 57 FT

PART OF DITCH PUT CLEANOUT ON TANK HOOK HOUSE &

TRAILER UR & CALL KIT SEE ATTACHED SHEET

9/18/81 STONE ADDED CONNECT HOUSE & TRAILER TO SYSTEM & CALL

DATE SYSTEM APPROVED 6/29/82 INSPECTOR Stoner

3/30/82 see attached sheet.



3/30/82 Seward Property

House connection OK

Trailer not connected

JS

6/29/82 Trailer connection OK Final JS



---

## HOWARD COUNTY HEALTH DEPARTMENT

---

*Joyce M. Boyd, M.D., County Health Officer*

August 19, 1994

MEMORANDUM

TO: Department of Licenses and Permits  
Howard County Government

FROM: Ronald J. Pinkley R. S. *RJP*  
Water and Sewerage Program  
Bureau of Environmental Health

RE: Demolition Permit  
Pre-Existing House  
Dr. and Mrs. Scheidt  
13501 Clarksville Pike  
Highland, Maryland 20777

This is to advise that the Howard County Health Department recommends issuance of the requested demolition permit for the above referenced facility.

The old hand dug well has been property abandoned and disconnected from the facility in question.

There remains an existing drilled well which will be retained for agricultural purposes consistent with our regulations.

RJP:jr

The home at 13501 Clarksville Pike, Highland, Maryland 20777 is ready to be demolished. The old hand dug well was already filled when investigated. The cast iron septic tank has pumped out by Jack Fyock's Septic Service and crushed by Garland Brian. The electricity has been disconnected by Baltimore Gas and Electric and the telephone has been disconnected. Suburban Propane has removed the tank.

References: Garland Brian 301-854-2161  
Jack Fyock 410-531-2939  
Balt. Gas & Electric 410- 455-9047  
C & P Telephone 410-954-6284  
Suburban Propane 301-251-0606

Operator on the site for John Brian who can verify the above data.

*Duke W. B...*

---

*(Mrs. Schutt) owner states existing drilled to be retained as a standby for irrigation and farming purposes only. a new well for new house will be drilled at a later date.*

*Ry...*  
*8/19/94*