

PERMIT

SEWAGE DISPOSAL SYSTEM

MARYLAND STATE DEPARTMENT OF HEALTH

HOWARD COUNTY

ELLICOTT CITY

DISTRICT

DATE 9/25/81

INDEXED

P 31626

A REPAIR

APPROVED 10/13/81
CBS/CW

03-282694

Mr. Cornwell

IS PERMITTED TO INSTALL ALTER X

ADDRESS 12196 Triadelphia Road, Ellicott City, Md PHONE 988-9221

SUBDIVISION ROAD 12196 Triadelphia Rd LOT

PROPERTY OWNER ~~Mr. Cornwell~~ MR. G. Cornwell

ADDRESS 12196 Triadelphia Rd, Ellicott City, Maryland

SPECIFICATIONS

SEPTIC TANK CAPACITY GALLONS

DRAIN FIELD DEPTH FEET, BOTTOM AREA SQ. FT.

DEEP TRENCH DEPTH FEET, BOTTOM AREA SQ. FT.

SEEPAGE PITS ABSORBENT SIDE-WALL AREA SQ. FT.

INLET PIPE FT. BELOW ORIGINAL GRADE. MAXIMUM DEPTH FT. BELOW ORIGINAL GRADE

EFFECTIVE DEPTH AT FT. BELOW ORIGINAL GRADE.

LOCATE DISPOSAL AREA FT. FROM LOT LINE AND FT. FROM LOT LINE AS SEEN WHEN
FACING LOT FROM

REPAIR CALL FOR INSPECTION WHEN GROUND IS OPENED UP SO SANITARIAN CAN
RECOMMEND REPAIR.

1500 gal. septic tank & trench off existing drywell (1 bath & 2 Bed room addition)
45'-50' LONG - 7'-8' OF STONE IN TRENCH
Proposed
CBS/CW

PLANS APPROVED BY Palmer F. Wine

DATE September 25, 1981

COVER NO WORK UNTIL INSPECTED AND APPROVED.

NEITHER THE HOWARD COUNTY COUNCIL NOR THE HEALTH DEPARTMENT IS RESPONSIBLE FOR THE SUCCESSFUL OPERATION OF ANY SYSTEM.

NOTE: IF TRENCH IS USED CALL FOR INSPECTION BEFORE PLACING GRAVEL IN TRENCH.

NOTE: NO DRY WELL SHALL EXCEED 15 FOOT IN DIAMETER.

NOTE: ALL PIPE FROM HOUSE TO DISPOSAL AREA MUST BE CAST IRON.

PERMIT VOID AFTER THREE YEARS.


NOTE: INSTALL STAND PIPE ON SEPTIC TANK AND DRY WELL. STAND PIPES MUST BE 6 INCHES IN DIAMETER. CAST IRON, CONCRETE OR TERRA
COTTA ACCEPTED.

*INSTALLER IS RESPONSIBLE FOR OBTAINING FINAL APPROVAL ON THIS PERMIT.

BLDG. PERMIT SIGNED
AND RETURNED 5-14-97
Serial # B7105640
Sundick

BLDG. PERMIT SIGNED
AND RETURNED 01/02/97
Serial # B7103527
1 story addition

BLDG. PERMIT SIGNED
AND RETURNED 10/13/81
#47911 for 2 B.R. & Bath Addition

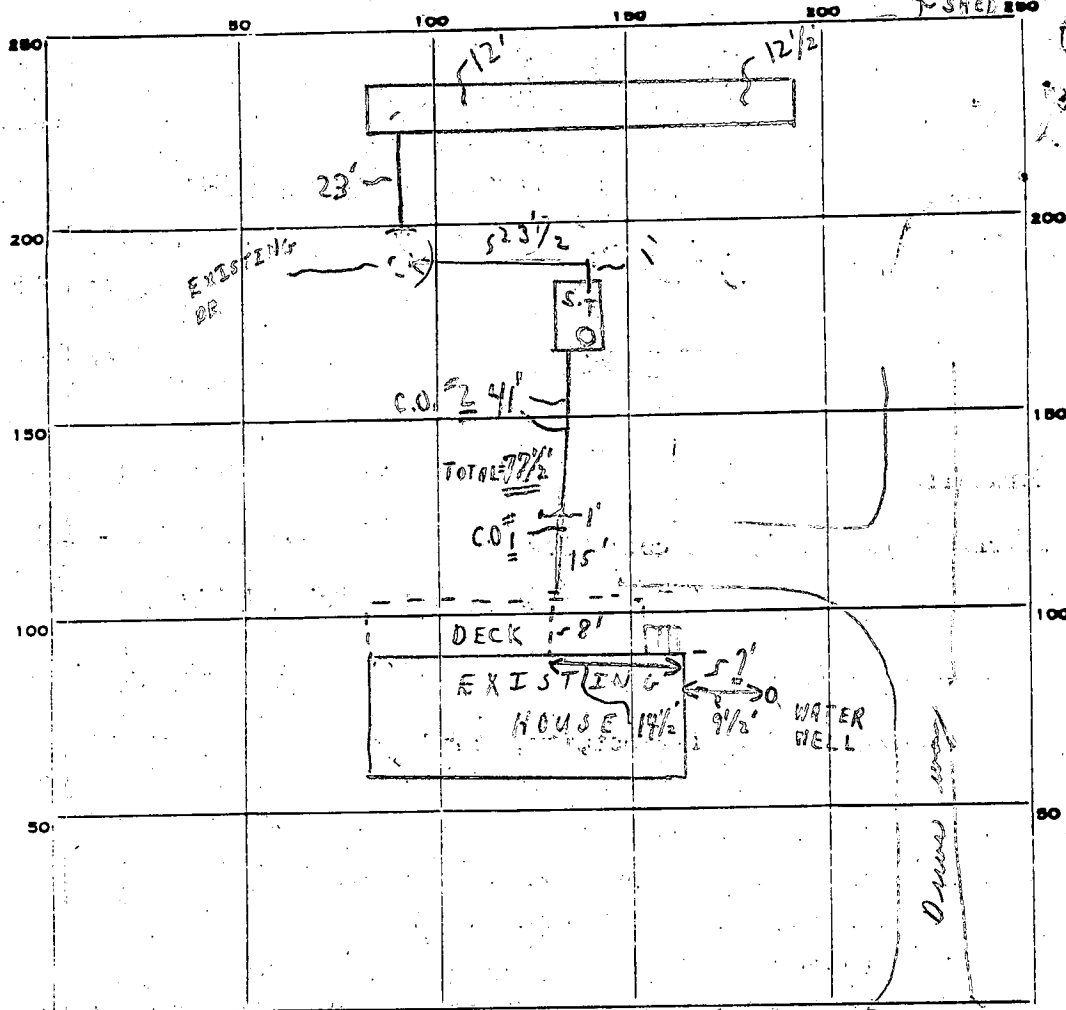

INDICATE NORTH. - NAME ADJOINING ROADWAY AS BASE LINE.

TRINDELPHIA ROAD

PERMIT CARD ☒

SEPTIC TANK, LEVEL ☒

CLEANOUTS ☒

C.O. #1
TO GRADE
NEED PLUG
10/13/81

C.O. #2
TO GRADE
NEED PLUG
10/13/81

DISTRIBUTION BOX, LEVEL

TILE FIELD, DEPTH 12 IN. FT. TRENCH WIDTH 2 FT.

GRAVEL DEPTH 10 IN. TOTAL LENGTH 45 FT.

450' ±

NUMBER OF TRENCHES 1 TOTAL BOTTOM AREA

SEEPAGE PITS, INSIDE DIAMETER FT. DEPTH BELOW INLET FT.

ABSORBENT AREA 450 SQ. FT.

REMARKS 10/7/81 OK TO CONTINUE WORK - PARTIAL (2) NO CHANGE (3)

OK TO COVER PIPE FROM HOUSE TO TRK. NEED TO SEE CLEANOUTS
PLUGGED IN LINE; OK TO COVER FROM SEPTIC TANK TO DRYWELL
ONLY; NEED TO SEE SEPTIC TANK TOP AND CLEANOUT AND LINE FROM
DRYWELL TO TRENCH AND TRENCH. 10/13/81 OK TO COVER ALL

WORK EXCEPT NEED TO SEE CLEANOUT PLUGS IN LINE CLEANOUTS. PARTIAL
TO CALL FOR FINAL - TENTATIVE OK TO RELESS WLP. PERMIT C.B. + F.V. C.B.


DATE SYSTEM APPROVED INSPECTOR

NO RECORD OF FINAL INSP REQUEST AS OF 7/17/95 - INDEX AS APPROVED (CW)

Third Election District

Howard County, Md.

OCT. 17, 1957 Scale: 1" = 50'

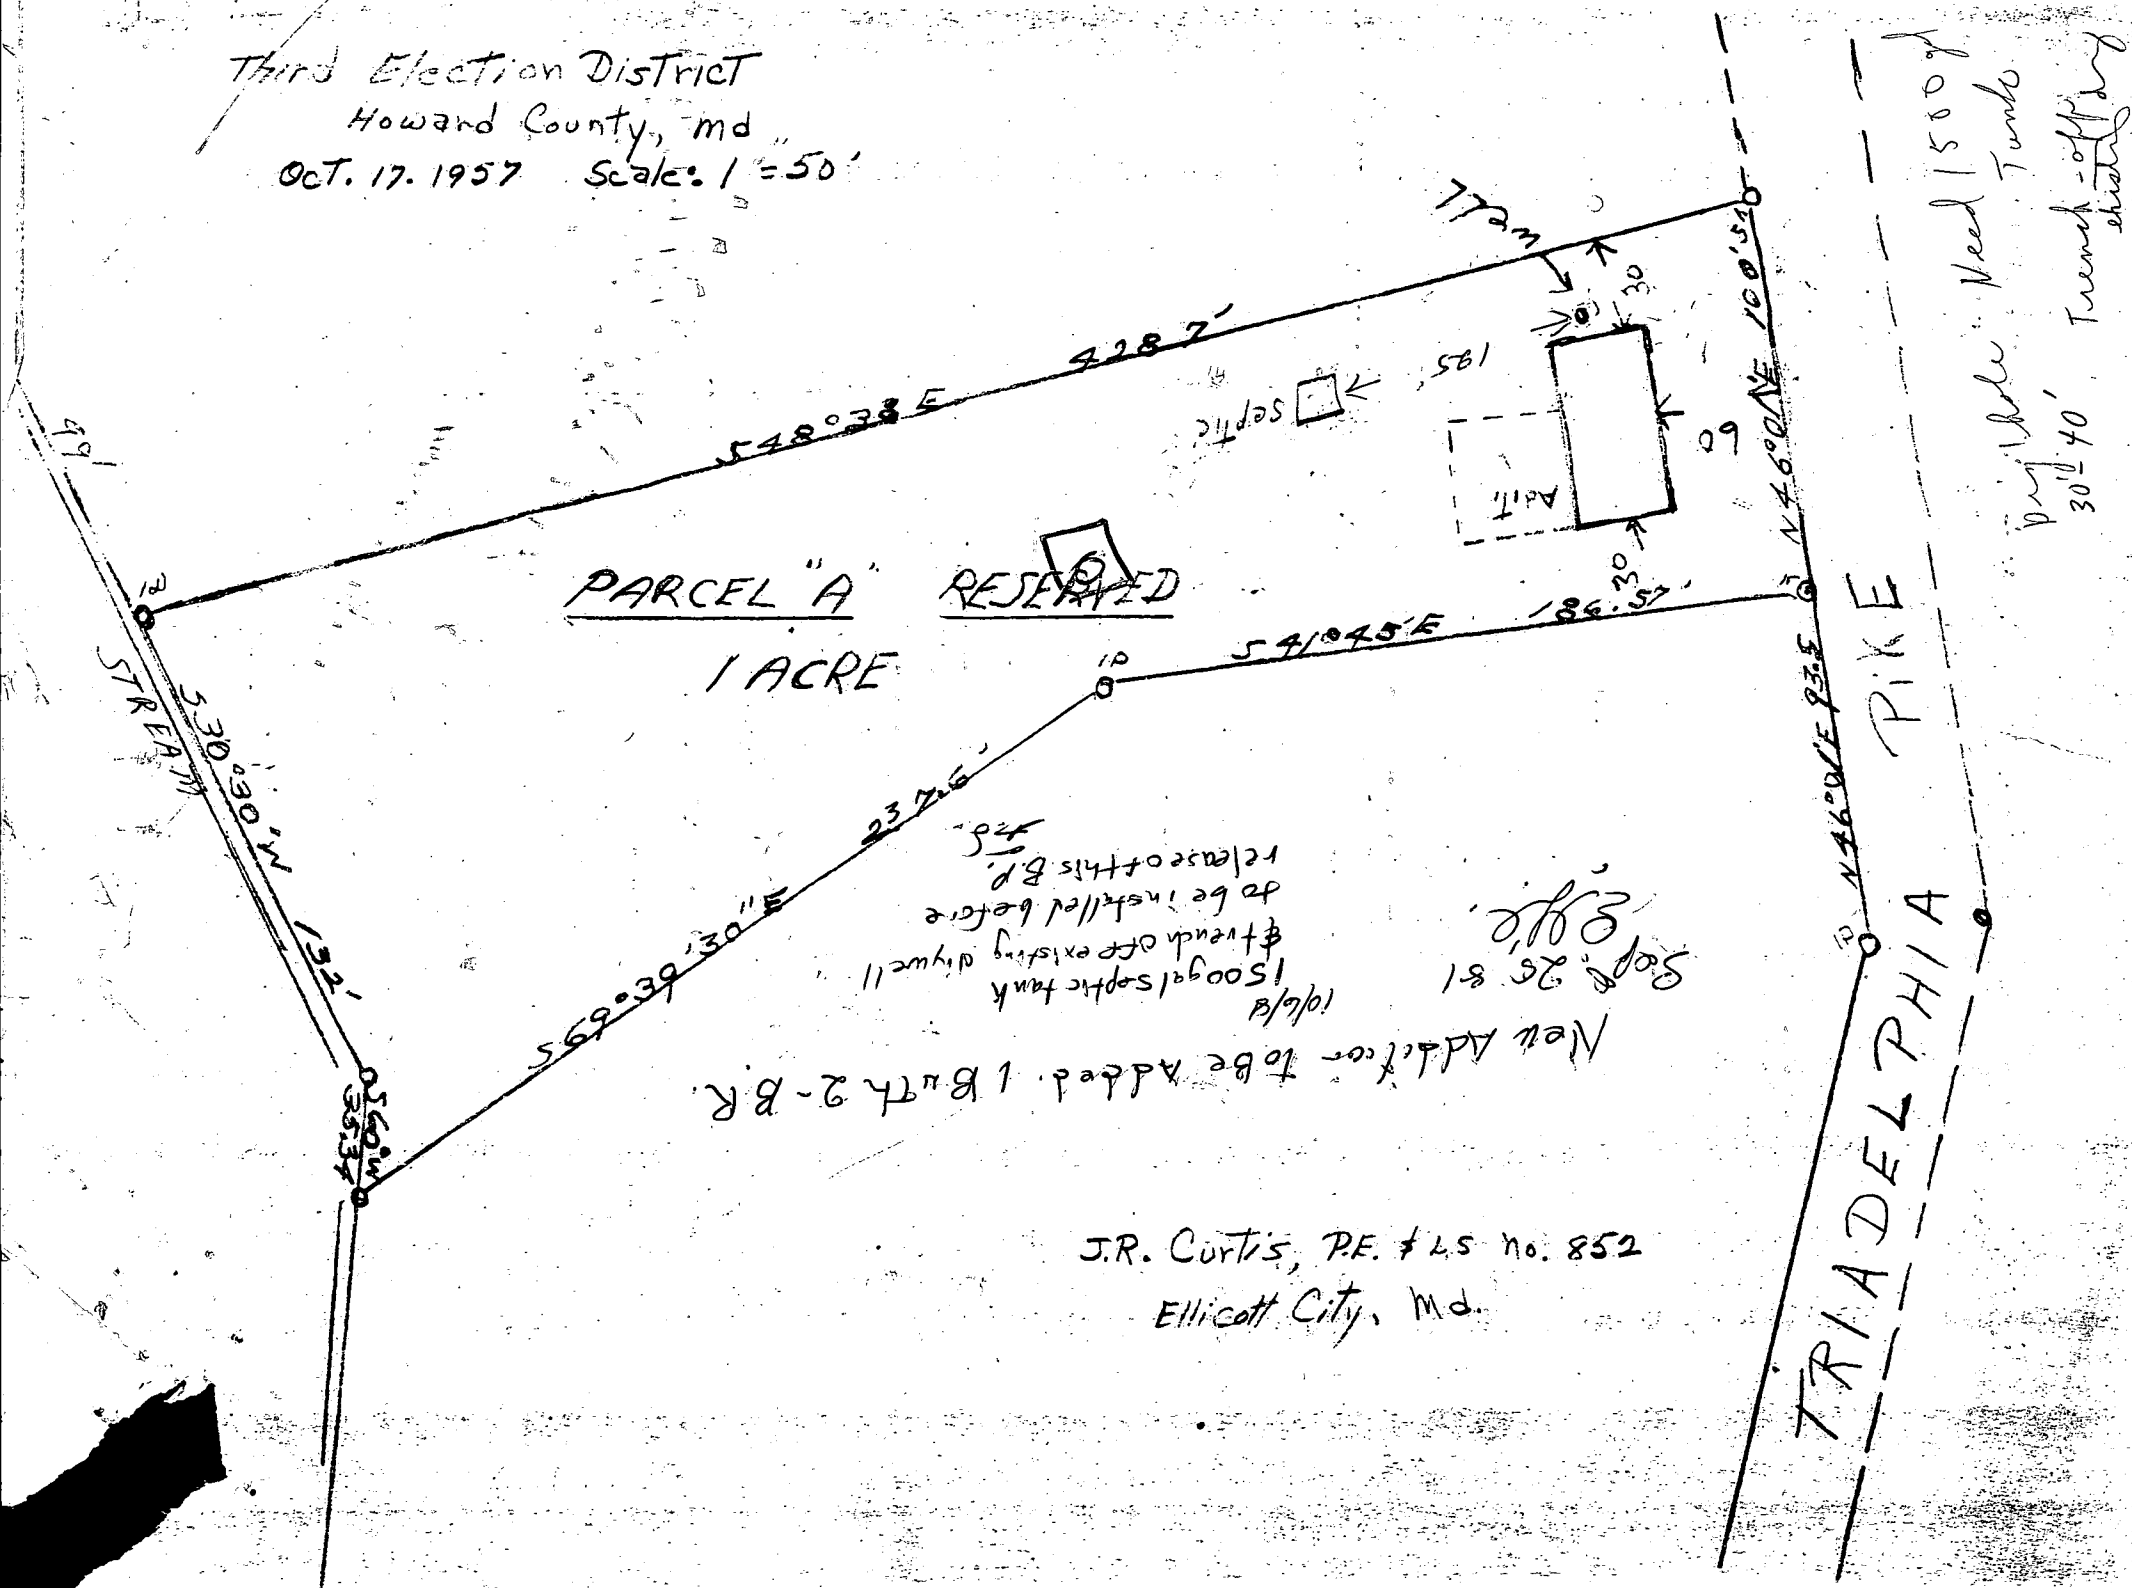

PERMIT

SEWAGE DISPOSAL SYSTEM

MARYLAND STATE DEPARTMENT OF HEALTH

HOWARD COUNTY

INDEXED

ELLICOTT CITY

DISTRICT 3

DATE 2/4/74

3/11/74 Rex Luther of Catonsville Plumbing & Heating
did work. System completely covered now. I did
see cleanout for new D.W. WWZ.

Emory Cornwell

IS PERMITTED TO INSTALL

ALTER X

ADDRESS 12196 Triadelphia Road, Ellicott City, Md.

PHONE 988-9221

A SEWAGE DISPOSAL SYSTEM LOCATED AT

SUBDIVISION ROAD 12196 Triadelphia Rd. LOT

PROPERTY OWNER Emory Cornwell

ADDRESS

SPECIFICATIONS

DRAIN FIELD DEPTH FEET, BOTTOM AREA SQ. FT.

SEEPAGE PITS ABSORBENT SIDE-WALL AREA SQ. FT.

SEPTIC TANK CAPACITY GALLONS

FOR GARBAGE GRINDER, INCREASE DISPOSAL AREA 22% & TANK CAPACITY 50%.

OTHER REPAIR - Dry well - to be inspected by Sanitarian.

2/5/74

At time of inspection drywell was dig 12 1/2 ft deep
and had 6-7 rows of blocks. Suggested that Mr. Cornwell
connect new well off of existing drywell. R.T.


PLANS APPROVED BY Robert T. Moorefield

DATE 2/4/74

FILL SEPTIC TANK AND DISTRIBUTION BOX WITH WATER BEFORE CALLING FOR AN INSPECTION. COVER NO WORK
UNTIL INSPECTED AND APPROVED.

NEITHER THE HOWARD COUNTY COMMISSIONERS NOR THE HEALTH DEPARTMENT IS RESPONSIBLE FOR THE
SUCCESSFUL OPERATION OF ANY SYSTEM.

19500

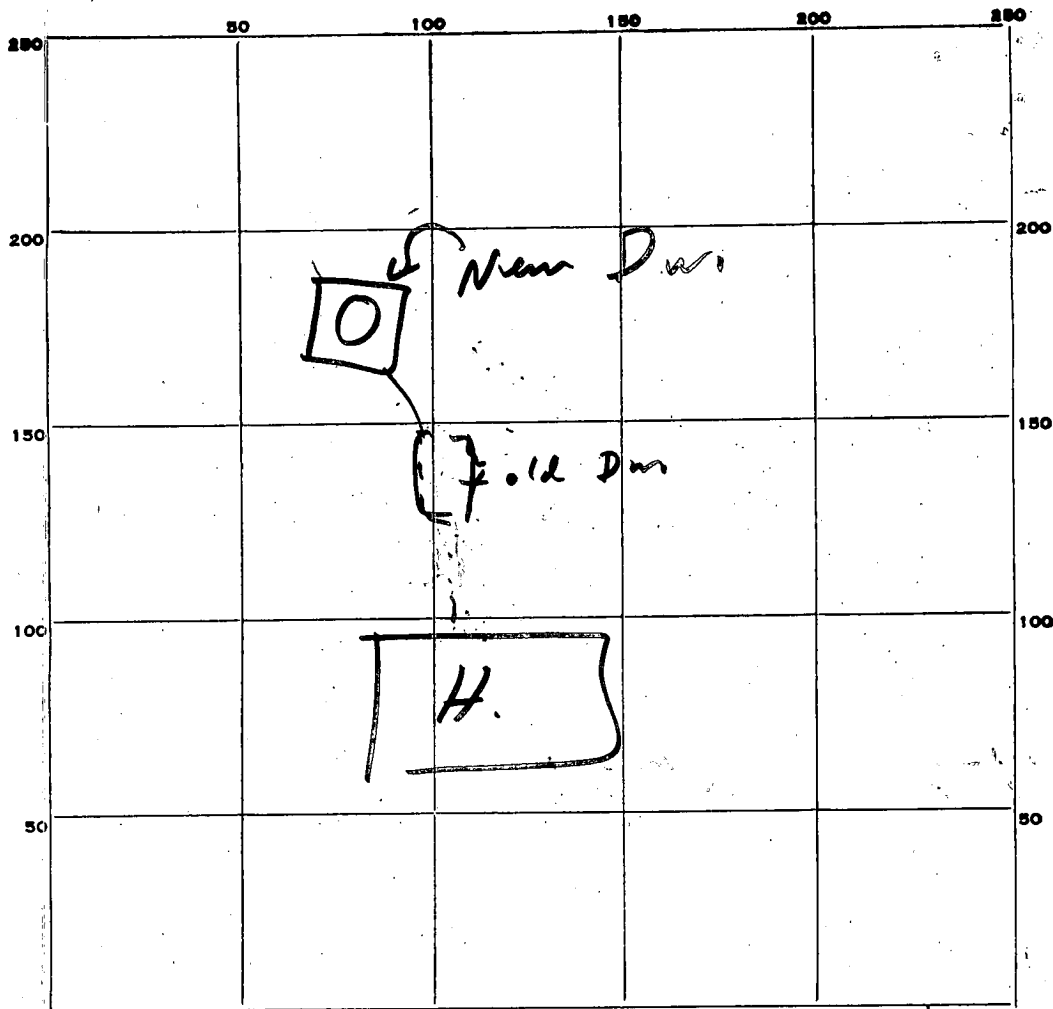

INDICATE NORTH. - NAME ADJOINING ROADWAY AS BASE LINE.

Tridelfhai → N

PERMIT CARD _____

SEPTIC TANK, LEVEL _____

CLEANOUTS _____

DISTRIBUTION BOX, LEVEL _____

TILE FIELD, DEPTH _____ FT. TRENCH WIDTH _____ FT.

GRAVEL DEPTH _____ IN. TOTAL LENGTH _____ FT.

NUMBER OF TRENCHES _____ TOTAL BOTTOM AREA _____

SEEPAGE PITS, INSIDE DIAMETER _____ FT. DEPTH BELOW INLET _____ FT.

ABSORBENT AREA _____ SQ. FT.

REMARKS _____

DATE SYSTEM APPROVED

3/11/74

INSPECTOR

R.M. E.W.K.B.

PERMIT

SEWAGE DISPOSAL SYSTEM

MARYLAND STATE DEPARTMENT OF HEALTH

HOWARD COUNTY

P 03480

A 03358

ELLICOTT CITY

DISTRICT 3

INDEXED

DATE 3-22-61

Emory Cornwell

IS PERMITTED TO INSTALL ☒ ALTER ☐

12196
ADDRESS Triadelphia Rd., Ellicott City PHONE Ri. 4-3143

A SEWAGE DISPOSAL SYSTEM LOCATED AT Triadelphia Rd. approximately 1 mile south of
Rt. 144 on the right hand side.

SUBDIVISION ROAD LOT

PROPERTY OWNER Emory Cornwell

ADDRESS above

SPECIFICATIONS

DRAIN FIELD DEPTH FEET, BOTTOM AREA SQ. FT.

SEEPAGE PITS ABSORBENT SIDE-WALL AREA SQ. FT.

SEPTIC TANK CAPACITY 750 GALLONS

FOR GARBAGE GRINDER, INCREASE DISPOSAL AREA 22% & TANK CAPACITY 50%.

OTHER One dry well 10 ft. in diameter by 11½ ft. deep below the inlet located
175 ft. from front property line and 42 ft. from the right side property line.

Right side property line determined when facing lot from Triadelphia Rd.


Septic tank cannot be installed more than 3 feet below original grade.

PLANS APPROVED BY James E. Hennigan DATE 3-10-61

FILL SEPTIC TANK AND DISTRIBUTION BOX WITH WATER BEFORE CALLING FOR AN INSPECTION. COVER NO WORK UNTIL INSPECTED AND APPROVED.

NEITHER THE HOWARD COUNTY COMMISSIONERS NOR THE HEALTH DEPARTMENT IS RESPONSIBLE FOR THE SUCCESSFUL OPERATION OF ANY SYSTEM.

A 03358

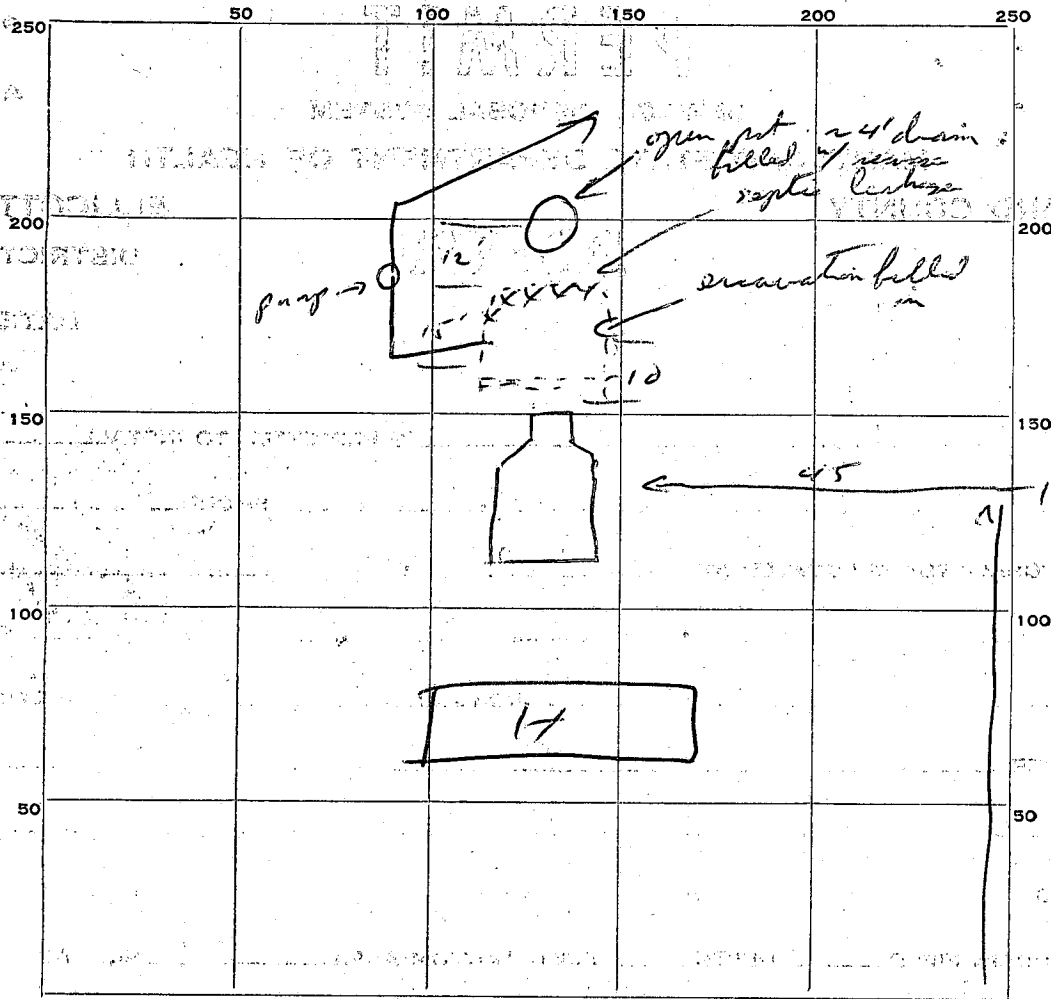

INDICATE NORTH. - NAME ADJOINING ROADWAY AS BASE LINE.

Triadelphia + N

PERMIT CARD

SEPTIC TANK, LEVEL

CLEANOUTS

DISTRIBUTION BOX, LEVEL

TILE FIELD, DEPTH

FT.

TRENCH WIDTH

FT.

GRAVEL DEPTH

IN.

TOTAL LENGTH

FT.

NUMBER OF TRENCHES

TOTAL BOTTOM AREA

SEEPAGE PITS, INSIDE DIAMETER

FT.

DEPTH BELOW INLET

FT.

ABSORBENT AREA

SQ. FT.

REMARKS

DATE SYSTEM APPROVED

INSPECTOR

APPLICATION

SEWAGE DISPOSAL TESTING

MARYLAND STATE DEPARTMENT OF HEALTH

HOWARD COUNTY

ELLICOTT CITY

DISTRICT 3 th
DATE 2023-61

TO: THE COUNTY HEALTH OFFICER
ELLICOTT CITY, MARYLAND

I, HEREBY, APPLY FOR THE NECESSARY TESTS IN ORDER TO CONSTRUCT (OR RECONSTRUCT) A SEWAGE DISPOSAL SYSTEM.

PROPERTY OWNER Cornwell, Emory

ADDRESS Tridelphia Road PHONE Ri 4-3143

PROPERTY LOCATION:

SUBDIVISION _____ LOT NO. _____

ROAD AND DESCRIPTION Tridelphia Rd. app. 1 mile south of 144
on the right hand side

OCCUPANT _____ PHONE _____

PERSON TO CONSTRUCT SYSTEM _____

ADDRESS _____ PHONE _____

SIZE OF LOT 1 1/2 acre TYPE BLDG. 3
NUMBER OF BEDROOMS

IF NOT SINGLE RESIDENCE DESCRIBE _____

SIGNATURE OF APPLICANT Emory D. Cornwell


APPROVED BY J. Henningan FOR Dry Well DATE 3-10-61

REJECTED BY _____ FOR _____ DATE _____
(KIND OF SYSTEM)

HOLD PENDING FURTHER TESTS _____ DATE _____

REASONS FOR REJECTION OR HOLDING _____

THIS IS NOT A PERMIT

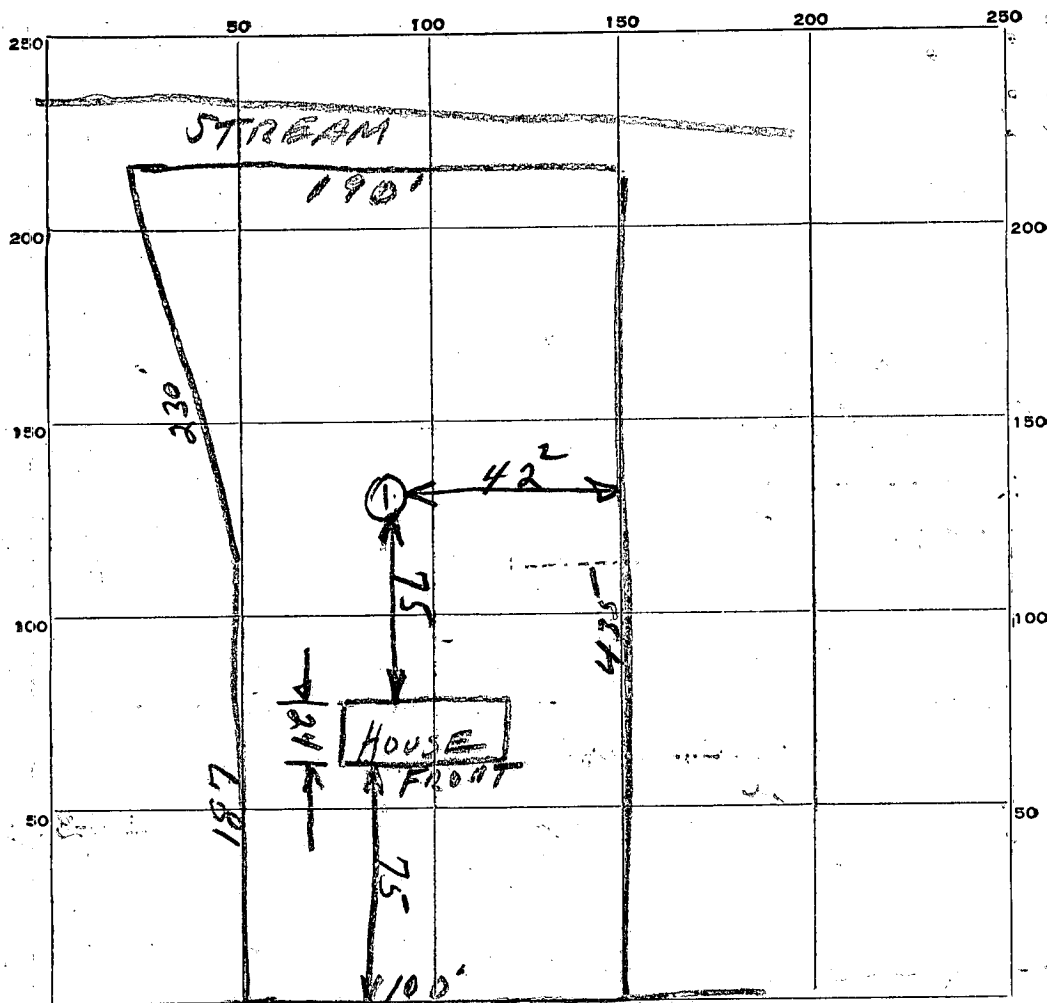

INDICATE NORTH. - NAME ADJOINING ROADWAY AS BASE LINE.

TRIDELPHIA ROAD

[illegible]

SOIL AUGER FINDING

TESTED BY

REMARKS.


ALSO PRESENT

LOT NO.

Third Election District

Howard County, Md.

OCT. 17. 1957 Scale: 1" = 50'

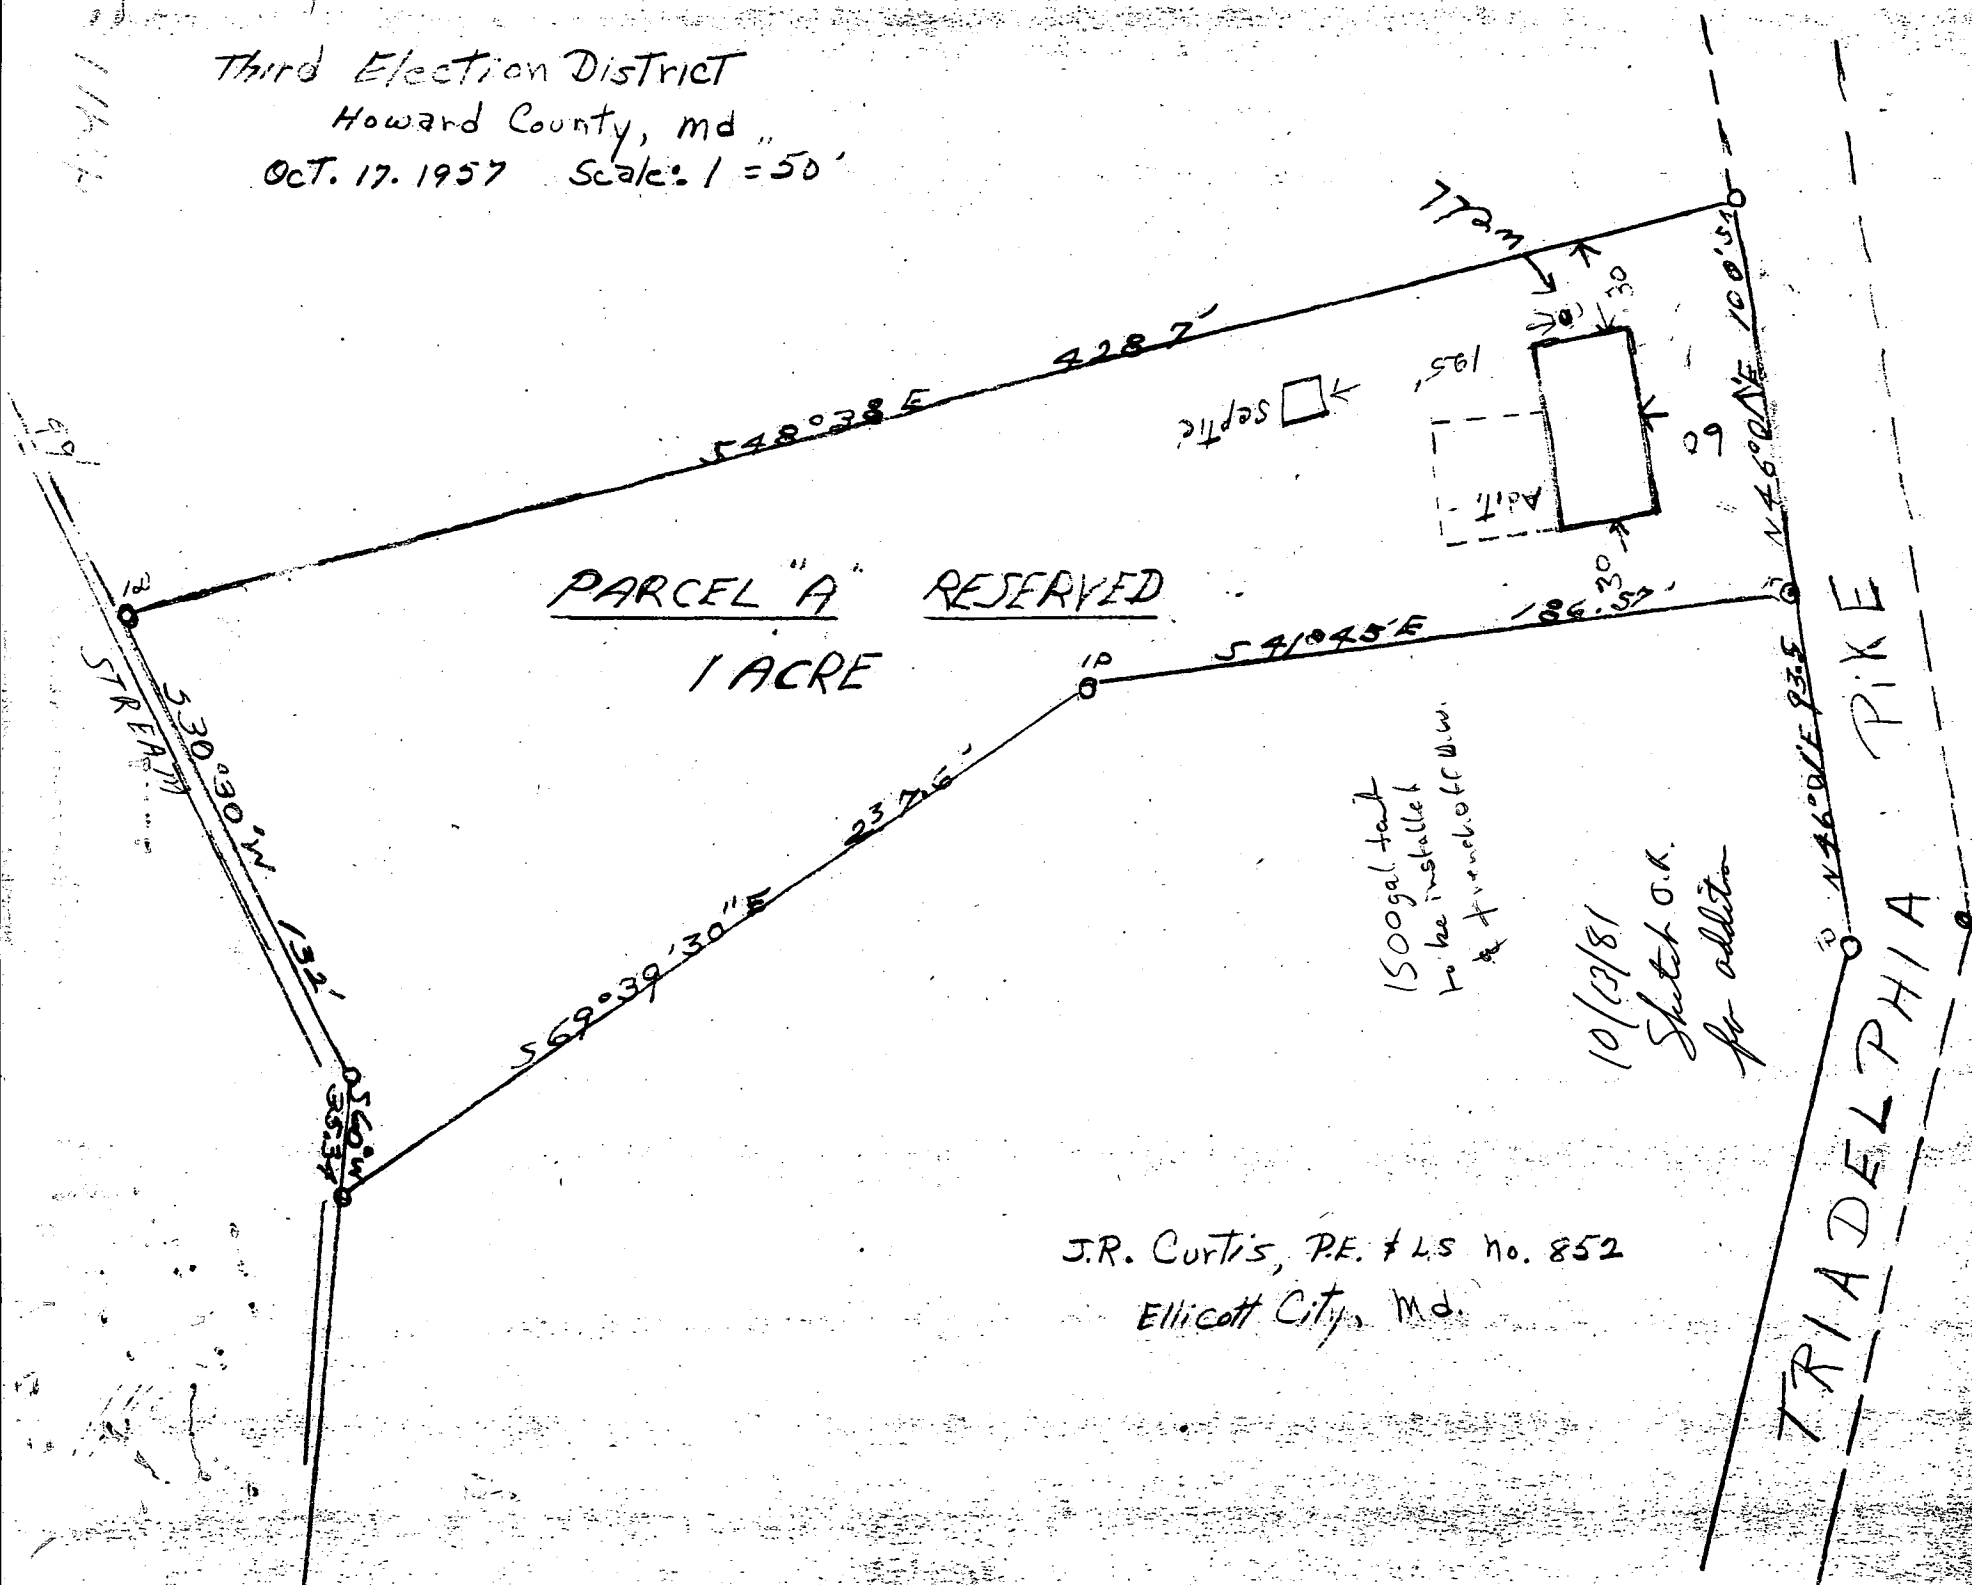

Third Election District
Howard County, Md.

Oct. 17, 1957 Scale: 1" = 50'

Proposed addition
16x20/9x10 L shaped approx.
410 sf.

ADDITION
"FOR LIVING ROOM"
✓ PER CORRESPONDENCE
3/19/47

PARCEL "A" RESERVED
1 ACRE

File # P316260

12/31/46

Proposed addition

OK as shown - OK


to sign walk-thru

BP.

(DKS)


J.R. Curtis, P.E. #LS No. 852
Ellicott City, Md.

TRIADELPHIA PIKE

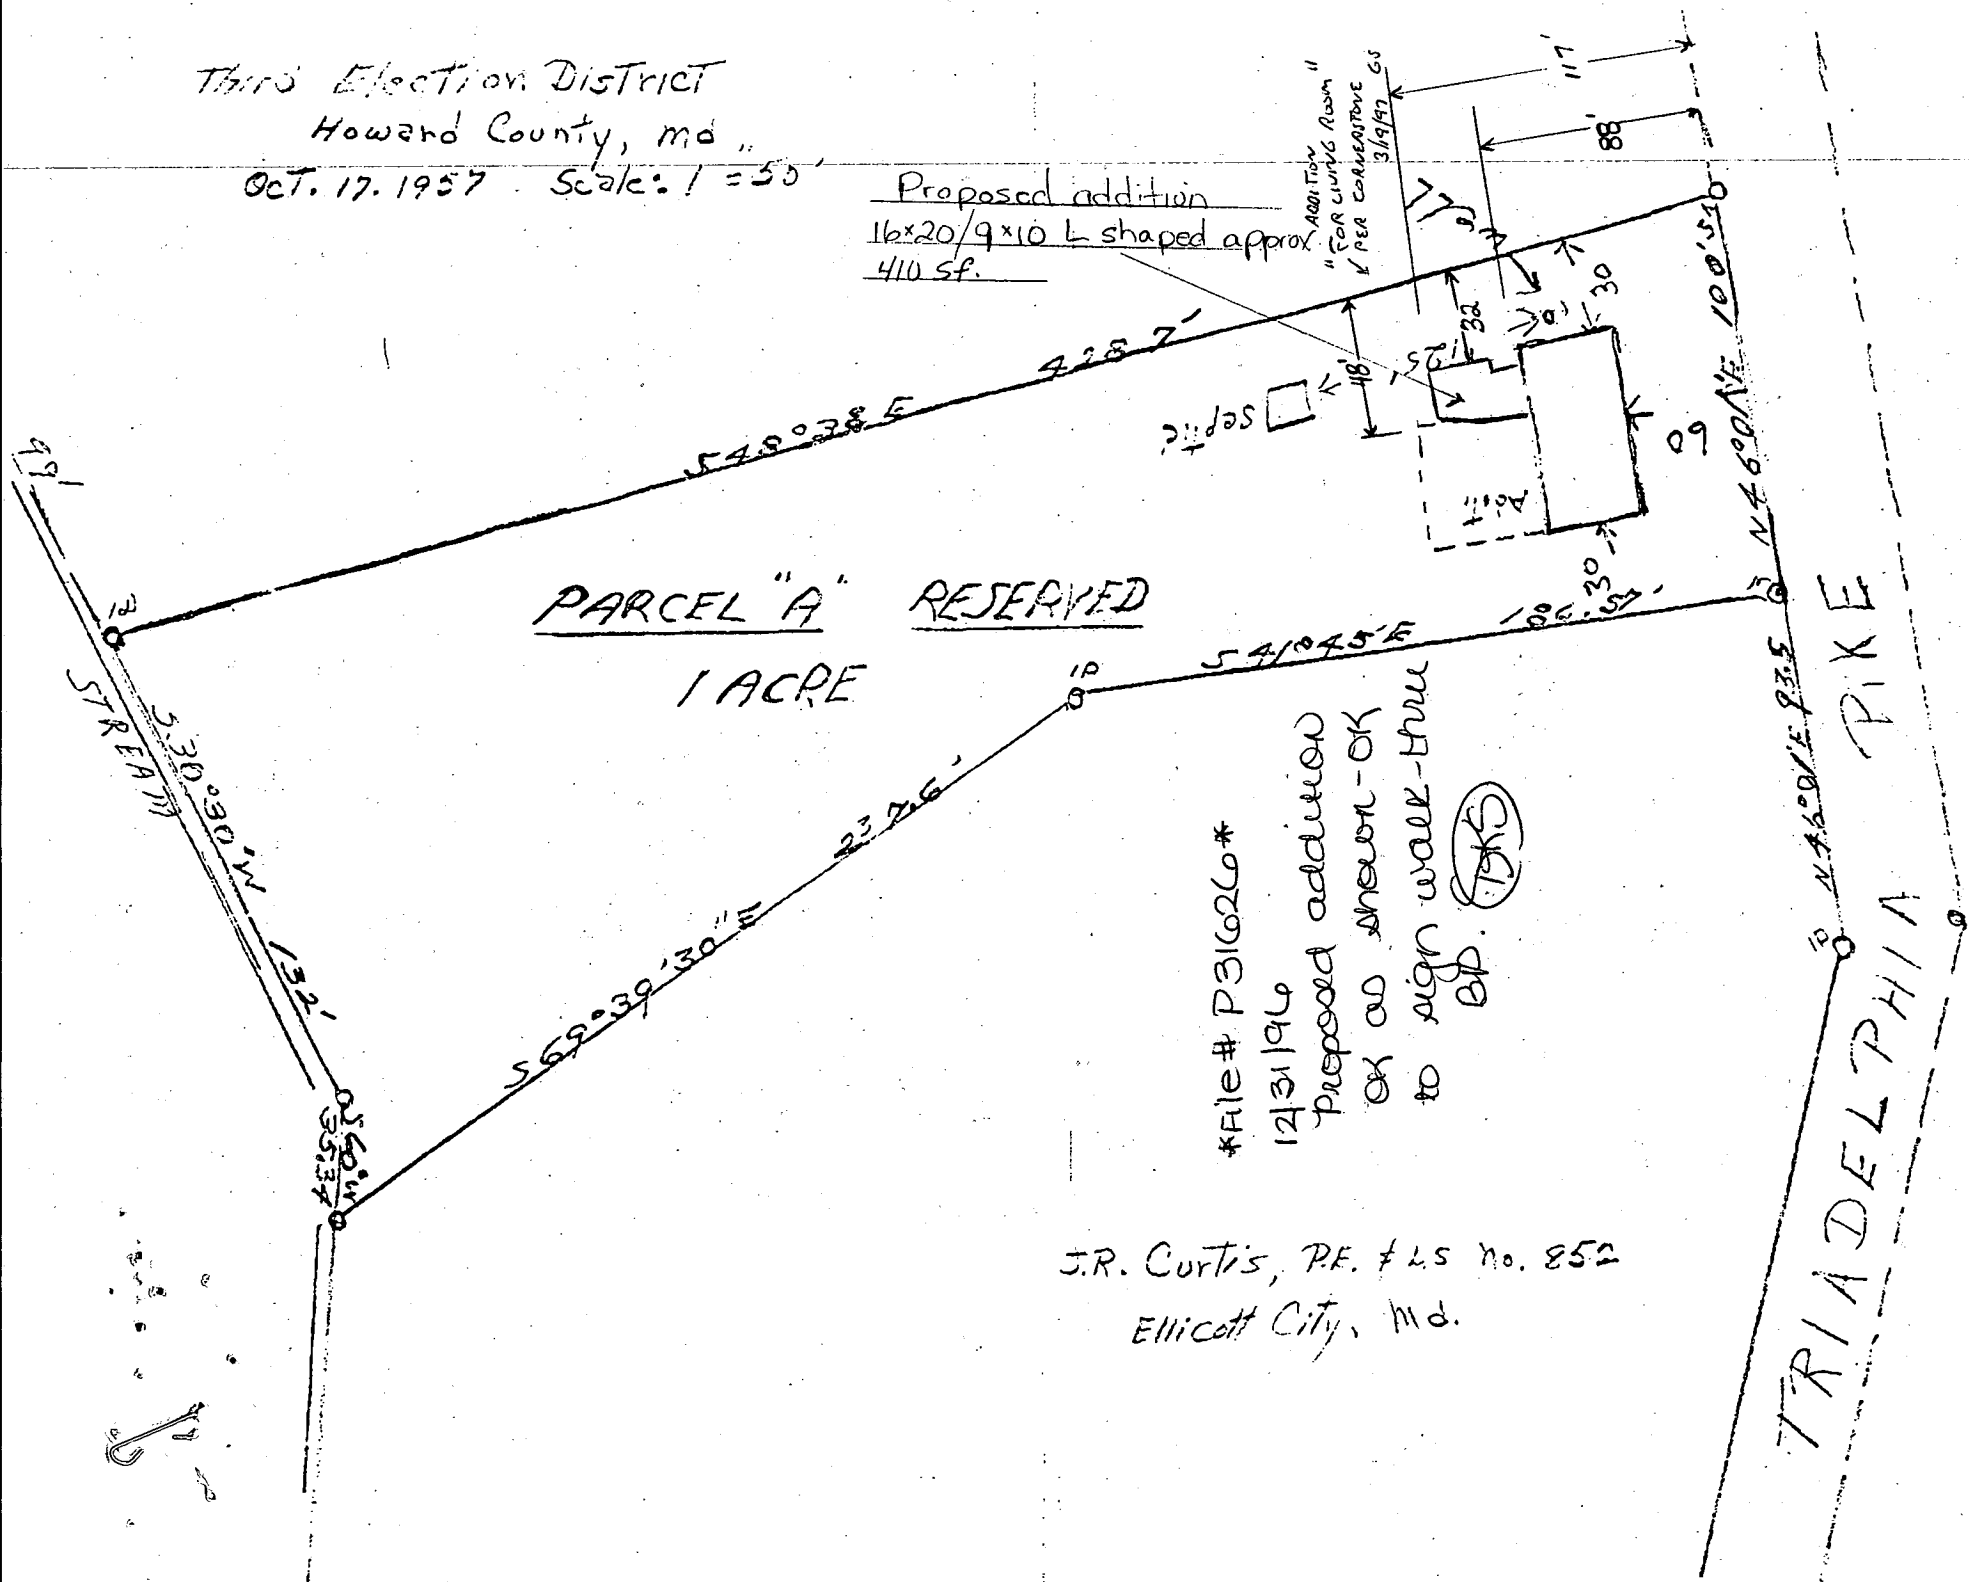

Third Election District
Howard County, Md.
Oct. 17, 1957 Scale: 1" = 50'

~~Proposed deck on
16x20/9x12 shaped approx
410 sq. ft.~~

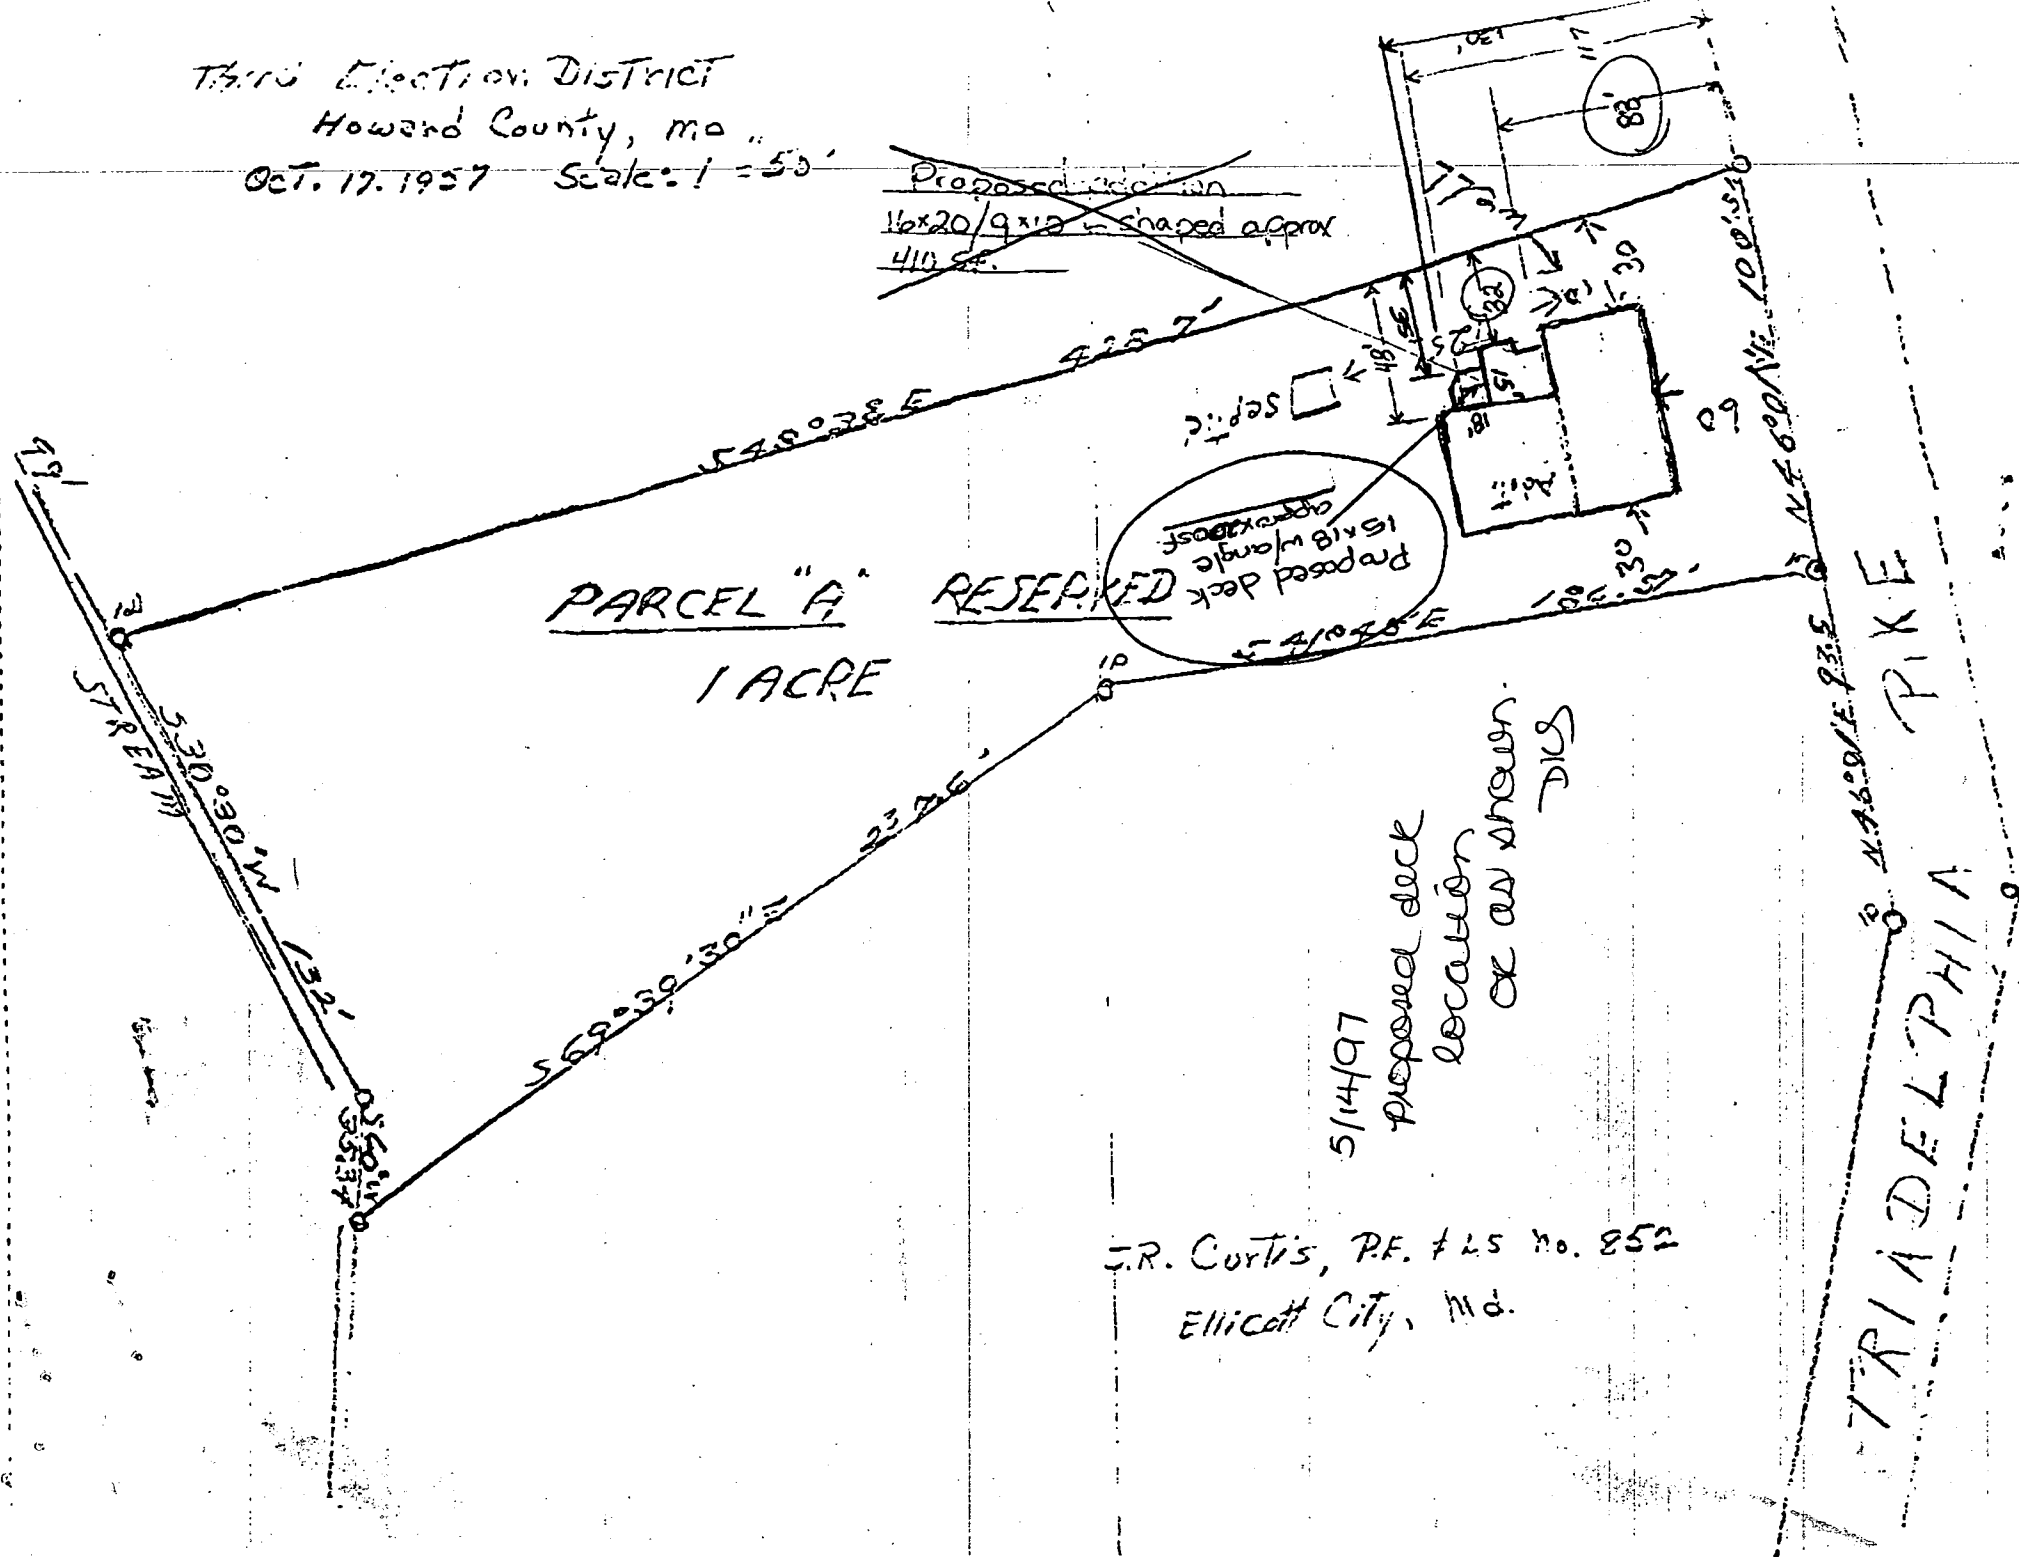

PARCEL "A" RESERVED
1 ACRE

Proposed deck
15x18 w/angle
approx 150°

Septic

5/14/97
Proposed deck
location
as shown
DLC

J.R. Curtis, P.E. #25 No. 852
Ellicott City, Md.

TRIADELPHIA PIKE