

11/2/81 FILE APPROVED
P 31678

PERMIT

SEWAGE DISPOSAL SYSTEM

MARYLAND STATE DEPARTMENT OF HEALTH

HOWARD COUNTY

04-330897

ELLICOTT CITY

DISTRICT 3rd

DATE 10/23/81

INDEX

Jack Fyock

IS PERMITTED TO INSTALL ALTER X

ADDRESS 13775 Triadelphia Road, Glenelg, Md. PHONE 988-9270

SUBDIVISION ROAD 1416 Underwood Road also LOT known as 1252 Underwood Road

PROPERTY OWNER James Welling

ADDRESS 13550 Old Frederick Road, Sykesville, Md. 21784

SPECIFICATIONS

(1) SEPTIC TANK CAPACITY 1000 GALLONS

DRAIN FIELD DEPTH FEET, BOTTOM AREA SQ. FT.

DEEP TRENCH DEPTH FEET, BOTTOM AREA SQ. FT.

(1) SEEPAGE PITS 15'x15' ABSORBENT SIDE-WALL AREA 360+ SQ. FT.

INLET PIPE 3'-4 1/2 FT. BELOW ORIGINAL GRADE. MAXIMUM DEPTH 10'-10 1/2 FT. BELOW ORIGINAL GRADE

EFFECTIVE DEPTH AT 3 FT. BELOW ORIGINAL GRADE.

LOCATE DISPOSAL AREA FT. FROM LOT LINE AND FT. FROM LOT LINE AS SEEN WHEN

FACING LOT FROM 39' from left rear corner of existing house when facing house from Underwood Road. ① HOLE.

REPAIR - Call for an appointment when ground is opened up and Sanitarian will

recommend the repair system.

Recommend 1-1000 gallon

tank + 1 (15' 15' Dry Well) depth 3'-4 1/2 and 10' diameter

Depth of Dry Well - in area as shown on sketch. Replace pipes where needed.

PLANS APPROVED BY Palmer F. Wine

DATE 10/23/81

COVER NO WORK UNTIL INSPECTED AND APPROVED.

NEITHER THE HOWARD COUNTY COUNCIL NOR THE HEALTH DEPARTMENT IS RESPONSIBLE FOR THE SUCCESSFUL OPERATION OF ANY SYSTEM.

NOTE: IF TRENCH IS USED CALL FOR INSPECTION BEFORE PLACING GRAVEL IN TRENCH.

NOTE: NO DRY WELL SHALL EXCEED 15 FOOT IN DIAMETER.


NOTE: ALL PIPE FROM HOUSE TO DISPOSAL AREA MUST BE CAST IRON.

PERMIT VOID AFTER THREE YEARS.

NOTE: INSTALL STAND PIPE ON SEPTIC TANK AND DRY WELL. STAND PIPES MUST BE 6 INCHES IN DIAMETER. CAST IRON, CONCRETE OR TERRA COTTA ACCEPTED.

*INSTALLER IS RESPONSIBLE FOR OBTAINING FINAL APPROVAL ON THIS PERMIT.

10.3.1678

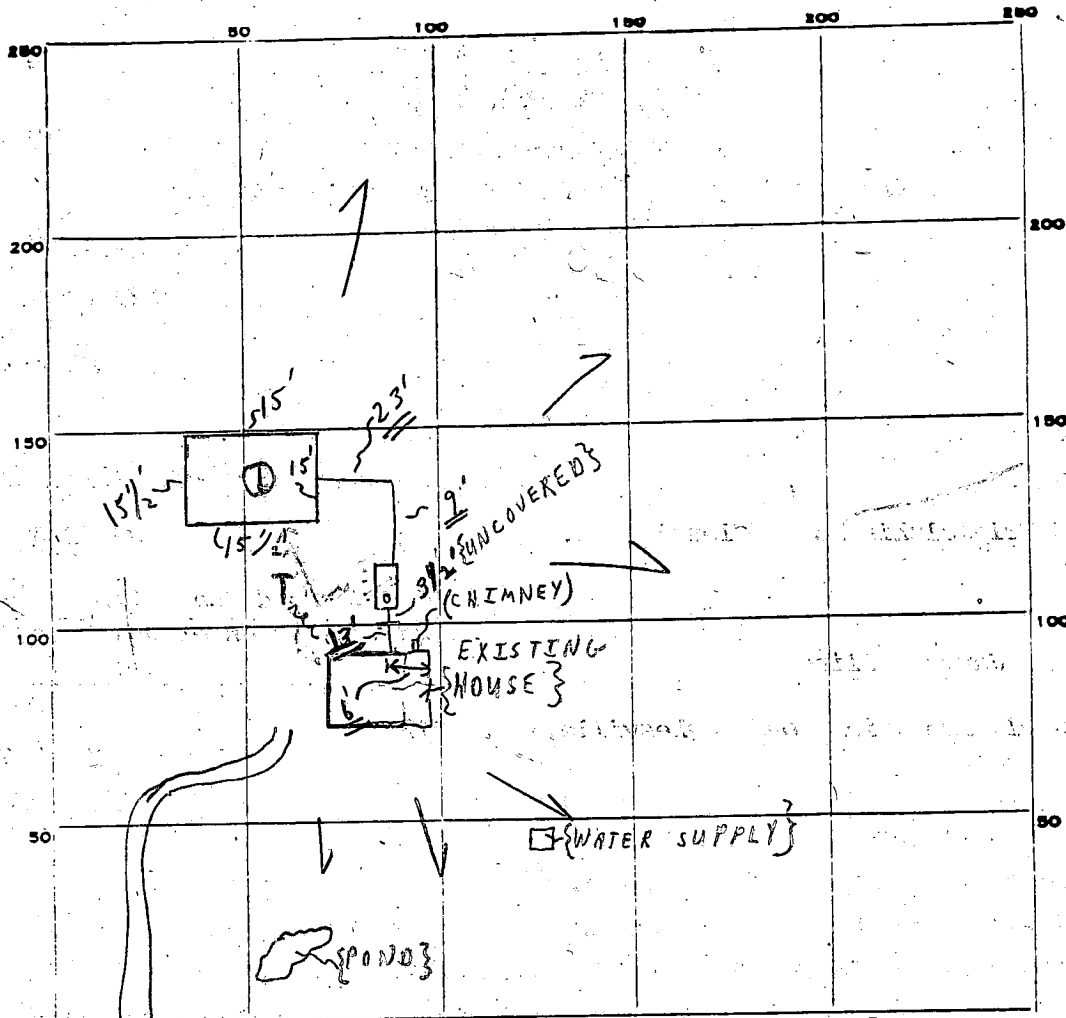

PERMIT CARD

SEPTIC TANK, LEVEL

CLEANOUTS

DISTRIBUTION BOX, LEVEL

TILE FIELD, DEPTH _____ FT. TRENCH WIDTH _____ FT.

GRAVEL DEPTH _____ IN. TOTAL LENGTH _____ FT.

NUMBER OF TRENCHES _____ TOTAL BOTTOM AREA _____

SEEPAGE PITS, INSIDE DIAMETER outside perimeter 61 FT. DEPTH BELOW INLET 6.5 + FT.

ABSORBENT AREA 397⁺ SQ. FT.

REMARKS 10/29/81 OK TO START WORK ON DRY WELL, ETC. 11/2/81 SYSTEM COMPLETE.
C.B.D.

DATE SYSTEM APPROVED

INSPECTOR