

PERMIT

SEWAGE DISPOSAL SYSTEM

MARYLAND STATE DEPARTMENT OF HEALTH

HOWARD COUNTY

ELLICOTT CITY

DISTRICT

DATE 4/8/82

INDEX

Fogle Septic Cleaners

IS PERMITTED TO INSTALL ALTER X

ADDRESS 1115 Streaker Road, Sykesville, Maryland 21784 PHONE 795-5670

SUBDIVISION Albeth Heights ROAD Marriottsville Rd. LOT 2, Blk.A

PROPERTY OWNER Mr. Gabriel McClellan 442-1143

ADDRESS Marriottsville Road

SPECIFICATIONS

SEPTIC TANK CAPACITY _____ GALLONS

DRAIN FIELD _____ DEPTH _____ FEET, BOTTOM AREA _____ SQ. FT.

DEEP TRENCH _____ DEPTH _____ FEET, BOTTOM AREA _____ SQ. FT.

SEEPAGE PITS _____ ABSORBENT SIDE-WALL AREA _____ SQ. FT.

INLET PIPE _____ FT. BELOW ORIGINAL GRADE. MAXIMUM DEPTH _____ FT. BELOW ORIGINAL GRADE

EFFECTIVE DEPTH AT _____ FT. BELOW ORIGINAL GRADE.

LOCATE DISPOSAL AREA _____ FT. FROM _____ LOT LINE AND _____ FT. FROM _____ LOT LINE AS SEEN WHEN

FACING LOT FROM

REPAIR - CALL FOR INSPECTION WHEN GROUND IS OPENED UP SO SANITARIAN CAN

RECOMMEND REPAIR

Replace septic tanks and distribution box

PLANS APPROVED BY Palmer F. Wine DATE April 8, 1982

COVER NO WORK UNTIL INSPECTED AND APPROVED.

NEITHER THE HOWARD COUNTY COUNCIL NOR THE HEALTH DEPARTMENT IS RESPONSIBLE FOR THE SUCCESSFUL OPERATION OF ANY SYSTEM.

NOTE: IF TRENCH IS USED CALL FOR INSPECTION BEFORE PLACING GRAVEL IN TRENCH.

NOTE: NO DRY WELL SHALL EXCEED 15 FOOT IN DIAMETER.

NOTE: ALL PIPE FROM HOUSE TO DISPOSAL AREA MUST BE CAST IRON.

PERMIT VOID AFTER THREE YEARS.

NOTE: INSTALL STAND PIPE ON SEPTIC TANK AND DRY WELL. STAND PIPES MUST BE 6 INCHES IN DIAMETER. CAST IRON, CONCRETE OR TERRA COTTA ACCEPTED.

*INSTALLER IS RESPONSIBLE FOR OBTAINING FINAL APPROVAL ON THIS PERMIT.


BLDG. PERMIT SIGNED

AND RETURNED

Serial # 57605

Added

EH-2-1079

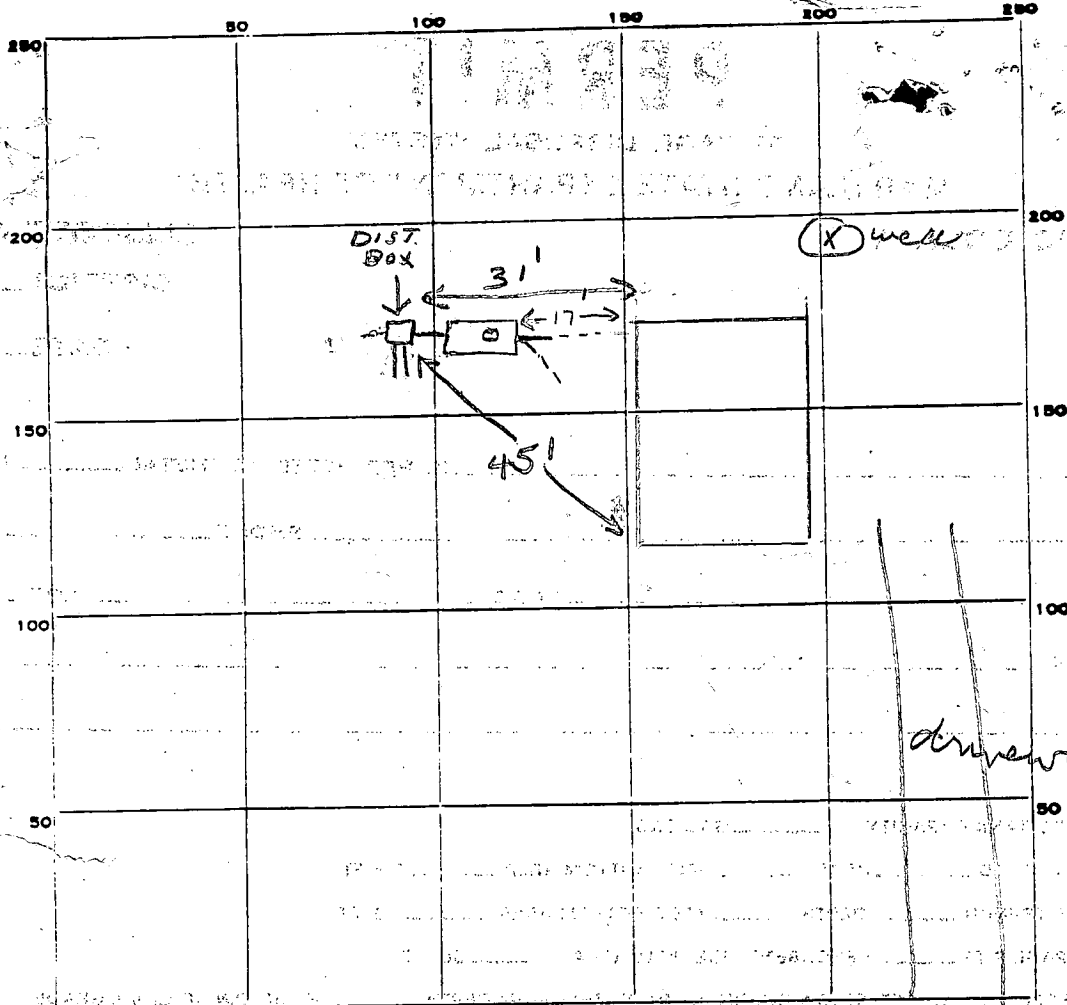

INDICATE NORTH. - NAME ADJOINING ROADWAY AS BASE LINE.

Alveth Rd.

PERMIT CARD ☒

SEPTIC TANK, LEVEL ☒

CLEANOUTS *ST* ☒

DISTRIBUTION BOX, LEVEL ☒

TILE FIELD, DEPTH _____ FT. TRENCH WIDTH _____ FT.

GRAVEL DEPTH _____ IN. TOTAL LENGTH _____ FT.

NUMBER OF TRENCHES _____ TOTAL BOTTOM AREA _____

SEEPAGE PITS, INSIDE DIAMETER _____ FT. DEPTH BELOW INLET _____ FT.

ABSORBENT AREA _____ SQ. FT.

REMARKS *4/13/82 OK to core, all work done*

DATE SYSTEM APPROVED

4/13/82

INSPECTOR

Stayer

CIC # 51605

Mac Paving

ALBETH

50' R/W

ROAD

Edgemont

U 70° 15' N

125.00' -

Residue
L=12.89'

R=75.00'
L=26.38'

U 19° 25' E




COMMIT
TO TENITE
SHIELDS

SHOW THAT
NO DRIVEWAY
CUT THE WELL

11700' BY PLACEMENT
OF DOOR
GLT
ON BY RAISING
OF DOOR AND
BARRIERS IT

Mac Drive NECESSARY

50' B.R.L.

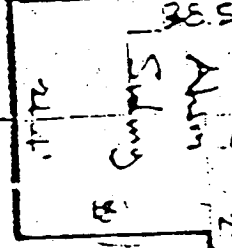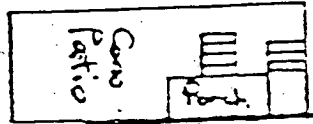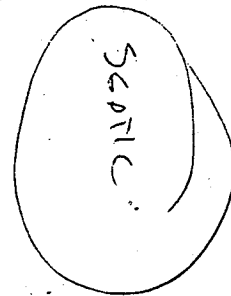

16' OWNER
GARAGE
&
EIGHT FOOT
ADDITION TO HOUSE
WHICH ENCOMPASSES
A BED ROOM,
AND ADDS A BATH.

SLAB ON GRADE
CONSTRUCTION - NO BASIN
EXCEPT FOR STEPS TO BACKYARD
ON SEPTIC SIDE OF HOUSE.

150'

5' Utility R/W

570° 15' E

139.42' RESIDUE

20' Well

CONDITION OF APPROVAL
BY HEALTH DEPT. 2/20/93

SUBJECT TO
APPLICANT'S COMMIT TO ABOVE

NEW R/W LINE
16.71'

U 12° 41' 10" E

SAVING & EXCEPTING PARCEL

10.55'


DAVID L. ROSE
11204 Albeth Rd.
MARIOTTSVILLE, Md.
21104

HOME
410.442.7624
WORK
410.313.7267

Albeth Heights has been
accepted into the metropolitan
area and will receive water and
sewer within a couple of years.
At the time it becomes
available, I will hook up to
the system.

[Signature]
Property owner

30/9/93

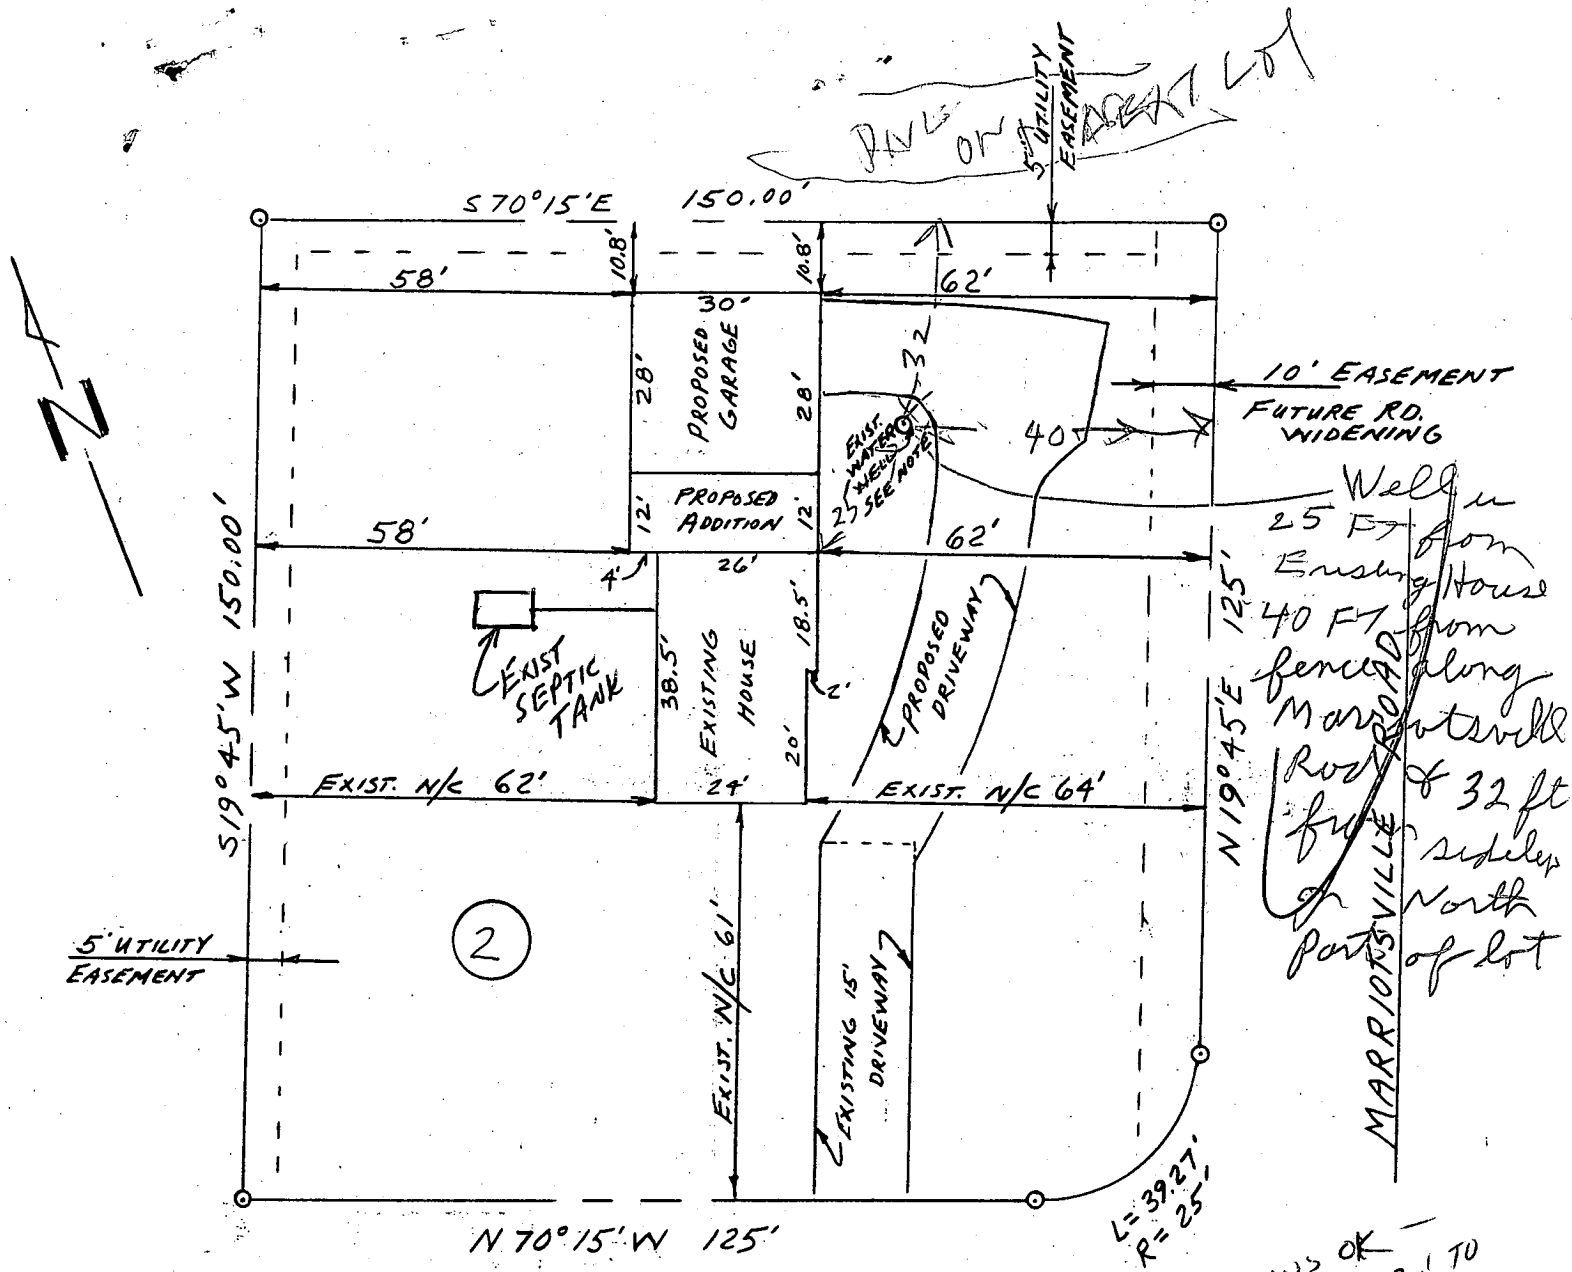

ALBETH ROAD

50' R/W

HEALTH DEPT. NOTE:

ACCESS IS DENIED TO DRIVEWAY
CROSSING PRIVATE WATER WELL
UNTIL PUBLIC WATER BECOMES
AVAILABLE & PRIVATE SYSTEM
IS ABANDONED.
ALSO NO CHEMICAL PESTICIDE
TREATMENT OF THE PROPOSED
CONSTRUCTION IS ALLOWED

lic # 51605

work 313-7267

SITE PLAN PROPOSED ADDITION
LOT #2 BLOCK A' SECT. 1
"ALBETH HEIGHTS"
PLAT BOOK 4 PAGE 50

11204 ALBETH ROAD
HOWARD COUNTY, MD

SCALE 1" = 30'
NOV. 22, 1993

PLANS OK -
LESS THAN 30' TO
WELL, BUT
ADEQUATE PROTECTION
PROVIDED.

PUBLIC WATER
ANTICIPATED
IN A "FEW"
YEARS.

12/2/93
Cwell