

5/14/82
around noon please

PERMIT

APPROVED
5/14/82
RH
P 31930
A REPAIR

SEWAGE DISPOSAL SYSTEM

MARYLAND STATE DEPARTMENT OF HEALTH

HOWARD COUNTY

05-352347

INDEX

ELLICOTT CITY

DISTRICT

5th

DATE 5/14/82

Jack Fyock

IS PERMITTED TO INSTALL ☒ ALTER

ADDRESS 13775 Triadelphia Road

PHONE 988-9270

SUBDIVISION ROAD 5806 Ten Oaks

LOT

PROPERTY OWNER Mr. Harjes

ADDRESS 5806 Ten Oaks, Clarksville, Md.

SPECIFICATIONS

3 BR

SEPTIC TANK CAPACITY GALLONS

DRAIN FIELD DEPTH FEET, BOTTOM AREA SQ. FT.

DEEP TRENCH 12 DEPTH FEET, BOTTOM AREA 360 SQ. FT.

SEEPAGE PITS ABSORBENT SIDE-WALL AREA SQ. FT.

INLET PIPE 5 FT. BELOW ORIGINAL GRADE. MAXIMUM DEPTH 14 FT. BELOW ORIGINAL GRADE

EFFECTIVE DEPTH AT 3 FT. BELOW ORIGINAL GRADE.

LOCATE DISPOSAL AREA FT. FROM LOT LINE AND FT. FROM LOT LINE AS SEEN WHEN FACING LOT FROM

REPAIR - CALL FOR INSPECTION WHEN GROUND IS OPENED UP SO SANITARIAN CAN RECOMMEND REPAIR

Run Ditch off old Dry Well

PLANS APPROVED BY Palmer F. Wine

DATE May 6, 1982

COVER NO WORK UNTIL INSPECTED AND APPROVED.

NEITHER THE HOWARD COUNTY COUNCIL NOR THE HEALTH DEPARTMENT IS RESPONSIBLE FOR THE SUCCESSFUL OPERATION OF ANY SYSTEM.

NOTE: IF TRENCH IS USED CALL FOR INSPECTION BEFORE PLACING GRAVEL IN TRENCH.

NOTE: NO DRY WELL SHALL EXCEED 15 FOOT IN DIAMETER.


NOTE: ALL PIPE FROM HOUSE TO DISPOSAL AREA MUST BE CAST IRON.

PERMIT VOID AFTER THREE YEARS.

NOTE: INSTALL STAND PIPE ON SEPTIC TANK AND DRY WELL. STAND PIPES MUST BE 6 INCHES IN DIAMETER. CAST IRON, CONCRETE OR TERRA COTTA ACCEPTED.

*INSTALLER IS RESPONSIBLE FOR OBTAINING FINAL APPROVAL ON THIS PERMIT.

X 31930

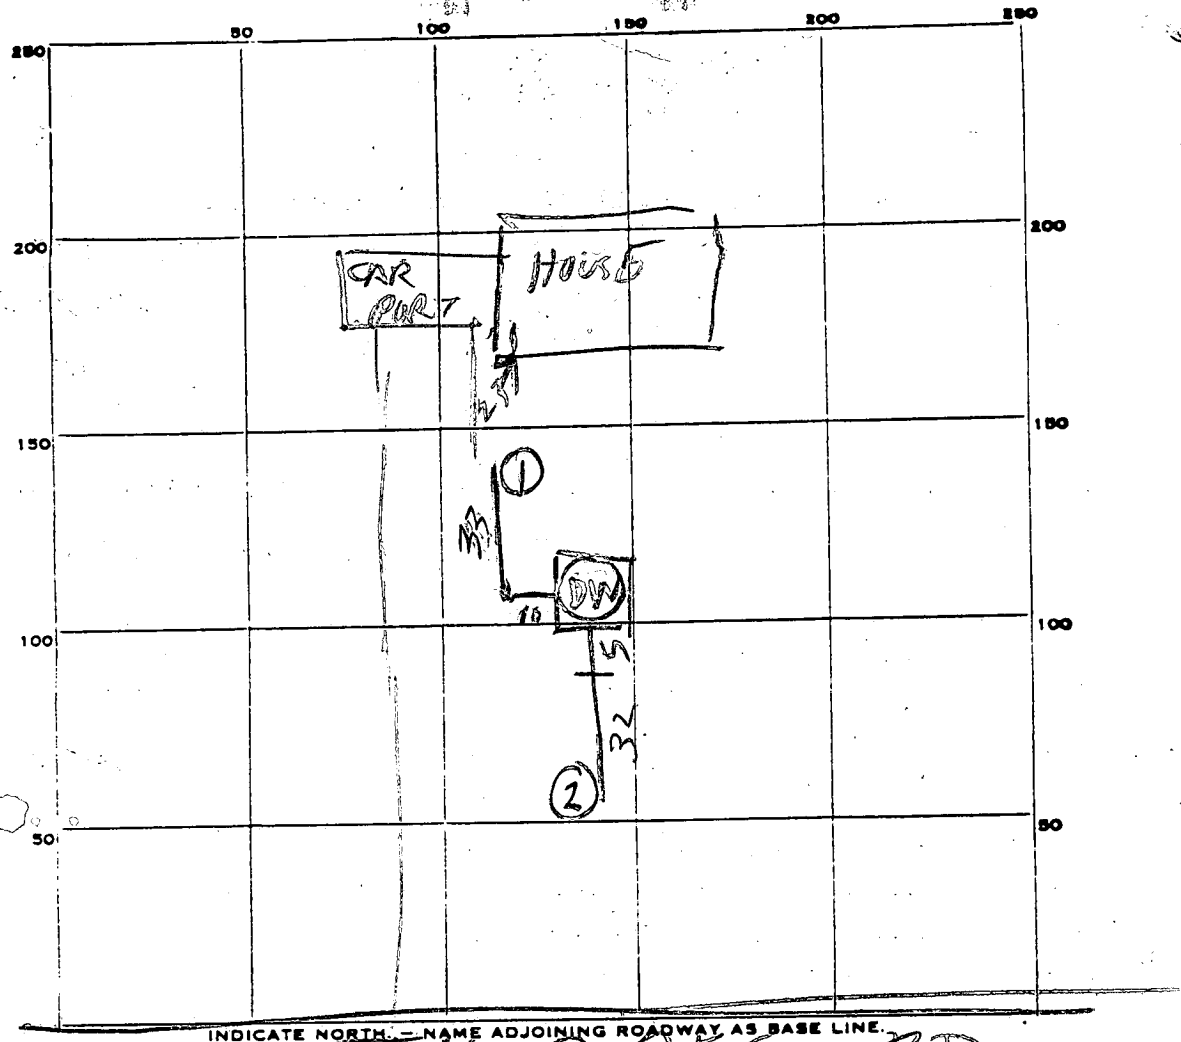

INDICATE NORTH - NAME ADJOINING ROADWAY AS BASE LINE.
TEN OAKS RD

PERMIT CARD _____

SEPTIC TANK, LEVEL _____ CLEANOUTS _____

DISTRIBUTION BOX, LEVEL _____

TILE FIELD, DEPTH 12 FT. TRENCH WIDTH 33 FT. #1 #2

GRAVEL DEPTH 7 FT. IN. TOTAL LENGTH 2 FT. #1 #2

NUMBER OF TRENCHES 2 TOTAL BOTTOM AREA 231 234

SEEPAGE PITS, INSIDE DIAMETER _____ FT. DEPTH BELOW INLET 2 FT.

ABSORBENT AREA _____ SQ. FT.

455 TOTAL

REMARKS 5/14/82 - 15' ALI HOLES 1 & 2 ARE OK
DEEP DITCH - 366 S&P SIDEWALL AREA
OFF OLD DW NEEDED DITCH DUG 1200
5/14/82 - 100 PM - STONE ADDED

DATE SYSTEM APPROVED 5/14/82 INSPECTOR Jayman and Hodges