

7/15/98
am WPI
7/22/98
2-00

PERMIT

SEWAGE DISPOSAL SYSTEM

DEPARTMENT OF HEALTH AND MENTAL HYGIENE

P 510564

A 50905-D

DISTRICT 3rd

DATE 7-14-98

DATE SYSTEM APPROVED M. Rifkin

INSPECTOR 7/22/98

HOWARD COUNTY HEALTH DEPARTMENT

BUREAU OF ENVIRONMENTAL HEALTH

~~XXXXXX~~

410-313-2640

INDEXED

03325628

Jack Fyock Septic Service

IS PERMITTED TO INSTALL X ALTER

ADDRESS P.O. Box 89, Glenelg, MD 21737

PHONE 410-988-9270

SUBDIVISION Quarterfield III

LOT 3

ROAD 11632 Whitetail Lane

PROPERTY OWNER

David Hudson

ADDRESS

SEPTIC TANK CAPACITY 1250 GALLONS

NUMBER OF BEDROOMS 4

210 SQUARE FEET PER BEDROOM

LINEAR FEET OF TRENCH REQUIRED 280

TRENCHES - Trench to be 3 feet wide. Inlet 4½ feet below original grade. Bottom maximum depth 6½ feet below original grade. Effective area begins at 4½ feet below original grade. 2 feet of stone below distribution pipe.

LOCATION - Place the distribution box 165 feet down the left lot line and 30 feet off this same lot line. Run trenches on contour to right side of lot.

NOTES - No trench to exceed 100 feet in length. Provide 6" - 8" diameter cleanout and cap to grade or above on septic tank. OK/MR

PLANS APPROVED BY Mark Rifkin

DATE 6/23/98

COVER NO WORK UNTIL INSPECTED AND APPROVED

NEITHER THE HOWARD COUNTY COUNCIL NOR THE HEALTH DEPARTMENT IS RESPONSIBLE FOR THE SUCCESSFUL OPERATION OF ANY SYSTEM

NOTE: CLEANOUT REQUIRED EVERY 70 FEET OF SEWER LINE AND/OR AT 90° SWEEPS IN LINES FROM HOUSE TO DRAIN FIELDS, 90° ELBOWS NOT ACCEPTABLE.

NOTE: ALL PARTS OF SEPTIC SYSTEMS (I.E. TANK, DISTRIBUTION BOX TRENCHES) TO BE 100 FEET FROM WELL (UNLESS OTHERWISE SPECIFICALLY AUTHORIZED)

NOTE: IF DEEP TRENCH(ES) ARE USED CALL FOR INSPECTION BEFORE AND AFTER PLACING GRAVEL IN TRENCH(ES)

NOTE: NO DRY WELL SHALL EXCEED 15 FOOT IN DIAMETER NO ABSORPTION TRENCH TO EXCEED 100 FEET IN LENGTH

NOTE: ALL PIPE FROM HOUSE TO SEPTIC TANK MUST BE CAST IRON OR SCHEDULE 35/40 PVC OR ABS

PERMIT VOID AFTER TWO YEARS

NOTE: INSTALL STAND PIPE ON SEPTIC TANK AND DRY WELL STAND PIPES MUST BE 6 INCHES IN DIAMETER CAST IRON. CONCRETE OR TERRA COTTA OR PVA OR ABS ACCEPTED. IF TOP OF SEPTIC TANK IS DEEPER THAN 3 FEET. MANHOLE TO GRADE REQUIRED

NOTE: DISTRIBUTION BOXES MUST HAVE BAFFLES

*INSTALLER IS RESPONSIBLE FOR OBTAINING FINAL APPROVAL ON THIS PERMIT

HD-260(6-90)


*CALL 461-9933 FOR INSPECTION OF SEPTIC SYSTEM.

PERMIT SKIPPED

AND RETURNED 6-23-98

Serial # 670118888
dwc

50905-D

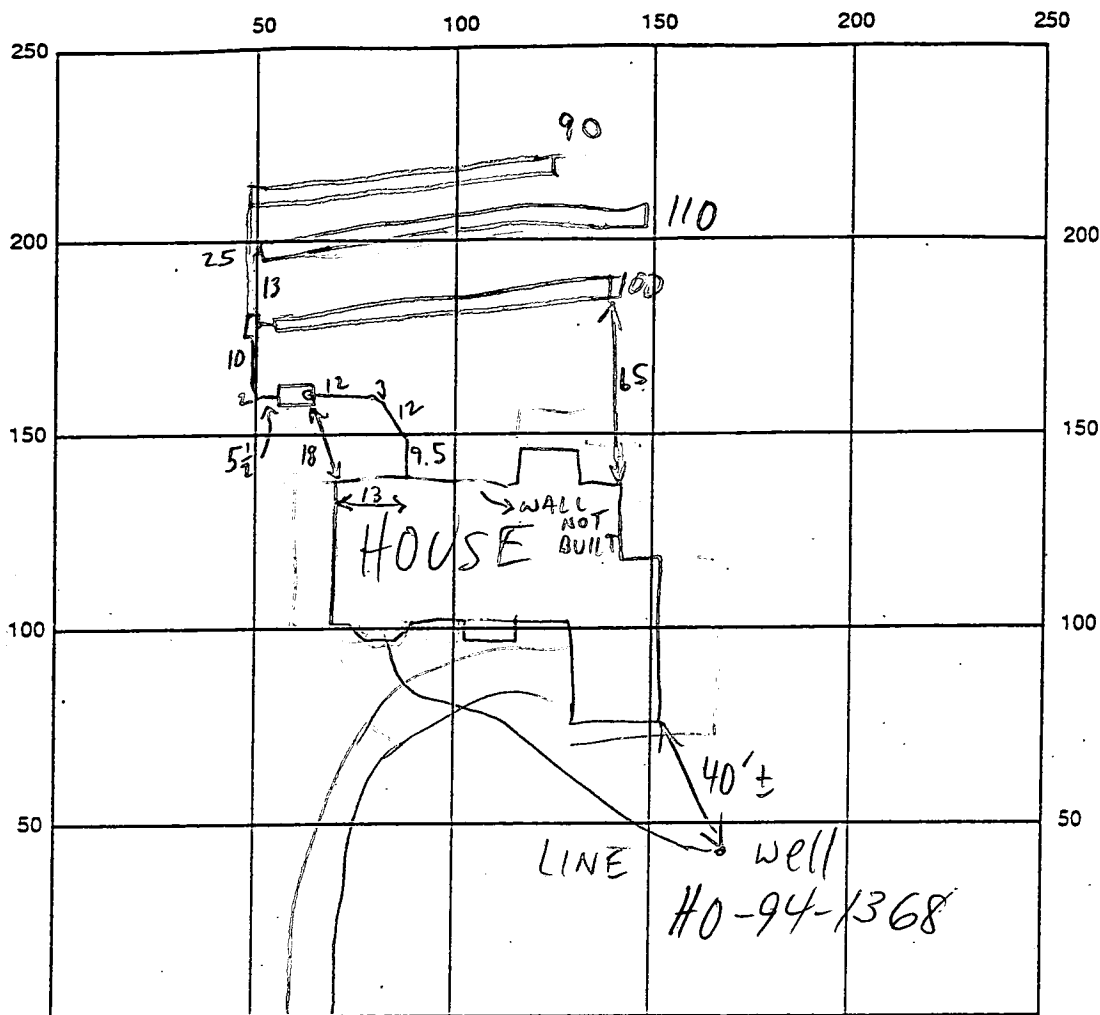

WHITETAIL LA

INDICATE NORTH - NAME ADJOINING ROADWAY AS BASE LINE

SEPTIC TANK LEVEL 1250 GAL-OK CLEANOUTS 8" @ ST-OK

DISTRIBUTION BOX LEVEL OK-BAFFLE IN

DRAIN FIELD/TITLE DEPTH 6-6 1/2 FT. TRENCH WIDTH 3 FT. INLET DEPTH 4-4 1/2 FT.

EFFECTIVE GRAVEL DEPTH 2 FT. TOTAL LENGTH 0100 0210 0390 FT.

NUMBER OF TRENCHES 3 ONE SIDEWALL BOTTOM AREA 0300 0330 0270 SQ. FT.

DRYWALL INSIDE DIAMETER — FT. EFFECTIVE DEPTH BELOW INLET — FT.

ABSORBENT AREA 900 SQ. FT.

REMARKS: 7/22/98 OK TO FINISH & COVER (MR)

DATE SYSTEM APPROVED 7/22/98 INSPECTOR M. Riskin

APPLICATION

PERCOLATION TESTING

A 50905D

P _____

HOWARD COUNTY HEALTH DEPARTMENT

BUREAU OF ENVIRONMENTAL HEALTH

3525-H ELLICOTT MILLS DRIVE/ELLICOTT CITY, MARYLAND 21043
TELEPHONE: 313-2640

DISTRICT _____

DATE 10/12/95

TO: THE COUNTY HEALTH OFFICER
ELLICOTT CITY, MARYLAND

I HEREBY APPLY FOR THE NECESSARY TEST PRIOR TO APPLICATION FOR PERMIT TO CONSTRUCT (OR RECONSTRUCT) A SEWAGE DISPOSAL SYSTEM.

PROPERTY OWNER MR. TOM SURIVENER David Hudson
~~CONTRACT PURCHASER~~

ADDRESS 5026 VORSEY HALL DRIVE #204 PHONE 964-5522
ELLICOTT CITY, MD 21042

AGENT OR PROSPECTIVE BUYER DONALD R. KENNER JR. LAND DESIGN & DEVELOPMENT, INC.
DEVELOPER

ADDRESS 10805 HICKORY RIDGE ROAD PHONE 740-2100
COLUMBIA, MD 21045

PROPERTY LOCATION:

SUBDIVISION QUARTERFIELD III LOT NO. #3 on P.C.

ROAD AND DESCRIPTION PROPOSED WHITETAIL LANE - THIRD ELECTION DISTRICT
ADJACENT TO QUARTERFIELD I & II OFF OF FOLLY QUARTER ROAD

TAX MAP 23 PARCEL # B4 (11632 WHITETAIL LANE) AND RETURNED 6-23-98
Serial # B70112115-4Bm

SIZE OF LOT CLUSTER ONE ACRE TYPE BLDG. SINGLE FAMILY DWELLING
(SINGLE FAMILY DWELLING OR COMMERCIAL)

THE SYSTEM INSTALLED UNDER THIS APPLICATION IS ACCEPTABLE ONLY UNTIL PUBLIC FACILITIES BECOME AVAILABLE. I FULLY UNDERSTAND THE

FEE CONNECTED WITH THE FILING OF THIS PERC TEST APPLICATION IS NON-REFUNDABLE UNDER ANY CIRCUMSTANCES. I ALSO AGREE TO

COMPLY WITH ALL M.O.S.H.A. REQUIREMENTS IN TESTING THIS LOT. Robert H. Helton - AGENT - LTD. INC.
(SIGNATURE OF APPLICANT)

APPROVED BY _____ FOR _____ DATE _____

DISAPPROVED BY _____ FOR _____ DATE _____

HOLD PENDING FURTHER TESTS _____

REASONS FOR REJECTION OR HOLDING 12/27/95 PERC OK, HOLD FOR PLAT MR

PERCOLATION TEST PLAT/PRELIMINARY PLAT - TITLE OR I.D. # _____ DATE _____

SITE DEVELOPMENT PLAN/FINAL PLAT - TITLE OR I.D. # _____ DATE _____

THIS IS NOT A PERMIT

A50905E
COUNTY #

SOIL PROFILE

526A/523A

brn
sac
lm

tan gray
sa lm
<10%
frags

500

deep orge
& brn
cl lm
and
sacl lm

beige
sa lm
10%
frags

500A/518

orge
brn
cl lm
&
sacl lm

tan gray
sa lm
10%
frags

INTENDED
STAKE

Lot 5

518

526

60

Lot 6

526A

90

NOT
DUG
523

523A

EXPAND

95

NOT
DUG
522

75

500A

10

CE

NOT
DUG
524

140

500

75

broad
swale

deep swales
old road beds?

SOIL PROFILE

524A

heavy
orge
cl lm

beige
sa lm
10%
frags

INDICATE NORTH - NAME ADJOINING ROADWAY AS BASE LINE.

W H I T E T A I L L A

DATE	TEST NO.	DEPTH	PRE-WET START	PRE-WET STOP	TEST - 1" DROP START	TEST - 1" DROP STOP	TIME
10/26/95	526AS	3 1/2"	2:51	2:56	VERY LITTLE DROP		
	526AV	5"	3:03	3:08	3:08	3:15	7
	523AS	11 1/2"	OK	see profile			
	523AV	4'3"	3:06	3:07	3:07	3:11	4
	523AV	12	sim to 526A	20%	frags		
	500S	5"	3:26	3:30	VERY LITTLE DROP		
	500S	6"	3:34	3:39	3:39	3:46	7
	500V	10'9"	OK	see profile			
	500AV	10 1/2"	OK	see profile			
INTENDED TO BE 526	518S	4'9"	4:00	4:04	4:04	4:08	4
BUT DUG @ WRONG STAKE	518V	11	OK	see profile			
	524A	5	11:10	11:13	11:13	11:22	9

REMARKS

524A 12

TYPE OF SOIL HOLES 500, 518 ONLY PER PLAT

TESTED BY M. R. P. K. in

ALSO PRESENT Assoc. Exc. Donk.

TRENCH DESIGN DATA: AVERAGE PERCOLATION TIME

6

TRENCH WIDTH

3

INLET DEPTH

4 1/2

MAXIMUM BOTTOM DEPTH

6 1/2

SQ. FT./BEDROOM

21.6 (due to 500)

Total linear feet of trench
required 280 feet

Width of trench(es) 3 feet

Depth of trench(es) 6 1/2 feet

Depth of stone required below
distribution pipe 2 feet

PLAN BY CFS 6/98 1:50


Approved Septic System Plan
Howard County Health Department
B00112115

Mark E. Rifkin 6/23/98
Signature Date

MANHOLE REQ'D @
SEPTIC TANK


10' OF PIPE UPSTREAM
OF SEPTIC TANK @
1-2% FALL

Private 24' Use-In-Common Access
Esm't. for Lots 5 & 6

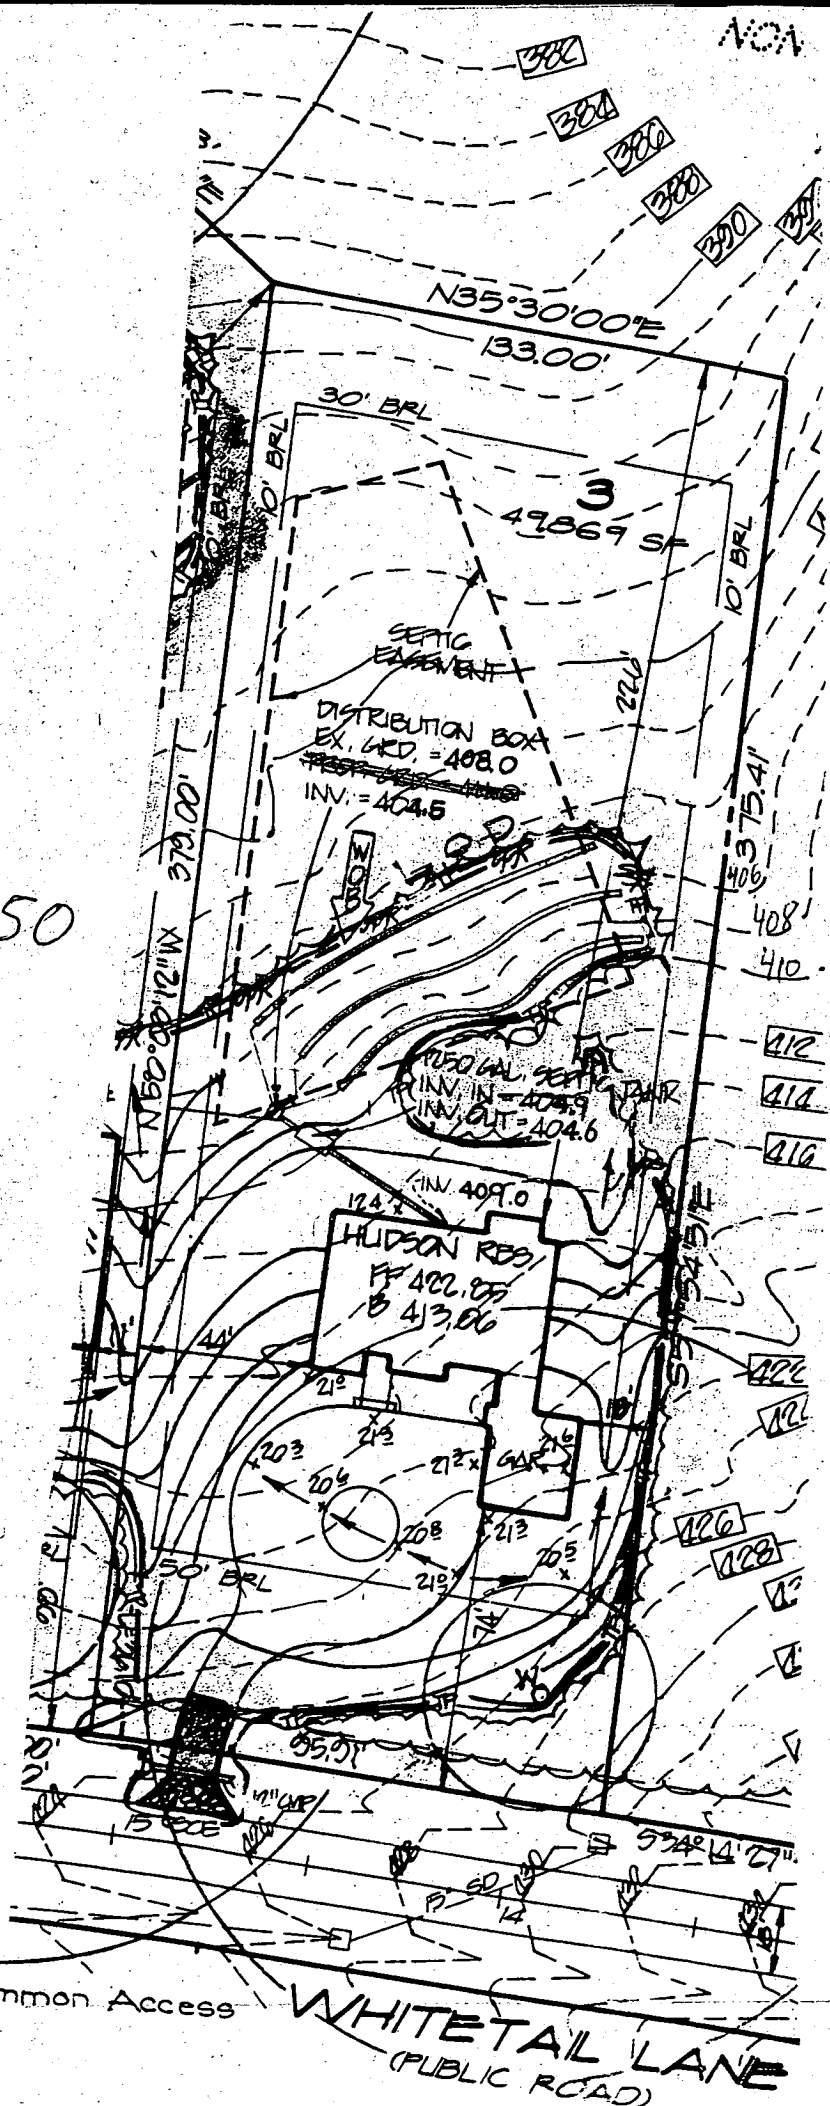

WHITETAIL LANE
(PUBLIC ROAD)

C1 1306		SEQUENCE NO. (DENY USE ONLY)		STATE OF MARYLAND WELL COMPLETION REPORT FILL IN THIS FORM COMPLETELY PLEASE PRINT OR TYPE		THIS REPORT MUST BE SUBMITTED WITHIN 45 DAYS AFTER WELL IS COMPLETED.	
THIS NUMBER IS TO BE PUNCHED IN COLUMNS 3-6 ON ALL CARDS						COUNTY NUMBER A50905	
ST/CO USE ONLY DATE RECEIVED 03/03/98		DATE WELL COMPLETED 02/27/98		Depth of Well 22 200 26 (TO NEAREST FOOT)		PERMIT NO. FROM "PERMIT TO DRILL WELL" H0-94-1368	
OWNER Greenfield Homes		last name Whitelail first name Lane		TOWN West Friendship			
STREET OR RFD		SUBDIVISION Waterfield		SECTION 3		LOT 3	
WELL LOG Not required for driven wells		GROUTING RECORD		C3		PUMPING TEST	
STATE THE KIND OF FORMATIONS PENETRATED, THEIR COLOR, DEPTH, THICKNESS AND IF WATER BEARING		WELL HAS BEEN GROUTED (Circle Appropriate Box) Y N				HOURS PUMPED (nearest hour) 3	
DESCRIPTION (Use additional sheets if needed)		TYPE OF GROUTING MATERIAL				PUMPING RATE (gal. per min. to nearest gal.) 15	
		CEMENT CM BENTONITE CLAY BC				METHOD USED TO MEASURE PUMPING RATE Bucket	
		NO. OF BAGS 15 NO. OF POUNDS 1410				WATER LEVEL (distance from land surface)	
		GALLONS OF WATER 90				BEFORE PUMPING 44	
		DEPTH OF GROUT SEAL: (to nearest foot)				WHEN PUMPING 52	
		from 0 ft. to 36 ft.				TYPE OF PUMP USED (for test)	
		(enter 0 if from surface)				A air P piston T turbine	
		CASING RECORD				C centrifugal R rotary O other (describe below)	
		casing types insert appropriate code below				J jet S submersible	
		ST CO STEEL CONCRETE				PUMP INSTALLED	
		PL OT PLASTIC OTHER				DRILLER WILL INSTALL PUMP YES NO	
		MAIN CASING TYPE				IF DRILLER INSTALLS PUMP, THIS SECTION MUST BE COMPLETED FOR ALL WELLS EXCEPT HOME USE	
		Nominal diameter top (main) casing (nearest inch) 6				TYPE OF PUMP INSTALLED	
		Total depth of main casing (nearest foot) 41				PLACE (A,C,J,P,R,S,T,O) IN BOX - SEE ABOVE	
		OTHER CASING (if used)				CAPACITY: GALLONS PER MINUTE (to nearest gallon)	
		diameter inch				PUMP HORSE POWER	
		depth (feet) from to				PUMP COLUMN LENGTH (nearest ft.)	
		SCREEN RECORD				CASING HEIGHT (circle appropriate box and enter casing height)	
		screen type or open hole				LAND SURFACE	
		insert appropriate code below				2 (nearest foot)	
		ST BR HO STEEL BRASS OPEN HOLE				LOCATION OF WELL ON LOT	
		PL OT PLASTIC OTHER				SHOW PERMANENT STRUCTURE SUCH AS BUILDING, SEPTIC TANKS, AND/OR LANDMARKS AND INDICATE NOT LESS THAN TWO DISTANCES (MEASUREMENTS TO WELL)	
IN HARD ROCK AREAS, IDENTIFY SPECIFICALLY WHERE SATURATED FRACTURES WERE OBSERVED.		C2					
WELL HYDROFRACTURED Y N		DEPTH (nearest ft.)					
		H0 39 200					
CIRCLE APPROPRIATE LETTER		SLOT SIZE 1 2 3					
A A WELL WAS ABANDONED AND SEALED WHEN THIS WELL WAS COMPLETED		DIAMETER OF SCREEN (NEAREST INCH)					
E ELECTRIC LOG OBTAINED		from to					
P TEST WELL CONVERTED TO PRODUCTION WELL		GRAVEL PACK					
I HEREBY CERTIFY THAT THIS WELL HAS BEEN CONSTRUCTED IN ACCORDANCE WITH COMAR 26.04.04 "WELL CONSTRUCTION" AND IN CONFORMANCE WITH ALL CONDITIONS STATED IN THE ABOVE CAPTIONED PERMIT, AND THAT THE INFORMATION PRESENTED HEREIN IS ACCURATE AND COMPLETE TO THE BEST OF MY KNOWLEDGE.		IF WELL DRILLED WAS FLOWING WELL INSERT F IN BOX 68.					
DRILLERS IDENT. NO. MSD024		MDE USE ONLY (NOT TO BE FILLED IN BY DRILLER)					
DRILLERS SIGNATURE Joseph Mays		T (E.R.O.S.) WQ					
(MUST MATCH SIGNATURE ON APPLICATION)		70 72 74 75 76					
SITE SUPERVISOR (sign. of driller or journeyman responsible for sitework if different from permittee)		TELESCOPE CASING LOG INDICATOR OTHER DATA					

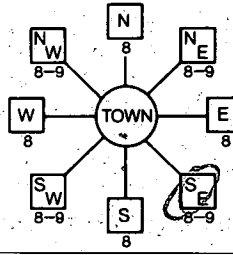B 1- 9488 (THIS NUMBER IS TO BE PUNCHED IN COLS. 3-6 ON ALL CARDS)	SEQUENCE NO. (MDE USE ONLY) 1 2 3 6 (THIS NUMBER IS TO BE PUNCHED IN COLS. 3-6 ON ALL CARDS)	STATE OF MARYLAND PERMIT TO DRILL WELL please print or type	STATE PERMIT NUMBER 40-94-1368 70 fill in this form completely 79
Date Received (APA) 8 MM DD YY 13 Greenfield Homes 15 Last Name Owner First Name 34 6656 Luster Drive 36 Street or RFD 55 Highland Md. 20777 57 Town 70 State 72 Zip 76		B 3 LOCATION OF WELL 8 COUNTY 21 Howard Quarterfield 23 SUBDIVISION 42 SECTION 3 LOT 3 44 46 48 50 West Friendship 52 NEAREST TOWN 71 MILES FROM TOWN (enter 0 if in town) 4 M I 73 76 77 78	
DRILLER INFORMATION Joseph L. Mayne MS D 24 Driller's Name 76 License No. 81 Joseph L. Mayne well Drilling Firm Name 5512 Ridge Rd Mt. Airy Md 21771 Address Joseph L. Mayne 2/7/98 Signature Date		B 4 1 2 DIRECTION OF WELL FROM TOWN (CIRCLE BOX)  Whitetail Lane 11 NEAR WHAT ROAD 30 ON WHICH SIDE OF ROAD (CIRCLE APPROPRIATE BOX) NORTH WEST ☒ EAST SOUTH 34 25 37 DISTANCE FROM ROAD ENTER FT OR MI FT 38 39 TAX MAP: _____ BLK: _____ PARCEL: _____	
B 2 WELL INFORMATION 1 2 APPROX. PUMPING RATE (GAL. PER MIN.) 8 12 5 AVERAGE DAILY QUANTITY NEEDED (GAL. PER DAY) 14 500 20		NOT TO BE FILLED IN BY DRILLER HEALTH DEPARTMENT APPROVAL Howard County A50905 COUNTY NAME COUNTY NO. STATE SIGNATURE _____ INSERT S → 41 DATE ISSUED 5/10/98 A McMillan 1/6/99 43 MM DD YY 48 CO SIGNATURE EXP. DATE NORTH GRID 521 000 EAST GRID 825 000 50 55 57 63	
USE FOR WATER (CIRCLE APPROPRIATE BOX) ☒ HOME (SINGLE OR DOUBLE HOUSEHOLD UNIT ONLY) ☐ FARMING (LIVESTOCK WATERING & AGRICULTURAL IRRIGATION) 22 ☐ INDUSTRIAL, COMMERCIAL, STATE AND FEDERAL GOV. OTHER (REQUIRES APPROPRIATION PERMIT) ☐ PUBLIC OR PRIVATE WATER COMPANY (REQUIRES APPROPRIATION PERMIT AND STATE APPROVAL) ☐ TEST, OBSERVATION, MONITORING (MAY REQUIRE APPROPRIATION PERMIT)		SHOW MAJOR FEATURES OF BOX & LOCATE WELL WITH AN X SOURCES OF DRILLING WATER 1. WELL 2. 3. WRITE THE BOX NUMBER FROM THE MAP HERE E 8201 N 5205 000 000 DRAW A SKETCH BELOW SHOWING LOCATION OF WELL IN RELATION TO NEARBY TOWNS AND ROADS AND GIVE DISTANCE FROM WELL TO NEAREST ROAD JUNCTION West Friendship Running Spring Rd Whitetail Lane Quarterfield Dr. N	
APPROXIMATE DEPTH OF WELL 300 FEET 24 28 APPROXIMATE DIAMETER OF WELL 6 INCH 30 37 METHOD OF DRILLING (circle one) BORED (or Augered) JETTED Jetted & DRIVEN 30 ☒ AIR-ROTARY AIR-PERCussion ROTARY (Hydraulic Rotary) 37 CABLE REVERSE-ROTARY DRIVE-POINT other _____		REPLACEMENT OR DEEPEMED WELLS (CIRCLE APPROPRIATE BOX) ☒ THIS WELL WILL NOT REPLACE AN EXISTING WELL ☐ THIS WELL WILL REPLACE A WELL THAT WILL BE ABANDONED AND SEALED 39 ☐ THIS WELL WILL REPLACE A WELL THAT WILL BE USED AS A STANDBY-CONTACT LOCAL APPROVING AUTHORITY FOR POLICY ON STANDBY WELLS ☐ THIS WELL WILL DEEPEMED AN EXISTING WELL PERMIT NUMBER OF WELL TO BE REPLACED OR DEEPEMED (IF AVAILABLE) 41 _____ 52	
Not to be filled in by driller (MDE OR COUNTY USE ONLY)			
APPROP. PERMIT NUMBER _____ G A P _____ 54 63 FORCE AM WRITE INITIALS IN BOX PERMIT NO. 40-94-1368 67 68 70 71 72 73 74 75 76 77 78 79			
SPECIAL CONDITIONS NOTE - APPROVING AUTHORITIES SHOULD USE SEPARATE SHEET IF NEEDED -			

COUNTY

HOWARD COUNTY HEALTH DEPARTMENT
Bureau of Environmental Health
3525-H Ellicott Mills Drive
Ellicott City, MD 21043
461-9933

APPLICATION FOR PITLESS ADAPTER, WELL PUMP AND PRESSURE TANK INSTALLATION

New Installation X
Replacement _____

Receipt # _____
Date _____

Name of Installer Garland Plumbing, Inc. Telephone 410-875-5323

License Number 6350

Certified Well Pump Installer X

Well Driller _____

Registered Plumber X

Name of Property Owner David Hudson

Telephone 410-781-6782

Subdivision Quarter Field Lot # 3

Well Tag # HO-99-1368

Site Address 11632 Whitetail Lane

Pump

1. Type

- a. Deep well jet _____
b. Shallow well jet _____
c. Submersible ✓

2. Make Goulds

3. Model # TE1

4. Capacity 7 GPM

5. Pump exceeds well capacity Yes _____ No X

6. If Yes, is low pressure cutoff switch installed? Yes _____ No _____

7. What methods are used to protect the pump and electrical wiring from vibrations? Torque arrestors _____ Cable guards _____ Other X

Motor

1. Horsepower 1/2

2. RPM 3450

3. Voltage _____

a. 110 _____

b. 220 ✓

Pitless Adapter

1. Make Harvard

2. Model # P-800

3. Depth 48"

Tank

1. Capacity 250

2. Pressure relief

valve? yes

Piping

1. Type Poly

2. Size 1"

3. NSF and/or BOCA

Code approved yes

4. Depth of supply

line 48"

Well data

1. Depth 190 ft.

2. Yield 7 GPM

3. Static water

level 140 ft.

4. Will water supply

be disinfected by

installer? no

WELL LINE 7' B.G.

@ HOUSE WALL; 4' B.G.

@ PITLESS ADAPTOR - OK

MR 7/15/98

ADVISED

R. MINOR

TO VERIFY

THAT WELL LINE

IS SLEEVED UNDER DRIVEWAY

I understand that it is my responsibility to notify the Howard County Health Department when the installation is ready for inspection (otherwise this permit is null and void).

All information given above is true to the best of my knowledge.

Signature of Applicant _____

Date _____

7-14-98

Note: A sticker indicating approval/status of the installation will be placed on the well casing at the time of the inspection.

HOWARD COUNTY PERMIT APPLICATION

PERMIT NUMBER

B00118888

Building Address 11632 WHITE TAIL LANE
ELLICOTT CITY MD
Suite/Apt. #: 6030 SDP/WP/Petition #: P9827
Census Tract 6030 Subdivision Quarterfield
Section 3 Area 84 Lot 3
Tax Map BEG Parcel 84 Grid 15
Zoning BEG Map Coordinates 49,86.9

Property Owner's Name DAVID C. HUDSON
Address 11632 WHITE TAIL LANE
City ELLICOTT CITY State MD Zip Code 21042
Home Phone 410-551-6077 Work Phone 410-528-8600
Applicant's Name & Mailing Address, (if other than stated hereon):

Existing Use RESIDENTIAL SFD
Proposed Use POOL DECK
Estimated Construction Cost \$ 0.00
Description of Work POOL DECK
2x2x w/Steps

Contractor Company OWNED
Contact Person DAVID C. HUDSON
Address 11632 WHITE TAIL LANE
City ELLICOTT CITY State MD Zip Code 21042
License No. 0000000000
Phone 410-551-6077 Fax 410-528-8600

Occupant or Tenant DAVID C. HUDSON
Contact Name DAVID C. HUDSON
Address 11632 WHITE TAIL LANE
City ELLICOTT CITY State MD Zip Code 21042
Phone 410-551-6077 Fax 410-528-8600

Engineer or Architect Company DAVID C. HUDSON
Contact Person DAVID C. HUDSON
Address 11632 WHITE TAIL LANE
City ELLICOTT CITY State MD Zip Code 21042
Phone 410-551-6077 Fax 410-528-8600

BUILDING DESCRIPTION - COMMERCIAL

BUILDING DESCRIPTION - RESIDENTIAL

Building Characteristics	Utilities
Height:	Water Supply: ☐ Public ☐ Private
No. of stories:	Sewage Disposal: ☐ Public ☐ Private
Gross area, sq. ft. per floor:	Electric Yes ☐ No ☐
Use group:	Gas Yes ☐ No ☐
Construction type:	Heating System:
☐ Reinforced Concrete	Electric ☐ Oil ☐
☐ Structural Steel	Natural Gas ☐
☐ Masonry	Propane Gas ☐
☒ Wood Frame	Sprinkler system: N/A ☐
☐ State Certified Modular	☐ Full ☐ Partial ☐ Other Suppression ☐ # of Heads

Building Characteristics	Utilities
SF Dwelling ☒ SF Townhouse ☐	Water Supply: ☐ Public ☒ Private
Depth Width	Sewage Disposal: ☐ Public ☒ Private
1st floor:	Electric Yes ☐ No ☐
2nd floor:	Gas Yes ☐ No ☐
Basement:	Heating System:
Finished Basement ☐ Unfinished Basement ☐	Electric ☐ Oil ☒
Crawl space ☐ Slab on Grade ☐	Natural Gas ☐
No. of Bedrooms:	Propane Gas ☐
Multi-family dwellings:	Sprinkler system: N/A ☐
No. of efficiency units:	☐ NFPA #13D ☐ NFPA #13R ☐ Other:
No. of 1 BR units:	
No. of 2 BR units:	
No. of 3 BR units:	
Other Structure:	
Dimensions:	
Footings:	
Roof:	
☐ State Certified Modular ☐ Manufactured Home	

THE UNDERSIGNED HEREBY CERTIFIES AND AGREES AS FOLLOWS: (1) THAT HE/SHE IS AUTHORIZED TO MAKE THIS APPLICATION; (2) THAT THE INFORMATION IS CORRECT; (3) THAT HE/SHE WILL COMPLY WITH ALL REGULATIONS OF HOWARD COUNTY WHICH ARE APPLICABLE THERETO; (4) THAT HE/SHE WILL PERFORM NO WORK ON THE ABOVE REFERENCED PROPERTY NOT SPECIFICALLY DESCRIBED IN THIS APPLICATION; (5) THAT HE/SHE GRANTS COUNTY OFFICIALS THE RIGHT TO ENTER ONTO THIS PROPERTY FOR THE PURPOSE OF INSPECTING THE WORK PERMITTED AND POSTING NOTICES.

Applicant's Signature

Print Name

Title/Company

Date

Checks payable to: DIRECTOR OF FINANCE OF HOWARD COUNTY

** PLEASE WRITE NEATLY AND LEGIBLY **

FOR OFFICE USE ONLY

AGENCY DATE SIGNATURE APPROVAL
Land Development, DPZ 6/12/99
State Highways 6/12/99
Building Official 6/12/99
Dev. Engineering, DPZ 6/12/99
Health 6/12/99
Fire Protection 6/12/99

DPZ SETBACK INFORMATION

Front: 50' min
Rear: 35' min (FROM FOREST)
Side: 70' min (FROM FOREST)
Side St: 70' min (FROM FOREST)
All minimum setbacks met? YES ☐ NO ☐
Is Entrance Permit required? YES ☐ NO ☐
Historic District? YES ☐ NO ☐
Lot Coverage for New Town Zone
SDP/Red-line approval date

PROPERTY ID#

36054
Filing fee \$
Permit fee \$ 35
Excise tax \$
Sub-total paid \$
Add'l permit fee \$
TOTAL FEES \$ 150
Balance due \$
Check # 6789
Validation # 22009

CONTINGENCY CONSTRUCTION START: ☐
ONE STOP SHOP: ☐

Accepted by

Distribution of Copies

White: Building Official


Green: LDD, DPZ

Yellow: DED, DPZ

Pink: Health

Gold: SHA

BOON 118888 OK.
 PROPOSED DECK & AREA
 ADEQUATE CLEARANCE TO SEPTIC
 6/23/99
 Craig Will

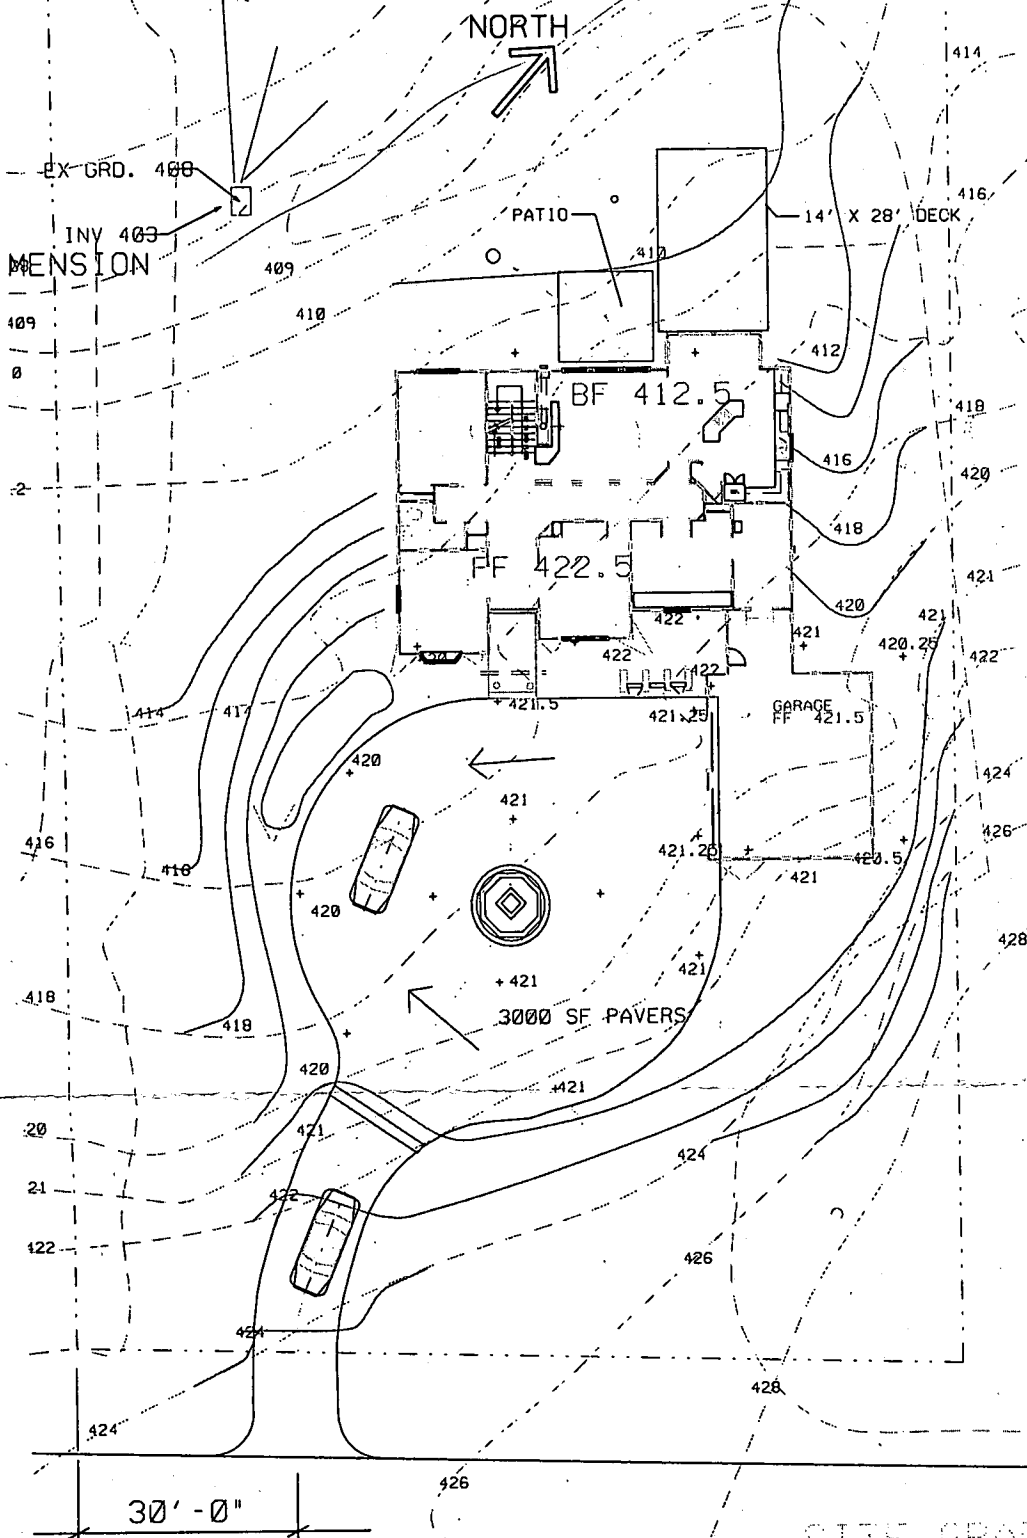

RECEIVED
 HOWARD COUNTY HEALTH DEPT.
 ENVIRONMENTAL HEALTH
 1999 JUN 23 PM 2:40

SITE GRADING PLAN

DECK
 11632 WHITETAIL LANE
 ELLICOTT CITY, MD.
 DAVID HUDSON