

7/29/94
8/2/94
10:00 am
10:00 & later
2 PM

PERMIT

SEWAGE DISPOSAL SYSTEM

DEPARTMENT OF HEALTH AND MENTAL HYGIENE

HOWARD COUNTY HEALTH DEPARTMENT

BUREAU OF ENVIRONMENTAL HEALTH

~~461-9933~~ 313-2640

INDEXED

P 50046

A REPAIR

DISTRICT 3

DATE 05/24/94

DATE SYSTEM APPROVED 8/2/94

INSPECTOR DKS

03-281272

Vernon A. Burgess

David Brown

IS PERMITTED TO INSTALL ALTER X

ADDRESS 1906
13170 Triadelphia Road

PHONE _____

SUBDIVISION _____ LOT _____ ROAD 13170 Triadelphia Road

PROPERTY OWNER Vernon A. Burgess

ADDRESS 13170 Triadelphia Road
Glenelg, Maryland

SEPTIC TANK CAPACITY existing 1000 GALLONS

NUMBER OF BEDROOMS 3

180 SQUARE FEET PER BEDROOM

LINEAR FEET OF TRENCH REQUIRED 90

780
3
540
108
5140

REPAIR - PURPOSE - SEPTIC SYSTEM HAS FAILED.

Call for inspection when ground is opened so sanitarian can recommend repair. 05/24/94

Install one Repair Trench approximately 90 ft long, 2 ft wide, 9 ft max bottom depth
with inlet at 4 ft, 5 ft stone fill. Disconnected from old trench. 7/29/94

PLANS APPROVED BY Donald J. Pickles

DATE 7/29/94

COVER NO WORK UNTIL INSPECTED AND APPROVED

NEITHER THE HOWARD COUNTY COUNCIL NOR THE HEALTH DEPARTMENT IS RESPONSIBLE FOR THE SUCCESSFUL OPERATION OF ANY SYSTEM

NOTE: CLEANOUT REQUIRED EVERY 70 FEET OF SEWER LINE AND/OR AT 90° SWEEPS IN LINES FROM HOUSE TO DRAIN FIELDS, 90° ELBOWS NOT ACCEPTABLE.

NOTE: ALL PARTS OF SEPTIC SYSTEMS (I.E. TANK, DISTRIBUTION BOX TRENCHES) TO BE 100 FEET FROM WELL (UNLESS OTHERWISE SPECIFICALLY AUTHORIZED)

NOTE: IF DEEP TRENCH(ES) ARE USED CALL FOR INSPECTION BEFORE AND AFTER PLACING GRAVEL IN TRENCH(ES)

NOTE: NO DRY WELL SHALL EXCEED 15 FOOT IN DIAMETER NO ABSORPTION TRENCH TO EXCEED 100 FEET IN LENGTH

NOTE: ALL PIPE FROM HOUSE TO SEPTIC TANK MUST BE CAST IRON OR SCHEDULE 35/40 PVC OR ABS

PERMIT VOID AFTER TWO YEARS

NOTE: INSTALL STAND PIPE ON SEPTIC TANK AND DRY WELL STAND PIPES MUST BE 6 INCHES IN DIAMETER CAST IRON, CONCRETE OR TERRA COTTA OR PVA OR ABS ACCEPTED. IF TOP OF SEPTIC TANK IS DEEPER THAN 3 FEET. MANHOLE TO GRADE REQUIRED.

NOTE: DISTRIBUTION BOXES MUST HAVE BAFFLES

*INSTALLER IS RESPONSIBLE FOR OBTAINING FINAL APPROVAL ON THIS PERMIT

BLOG. PERMIT SIGNED

AND RETURNED

6-5-97
Donald J. Pickles
7/29/94
1-5-97
Scavenger

P 50046

2/18/87
1 PM

approved
2/18/87
B. Williams

PERMIT

SEWAGE DISPOSAL SYSTEM

MARYLAND STATE DEPARTMENT OF HEALTH*

P 38757
A REPAIR

HOWARD COUNTY
BUREAU OF ENVIRONMENTAL HEALTH
992-2330

INDEXED

ELLICOTT CITY
DISTRICT _____
DATE 2/19/87

Jack Fyock IS PERMITTED TO INSTALL _____ ALTER X

ADDRESS _____ PHONE 988-9270

SUBDIVISION _____ ROAD 13170 Triadelphia Road LOT _____

PROPERTY OWNER Vernon A. Burgess
13170 Triadelphia Road

ADDRESS _____

IF GARBAGE GRINDER IS USED INCREASE SEPTIC TANK CAPACITY BY 50% AND ABSORPTION AREA BY 22%.

GARBAGE GRINDER? YES _____ NO _____

SEPTIC TANK CAPACITY 1000 GALLONS NUMBER OF BEDROOMS would guess 3

REPAIR - REPLACEMENT OF TANK.

replacing metal (collapsed) 750 gal w/
new Tank

PLANS APPROVED BY C. Williams DATE 2/17/87

COVER NO WORK UNTIL INSPECTED AND APPROVED.

NEITHER THE HOWARD COUNTY COUNCIL NOR THE HEALTH DEPARTMENT IS RESPONSIBLE FOR THE SUCCESSFUL OPERATION OF ANY SYSTEM.

NOTE: IF TRENCH IS USED CALL FOR INSPECTION BEFORE AND AFTER PLACING GRAVEL IN TRENCH.

NOTE: NO DRY WELL SHALL EXCEED 15 FOOT IN DIAMETER. NO ABSORPTION TRENCH TO EXCEED 100 FEET IN LENGTH.

NOTE: ALL PIPE FROM HOUSE TO SEPTIC TANK MUST BE CAST IRON OR SCHEDULE 40 PVC OR ABS.

PERMIT VOID AFTER THREE YEARS.


NOTE: INSTALL STAND PIPE ON SEPTIC TANK AND DRY WELL. STAND PIPES MUST BE 6 INCHES IN DIAMETER. CAST IRON, CONCRETE OR TERRA COTTA, OR PVC OR ABS ACCEPTED. IF TOP OF SEPTIC TANK IS DEEPER THAN 3 FEET MANHOLE TO GRADE REQUIRED.

*INSTALLER IS RESPONSIBLE FOR OBTAINING FINAL APROVAL ON THIS PERMIT

*CALL 992-2330 FOR INSPECTION OF SEPTIC SYSTEMS.

EH - 2-1082

P 38757

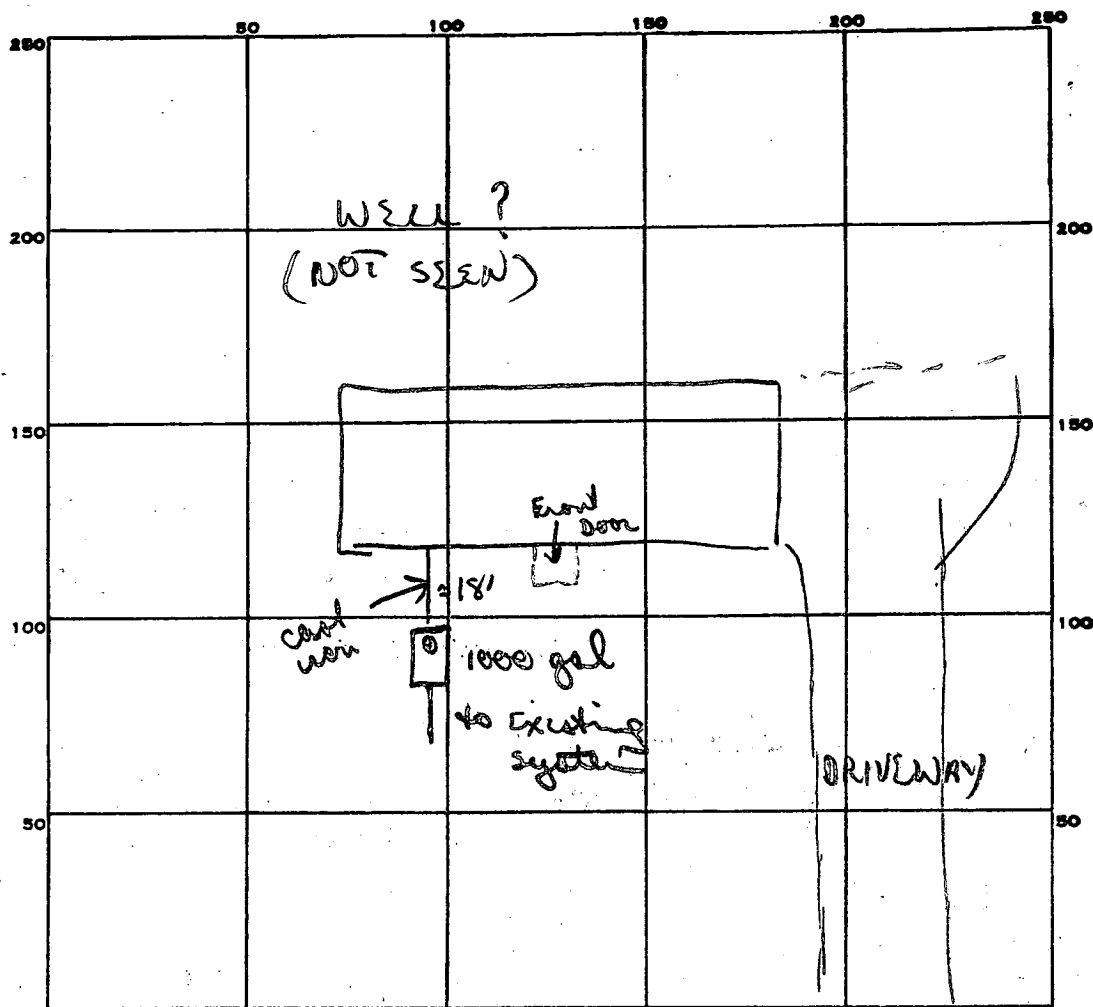

INDICATE NORTH. - NAME ADJOINING ROADWAY AS BASE LINE.

PERMIT CARD ✓ final

SEPTIC TANK, LEVEL NEW 1000 gal tank CLEANOUTS 1 S.T. 40

DISTRIBUTION BOX, LEVEL _____

TILE FIELD, DEPTH _____ FT. TRENCH WIDTH _____ FT.

GRAVEL DEPTH _____ IN. TOTAL LENGTH _____ FT.

NUMBER OF TRENCHES _____ TOTAL BOTTOM AREA _____

N/A

SEEPAGE PITS, INSIDE DIAMETER _____ FT. DEPTH BELOW INLET _____ FT.

ABSORBENT AREA _____ SQ. FT.

REMARKS 2/18/87 Tank replacing old collapsed metal tank
to be connected to existing system as is

DATE SYSTEM APPROVED 2/18/87 INSPECTOR B N Jipen

7/18/60

PERMIT

SEWAGE DISPOSAL SYSTEM

MARYLAND STATE DEPARTMENT OF HEALTH

HOWARD COUNTY

INDEXED

ELLICOTT CITY

DISTRICT 3

DATE 7/14/60

app. file
P 02692

A 02536

R. R. Vane, Jr.

IS PERMITTED TO INSTALL ☒ ALTER

ADDRESS Ellicott City

PHONE E.C. 1319

A SEWAGE DISPOSAL SYSTEM LOCATED AT Tridelphia Rd. 4 mi. W. Rt. 144 on right hand side
road.

SUBDIVISION _____ ROAD _____ LOT _____

PROPERTY OWNER Burgess, Vernon A.

ADDRESS Tridelphia Rd., Ellicott City

SPECIFICATIONS

DRAIN FIELD ☒ DEPTH 3 FEET, BOTTOM AREA 345 SQ. FT.

SEEPAGE PITS _____ ABSORBENT SIDE-WALL AREA _____ SQ. FT.

SEPTIC TANK CAPACITY 750 GALLONS

FOR GARBAGE GRINDER, INCREASE DISPOSAL AREA 22% & TANK CAPACITY 50%.

OTHER Place the tile field about 20 ft. to 70 ft. from the front of the house
and about 80 ft. to 160 ft. from the side of the lot that is fartherest
from Rt. 144.


PLANS APPROVED BY Raymond Hodges DATE 6/7/60

FILL SEPTIC TANK AND DISTRIBUTION BOX WITH WATER BEFORE CALLING FOR AN INSPECTION. COVER NO WORK UNTIL INSPECTED AND APPROVED.

NEITHER THE HOWARD COUNTY COMMISSIONERS NOR THE HEALTH DEPARTMENT IS RESPONSIBLE FOR THE SUCCESSFUL OPERATION OF ANY SYSTEM.

A 02536

126
3
378

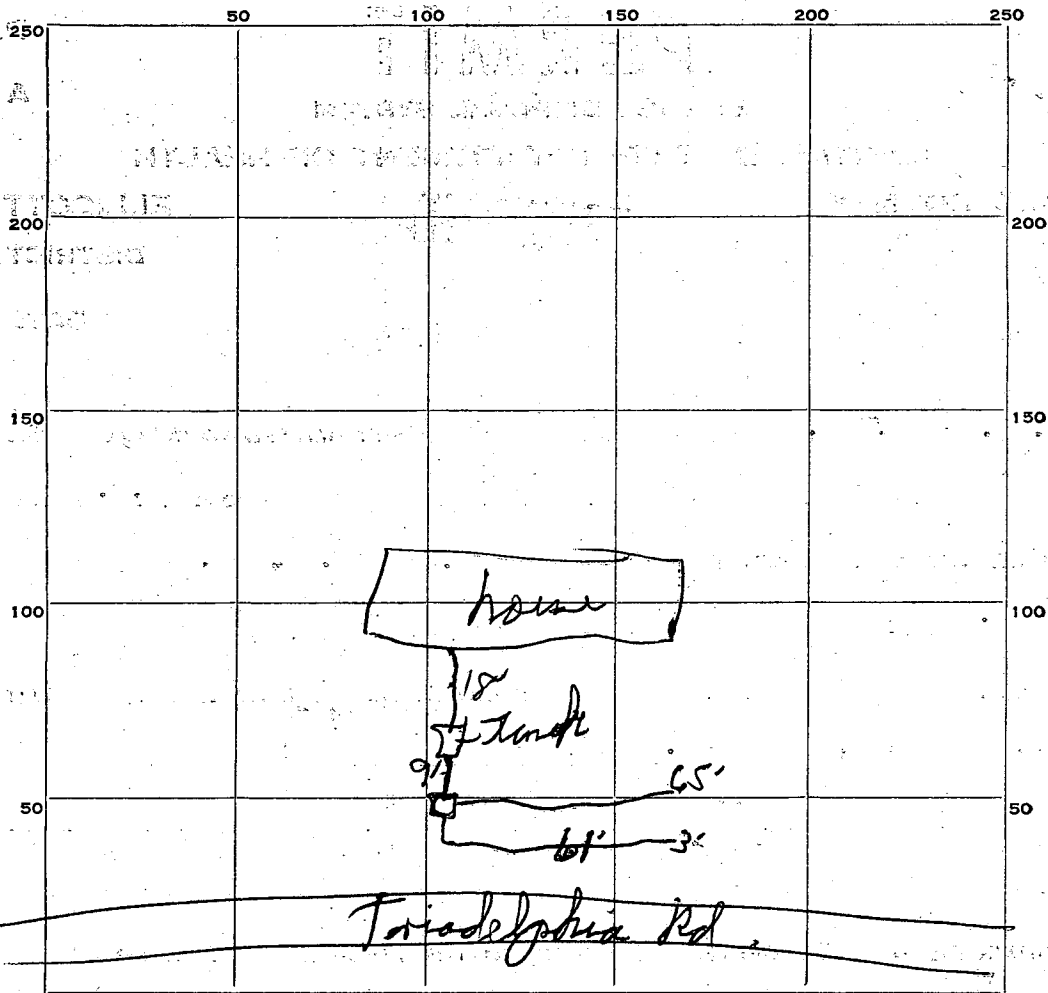

INDICATE NORTH. - NAME ADJOINING ROADWAY AS BASE LINE.

PERMIT CARD ☒

SEPTIC TANK, LEVEL ☒

CLEANOUTS ☒

DISTRIBUTION BOX, LEVEL ☐

TILE FIELD, DEPTH 3 FT. TRENCH WIDTH 3 FT.

GRAVEL DEPTH 12 IN. TOTAL LENGTH 126 FT.

NUMBER OF TRENCHES 2 TOTAL BOTTOM AREA 378

SEEPAGE PITS, INSIDE DIAMETER FT. DEPTH BELOW INLET FT.

ABSORBENT AREA SQ. FT.

REMARKS

DATE SYSTEM APPROVED

7/18/60

INSPECTOR

29W

APPLICATION

A 02536

P 02692

SEWAGE DISPOSAL TESTING

MARYLAND STATE DEPARTMENT OF HEALTH

HOWARD COUNTY

ELLICOTT CITY

750 Gallon Tank

DISTRICT 3

DATE 6/1/60

Tile Field 345 ^{sq ft} bottom area

Builder: Associated Home Builders - Sara. 7-0868

Place the tile field about 20 ft to 70 ft from the front of the house and about

TO THE COUNTY HEALTH OFFICER
ELLICOTT CITY, MARYLAND

80 ft to 160 ft from the side of the lot that is farthest from Route #144

I, HEREBY, APPLY FOR THE NECESSARY TESTS IN ORDER TO CONSTRUCT (OR RECONSTRUCT) A SEWAGE DISPOSAL SYSTEM.

PROPERTY OWNER Burgess, Vernon A.

ADDRESS Tridelpia Rd., Ellicott City

PHONE None

PROPERTY LOCATION:

SUBDIVISION

LOT NO.

ROAD AND DESCRIPTION Tridelpia Rd. 4 mi. W. Rt. 144 on right hand side road.

next property pass white house with blue trim.

OCCUPANT

PHONE

PERSON TO CONSTRUCT SYSTEM

ADDRESS

PHONE

SIZE OF LOT 1 acre

TYPE BLDG.

3

NUMBER OF BEDROOMS

IF NOT SINGLE RESIDENCE DESCRIBE

SIGNATURE OF APPLICANT

APPROVED BY

FOR

(KIND OF SYSTEM)

DATE

REJECTED BY

FOR

(KIND OF SYSTEM)


DATE

HOLD PENDING FURTHER TESTS

DATE

REASONS FOR REJECTION OR HOLDING

THIS IS NOT A PERMIT

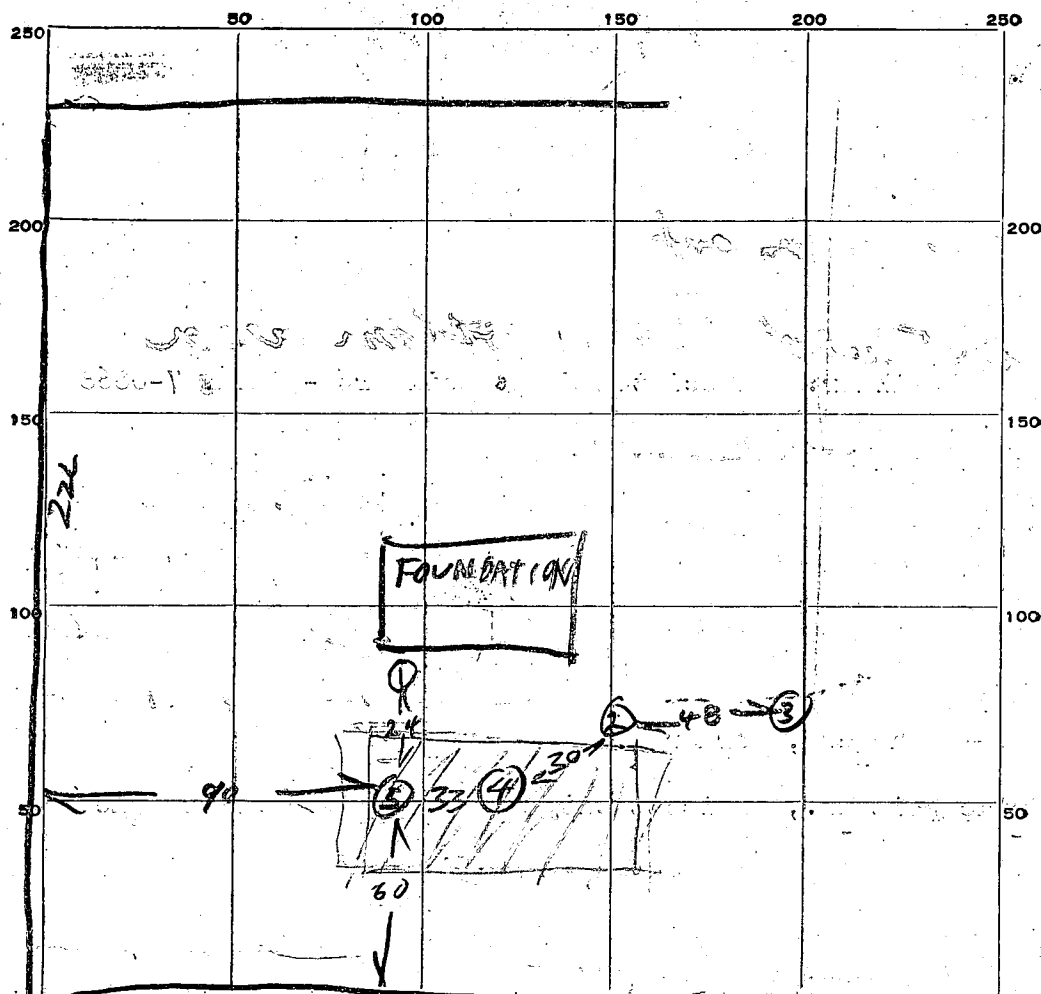

TRIDELPHIA RD

DATE	TEST NO.	DEPTH	PRE-WET		TEST - 1" DROP		TIME
			START	STOP	START	STOP	
6/7/60	1	3	954	1010	1000	1024	14 min
	2	3	959	1010	1000	1024	14 min
	3	3	1000	1050	1026	1031	5 min
	4	3	1023	1028	1026	1031	5 min
	5	3 1/2	1037	1043	1026	1031	5 min

SOIL AUGER FINDING.

TESTED BY

ALSO PRESENT

6/5/97

Garage location will
have no impact to
the existing well &
septic OK to proceed A. M. Mullen

