
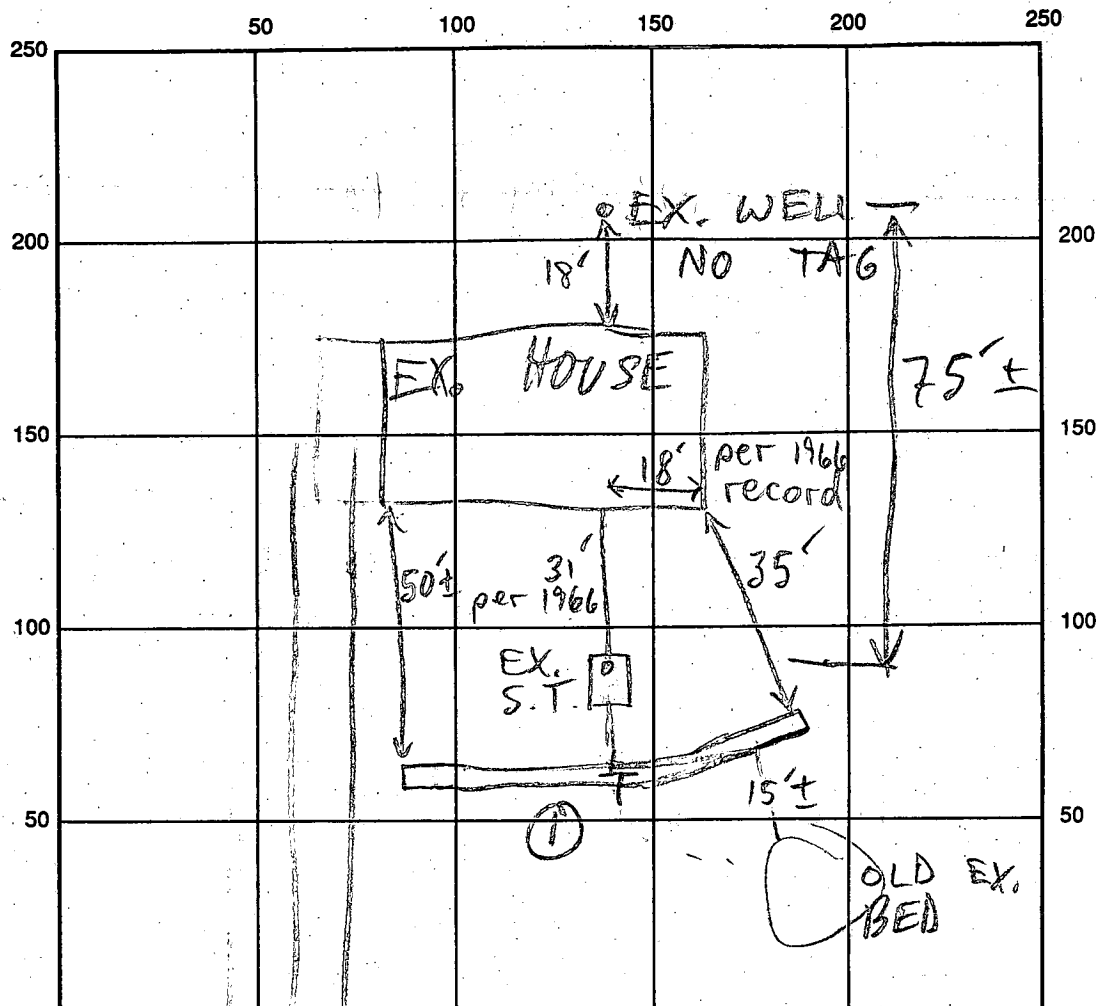


50205m

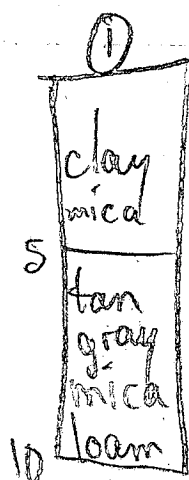

TAYLOR PARK RD INDICATE NORTH - NAME ADJOINING ROADWAY AS BASE LINE

SEPTIC TANK LEVEL EX-OK CLEANOUTS EX-OK

DISTRIBUTION BOX LEVEL —

DRAIN FIELD/TITLE DEPTH 10 FT. TRENCH WIDTH 3 FT. INLET DEPTH 2½ FT.

EFFECTIVE GRAVEL DEPTH 7½ FT. TOTAL LENGTH 70 FT.

NUMBER OF TRENCHES 1 ONE SIDEWALL/BOTTOM AREA 525 SQ. FT.

DRYWALL INSIDE DIAMETER — FT. EFFECTIVE DEPTH BELOW INLET — FT.

ABSORBENT AREA 525 SQ. FT.

REMARKS: 7/12/94 EX. BED STILL CONNECTED; 1966 SPECS
REPORT H₂O @ 9' BUT FYOCK CREW REPORTS HOLE TO
13' IN SAME VICINITY AS HOLE ① ABOVE; BOTH HOLES
DRY; OK TO COVER MR

DATE SYSTEM APPROVED 7/12/94 INSPECTOR M. Ripkin

5/6/66 - Approved - 8 H 12
11697

PERMIT

SEWAGE DISPOSAL SYSTEM

MARYLAND STATE DEPARTMENT OF HEALTH

HOWARD COUNTY

P 09771

A

ELLICOTT CITY³

DISTRICT 4/11/66

INDEXED

DATE

X

The John E. Ruth Co.

400 Overbrook Rd.

IS PERMITTED TO INSTALL ALTER

River Park Estates; Lot 23, Sec. 3

ADDRESS

A SEWAGE DISPOSAL SYSTEM LOCATED AT

River Park Estates

Taylor Park Rd.

23, Sec. 3

SUBDIVISION The Debra Corp. ROAD LOT

PROPERTY OWNER 122 Dunloggin Rd., E.C.

ADDRESS

SPECIFICATIONS

DRAIN FIELD DEPTH FEET, BOTTOM AREA SQ. FT.

SEEPAGE PITS ABSORBENT SIDE-WALL AREA 750 SQ. FT.

SEPTIC TANK CAPACITY GALLONS

Existing bed 200 ft. side by 22 ft. long, located 10 ft. off the
FOR CHANGE UNDER, INCREASE DISPOSAL AREA 22% & TANK CAPACITY 50%.

OTHER right side property line and 15 ft. off the front property line as
seen when facing this lot from Taylor Park Rd. Depth of bed 4½ ft.
on shallow side - no deeper - water at 9 ft.

J. Hennigan


3/30/65

PLANS APPROVED BY DATE

FILL SEPTIC TANK AND DISTRIBUTION BOX WITH WATER BEFORE CALLING FOR AN INSPECTION. COVER NO WORK
UNTIL INSPECTED AND APPROVED.

NEITHER THE HOWARD COUNTY COMMISSIONERS NOR THE HEALTH DEPARTMENT IS RESPONSIBLE FOR THE
SUCCESSFUL OPERATION OF ANY SYSTEM.

A 09771

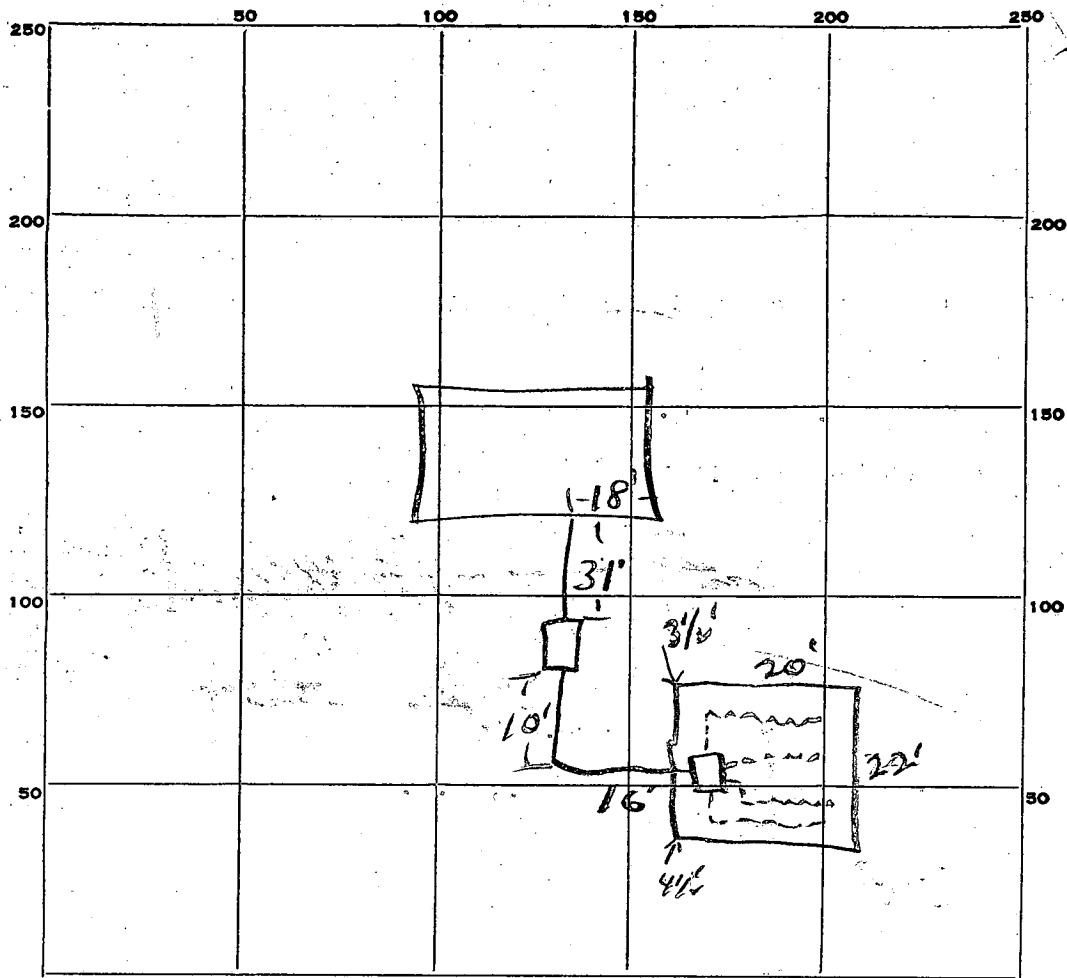

INDICATE NORTH. - NAME ADJOINING ROADWAY AS BASE LINE.

PERMIT CARD OK

Taylor Park Rd.

SEPTIC TANK, LEVEL OK 75°

CLEANOUTS OK

DISTRIBUTION BOX, LEVEL OK

L. Bed

~~TILE FIELD~~, DEPTH 4 1/2' shallow side FT. TRENCH WIDTH 20 FT.

GRAVEL DEPTH 36 IN. TOTAL LENGTH 22 FT.

NUMBER OF TRENCHES _____ TOTAL BOTTOM AREA 440

SEEPAGE PITS, INSIDE DIAMETER _____ FT. DEPTH BELOW INLET _____ FT.

ABSORBENT AREA _____ SQ. FT.

REMARKS _____

DATE SYSTEM APPROVED

5/6/66

INSPECTOR

JH Kilmore

APPLICATION

A 09771

P

SEWAGE DISPOSAL TESTING

MARYLAND STATE DEPARTMENT OF HEALTH

HOWARD COUNTY

ELLICOTT CITY

Septic Tank - 750 gallons

DISTRICT 3

~~Drainage~~ - 12 ft in dia. by 12 ft. below the inlet DATE 3/16/65

located 43 ft from the front property line and
90 ft. off the left side property line as seen when
facing the lot from Taylor Park Rd. Locate inlet
at 3 ft below original grade

TO: THE COUNTY HEALTH OFFICER
ELLICOTT CITY, MARYLANDI, HEREBY, APPLY FOR THE NECESSARY TESTS IN ORDER TO CONSTRUCT (OR RECONSTRUCT) A SEWAGE
DISPOSAL SYSTEM.

PROPERTY OWNER The Debra Corporation

ADDRESS 122 Dunloggin Rd., Ellicott City, Md. PHONE HO 5-2224

PROPERTY LOCATION:

SUBDIVISION River Park Estates LOT NO. 23, Sec. 3

ROAD AND DESCRIPTION Taylor Park Road

OCCUPANT PHONE

PERSON TO CONSTRUCT SYSTEM

ADDRESS PHONE

SIZE OF LOT 43,750 sq. ft. TYPE BLDG. 3

NUMBER OF BEDROOMS

IF NOT SINGLE RESIDENCE DESCRIBE

SIGNATURE OF APPLICANT /s/ R. W. Griffith


APPROVED BY J. Hennigan FOR Dry Well. DATE 3-20-65

REJECTED BY FOR DATE

HOLD PENDING FURTHER TESTS DATE

REASONS FOR REJECTION OR HOLDING

THIS IS NOT A PERMIT

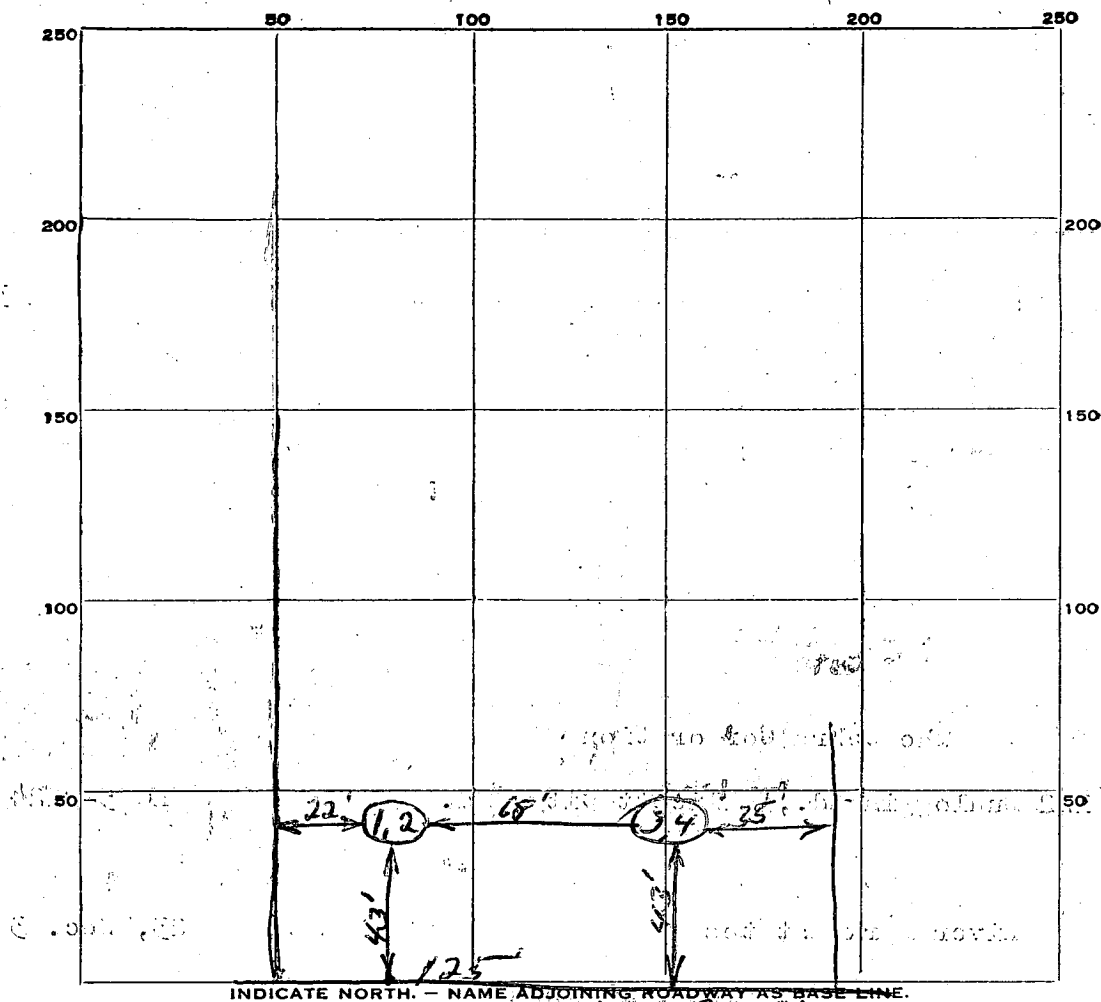

TAYLOR PARK ROAD

[illegible]

SOIL AUGER FINDING

TESTED BY.

REMARKS

ALSO PRESENT

LOT NO.

23 *See*