8/2/94

HOWARD COUNTY HEALTH DEPAR

BUREAU OF ENVIRONMENTAL HEALTH

PERMIT

SEWAGE DISPOSAL SYSTEM

DEPARTMENT OF HEALTH AND MENTAL HYGIENE

INDEAEU

P	50205W


A	REPAIR	

DISTRICT____

DATE \$10/94

DATE SYSTEM APPROVED 8/2/9

XXXXXXXX 313-2640	
INSPECTOR DKS	
Jack Fyock Septic Service IS PERMITTED TO INSTALL ALTER X	
ADDRESSPHONE 988-9270	
SUBDIVISIONLOTROAD 14009 Triadelphia Road	
PROPERTY OWNER	
14009 Triadelphia Road ADDRESS Glenelg, Maryland 21737	
SEPTIC TANK CAPACITY 1000 GALLONS 125	
NUMBER OF BEDROOMS 3	
125 SQUARE FEET PER BEDROOM	
LINEAR FEET OF TRENCH REQUIRED 54+	
REPAIR - PURPOSE - DRYWELL HAS FAILED. Call for inspection when ground is opened so sanitarian can recommend repair. 08	3702/
Install one 544 trench off existing drywell along rear of pro Trench to be 2' wide, inlet 3', bottom 10', stone 7'.	<u>er</u> t
PLANS APROVED BY LOTHO ON SOL DATE 8/2/94	
COVER NO WORK UNTIL INSPECTED AND APPROVED	
NEITHER THE HOWARD COUNTY COUNCIL NOR THE HEALTH DEPARTMENT IS RESPONSIBLE FOR THE SUCCESSFUL OPERATION OF ANY SYSTEM	,
NOTE: CLEANOUT REQUIRED EVERY 70 FEET OF SEWER LINE AND/OR AT 90° SWEEPS IN LINES FROM HOUSE TO DRAIN FIELDS, 90° ELBOWS ACCEPTABLE.	NOT
NOTE: ALL PARTS OF SEPTIC SYSTEMS (I.E. TANK, DISTRIBUTION BOX TRENCHES) TO BE 100 FEET FROM WELL (UNLESS OTHERWISE SPECIFICAL AUTHORIZED)	ALLY
NOTE: IF DEEP TRENCH(ES) ARE USED CALL FOR INSPECTION BEFORE AND AFTER PLACING GRAVEL IN TRENCH(ES)	
NOTE: NO DRY WELL SHALL EXCEED 15 FOOT IN DIAMETER NO ABSORPTION TRENCH TO EXCEED 100 FEET IN LENGTH	
NOTE: ALL PIPE FROM HOUSE TO SEPTIC TANK MUST BE CAST IRON OR SCHEDULE 35/40 PVC OR ABS	
PERMIT VOID AFTER TWO YEARS	
NOTE: INSTALL STAND PIPE ON SEPTIC TANK AND DRY WELL STAND PIPES MUST BE 6 INCHES IN DIAMETER CAST IRON. CONCRETE OR TERRA COTTA PVA OR ABS ACCEPTED. IF TOP OF SEPTIC TANK IS DEEPER THAN 3 FEET. MANHOLE TO GRADE REQUIRED.	A OR ➤
NOTE: DISTRIBUTION BOXES MUST HAVE BAFFLES	9

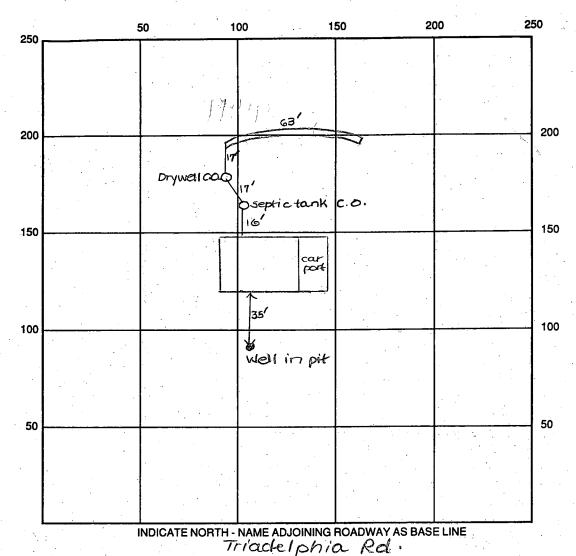

SEPTIC TANK LEVEL Existing CLEANOUTS one on Sit. one on drywell DISTRIBUTION BOX LEVEL __ N/A TRENCH WIDTH 2 FT. DRAIN FIELD/TITLE DEPTH /O FT. INLET DEPTH ___ TOTAL LENGTH 63 FT. EFFECTIVE GRAVEL DEPTH _____ FT. ONE SIDEWALL/ SQ. FT. NUMBER OF TRENCHES / EFFECTIVE DEPTH BELOW INLET EXISTINGET. DRYWALL INSIDE DIAMETER Existing FT. ABSORBENT AREA 441 SQ. FT. + Existing 8/2/94 OK to cover all work. DKS REMARKS: _ 8/2/94 DATE SYSTEM APPROVED **INSPECTOR**