

PERMIT

SEWAGE DISPOSAL SYSTEM

DEPARTMENT OF HEALTH AND MENTAL HYGIENE

HOWARD COUNTY HEALTH DEPARTMENT

BUREAU OF ENVIRONMENTAL HEALTH

~~XXXX-9933X~~

313-2640

INDEXED

DATE SYSTEM APPROVED

INSPECTOR

P 50427J
A 11740
A REPAIR

DISTRICT

DATE

12/5/94

11/9/94

C. R. J.

Jack Fyock Septic Service

IS PERMITTED TO INSTALL

ALTER

X

ADDRESS

PHONE 988-9270

SUBDIVISION Linden Chapel Woods

LOT 2

ROAD 5196 Ten Oaks Road

PROPERTY OWNER

Jim Wilson

ADDRESS

SEPTIC TANK CAPACITY (Existing) GALLONS

NUMBER OF BEDROOMS

3+

125+ SQUARE FEET PER BEDROOM

(plus old system)

LINEAR FEET OF TRENCH REQUIRED

65'

REPAIR - PURPOSE - SEPTIC SYSTEM HAS FAILED.

Call for inspection when ground is opened so sanitarian can recommend approval.
11/07/94

11/9/94 Trench to come off existing dry well, 2' wide, 8' deep, 3' inlet, 65' long, 50' sq. ft. effective area, old septic system.

PLANS APPROVED BY

C. R. J. @ site for Mrs. C. Williams

DATE

11/9/94

COVER NO WORK UNTIL INSPECTED AND APPROVED

NEITHER THE HOWARD COUNTY COUNCIL NOR THE HEALTH DEPARTMENT IS RESPONSIBLE FOR THE SUCCESSFUL OPERATION OF ANY SYSTEM

NOTE: CLEANOUT REQUIRED EVERY 70 FEET OF SEWER LINE AND/OR AT 90° SWEEPS IN LINES FROM HOUSE TO DRAIN FIELDS, 90° ELBOWS NOT ACCEPTABLE.

NOTE: ALL PARTS OF SEPTIC SYSTEMS (I.E. TANK, DISTRIBUTION BOX TRENCHES) TO BE 100 FEET FROM WELL (UNLESS OTHERWISE SPECIFICALLY AUTHORIZED)

NOTE: IF DEEP TRENCH(ES) ARE USED CALL FOR INSPECTION BEFORE AND AFTER PLACING GRAVEL IN TRENCH(ES)

NOTE: NO DRY WELL SHALL EXCEED 15 FOOT IN DIAMETER NO ABSORPTION TRENCH TO EXCEED 100 FEET IN LENGTH

NOTE: ALL PIPE FROM HOUSE TO SEPTIC TANK MUST BE CAST IRON OR SCHEDULE 35/40 PVC OR ABS

PERMIT VOID AFTER TWO YEARS


NOTE: INSTALL STAND PIPE ON SEPTIC TANK AND DRY WELL STAND PIPES MUST BE 6 INCHES IN DIAMETER CAST IRON, CONCRETE OR TERRA COTTA OR PVA OR ABS ACCEPTED. IF TOP OF SEPTIC TANK IS DEEPER THAN 3 FEET, MANHOLE TO GRADE REQUIRED.

NOTE: DISTRIBUTION BOXES MUST HAVE BAFFLES

*INSTALLER IS RESPONSIBLE FOR OBTAINING FINAL APPROVAL ON THIS PERMIT

*CALL 461-9933 FOR INSPECTION OF SEPTIC SYSTEM.

P50427J

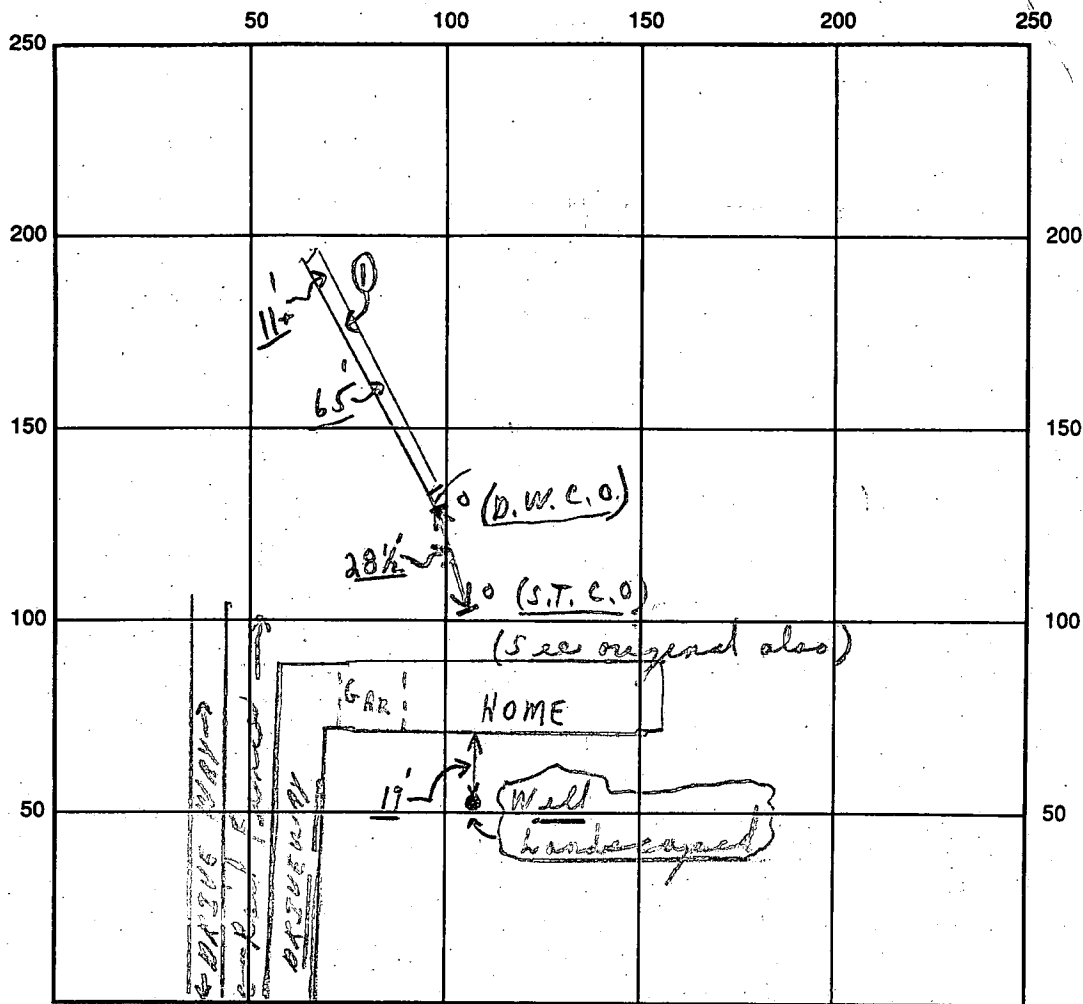

SEPTIC TANK LEVEL Existing CLEANOUTS (Existing @ S.T. + D.W.)
 DISTRIBUTION BOX LEVEL Using - old dry well
 DRAIN FIELD/TITLE DEPTH 11 FT. ^{+ overlap} TRENCH WIDTH 2 FT. INLET DEPTH 3' FT.
 EFFECTIVE GRAVEL DEPTH 8 FT. TOTAL LENGTH 65 FT.
 NUMBER OF TRENCHES 1 ONE SIDEWALL/BOTTOM AREA 520 SQ. FT. ^{ Plus old dry well }
 DRYWALL INSIDE DIAMETER ~ FT. EFFECTIVE DEPTH BELOW INLET ~ FT.
 ABSORBENT AREA 520 SQ. FT. ^(plus old dry well)

REMARKS: 11/9/94 Final (1 stop) - saw for end of trench - ok to cover as finish material on site; cbs

DATE SYSTEM APPROVED 11/9/94 INSPECTOR Charles B. Shuster

PERMIT

SEWAGE DISPOSAL SYSTEM

MARYLAND STATE DEPARTMENT OF HEALTH

HOWARD COUNTY

ELLICOTT CITY

INDEXED

DISTRICT 5

DATE 9-10-68

app - 925-68
also

P 13945

A 11740

Elwood Scaggs

IS PERMITTED TO INSTALL ☒ ALTER

ADDRESS Rfd. Murphy Rd., Laurel, Md. 20810

PHONE 725-0324

A SEWAGE DISPOSAL-SYSTEM LOCATED AT _____

SUBDIVISION Linden Chapel Woods

5796
ROAD Ten Oaks Road

LOT 2

PROPERTY OWNER Erich Nederlener

ADDRESS _____

SPECIFICATIONS 3 - bedrooms

DRAIN FIELD _____ DEPTH _____ FEET, BOTTOM AREA _____ SQ. FT.

SEEPAGE PITS _____ ABSORBENT SIDE-WALL AREA _____ SQ. FT.

SEPTIC TANK CAPACITY 750 GALLONS

FOR GARBAGE GRINDER, INCREASE DISPOSAL AREA 22% & TANK CAPACITY 50%.

OTHER Drywell 12 ft. in dia. by 9 ft. deep below the inlet located 150 ft. from the front property line and 61 ft. off the right side property line as seen when facing the lot from Ten Oaks Rd. Place inlet pipe 3 ft. below original grade.

PERMIT VOID AFTER THREE YEARS.

PLANS APPROVED BY R. Hodges

DATE 6-7-68

FILL SEPTIC TANK AND DISTRIBUTION BOX WITH WATER BEFORE CALLING FOR AN INSPECTION. COVER NO WORK UNTIL INSPECTED AND APPROVED.

NEITHER THE HOWARD COUNTY COMMISSIONERS NOR THE HEALTH DEPARTMENT IS RESPONSIBLE FOR THE SUCCESSFUL OPERATION OF ANY SYSTEM.


NOTIFY THE HEALTH DEPARTMENT 48 HOURS
BEFORE EXCAVATIONS ARE TO BE BACK FILLED.

A 11740

$$\begin{array}{r} 44 \\ 3 \\ \hline 172 \end{array}$$

$$\begin{array}{r} 3.14 \\ 13\frac{1}{2} \\ \hline 157 \\ 942 \\ 314 \\ \hline 4239 \end{array}$$

$$\begin{array}{r} 42.4 \\ 8\frac{1}{4} \\ \hline 106 \\ 3392 \\ \hline 349 \end{array}$$

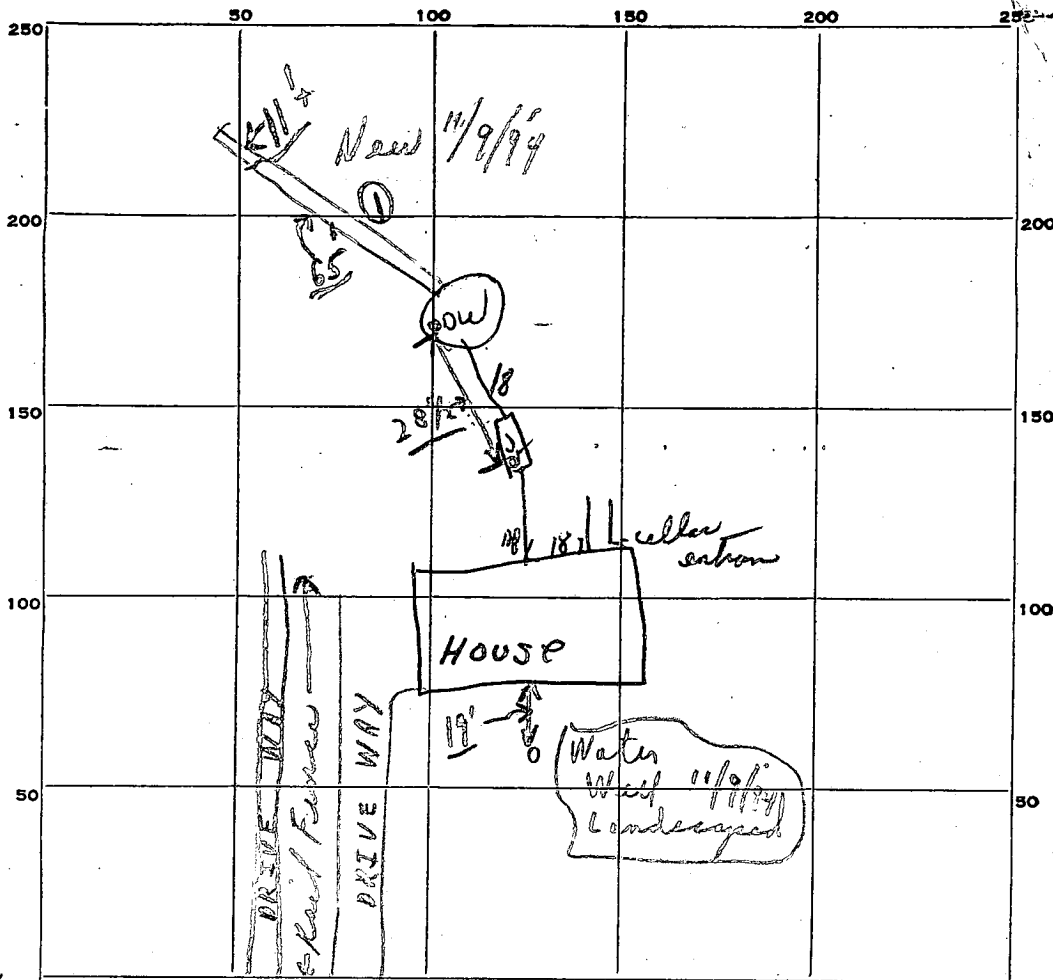

INDICATE NORTH. - NAME ADJOINING ROADWAY AS BASE LINE.

Ten Oaks Rd.

→ Dayton

PERMIT CARD _____

SEPTIC TANK, LEVEL OK

CLEANOUTS OK

DISTRIBUTION BOX, LEVEL _____

TILE FIELD, DEPTH _____ FT. TRENCH WIDTH _____ FT.

GRAVEL DEPTH _____ IN. TOTAL LENGTH _____ FT.

NUMBER OF TRENCHES _____ TOTAL BOTTOM AREA _____

SEEPAGE PITS, INSIDE DIAMETER 13 1/2 FT. DEPTH BELOW INLET 8 1/4 FT.

ABSORBENT AREA 349 + SQ. FT.

REMARKS _____

DATE SYSTEM APPROVED 9/35/68 INSPECTOR Sw. Mone

5204

3 375

11/9/94
 Length 65'
 Width 2'
 Depth 11'
 slope 8'
 only 2 1/2' to 2'

Preliminary

APPLICATION

SEWAGE DISPOSAL TESTING

MARYLAND STATE DEPARTMENT OF HEALTH

HOWARD COUNTY

ELLICOTT CITY

DISTRICT 5

DATE 4/20/66

A 11740

P _____

TO: THE COUNTY HEALTH OFFICER
ELLICOTT CITY, MARYLAND

I, HEREBY, APPLY FOR THE NECESSARY TESTS IN ORDER TO CONSTRUCT (OR RECONSTRUCT) A SEWAGE DISPOSAL SYSTEM.

PROPERTY OWNER Frank F. Willson

ADDRESS 14701 Layhill Rd., Silver Spring, Md. PHONE 384-1732

PROPERTY LOCATION:

SUBDIVISION Linden Chapel Woods

LOT NO. 2

ROAD AND DESCRIPTION Ten Oaks Road

OCCUPANT _____

PHONE _____

PERSON TO CONSTRUCT SYSTEM _____

ADDRESS _____

PHONE _____

SIZE OF LOT 1.045 acres

TYPE BLDG. 3
NUMBER OF BEDROOMS

IF NOT SINGLE RESIDENCE DESCRIBE _____

SIGNATURE OF APPLICANT /s/ Bob Johnsen


APPROVED BY R. Hodges FOR Drysdale DATE 7 June 68
(KIND OF SYSTEM)

REJECTED BY _____ FOR _____ DATE _____
(KIND OF SYSTEM)

HOLD PENDING FURTHER TESTS _____ DATE _____

REASONS FOR REJECTION OR HOLDING 7 June 68 + Final Plat approved Apr 67

THIS IS NOT A PERMIT

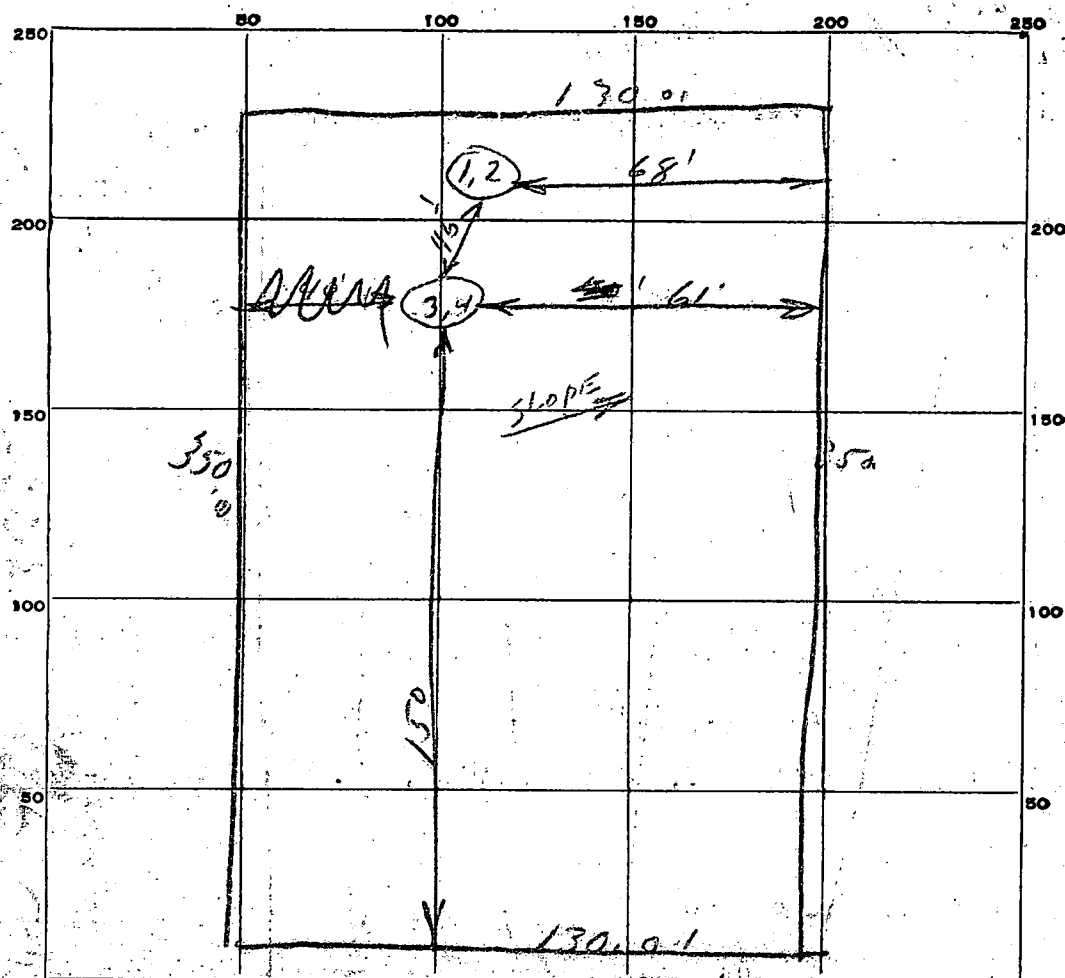[illegible]

SOIL AUGER FINDING

TESTED BY

REMARKS

Wait till preliminary OK'd before approval.

APPLICATION

A 11740

P _____

SEWAGE DISPOSAL TESTING

MARYLAND STATE DEPARTMENT OF HEALTH

HOWARD COUNTY

ELLICOTT CITY

DISTRICT 5

DATE 4/20/66

3 bedrooms - 750 gal. septic Tank.
Dry well, 12 ft. in dia by 9 ft. deep below
the inlet located 150 ft. from the front property
line and 61 ft. off the right side property line as
seen when facing the lot from Ten Oaks Road.
Place inlet pipe 3 ft. below original grade.

TO: THE COUNTY HEALTH OFFICER
ELLICOTT CITY, MARYLAND

I, HEREBY, APPLY FOR THE NECESSARY TESTS IN ORDER TO CONSTRUCT (OR RECONSTRUCT) A SEWAGE DISPOSAL SYSTEM.

PROPERTY OWNER Frank F. Willson

ADDRESS 14701 Layhill Rd., Silver Spring, Md. PHONE 384-1732

PROPERTY LOCATION:

SUBDIVISION Linden Chapel Woods LOT NO. 2

ROAD AND DESCRIPTION Ten Oaks Road

OCCUPANT _____ PHONE _____

PERSON TO CONSTRUCT SYSTEM _____

ADDRESS _____ PHONE _____

SIZE OF LOT 1.045 acres TYPE BLDG. 3

NUMBER OF BEDROOMS

IF NOT SINGLE RESIDENCE DESCRIBE _____

SIGNATURE OF APPLICANT /s/ Bob Johnsen

APPROVED BY R. Hodges FOR dry well DATE 6/7/68

(KIND OF SYSTEM)

REJECTED BY _____ FOR _____ DATE _____

(KIND OF SYSTEM)

HOLD PENDING FURTHER TESTS _____ DATE _____

REASONS FOR REJECTION OR HOLDING 7 June 68 - Final Plat

approved Apr 67

THIS IS NOT A PERMIT

State Office Building
ANNAPOLIS, MARYLAND 21401DEPARTMENT OF
WATER RESOURCESAPPLICATION MUST BE SUBMIT-
TED AND PERMIT RECEIVED BE-
FORE DRILLING IS STARTED.

APPLICATION FOR PERMIT TO DRILL WELL

No. 7145

Owner Erich Niederlehner

Street or R. F. D. _____

Post Office DaytonQuantity of Water to be Produced 3Gallons Per
MinuteTotal Quantity Needed For Use 1000Gallons Per
DayUse for Water HouseApproximate Depth of Well (feet) 100Method of Drilling to be used CableIs this a Replacement Well? Yes - (No)If YES, indicate date abandoned well is to be
sealed: _____

and by whom: _____

PERMIT TO DRILL WELL
(Not To Be Filled In By Driller)Well Permit No. Ho-69-W-10Samples of Cuttings Required by Department: ☒ Yes ☐ NoOwner Requires Permit to Appropriate Water: ☒ Yes ☐ NoOwner Has Permit to Appropriate Water: ☒ Yes ☐ No

Appropriation Permit No. _____

The applicant is herewith granted a permit to drill this well
subject to the conditions stipulated.Baul W. McKee Co. 7-9-68
Director Date

THIS PERMIT IS NOT TRANSFERRABLE

WITHOUT WRITTEN PERMISSION FROM THE DEPARTMENT

Special conditions that must be observed: _____

County Permit No. _____

Health Department Approval of Application

Howard

County Department of Health

or ☐ State Department of HealthApproved by Palmer F. WineTitle Director, Environmental HealthDate 7/8/68Driller Denny Brown License Number 113Street or R. F. D. Int aing Ind.

Post Office _____

Date July 5 1968Location of Well County HowardSubdivision Linder Chapel woodsSection _____ Lot 2Nearest Town DaytonDistance from Town 1 1/2 mileDirection from Town South

Description of Location of Well

(This information MUST BE ACCURATE, and should be definite
enough to permit locating well on a county map).Near what road Ten oak RdOn which side of road West

(North, East, South, West)

Distance from road 500 yardsDraw a sketch below showing location of well in relation to nearby towns,
roads and streams with NORTH in the direction of the arrow, and give distance
from well to nearest road junction or stream crossing shown on the sketch.
Distances may be approximate, but must be indicated.

NORTH

THIS REPORT
MUST BE SUBMITTED
WITHIN 30 DAYS
AFTER COMPLETION
OF THE WELL

WELL COMPLETION REPORT

WELL DESCRIPTION

WELL LOG

State the kind of formations penetrated, their color, their depth, their thickness, and if water-bearing

CASING AND SCREEN RECORD

State the kind and size and position of casing, liner, shoe, screen, and other accessories (if no casing used, give diameter of well).

Permit Number 4-69 W 18
Owner Emch Waterworks
Address Dayton
Subdivision Clinton Chapel
Section _____ Lot 2

PUMPING TEST

Hours Pumped _____
Type of Pump Used Bayler
Pumping Rate _____
Gallons per Minute _____

WATER LEVEL

(Distance from land surface to water)
Before Pumping 40 Ft.
When Pumping 75 Ft.

APPEARANCE OF WATER

Clear Partly Cloudy _____
Taste None
Odor None

Height of Casing Above Land
Surface 2 Ft.

PUMP INSTALLED

Type _____
Capacity _____
Gallons per Minute _____
Gallons per Hour _____
Pump Column Length _____ Ft.

LOCATION OF WELL ON LOT

Show permanent structures such as building(s), septic tank, and/or other landmarks and indicate not less than 2 distances (measurements) to well.

Dayton

NORTH

Clinton Chapel

you can see it

well 300 yards from intersection of Clinton Chapel

DATE
WELL WAS
COMPLETED

I hereby affirm that this report contains no willful misrepresentations or falsifications and that information given in this report is true, accurate and complete to the best of my knowledge and belief.

Diary Brown, Well Driller

Well Driller License No.: 113

oct 2 1968

HOWARD COUNTY
MARYLAND STATE DEPARTMENT OF HEALTH
199 COURT HOUSE DRIVE
ELLICOTT CITY, MARYLAND 21043

WELL COMPLETION REPORT

This report must be submitted within 10 days after completion of the well.

This is to certify that the well which has been completed on the below property has been constructed and disinfected in compliance with the regulations and specifications of the State Board of Health.

The following construction and performance characteristics were noted:

1. Type, diameter and length of casing 6 In. D. 55 ft
2. Total depth of well 102 ft
3. Type, diameter and length of strainer _____. Size of screen openings _____
4. Method of sealing top and bottom of screen _____
5. Method of grouting Cement. Quantity, cement used 2 Bags lbs.
Gallons water 10
6. Standing water level (depth below ground surface when not pumping) 40
7. Yield of well in gallons per minute 5; elevation of water surface when pumped at the designated rate 76 ft
8. Number of hours pump operated at stipulated rate during pumping test 1
9. Record of any other pumping performance None
10. Log of materials encountered during drilling Rock from 52 ft
11. Physical appearance of water at end of final pumping test Partly Clear
12. Variation in vertical alignment (how much the well casing varies from a truly plumb line) throughout its depth None
13. Disinfected by 12 ounces of Clorox % Chlorine (Brand name _____).

Property Owner Erich Riederlich Address Dayton Lot 2
Location of Property Linden Chapel wood sub
Health Department Number _____ Dept. of Water Resources Permit No. H-69 W 18

Date: Oct 2, 1968

Denny Brown
Signature of Well Driller

INSTRUCTIONS: This form is to be completed in duplicate and certified by the Well Driller upon completion of each drilled well. One copy will be forwarded to the property owner by the Health Department along with the final approval of the well.