

PERMIT

SEWAGE DISPOSAL SYSTEM

DEPARTMENT OF HEALTH AND MENTAL HYGIENE

03-291049

HOWARD COUNTY HEALTH DEPARTMENT

BUREAU OF ENVIRONMENTAL HEALTH

XXV6X-8938X

313-2640

INDEXED

5/1/95 P.C.O.

P 50696 J

A REPAIR

DISTRICT 3rd

DATE 5/18/95

DATE SYSTEM APPROVED 5/1/95

INSPECTOR C.B. 10/1

Jack Fyock Septic Service

IS PERMITTED TO INSTALL ☐ ALTER ☒

ADDRESS 13775 Triadelphia Road, Glenelg, Maryland 21737 PHONE 988-9270

SUBDIVISION River Park Estates LOT 22 ROAD 1112 Taylor Park Drive

PROPERTY OWNER Robert L. McDonald

ADDRESS

SEPTIC TANK CAPACITY GALLONS

NUMBER OF BEDROOMS

SQUARE FEET PER BEDROOM

LINEAR FEET OF TRENCH REQUIRED

REPAIR - PURPOSE - SEPTIC SYSTEM HAS FAILED.

Call for inspection when ground is opened so sanitarian can recommend repair. 04/25/95

(1) New trench added → 70'± long; 2' wide inlet; maximum depth 11 1/2'±; 7 1/2" of stone added to trench under pipe - location off - new dist box & 18'± off existing trench. C.B. in field for "C.W."

PLANS APPROVED BY DATE 5/1/95

COVER NO WORK UNTIL INSPECTED AND APPROVED

NEITHER THE HOWARD COUNTY COUNCIL NOR THE HEALTH DEPARTMENT IS RESPONSIBLE FOR THE SUCCESSFUL OPERATION OF ANY SYSTEM

NOTE: CLEANOUT REQUIRED EVERY 70 FEET OF SEWER LINE AND/OR AT 90° SWEEPS IN LINES FROM HOUSE TO DRAIN FIELDS, 90° ELBOWS NOT ACCEPTABLE.

NOTE: ALL PARTS OF SEPTIC SYSTEMS (I.E. TANK, DISTRIBUTION BOX TRENCHES) TO BE 100 FEET FROM WELL (UNLESS OTHERWISE SPECIFICALLY AUTHORIZED)

NOTE: IF DEEP TRENCH(ES) ARE USED CALL FOR INSPECTION BEFORE AND AFTER PLACING GRAVEL IN TRENCH(ES)

NOTE: NO DRY WELL SHALL EXCEED 15 FOOT IN DIAMETER NO ABSORPTION TRENCH TO EXCEED 100 FEET IN LENGTH

NOTE: ALL PIPE FROM HOUSE TO SEPTIC TANK MUST BE CAST IRON OR SCHEDULE 35/40 PVC OR ABS


PERMIT VOID AFTER TWO YEARS

NOTE: INSTALL STAND PIPE ON SEPTIC TANK AND DRY WELL STAND PIPES MUST BE 6 INCHES IN DIAMETER CAST IRON. CONCRETE OR TERRA COTTA OR PVA OR ABS ACCEPTED. IF TOP OF SEPTIC TANK IS DEEPER THAN 3 FEET. MANHOLE TO GRADE REQUIRED.

NOTE: DISTRIBUTION BOXES MUST HAVE BAFFLES

*INSTALLER IS RESPONSIBLE FOR OBTAINING FINAL APPROVAL ON THIS PERMIT

P 50696 J

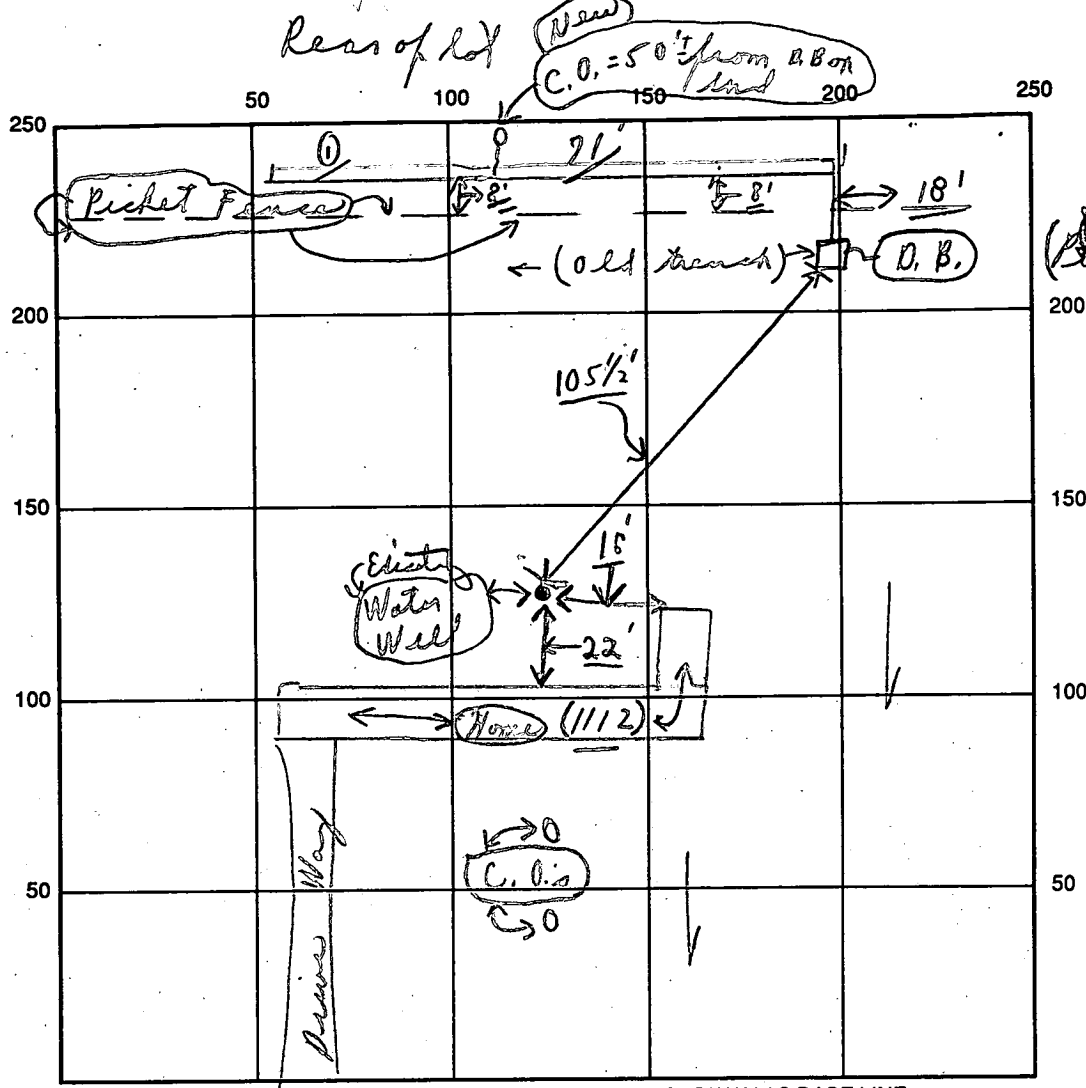

INDICATE NORTH - NAME ADJOINING ROADWAY AS BASE LINE

← "Taylor Park Drive" →

SEPTIC TANK LEVEL Existing CLEANOUTS Existing { New C.O. in trench }

DISTRIBUTION BOX LEVEL Existing (Replaced)

DRAIN FIELD/TITLE DEPTH New 11 1/2' + average TRENCH WIDTH 2 FT. INLET DEPTH 4 FT.

EFFECTIVE GRAVEL DEPTH 7 1/2' + TOTAL LENGTH 71 FT. (Plus - old system)

NUMBER OF TRENCHES NEW 1 ONE SIDEWALL/BOTTOM AREA 532.5 SQ. FT.

DRYWALL INSIDE DIAMETER ~ FT. EFFECTIVE DEPTH BELOW INLET ~ FT.

ABSORBENT AREA 532.5 + (old system) SQ. FT.

REMARKS: (Note) 5/1/95 Partial, ok to continue on repair, chd
5/1/95 Late (P.M.) Final on repair - chd (ok to cover
as finish last end of trench) - material on site)

DATE SYSTEM APPROVED Repair 5/1/95 INSPECTOR Charles Egan Utcher

8/8/72 8/15/72
2pm after 12 noon
8/15/72
Final OK
R. Tamm

PERMIT

SEWAGE DISPOSAL SYSTEM

P 17303

A

MARYLAND STATE DEPARTMENT OF HEALTH

HOWARD COUNTY

ELLICOTT CITY

INDEXED

DISTRICT 3rd

DATE 8/7/72

8/15/72
as soon as possible
File

Gen Ketterman

IS PERMITTED TO INSTALL ALTER X

ADDRESS Jerry's Drive, Ellicott City, Md.

PHONE 531-5449

A SEWAGE DISPOSAL SYSTEM LOCATED AT

SUBDIVISION ROAD 1112 Taylor Park Drive LOT

PROPERTY OWNER Mr. Russell Pinto Robert L McDonald

ADDRESS Star Route 1, Taylor Park Drive, Sykesville, Md.

SPECIFICATIONS

DRAIN FIELD DEPTH FEET, BOTTOM AREA SQ. FT.

SEEPAGE PITS ABSORBENT SIDE-WALL AREA SQ. FT.

SEPTIC TANK CAPACITY GALLONS

FOR GARBAGE GRINDER, INCREASE DISPOSAL AREA 22% & TANK CAPACITY 50%.

OTHER REPAIR - Call for inspection when ground is opened up and Sanitarian will recommend repair system.

8/8/72 - trench 50ft long - 2ft wide - 11 ft deep (if possible) - 1ft gravel under pipe - call for inspection of trench before gravel is installed. pump must be used - water tight pump pit - cast iron pipe to be used within 50ft radius of

PLANS APPROVED BY Palmer F. Wine

DATE 8/7/72

well & trench area are loaded & cants
FILL SEPTIC TANK AND DISTRIBUTION BOX WITH WATER BEFORE CALLING FOR AN INSPECTION. COVER NO WORK UNTIL INSPECTED AND APPROVED.

trench run 11' with house down

NEITHER THE HOWARD COUNTY COMMISSIONERS NOR THE HEALTH DEPARTMENT IS RESPONSIBLE FOR THE SUCCESSFUL OPERATION OF ANY SYSTEM.

OK to use existing tank - if in good cond.

8/11/72 F.F. said if line from pump is not cast iron any part of this line within a 50FT radius of well must be run through a larger pipe.

17303

INDEXED

File

Work covered when
inspector arrived
C. B. D.

PERMIT

SEWAGE DISPOSAL SYSTEM

MARYLAND STATE DEPARTMENT OF HEALTH

HOWARD COUNTY

ELLCOTT CITY

DISTRICT 3

DATE 8/30/71

P 16274

A _____

Russell Pinto

Charles Dwyer

IS PERMITTED TO INSTALL ALTER X

ADDRESS 1112 Taylor Park Road, Sykesville, Md. PHONE 442-2273

A SEWAGE DISPOSAL SYSTEM LOCATED AT _____

SUBDIVISION River Park Estates ROAD 1112 Taylor Park LOT 22, Sec. 3

PROPERTY OWNER same as above Robert L. McDonald

ADDRESS _____

SPECIFICATIONS

DRAIN FIELD _____ DEPTH _____ FEET, BOTTOM AREA _____ SQ. FT.

SEEPAGE PITS _____ ABSORBENT SIDE-WALL AREA _____ SQ. FT.

SEPTIC TANK CAPACITY _____ GALLONS

FOR GARBAGE GRINDER, INCREASE DISPOSAL AREA 22% & TANK CAPACITY 50%.

OTHER REPAIR - Call for inspection when ground is opened up and Sanitarian

will recommend repair system. 9/10/71 - trench to be 8 to 9 ft deep - not less than

one foot across - 3 ft wide - total length 50 ft -

with as much ground as possible - minimum amount of ground 3 ft across

pipe: lay pipe as high as you can. Call for inspection of trench before

PLANS APPROVED BY Palmer F. Wine DATE 8/30/71 ground is installed


FILL SEPTIC TANK AND DISTRIBUTION BOX WITH WATER BEFORE CALLING FOR AN INSPECTION. COVER NO WORK UNTIL INSPECTED AND APPROVED.

NEITHER THE HOWARD COUNTY COMMISSIONERS NOR THE HEALTH DEPARTMENT IS RESPONSIBLE FOR THE SUCCESSFUL OPERATION OF ANY SYSTEM.

209770

43,750 sq. ft.

16274

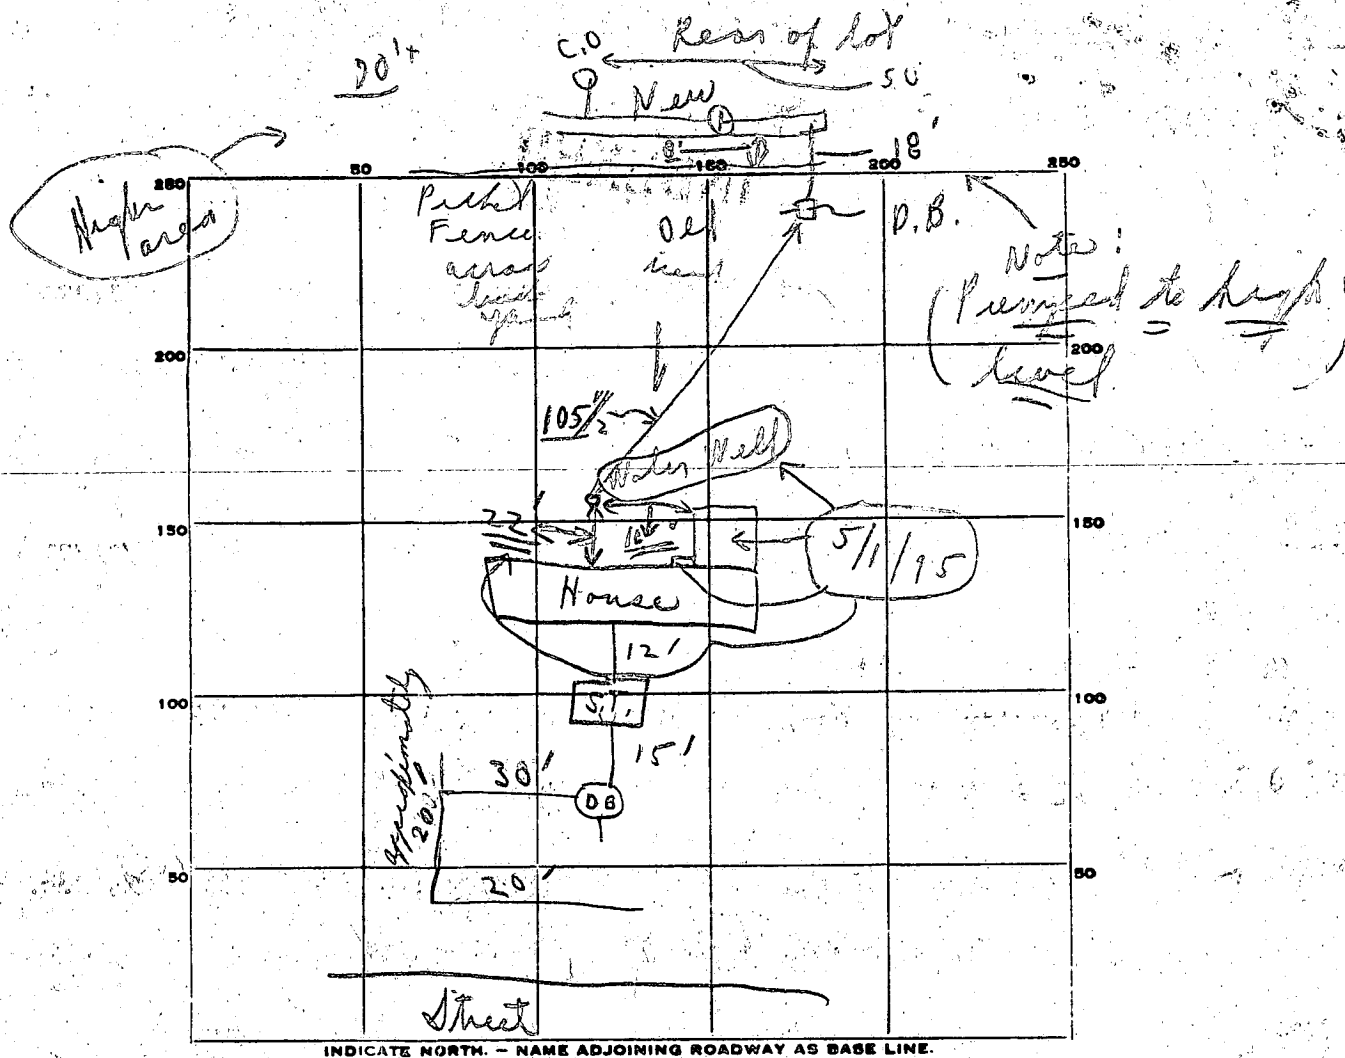

INDICATE NORTH. - NAME ADJOINING ROADWAY AS BASE LINE.

PERMIT CARD _____

SEPTIC TANK, LEVEL _____

CLEANOUTS _____

DISTRIBUTION BOX, LEVEL _____

(Baffle in 5/1/95)

TILE FIELD, DEPTH _____ FT. TRENCH WIDTH _____ FT.

GRAVEL DEPTH _____ IN. TOTAL LENGTH _____ FT.

NUMBER OF TRENCHES _____ TOTAL BOTTOM AREA _____

SEEPAGE PITS, INSIDE DIAMETER _____ FT. DEPTH BELOW INLET _____ FT.

ABSORBENT AREA _____ SQ. FT.

4 ft. gravel under pipe according to Pinto

REMARKS _____

9/17/91- 2:45 P.M. Mr. Shump said they could cover at their own. Mr. Pinto said he was covering 70 ft. long trench- 3 ft wide- 9 ft. deep going back to 5 ft. - when 55 tons of stone used per Mr. Pinto

DATE SYSTEM APPROVED _____

INSPECTOR _____

Note

On 9/17/91 C. Streaker Covered at their own risk. Found everything covered over. Spoke to Mr. Pinto