

PERMIT

SEWAGE DISPOSAL SYSTEM

DEPARTMENT OF HEALTH AND MENTAL HYGIENE

HOWARD COUNTY HEALTH DEPARTMENT

BUREAU OF ENVIRONMENTAL HEALTH

461-9933

313-2640

INDEXED

INDEXED

No House Connection

P 56586

A 56591
REPAIR

DISTRICT _____

DATE 4-30-96

DATE SYSTEM APPROVED _____

INSPECTOR _____

Jenkins Brothers

IS PERMITTED TO INSTALL _____ ALTER ☒ X

ADDRESS 7670 Smiths Private Road, Sykesville, MD 21784 PHONE 410-465-6646

SUBDIVISION Burleigh Manor LOT #3 ROAD 3950 White Rose Way

PROPERTY OWNER William Reynolds

ADDRESS _____

SEPTIC TANK CAPACITY 1000 GALLONS

NUMBER OF BEDROOMS 24'x24' Pool Bathhouse (system sized for equivalent of 3 Bedroom House)

210 SQUARE FEET PER BEDROOM

LINEAR FEET OF TRENCH REQUIRED 90

REPAIR - PURPOSE - SEPTIC REPAIR FOR EXISTING POOL HOUSE.

Call for inspection when ground is opened so sanitarian can recommend repair

Install one 90' Long, 24" wide, 9" Dia Bottom, 3" Dia Top, 6" Dia Stone Fill Trench.
OK to install single trench with a 90 degree Bend to accommodate near Flat site. Future
Trenches will need to fit original contours. R. P. R. 5/3/96

PLANS APPROVED BY R. P. R. DATE 5/3/96

COVER NO WORK UNTIL INSPECTED AND APPROVED

NEITHER THE HOWARD COUNTY COUNCIL NOR THE HEALTH DEPARTMENT IS RESPONSIBLE FOR THE SUCCESSFUL OPERATION OF ANY SYSTEM

NOTE: CLEANOUT REQUIRED EVERY 70 FEET OF SEWER LINE AND/OR AT 90° SWEEPS IN LINES FROM HOUSE TO DRAIN FIELDS, 90° ELBOWS NOT ACCEPTABLE.

NOTE: ALL PARTS OF SEPTIC SYSTEMS (I.E. TANK, DISTRIBUTION BOX TRENCHES) TO BE 100 FEET FROM WELL (UNLESS OTHERWISE SPECIFICALLY AUTHORIZED)

NOTE: IF DEEP TRENCH(ES) ARE USED CALL FOR INSPECTION BEFORE AND AFTER PLACING GRAVEL IN TRENCH(ES)

NOTE: NO DRY WELL SHALL EXCEED 15 FOOT IN DIAMETER NO ABSORPTION TRENCH TO EXCEED 100 FEET IN LENGTH

NOTE: ALL PIPE FROM HOUSE TO SEPTIC TANK MUST BE CAST IRON OR SCHEDULE 35/40 PVC OR ABS

PERMIT VOID AFTER TWO YEARS

NOTE: INSTALL STAND PIPE ON SEPTIC TANK AND DRY WELL STAND PIPES MUST BE 6 INCHES IN DIAMETER CAST IRON. CONCRETE OR TERRA COTTA OR PVA OR ABS ACCEPTED. IF TOP OF SEPTIC TANK IS DEEPER THAN 3 FEET. MANHOLE TO GRADE REQUIRED.

NOTE: DISTRIBUTION BOXES MUST HAVE BAFFLES


*INSTALLER IS RESPONSIBLE FOR OBTAINING FINAL APPROVAL ON THIS PERMIT

HD-260(6-90)

*CALL 461-9933 FOR INSPECTION OF SEPTIC SYSTEM.

Add'l. Pool House
BLDG. PERMIT SIGNED
AND RETURNED 5-15-96
Serial # 64913

A 56591

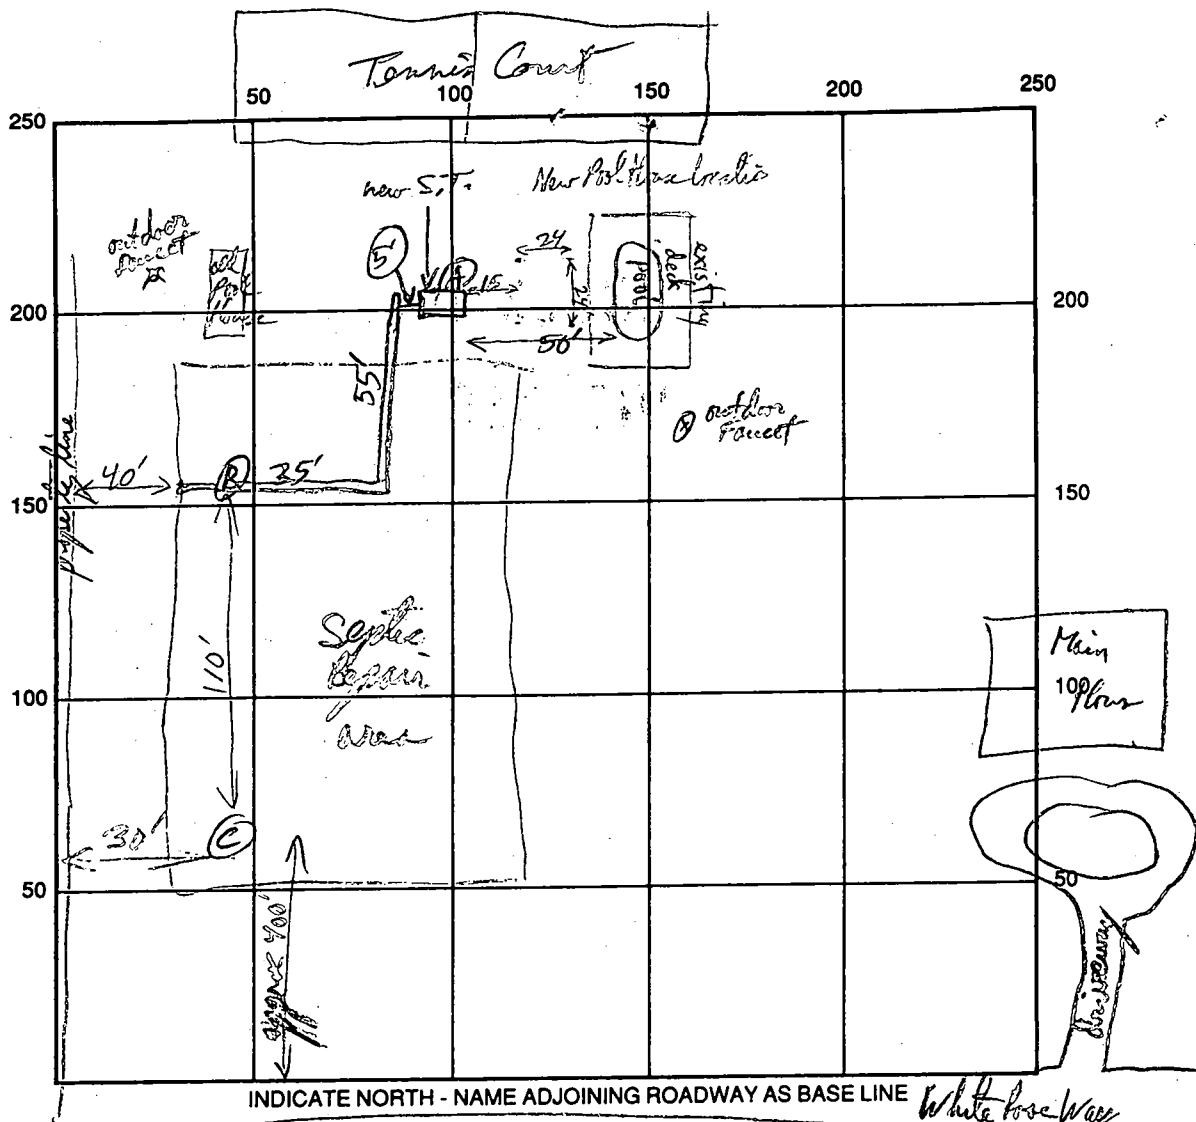

SEPTIC TANK LEVEL 1000 gal (mid second) CLEANOUTS S.T. ✓

DISTRIBUTION BOX LEVEL NA

DRAIN FIELD/TITLE DEPTH 9 FT. TRENCH WIDTH _____ FT. INLET DEPTH _____ FT.

EFFECTIVE GRAVEL DEPTH _____ FT. TOTAL LENGTH _____ FT.

NUMBER OF TRENCHES _____ ONE SIDEWALL/BOTTOM AREA _____ SQ. FT.

DRYWALL INSIDE DIAMETER _____ FT. EFFECTIVE DEPTH BELOW INLET _____ FT.

ABSORBENT AREA _____ SQ. FT.

REMARKS: Septic Tank location OK. Perc Tests OK for septic installed.

Trench installed as shown - OK to cover 11/8 5/3/96

No House Connection yet - New Bly has not been installed 11/8 5/3/96

12/11/99 No house connection as of this date - Repair indexed but not approved AM

DATE SYSTEM APPROVED _____ INSPECTOR _____

HOWARD COUNTY

PERMIT APPLICATION

DEPARTMENT OF INSPECTIONS, LICENSES & PERMIT
3430 COURT HOUSE DRIVE, ELLICOTT CITY, MARYLAND 21043

SERIAL NUMBER

64 913

BUILDING ADDRESS (HOUSE NO., STREET, TOWN OR AREA)
3950 White Rose Way
Ellicott City, MD 20042

LOT NO. 3	PARCEL NO.	SEC. 3	AREA 1	BLOCK NO.	LIBER	FOLIO
SUB DIVISION Beverly Manor			ZONE	ZONE MAP	ELEC. DIST. 3	CENSUS TR.

OWNER NAME AND ADDRESS: WILLIAM Reginald's 3950 White Rock Way Ellicott City, MD 21047	PHONE NO. 410-461-2619
---	---------------------------

OCCUPANT'S NAME AND ADDRESS	PHONE NO.
Smt	

ARCHITECT OR ENGINEER'S NAME AND ADDRESS PHONE NO.

N/A

CONTRACTOR'S NAME AND ADDRESS	PHONE NO.
Botanical Decorators 10341 Owen Brown Rd Columbia, MD 21044	995.0300

EXISTING USE Single Family Detached	PROPOSED USE SFD w/ pool house
--	-----------------------------------

EST. CONSTRUCTION COST	LICENSE NUMBER	PERMIT FEE
150000	38775	

GRADING/SEDIMENT CONTROL ☐ YES ☐ NO SDP # _____

DESCRIPTION OF WORK AUTHORIZED

Construct pool house
at Bath at corner
road on
the corner of
the corner of

SIZE OF BLDG.	FRONT	DEPTH	HEIGHT

TYPE OF BLDG.	AREA	VOLUME	ROOF
B. ROOMS			
ROOMS			
BATHS			
FIREPLACES			

FOOTINGS	FOUNDATION	S. WALLS

UTILITIES					
WATER/WELL	SEWER/SEPTIC	GAS	ELECTRICITY	TYPE OF HEAT	AC
				oil	

I have carefully examined and read this application and know the same is true and correct, and that is doing this work, all provisions of Howard County Ordinances and the State Laws of Maryland will be complied with, whether specified or not; and I will notify the Department of Inspections, and Permits twenty-four hours in advance when I am ready for the inspections called for elsewhere in the application; and that no work will be covered up until such inspections have been complied with.

[Signature]
SIGNATURE

Mr. [Name] 3-6-96
TITLE DATE

W/S CODE **FOR OFFICE USE ONLY**

DISTANCE IN FEET FROM R/W LINE TO FRONT BUILDING LINE _____

SIDE YARD _____
(DISTANCE IN FEET FROM SIDE BLDG. LINE TO SIDE PROPERTY LINE)

TO SIDE BUILDING LINE _____
DISTANCE IN FEET, REAR YD. REQUIRING SET _____

BACK _____ (CORNER LOT ONLY) _____ SDP # _____

Check payable to: DIRECTOR OF FINANCE OF HOWARD COUNTY

FUNCTION	DATE	SIGNATURE APPROVAL
ZONING/PLANNING		
SHA		
SEDIMENT/GRADING		
BUILDING OFFICIAL		
WATER & SEWER		
HEALTH DEPT.	6/15/96	Bruce Pickney / T
FIRE PROTECTION		
STORM WATER MGMT		

CAUTION

To begin construction before a permit placard has been issued and displayed on the job is a violation of the law.

Use and occupancy permit must be applied for two weeks before it will be issued.

APPROVED _____ DATE _____

LP-69-591

Distribution of Copies:
 White - Building Official
 Green - Planning & Zoning

Yellow - Engineering
Pink - Health Dept.
Gold - S.H.A.

PERMIT

SEWAGE DISPOSAL SYSTEM

DEPARTMENT OF HEALTH AND MENTAL HYGIENE

HOWARD COUNTY HEALTH DEPARTMENT
BUREAU OF ENVIRONMENTAL HEALTH

461-9933x 313-2640

INDEXED

P 48430

A REPAIR

DISTRICT

DATE 8/13/92

DATE SYSTEM APPROVED 8/5/92

INSPECTOR RH

Jenkins Brothers

IS PERMITTED TO INSTALL ☐ ALTER ☒

ADDRESS 7670 Smiths Private Road, Sykesville, Maryland PHONE 461-9282

SUBDIVISION Burleigh Manor, Sec. 3 LOT 3, Area 1 ROAD 3950 White Rose Way

PROPERTY OWNER William Reynolds
3950 White Rose Way

ADDRESS

SEPTIC TANK CAPACITY 1500 GALLONS

NUMBER OF BEDROOMS 5

180 SQUARE FEET PER BEDROOM

LINEAR FEET OF TRENCH REQUIRED 130

REPAIR - PURPOSE - Septic System has failed.

Call for inspection when ground is opened so sanitarian can recommend repair-8/03/92

8/4/92 - TRENCH - 11 FT DEEP, 2 FT WIDE 7 FT 5 INCH
INLET 4 FT PUT A Baffle IN OLD HAND MADE
1250 GAL TANK OK TO USE A "T" PIPE TO SPLIT
THE TRENCH INTO 2 PARTS. RUN TRENCH OFF OLD
TANK TO PERC HOLE #1 & AWAY FROM OLD

PLANS APPROVED BY DATE

COVER NO WORK UNTIL INSPECTED AND APPROVED

NEITHER THE HOWARD COUNTY COUNCIL NOR THE HEALTH DEPARTMENT IS RESPONSIBLE FOR THE SUCCESSFUL OPERATION OF ANY SYSTEM

NOTE: CLEANOUT REQUIRED EVERY 70 FEET OF SEWER LINE AND/OR AT 90° SWEEPS IN LINES FROM HOUSE TO DRAIN FIELDS, 90° ELBOWS NOT ACCEPTABLE.

NOTE: ALL PARTS OF SEPTIC SYSTEMS (I.E. TANK, DISTRIBUTION BOX TRENCHES) TO BE 100 FEET FROM WELL (UNLESS OTHERWISE SPECIFICALLY AUTHORIZED)

NOTE: IF DEEP TRENCH(ES) ARE USED CALL FOR INSPECTION BEFORE AND AFTER PLACING GRAVEL IN TRENCH(ES)

NOTE: NO DRY WELL SHALL EXCEED 15 FOOT IN DIAMETER NO ABSORPTION TRENCH TO EXCEED 100 FEET IN LENGTH

NOTE: ALL PIPE FROM HOUSE TO SEPTIC TANK MUST BE CAST IRON OR SCHEDULE 35/40 PVC OR ABS

PERMIT VOID AFTER TWO YEARS

NOTE: INSTALL STAND PIPE ON SEPTIC TANK AND DRY WELL STAND PIPES MUST BE 6 INCHES IN DIAMETER CAST IRON. CONCRETE OR TERRA COTTA OR PVA OR ABS ACCEPTED. IF TOP OF SEPTIC TANK IS DEEPER THAN 3 FEET. MANHOLE TO GRADE REQUIRED.

NOTE: DISTRIBUTION BOXES MUST HAVE BAFFLES


*INSTALLER IS RESPONSIBLE FOR OBTAINING FINAL APPROVAL ON THIS PERMIT

HD-260(6-90)

*CALL 461-9933 FOR INSPECTION OF SEPTIC SYSTEM.

Add to Pool House
BLDG. PERMIT SIGNED
AND RETURNED 5-15-96
Serial # 621913

48430

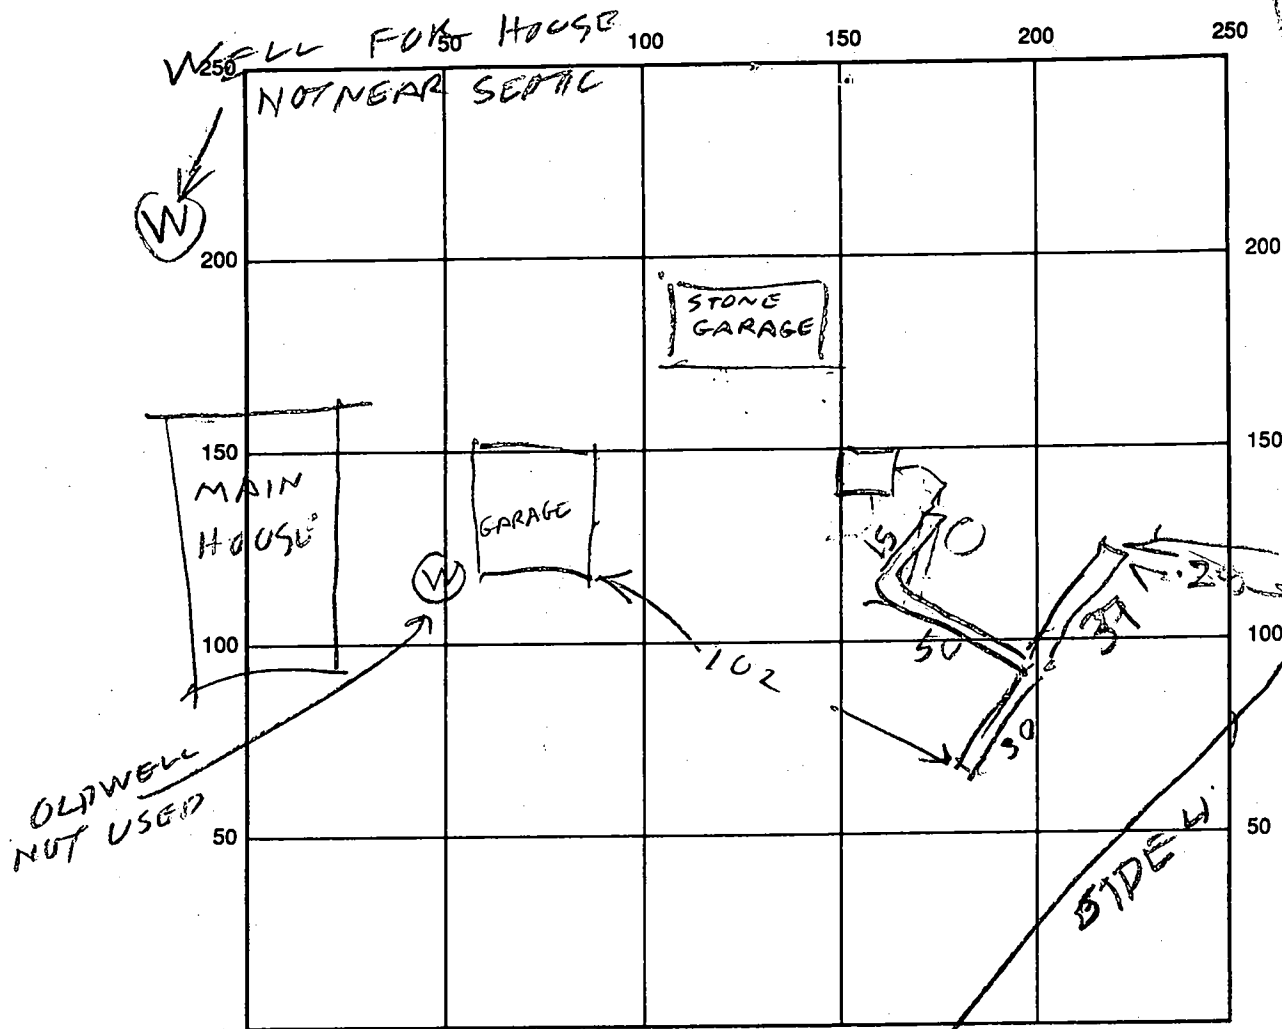

SEPTIC TANK LEVEL _____ CLEANOUTS OK

DISTRIBUTION BOX LEVEL _____

DRAIN FIELD/TITLE DEPTH 11 FT. TRENCH WIDTH 2 FT. INLET DEPTH 3 1/2 FT.

EFFECTIVE GRAVEL DEPTH 7 FT. TOTAL LENGTH 132 FT.

NUMBER OF TRENCHES ONE WITH T¹¹ PIPE ONE SIDEWALL/BOTTOM AREA 924 SQ. FT.

DRYWALL INSIDE DIAMETER _____ FT. EFFECTIVE DEPTH BELOW INLET _____ FT.

ABSORBENT AREA _____ SQ. FT.

REMARKS: 8/4/92 REPAIR PERC OK SEE SHEET

8/5/92 TRENCH OK

DATE SYSTEM APPROVED 8/5/92

INSPECTOR Raymond J. Hodge

8-3-92

Septic Repair Permit - 10:00am
Tuesday 8-4-92

Jenkins to Install 461-9282

3950 White Rose Way

Burleigh Manor Sec 3, Area 1, Lot 3

William Reynolds owner

5 bedrooms

F10-H

Public sewer is available on
Contract 2878-D-W & S (\$2800.00 + plumber)

Drainfields failing. House 3000 ft to road.

Require percolation testing prior
to installation of septic system
(C. Mellon approved repair request.)

Please type a repair permit.
Give to installer in field. Check
will be mailed.

Thanks

Jane Nadeau

APPLICATION

PERCOLATION TESTING

A _____
P 48430

HOWARD COUNTY HEALTH DEPARTMENT

BUREAU OF ENVIRONMENTAL HEALTH

3525-H ELLICOTT MILLS DRIVE/ELLICOTT CITY, MARYLAND 21043
TELEPHONE: 313-2640

DISTRICT _____

DATE _____

TO: THE COUNTY HEALTH OFFICER
ELLICOTT CITY, MARYLAND

Repair Per

I HEREBY APPLY FOR THE NECESSARY TEST PRIOR TO APPLICATION FOR PERMIT TO CONSTRUCT (OR RECONSTRUCT) A SEWAGE DISPOSAL SYSTEM.

PROPERTY OWNER William Reynolds

ADDRESS 350 White Rose Way PHONE _____

AGENT OR PROSPECTIVE BUYER _____

ADDRESS _____ PHONE _____

PROPERTY LOCATION:

SUBDIVISION BURLEIGH MANOR LOT NO. 3 Sect 3 Area 1

ROAD AND DESCRIPTION 3950 WHITE ROSE WAY

TAX MAP _____ PARCEL # _____

SIZE OF LOT _____ TYPE BLDG. REPAIR TO SFD
(3000' TO PUBLIC SEWER)
(SINGLE FAMILY DWELLING OR COMMERCIAL)

THE SYSTEM INSTALLED UNDER THIS APPLICATION IS ACCEPTABLE ONLY UNTIL PUBLIC FACILITIES BECOME AVAILABLE. I FULLY UNDERSTAND THE FEE CONNECTED WITH THE FILING OF THIS PERC TEST APPLICATION IS NON-REFUNDABLE UNDER ANY CIRCUMSTANCES. I ALSO AGREE TO COMPLY WITH ALL M.O.S.H.A. REQUIREMENTS IN TESTING THIS LOT.

(SIGNATURE OF APPLICANT)

APPROVED BY _____ FOR _____ DATE _____

DISAPPROVED BY _____ FOR _____ DATE _____

HOLD PENDING FURTHER TESTS _____


REASONS FOR REJECTION OR HOLDING _____

PERCOLATION TEST PLAT/PRELIMINARY PLAT - TITLE OR I.D. # _____ DATE _____

SITE DEVELOPMENT PLAN/FINAL PLAT - TITLE OR I.D. # _____ DATE _____

THIS IS NOT A PERMIT

INLET DEPTH 4 MAXIMUM BOTTOM DEPTH 11 SQ. FT./BEDROOM 180

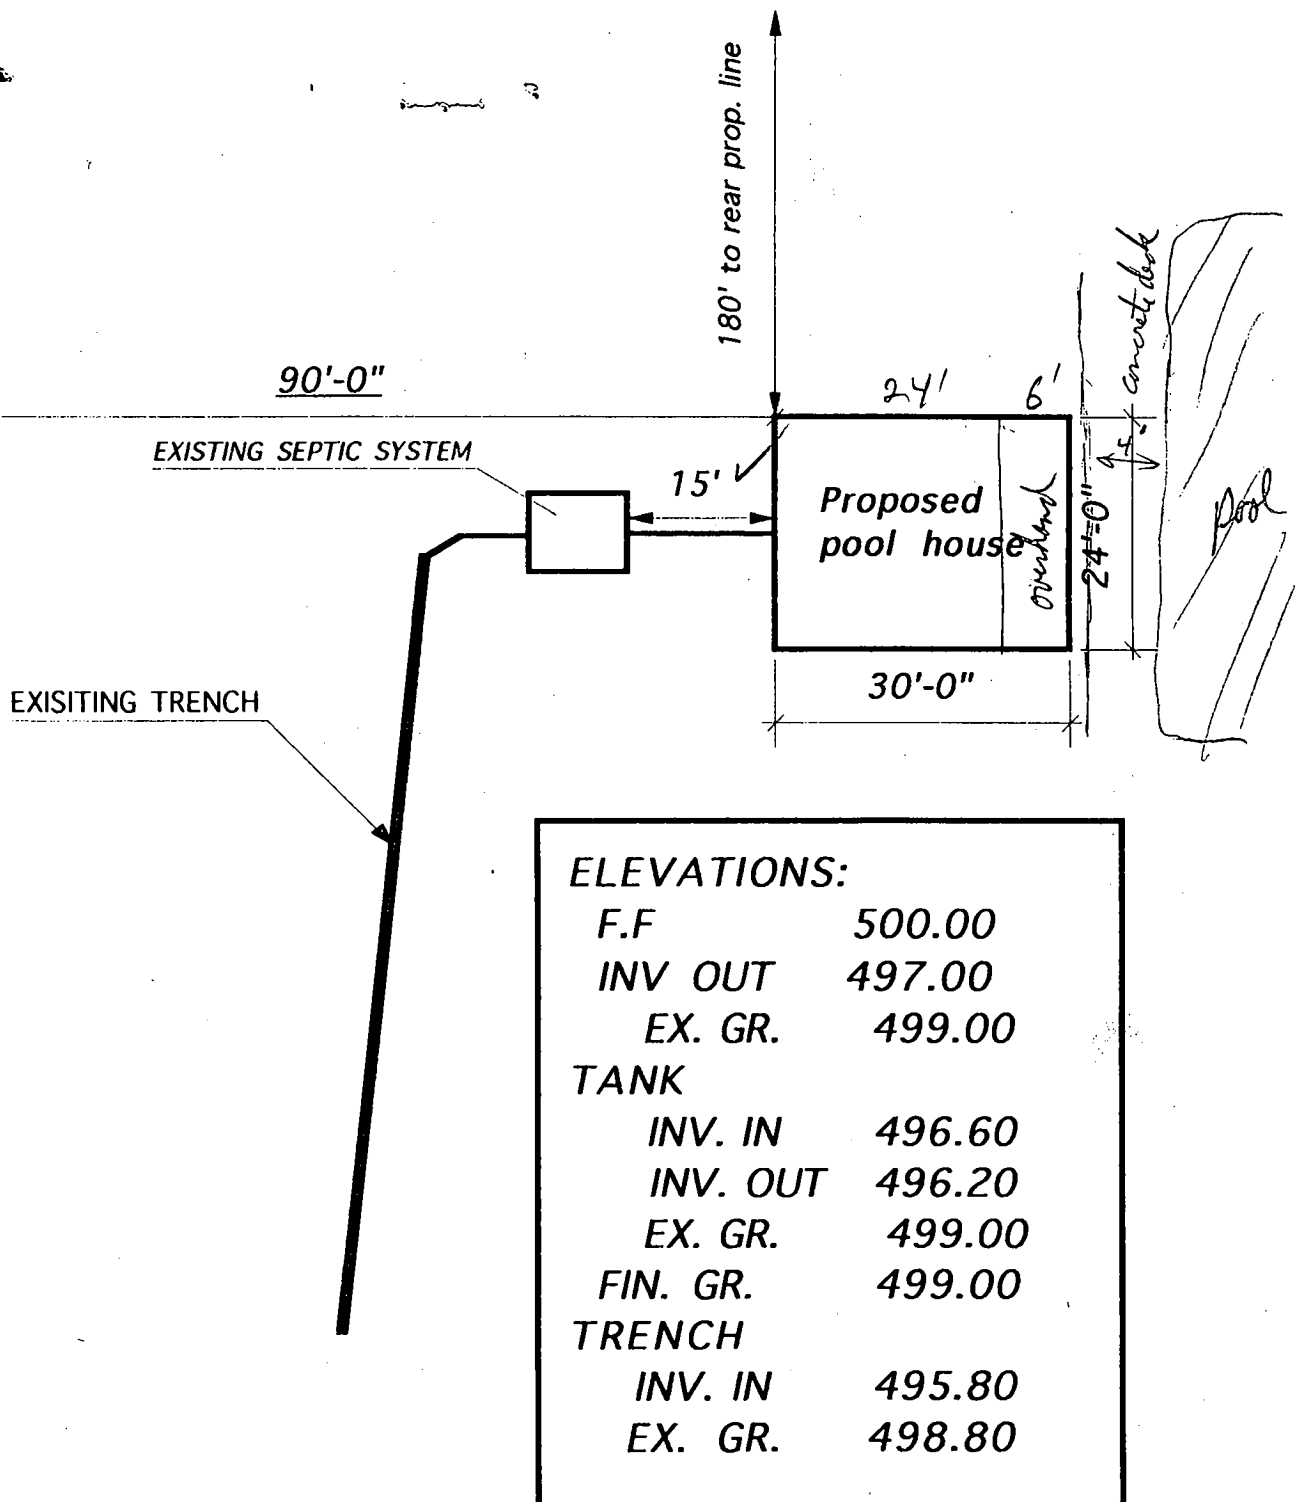

SCALE: 1" = 20'

Site is very limited. Only 50ft between existing septic tank and Pool (sidewalk, not deck) given the deck width a 30ft long house oriented as shown above would be less than 10ft from S.T. At the time of Septic repair, the stated pool house dimensions were 24' x 24' and installation was based on that measurement.

5/15/96 infield stake corners of Pool house are as seen previously on 5/3/96, entire ft was explained as an overhang which would extend to begin of existing deck. OK to approve P.P. Rpt 5/15/96

2000-8 END: SP



BOTANICAL DECORATORS

The Landscape Company

10344 Owen Brown Road
Columbia, Maryland 21044
410-995-0300 • 301-854-0880
Fax/Voice Mail 410-995-0381

Barry L. Wood
President

RECEIVED
HOWARD CO. HEALTH DEPT.
ENVIRONMENTAL HEALTH
96 MAY - 8 AM 10:24

5/31/94

APPLICATION

PERCOLATION TESTING

A 56591

P _____

HOWARD COUNTY HEALTH DEPARTMENT

BUREAU OF ENVIRONMENTAL HEALTH

3525-H ELLICOTT MILLS DRIVE/ELLICOTT CITY, MARYLAND 21043

TELEPHONE: 313-2640

DISTRICT _____

DATE _____

TO: THE COUNTY HEALTH OFFICER
ELLICOTT CITY, MARYLAND

I HEREBY APPLY FOR THE NECESSARY TEST PRIOR TO APPLICATION FOR PERMIT TO CONSTRUCT (OR RECONSTRUCT) A SEWAGE DISPOSAL SYSTEM.

PROPERTY OWNER Reynolds Residence

ADDRESS 3950 White Rose Way PHONE 461-2619

E.C. # 21042

AGENT OR PROSPECTIVE BUYER Fred C. Dickson Co.

ADDRESS 5414 Mineral Hill Rd PHONE 781-6786

PROPERTY LOCATION:

SUBDIVISION Burleigh Manor Sec 3 LOT NO. 3 Area 1

ROAD AND DESCRIPTION 3950 White Rose Way - Perk & re inst. V

existing system for pool house

TAX MAP _____ PARCEL # _____

SIZE OF LOT _____ TYPE BLDG. _____

(SINGLE FAMILY DWELLING OR COMMERCIAL)

THE SYSTEM INSTALLED UNDER THIS APPLICATION IS ACCEPTABLE ONLY UNTIL PUBLIC FACILITIES BECOME AVAILABLE. I FULLY UNDERSTAND THE

FEE CONNECTED WITH THE FILING OF THIS PERC TEST APPLICATION IS NON-REFUNDABLE UNDER ANY CIRCUMSTANCES. I ALSO AGREE TO

COMPLY WITH ALL M.O.S.H.A. REQUIREMENTS IN TESTING THIS LOT. [Signature]

(SIGNATURE OF APPLICANT)

APPROVED BY _____ FOR _____ DATE _____

DISAPPROVED BY _____ FOR _____ DATE _____

HOLD PENDING FURTHER TESTS _____

REASONS FOR REJECTION OR HOLDING _____

PERCOLATION TEST PLAT/PRELIMINARY PLAT - TITLE OR I.D. # _____ DATE _____

SITE DEVELOPMENT PLAN/FINAL PLAT - TITLE OR I.D. # _____ DATE _____

THIS IS NOT A PERMIT

P56586

COUNTY #


A66591

SOIL PROFILE

0' B
6" dark brn sil (New A)
18" Reddish mica
sil (fill)
24" dark brn
sil old topsoil
4' Red-Yel Rd
HL-HSL
6' Reddish Brown
Mica Loom
to very light
Mica Loom
13' Reddish Brn
Amica L-SL

13' (ST. hole) A
Fill
18' Topsoil
24" dark brn sil
orange
L-SIL-HSL
Very good
Quantity Structure
45' Reddish Yel
-Reddish Brn
Amica Loom

C
Red Brn HL
STO Brn HL
SIL-HSL
4' purple Red
(with some
yellow patches)
Mica L-SL
5% Str + Sign. lite
+ 5-10%
schist gravel
(5YR 8/10)
pale blue
Sand
12'
12 1/2'

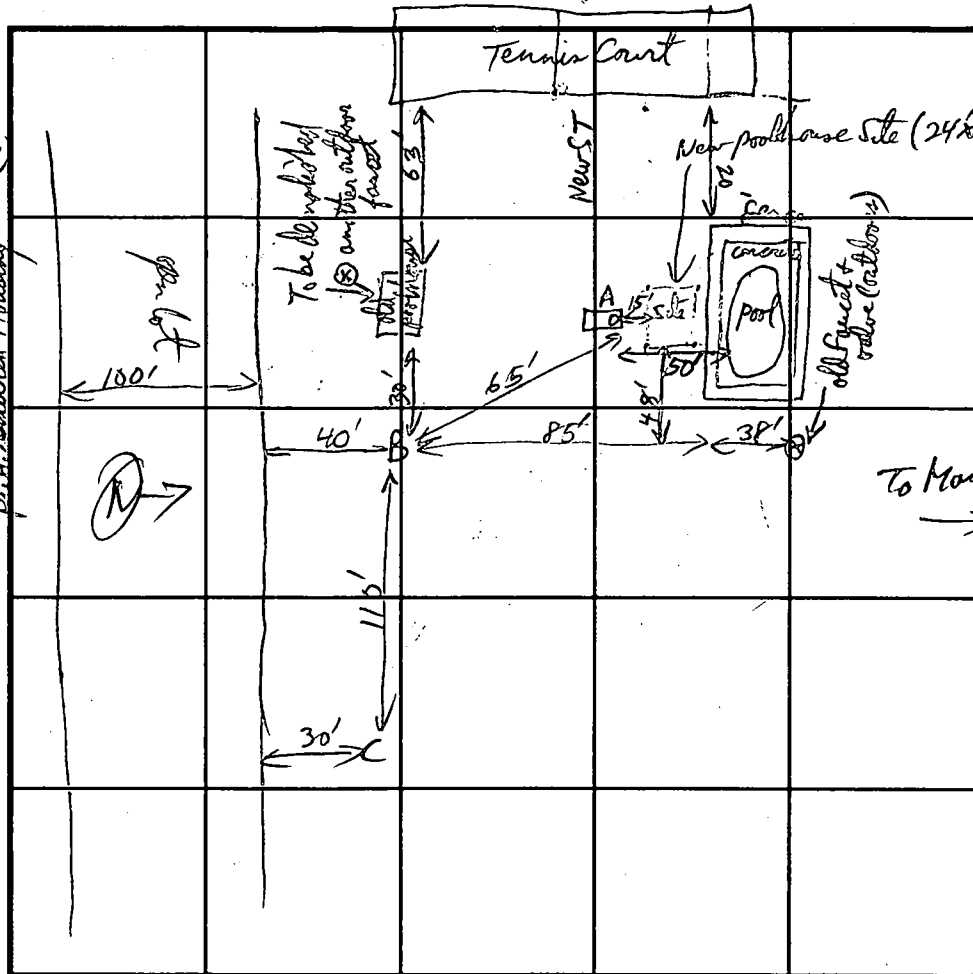


SOIL PROFILE




INDICATE NORTH - NAME ADJOINING ROADWAY AS BASE LINE.

DATE	TEST NO.	DEPTH	PRE-WET		TEST - 1" DROP		TIME
			START	STOP	START	STOP	
5/3/96	B	6 1/2	9:22:00	9:32:00	9:32:00	9:44	(12 min) OK
		V13	soils ok any depth - best below 5 ft				
	A	7 1/2	Soils too hard				
	C	V5	10:14	10:25	10:25	10:45	(20 min) OK
		V12					

REMARKS OK any depth - moderate rates only (good treatment)
TYPE OF SOIL Chester
TESTED BY R. P. Kelly ALSO PRESENT Tomlin & Bros.
TRENCH DESIGN DATA: AVERAGE PERCOLATION TIME 12-20 TRENCH WIDTH 2
INLET DEPTH 3-4 MAXIMUM BOTTOM DEPTH 8 SQ. FT./BEDROOM 210-240

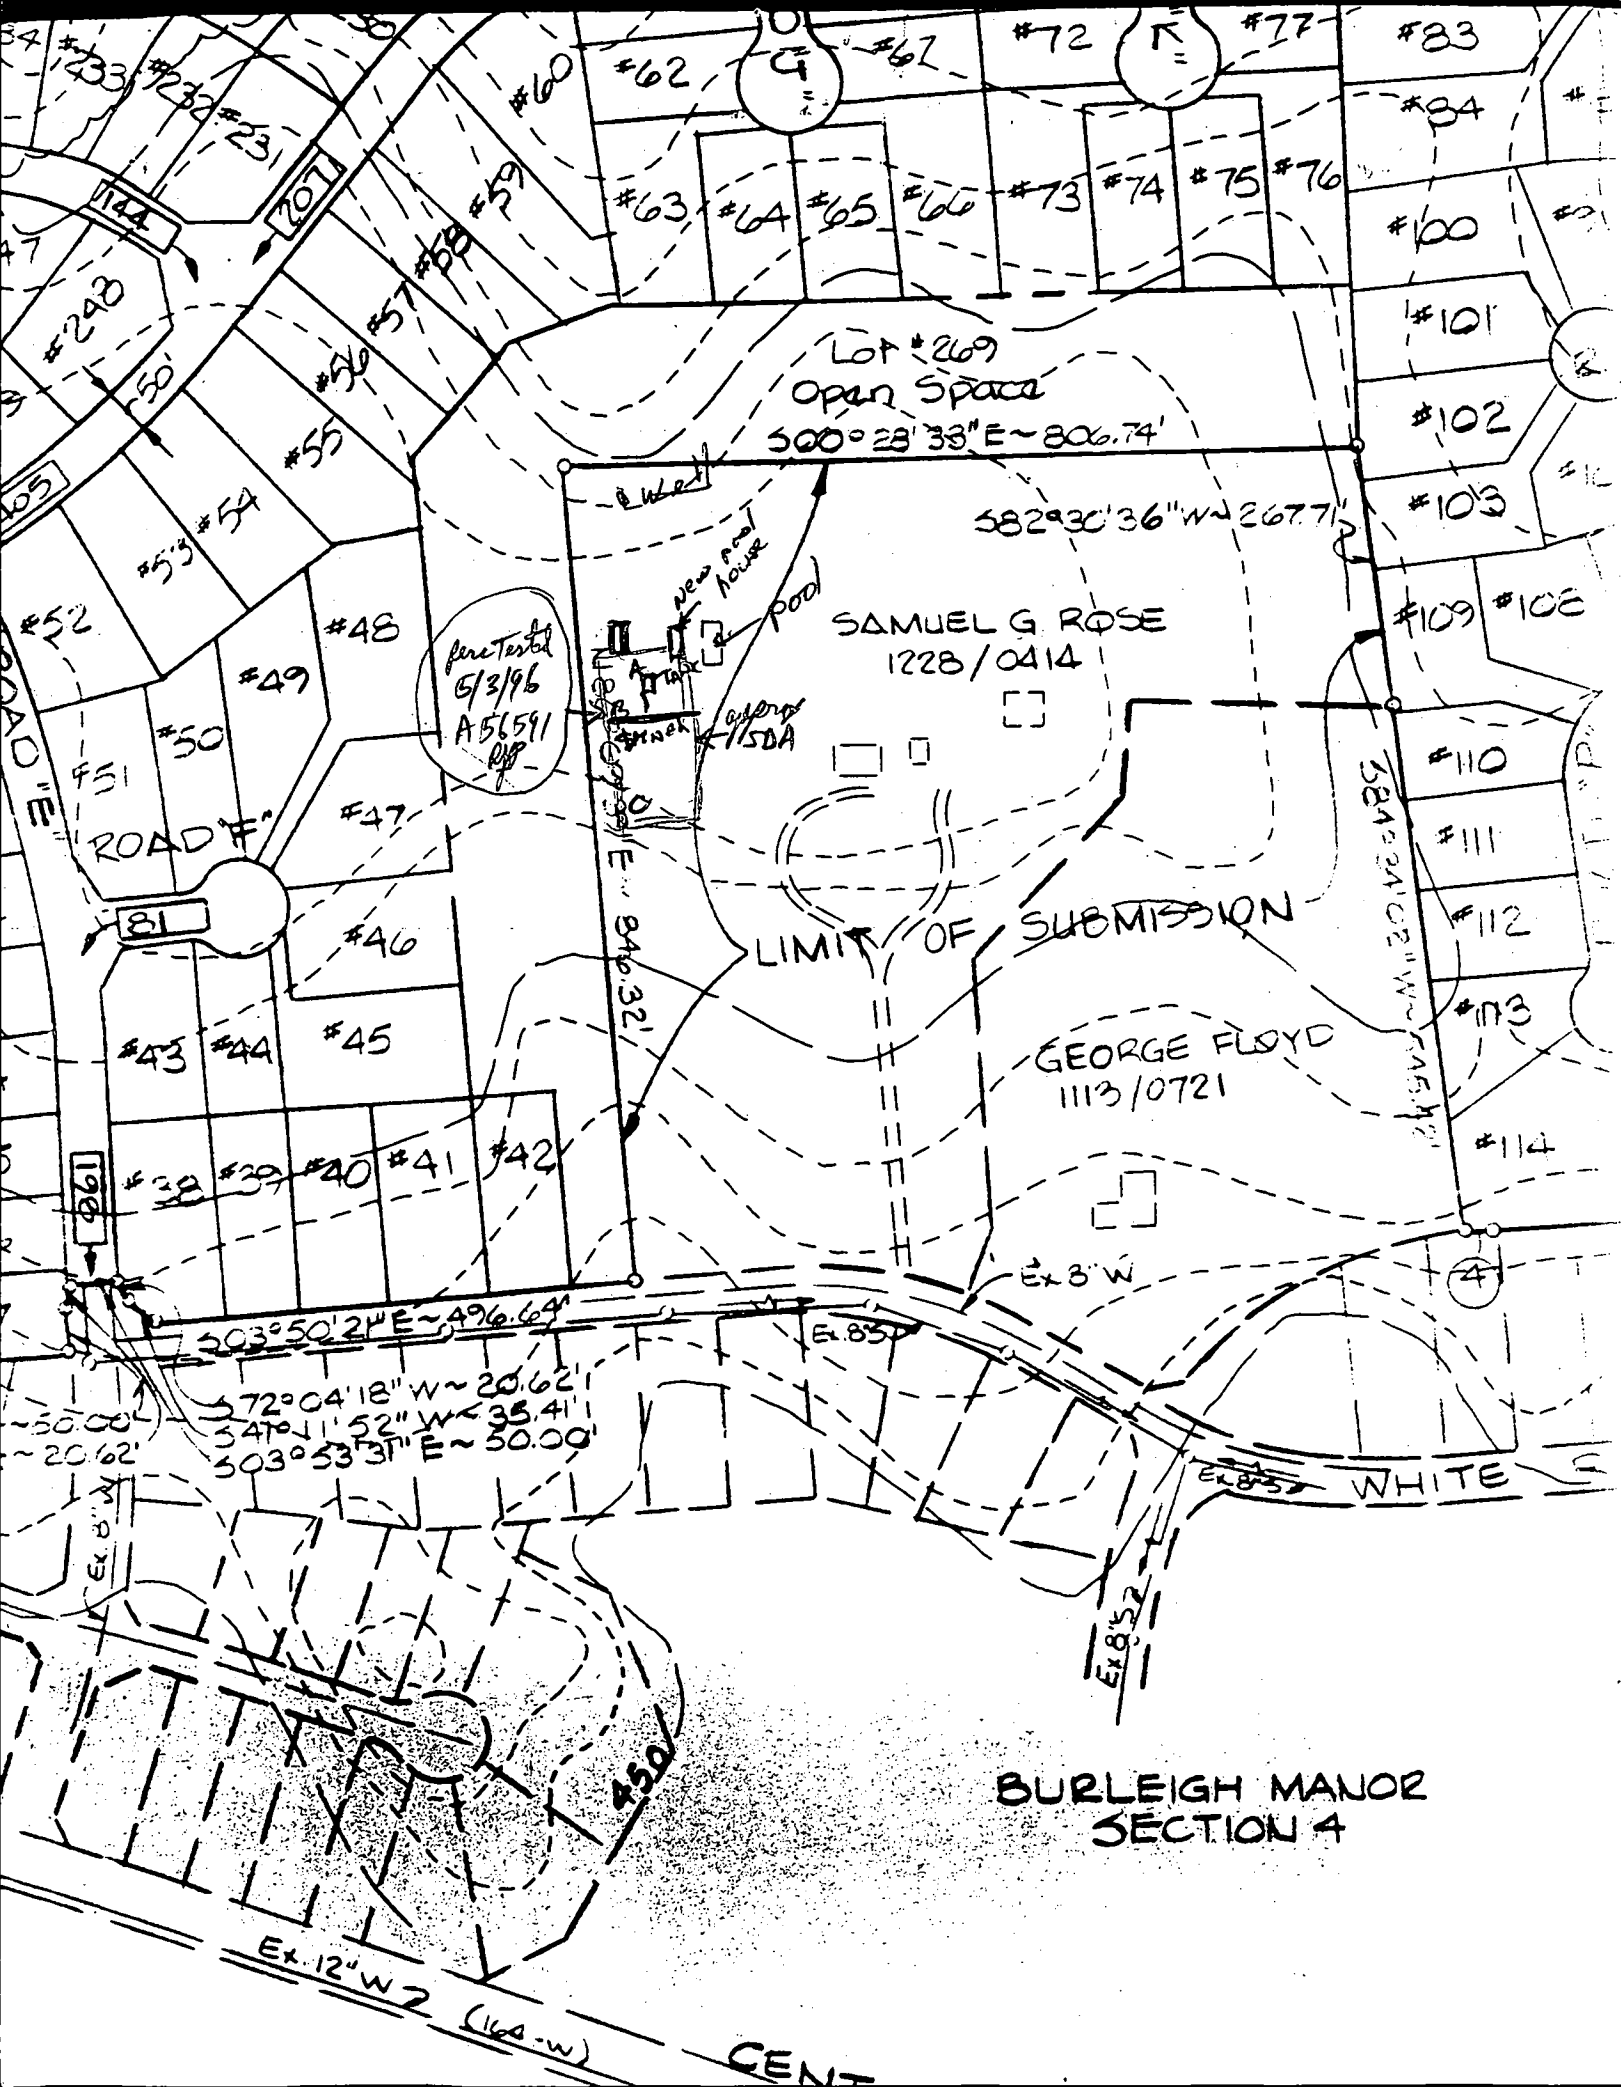

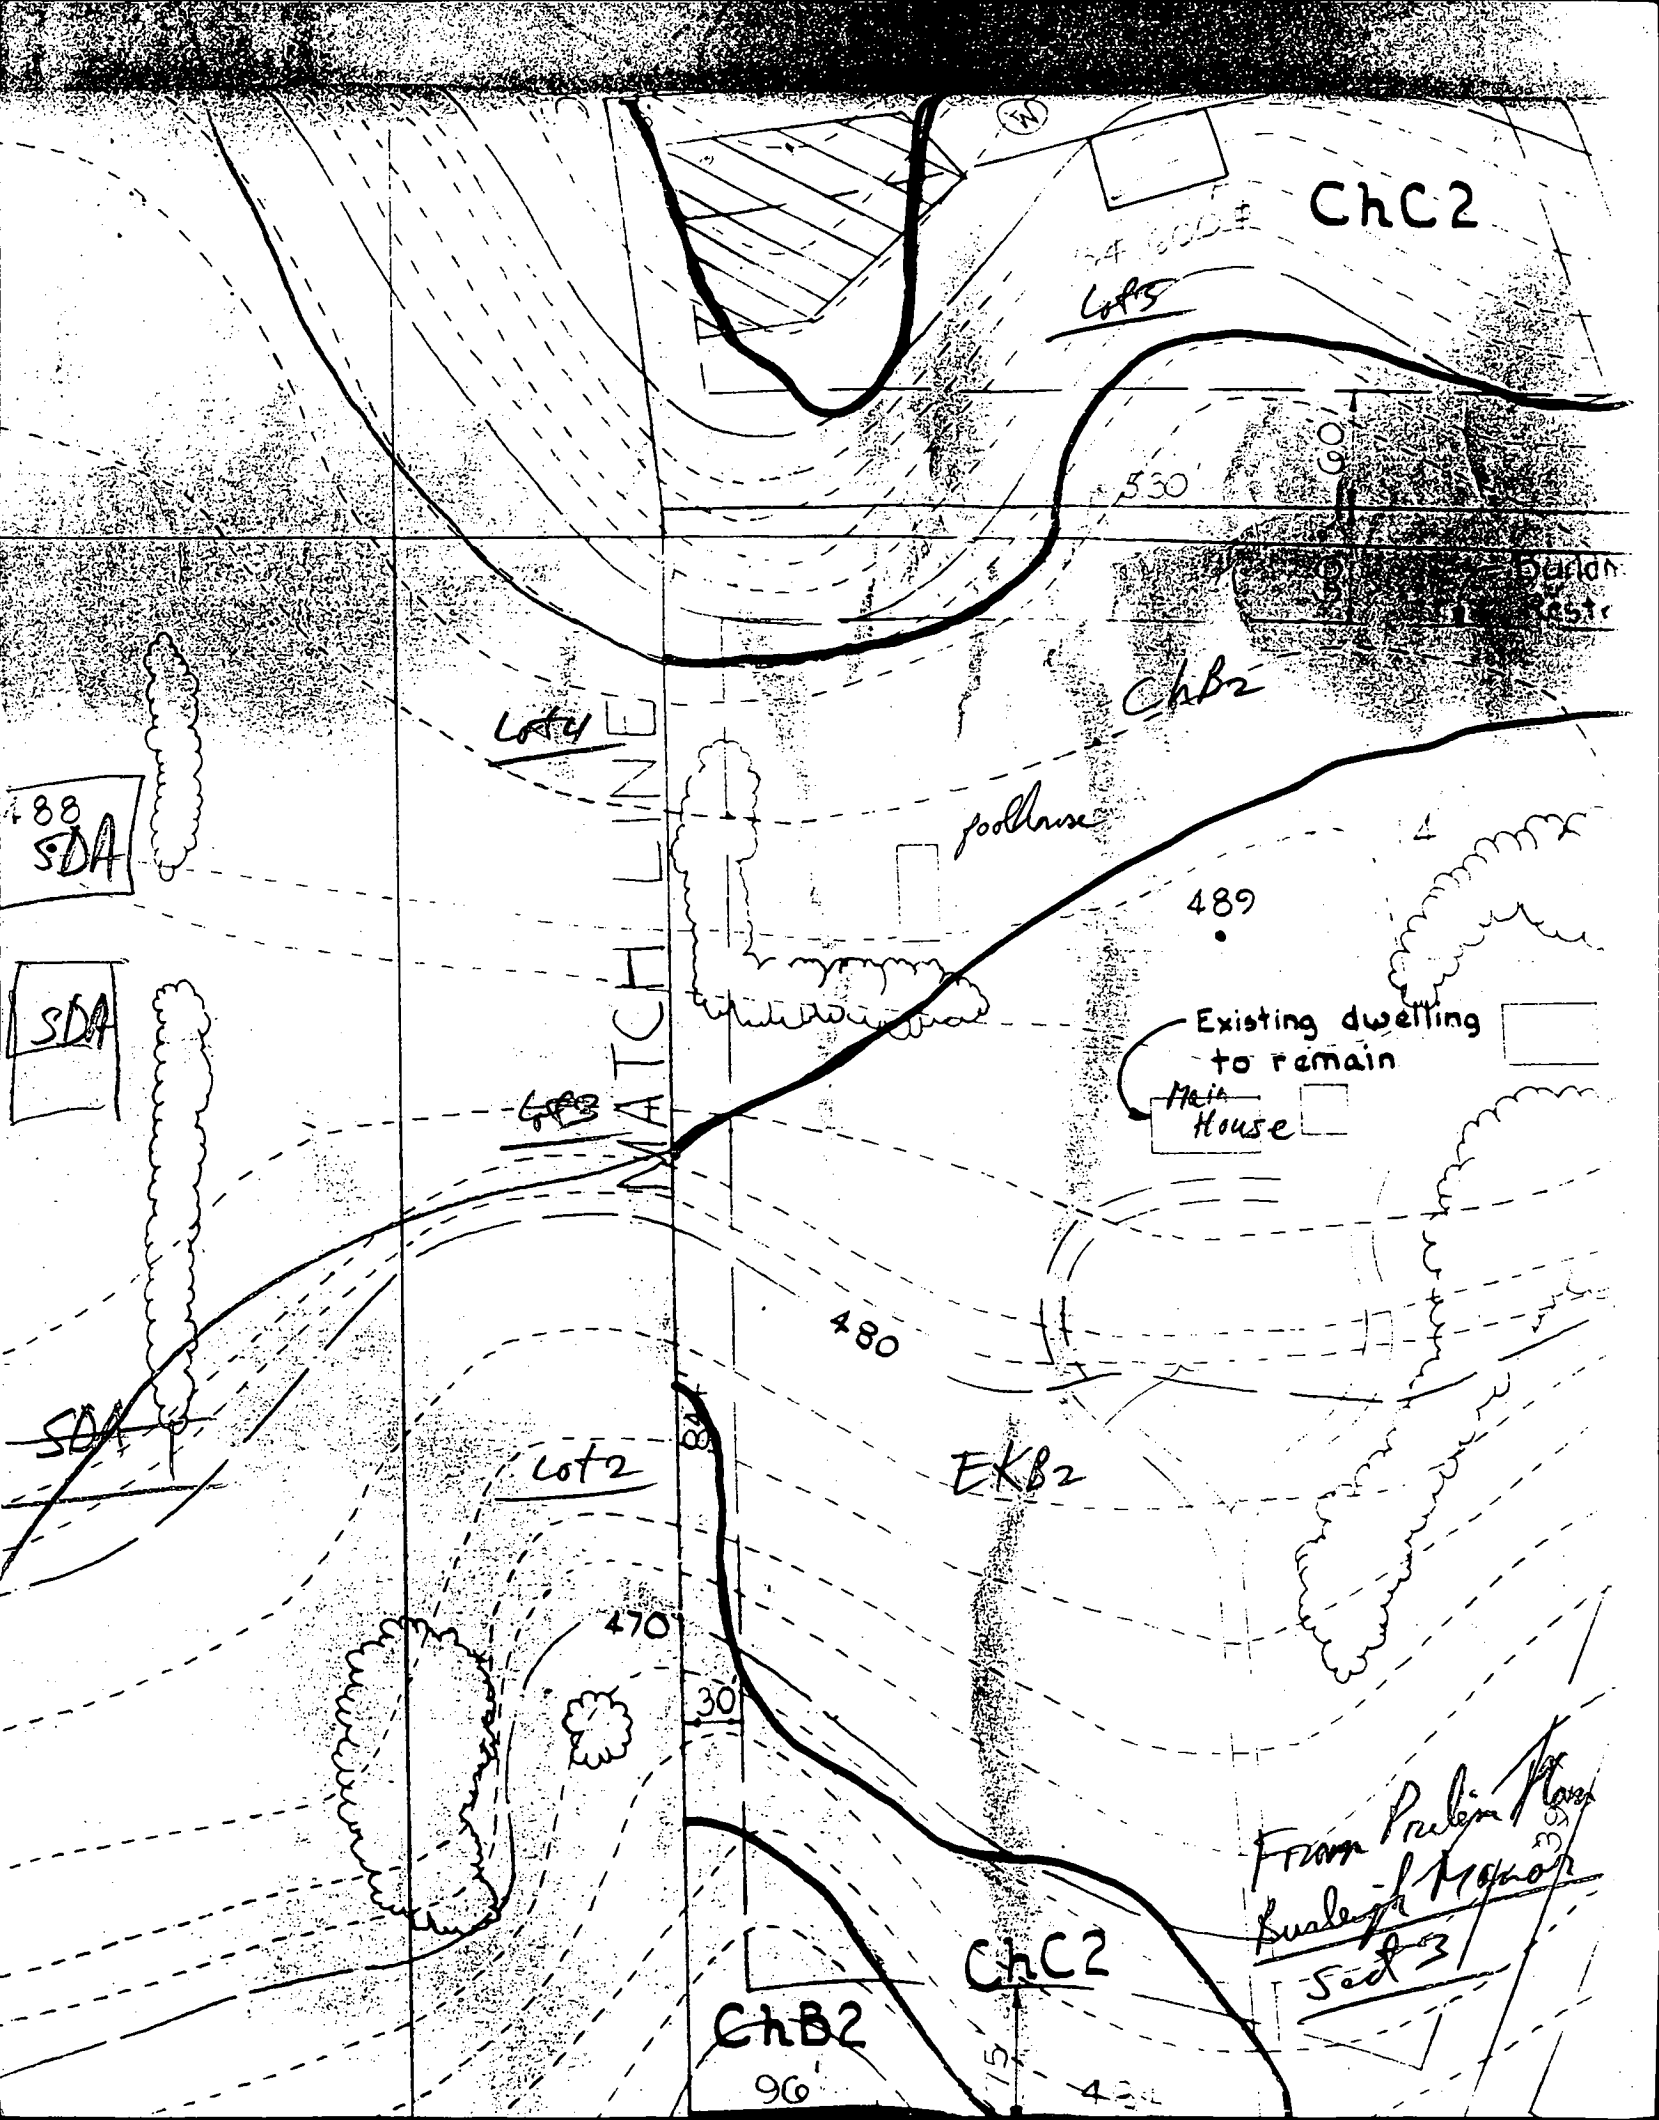

From Prelim Plan
Sueleigh Major
Sect 3

LEFT REAR
CORNER

Prop Line

Prop Line

100'

100'

EXISTING POOL
HOUSE

TANK

STO

NEW LOCATION
OF POOL HOUSE

spec
as installed

POOL

TRENCH 100'

