

# PERMIT

## SEWAGE DISPOSAL SYSTEM

### DEPARTMENT OF HEALTH AND MENTAL HYGIENE

05-353114

P 57538D

A REPAIR

DISTRICT 5th

DATE 11/19/96

DATE SYSTEM APPROVED 11/22/96

INSPECTOR M. Riskin

#### HOWARD COUNTY HEALTH DEPARTMENT

BUREAU OF ENVIRONMENTAL HEALTH

XXXX-XXXX 313-2640

INDEXED

Jack Fyock Septic Service IS PERMITTED TO INSTALL ALTER X

ADDRESS 4105 Ten Oaks Road, Dayton, Maryland 21036 PHONE 988-9270

SUBDIVISION LOT ROAD 12704 Route 216

PROPERTY OWNER Mike Smoot  
12704 Route 216

ADDRESS

SEPTIC TANK CAPACITY 1000 GALLONS

NUMBER OF BEDROOMS 3

SQUARE FEET PER BEDROOM

LINEAR FEET OF TRENCH REQUIRED

REPAIR - PURPOSE - SEPTIC TANK HAS COLLAPSED.

Call for inspection when tank is in place so that a sanitarian can approved size and location. 11/18/96

PLANS APPROVED BY DATE

COVER NO WORK UNTIL INSPECTED AND APPROVED

NEITHER THE HOWARD COUNTY COUNCIL NOR THE HEALTH DEPARTMENT IS RESPONSIBLE FOR THE SUCCESSFUL OPERATION OF ANY SYSTEM

NOTE: CLEANOUT REQUIRED EVERY 70 FEET OF SEWER LINE AND/OR AT 90° SWEEPS IN LINES FROM HOUSE TO DRAIN FIELDS, 90° ELBOWS NOT ACCEPTABLE.

NOTE: ALL PARTS OF SEPTIC SYSTEMS (I.E. TANK, DISTRIBUTION BOX TRENCHES) TO BE 100 FEET FROM WELL (UNLESS OTHERWISE SPECIFICALLY AUTHORIZED)

NOTE: IF DEEP TRENCH(ES) ARE USED CALL FOR INSPECTION BEFORE AND AFTER PLACING GRAVEL IN TRENCH(ES)

NOTE: NO DRY WELL SHALL EXCEED 15 FOOT IN DIAMETER NO ABSORPTION TRENCH TO EXCEED 100 FEET IN LENGTH

NOTE: ALL PIPE FROM HOUSE TO SEPTIC TANK MUST BE CAST IRON OR SCHEDULE 35/40 PVC OR ABS


PERMIT VOID AFTER TWO YEARS

NOTE: INSTALL STAND PIPE ON SEPTIC TANK AND DRY WELL STAND PIPES MUST BE 6 INCHES IN DIAMETER CAST IRON. CONCRETE OR TERRA COTTA OR PVA OR ABS ACCEPTED. IF TOP OF SEPTIC TANK IS DEEPER THAN 3 FEET. MANHOLE TO GRADE REQUIRED.

NOTE: DISTRIBUTION BOXES MUST HAVE BAFFLES

\*INSTALLER IS RESPONSIBLE FOR OBTAINING FINAL APPROVAL ON THIS PERMIT

57538D

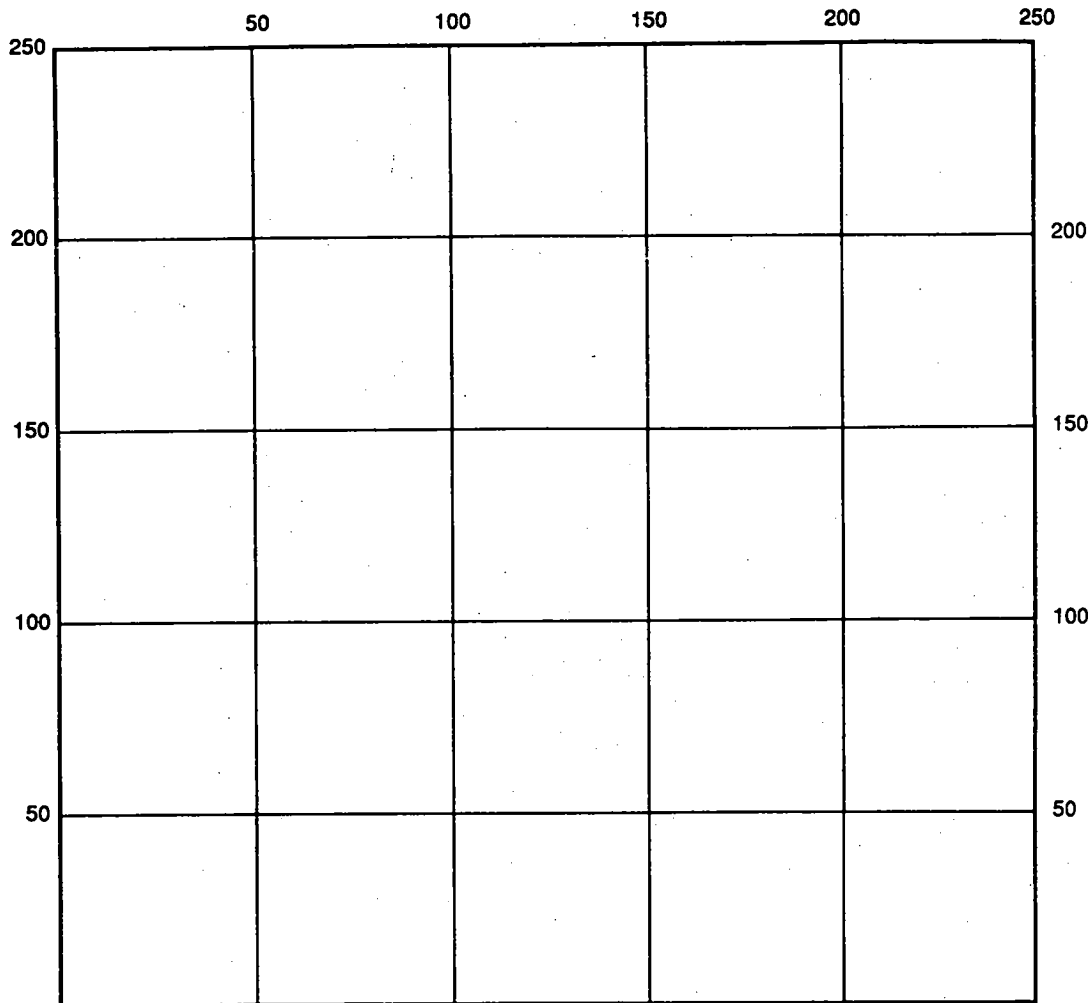

INDICATE NORTH - NAME ADJOINING ROADWAY AS BASE LINE

SEPTIC TANK LEVEL \_\_\_\_\_ CLEANOUTS \_\_\_\_\_

DISTRIBUTION BOX LEVEL \_\_\_\_\_

DRAIN FIELD/TITLE DEPTH \_\_\_\_\_ FT. TRENCH WIDTH \_\_\_\_\_ FT. INLET DEPTH \_\_\_\_\_ FT.

EFFECTIVE GRAVEL DEPTH \_\_\_\_\_ FT. TOTAL LENGTH \_\_\_\_\_ FT.

NUMBER OF TRENCHES \_\_\_\_\_ ONE SIDEWALL/BOTTOM AREA \_\_\_\_\_ SQ. FT.

DRYWALL INSIDE DIAMETER \_\_\_\_\_ FT. EFFECTIVE DEPTH BELOW INLET \_\_\_\_\_ FT.

ABSORBENT AREA \_\_\_\_\_ SQ. FT.

REMARKS: 11/21/96 9:45 T/C FROM K. HATFIELD-S.T. COLLAPSED  
INSP REQUESTED FOR LATE A.M.; ADVISED HIM TO INSTALL  
NEW S.T., COVER AND SUBMIT SKETCH MR

11/22/96 INST. COMPLETE, SKETCH RECEIVED-ALL OK


DATE SYSTEM APPROVED 11/22/96 INSPECTOR M. Ripkin

S 20° 35' E 150.00'

1.595 AC +/-

PAUL MICHAEL SMOOT  
12704 SCAGGSVILLE ROAD  
5TH ELECTION DISTRICT  
HOWARD COUNTY, MD  
676 / 505

SCALE: 1" = 50'

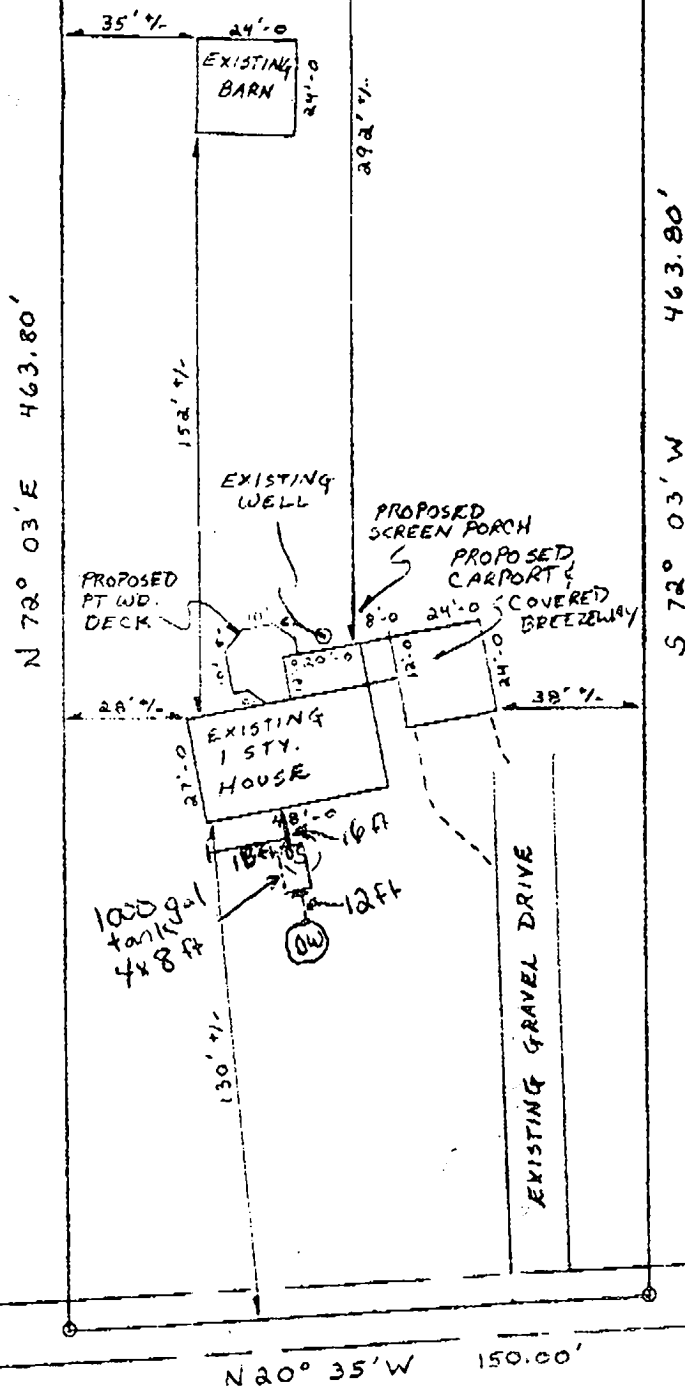

E RT. 216

N 20° 35' W 150.00'

10

12

8/14/86  
AS AP

8-14-86  
Approved  
S. Auhl

# PERMIT

SEWAGE DISPOSAL SYSTEM

MARYLAND STATE DEPARTMENT OF HEALTH\*

P 37599

A REPAIR

HOWARD COUNTY  
BUREAU OF ENVIRONMENTAL HEALTH

X992-2330X  
461-9933

INDEXED

ELLICOTT CITY

DISTRICT 5

DATE 8/2/86

Jack Fyock IS PERMITTED TO INSTALL \_\_\_\_\_ ALTER X

ADDRESS \_\_\_\_\_ PHONE 988-9270

SUBDIVISION \_\_\_\_\_ ROAD 12704 Route 216 LOT \_\_\_\_\_

PROPERTY OWNER Mike Smoot  
12704 Route 216

ADDRESS \_\_\_\_\_

IF GARBAGE GRINDER IS USED INCREASE SEPTIC TANK CAPACITY BY 50% AND ABSORPTION AREA BY 22%.

GARBAGE GRINDER? YES \_\_\_\_\_ NO \_\_\_\_\_

SEPTIC TANK CAPACITY \_\_\_\_\_ GALLONS NUMBER OF BEDROOMS 3

BLDG. PERMIT SIGNED  
AND RETURNED 8/8/86

Serial # 60529  
check, sewer and pond, & caught

REPAIR - CALL FOR INSPECTION WHEN GROUND IS OPENED UP SO SANITARIAN CAN RECOMMEND REPAIR.

PLANS APPROVED BY C. Williams DATE 8/06/86

COVER NO WORK UNTIL INSPECTED AND APPROVED.

NEITHER THE HOWARD COUNTY COUNCIL NOR THE HEALTH DEPARTMENT IS RESPONSIBLE FOR THE SUCCESSFUL OPERATION OF ANY SYSTEM.

NOTE: IF TRENCH IS USED CALL FOR INSPECTION BEFORE AND AFTER PLACING GRAVEL IN TRENCH.

NOTE: NO DRY WELL SHALL EXCEED 15 FOOT IN DIAMETER. NO ABSORPTION TRENCH TO EXCEED 100 FEET IN LENGTH.

NOTE: ALL PIPE FROM HOUSE TO SEPTIC TANK MUST BE CAST IRON OR SCHEDULE 40 PVC OR ABS.

PERMIT VOID AFTER THREE YEARS.


NOTE: INSTALL STAND PIPE ON SEPTIC TANK AND DRY WELL. STAND PIPES MUST BE 6 INCHES IN DIAMETER. CAST IRON, CONCRETE OR TERRA COTTA, OR PVC OR ABS ACCEPTED. IF TOP OF SEPTIC TANK IS DEEPER THAN 3 FEET MANHOLE TO GRADE REQUIRED

\*INSTALLER IS RESPONSIBLE FOR OBTAINING FINAL APROVAL ON THIS PERMIT

\*CALL 992-2330 FOR INSPECTION OF SEPTIC SYSTEMS.

EH - 2-1082

37599  
A  
Repair

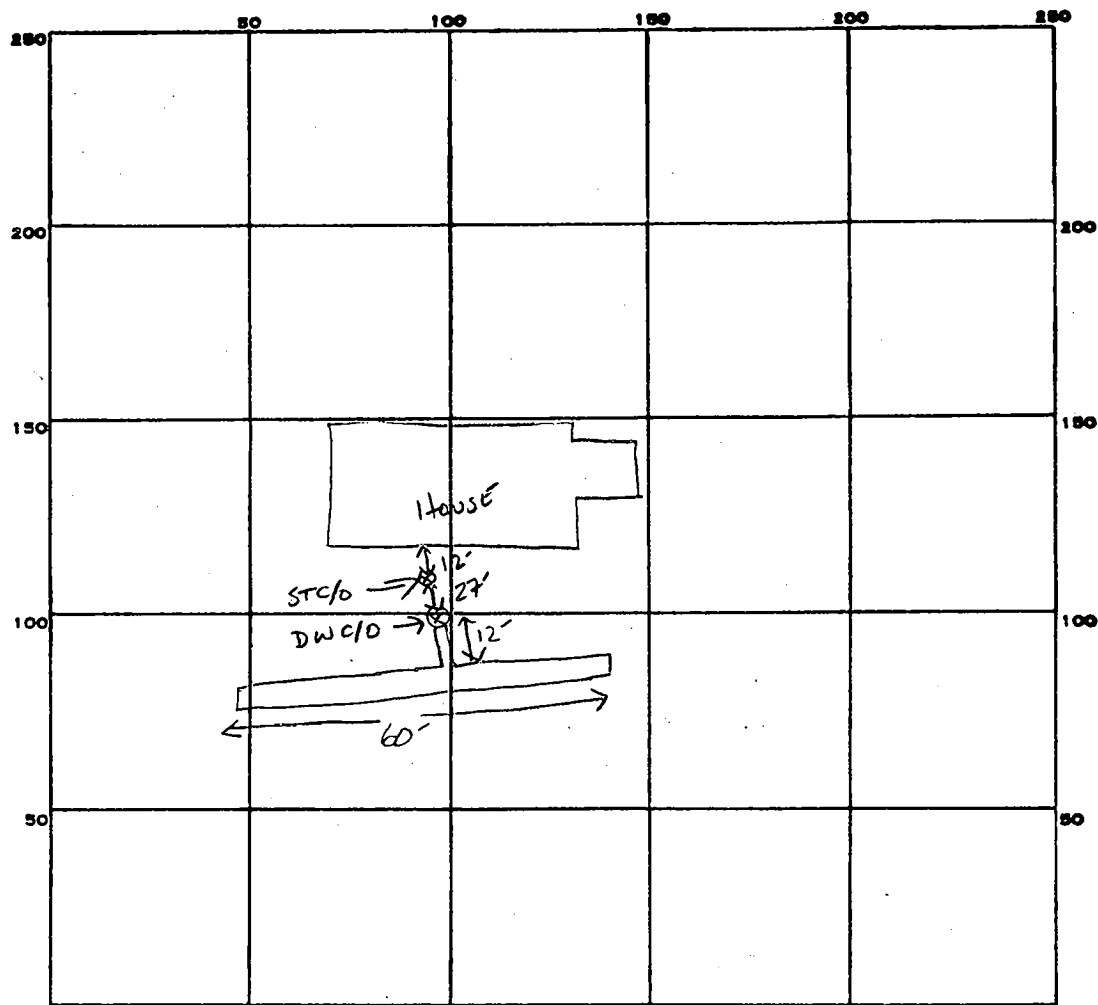

INDICATE NORTH - NAME ADJOINING ROADWAY AS BASE LINE.

Rt 216

PERMIT CARD ✓

SEPTIC TANK, LEVEL EXISTING

CLEANOUTS EXISTING

DISTRIBUTION BOX, LEVEL N/A

TILE FIELD, DEPTH 12 FT. TRENCH WIDTH 2 FT.

INLET 4

GRAVEL DEPTH 8 FT IN. TOTAL LENGTH 60 FT.

NUMBER OF TRENCHES 1

ONE SIDE WALL

TOTAL BOTTOM AREA 480  $\phi$

SEEPAGE PITS, INSIDE DIAMETER        FT. DEPTH BELOW INLET        FT.

ABSORBENT AREA 480 SQ. FT.


REMARKS

DATE SYSTEM APPROVED

8-14-86

INSPECTOR

S. Abel

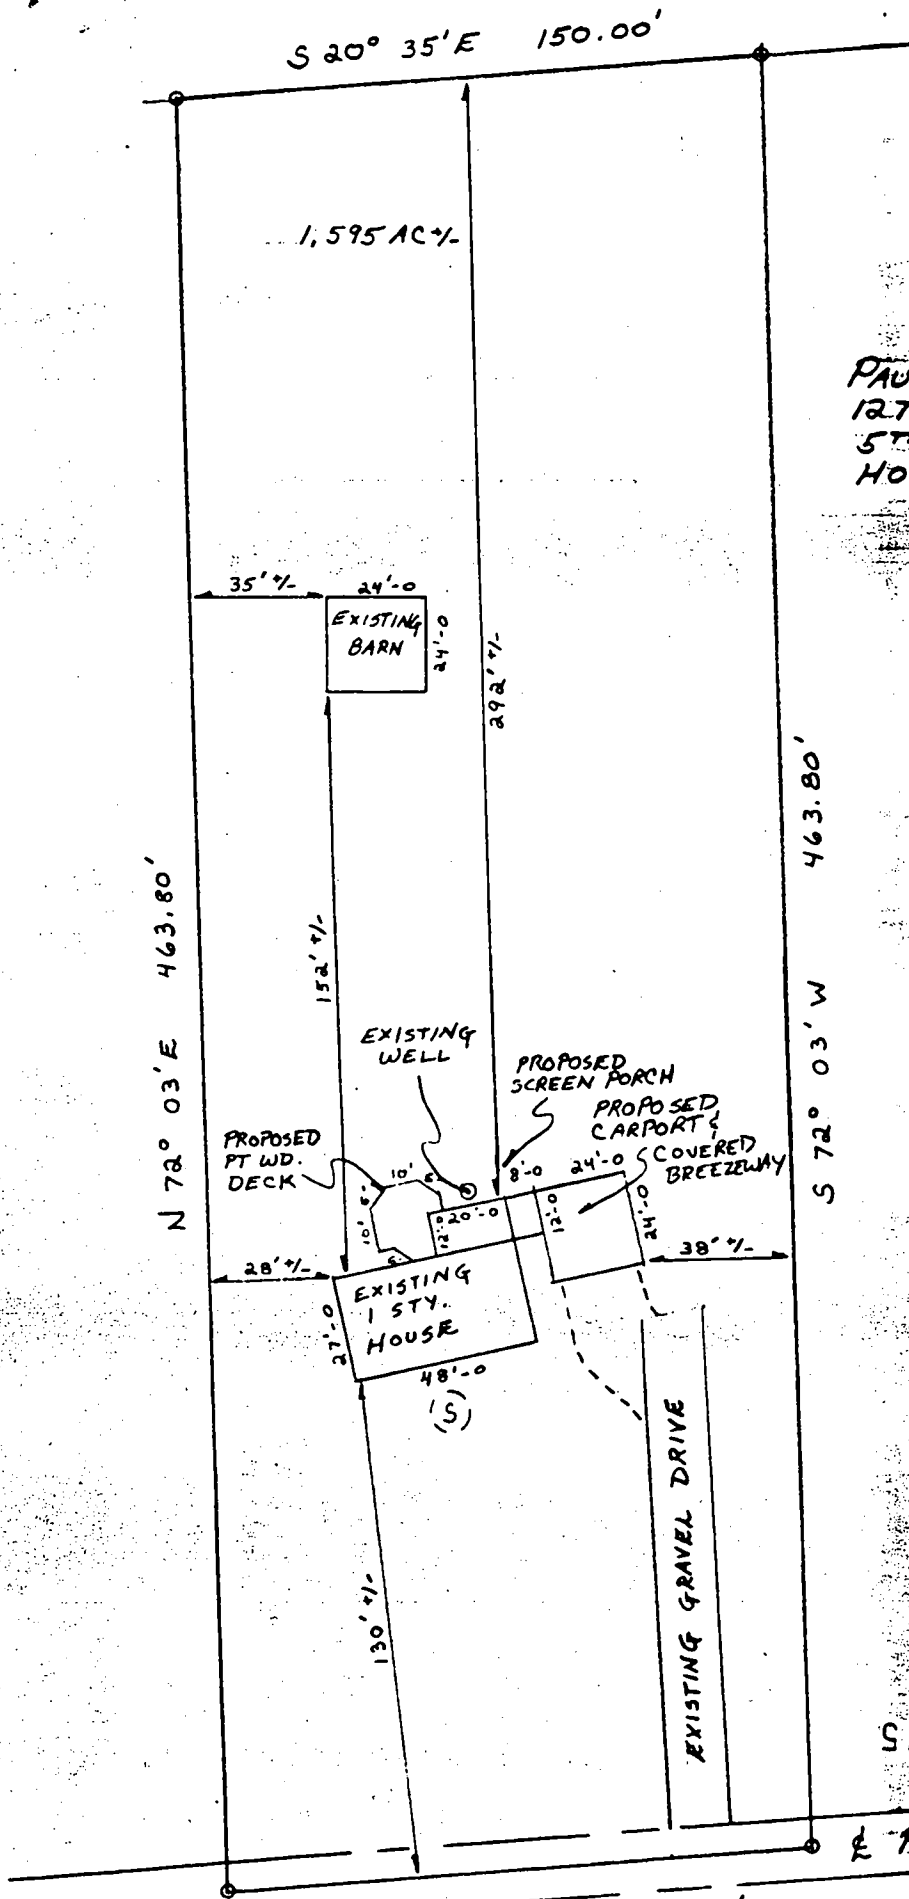

PAUL MICHAEL SMOOT  
12704 SCAGGSVILLE ROAD  
5TH ELECTION DISTRICT  
HOWARD COUNTY, MD  
676 / 505

SCALE: 1" = 50'

8/1/95

OK AS PER THIS  
REVISION  
8/7/95  
C. Williams

95 AUG - 7 PM 3:15

12704 Route 216  
Highland, Maryland 20777  
August 1, 1995

Mr. Craig Williams, Program Director  
Water and Sewerage Program  
Bureau of Environmental Health  
**Howard County Health Department**  
3525-H Ellicott Mills Drive  
Ellicott City, Maryland 21043-4544

RE: Building Permit Application Serial Number: 60829  
Proposed Deck, Porch and Breezeway  
12704 Route 216

Dear Mr. Williams:

Thank you very much for meeting with us this morning.


Attached is our modified building plan which incorporates the discussion and agreements reached at that meeting.

The new porch/deck structure...

- will not be built over the well
- will extend 12' from the existing, original house structure

Again, thank you for taking the time to meet with us to find a mutually acceptable solution.

Sincerely,

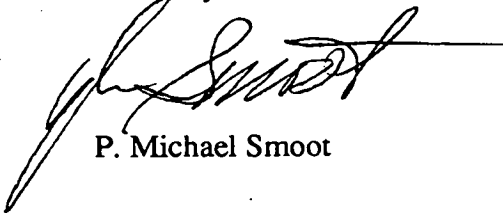

P. Michael Smoot

OK AS per T+L  
REVISION  
8/7/95 CW

Attachment

cc: Smoot Construction

95 AUG - 7 PM 3:15



Howard County  
Health Department

3525 H Ellicott Mills Drive, Ellicott City, MD 21043


(410) 313-2640 Fax (410) 313-2648

TDD (410) 313-2323 Toll Free 1-866-313-6300

website: www.hchealth.org

*Penny E. Borenstein, M.D., M.P.H., Health Officer*

**F A X**

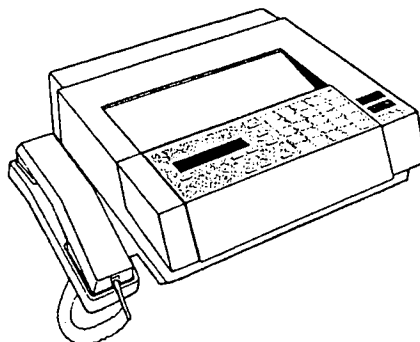

Date

7/21/04

To

RAY

Department

FAX #

301-820-6442

From

Kacie Noonan

Telephone

410-313-1775

FAX (410) 313-2648

# Of Pages

9

(including cover page)

Comments



More Contractors' list avail. if needed  
Will look for well report  
in "old wells" box - ADDRESSES NOT WRITTEN  
UNDER PROP. but owner's name back then

**CONFIDENTIALITY NOTICE**

**"WARNING: UNAUTHORIZED INTERCEPTION OF THIS TELEPHONIC  
COMMUNICATION COULD BE A VIOLATION OF FEDERAL AND MARYLAND LAW"**

The documents accompanying this telecopy transmission contain confidential information belonging to the sender which is legally privileged. The information is intended only for the use of the individual or entity named above. If you are not the intended recipient, you are hereby notified that any discourse, copying, distribution or the taking of any action in reliance on the contents of this telephonic information is strictly prohibited. If you have received this telecopy in error, please immediately notify sender by telephone to arrange for return of the original documents to us.




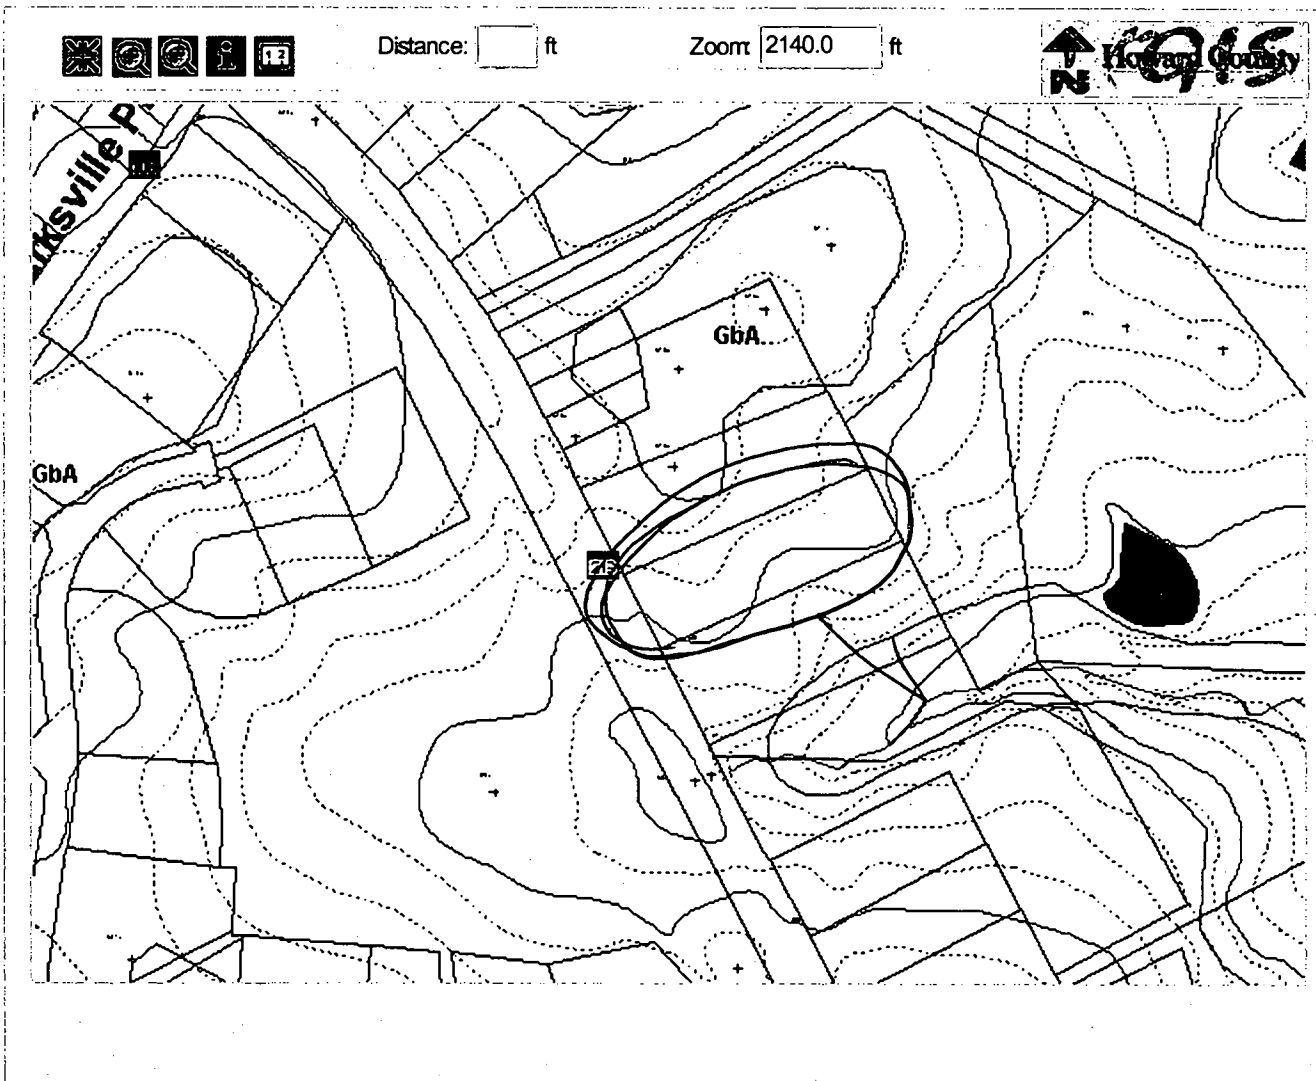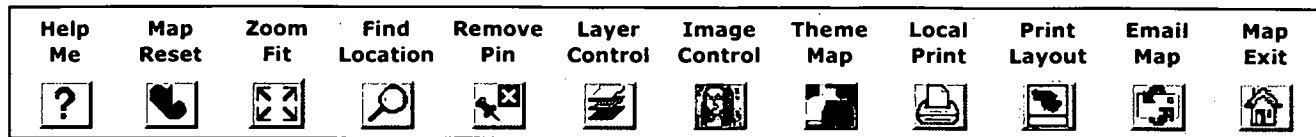


Disclaimer: Howard County, Maryland assumes no responsibility for the accuracy of this map or the information contained herein or derived therefrom. The buyer and/or user assumes all risks and liabilities whatsoever resulting from or arising out of the use of this map. There are no oral agreements or warranties relating to this sale and/or use of this map.


Wednesday, July 21 2004 | 9:56:57 AM | @622

#### Map Legends

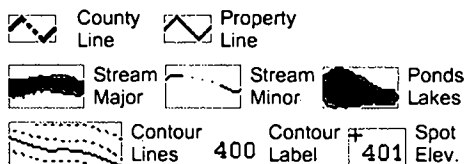

#### Soils Map

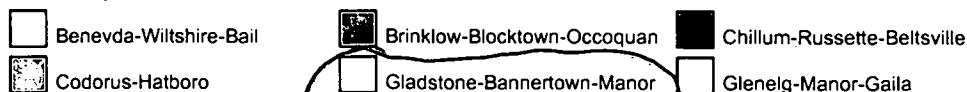

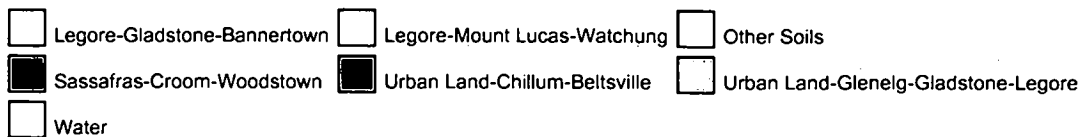**Sanitary Sewer****Water Lines**

**Contacts:** John Bussiere (x3044) Virginia Peterman (x3659) Yut Phasukyued (x3093) Robert Slivinsky (x3094)

*None*

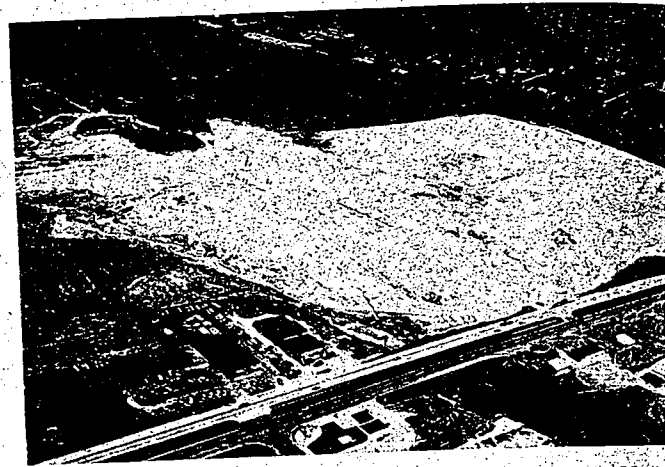


Figure 5.—Aerial view of Made land on U.S. Highway No. 29, St. Johns Lane.

Airy soils. Linganore soils have a Bt horizon of clay accumulation, which Brandywine and Mt. Airy soils lack.

**Linganore channery loam, 3 to 8 percent slopes, moderately eroded (LnB2).**—The profile of this soil is the one described for the series. This soil has a thin solum and is moderately deep to bedrock. It is suited to cultivated crops, pasture, and trees. The hazard of erosion and the moderate depth severely limit the use of this soil. (Capability unit IIIe-10; woodland suitability group 51)

**Linganore channery loam, 8 to 15 percent slopes, moderately eroded (LnC2).**—Included in the areas mapped as this soil are some small spots that have impeded subsoil drainage. This soil is suited to pasture, trees, and an occasional cultivated crop. Droughtiness and the hazard of erosion are the main limitations. (Capability unit IVe-10; woodland suitability group 51)

**Linganore channery loam, 15 to 25 percent slopes, moderately eroded (LnD2).**—Included in the areas mapped as this soil are some spots that have impeded subsoil drainage.

This soil is not suited to cultivated crops but is suited to pasture, trees, and sodded orchards. The hazard of erosion is the main limitation. (Capability unit VIe-3; woodland suitability group 52)

**Linganore channery silt loam, 25 to 45 percent slopes (LoE).**—This soil has a thin solum. It is more easily eroded than the other Linganore soils. Many areas are already severely eroded, and the hazard of further erosion is severe.

This soil is suited to limited grazing and to woodland. It should have a permanent cover of vegetation, to keep runoff from damaging areas downslope. (Capability unit VIIe-3; slopes that are exposed to the sun are in woodland suitability group 58, north slopes that are ordinarily shaded are in group 52)

## Made Land

Made land (Md) consists of areas that have been so disturbed or modified by grading or filling that the soils cannot be classified (fig. 5).

Most of the acreage originally consisted of Brandywine soils, but no characteristic soil profile can now be recognized. This land type is used for residential or commercial developments or other nonfarm purposes. (Not in a capability unit; woodland suitability group 21)

## Manor Series

The Manor series consists of very deep, well-drained to somewhat excessively drained soils that are located on the nearly level to steep uplands of the Piedmont Plateau. Most of these soils are in the east-central part of the county, and some are on the uplands above the Patuxent River. These soils formed in deep materials that weathered in place from soft, micaceous rocks and consequently contain large amounts of mica. The native vegetation is mixed upland hardwoods, mainly oaks; Virginia pine has invaded some areas.

These soils have a thin surface layer of dark-brown, crumbly loam. In cultivated areas, the plow layer is brown or reddish brown in color. The subsoil is yellowish-red to light-red, crumbly but slightly sticky loam that

contains much fine mica and some small, soft rock fragments. Below the subsoil is highly micaceous crumbly to loose, decomposed rock material that is in places is variegated with colors. The depth to bedrock is 6 to more than 10 feet. The bedrock is rather soft and is not clearly differentiated from the decomposed rock material just above it. Some areas contain much gravel of hard, white quartz. The gravel is mostly on or near the surface of the soil.

Manor soils have a high available moisture capacity. They are strongly acid to very strongly acid. Although highly susceptible to erosion, they are suitable for a variety of uses. Some farms consist almost entirely of Manor soils. Some areas, particularly some near U.S. Highway No. 29, have been used as building sites.

Profile of Manor loam, 0 to 3 percent slopes, wooded area on Folly Quarter Road.

- O1—2 inches to 0, litter of hardwood leaves.
- A1—0 to 6 inches, dark-brown (7.5YR 4/4) loam; very friable when moist; granular structure; very friable when moist; sticky and slightly plastic when wet; roots abundant; some tendency toward fine platiness; strong to very strongly acid; gradual, smooth boundary. 4 to 6 inches thick.
- B2—6 to 30 inches, yellowish-red (5YR 4/8) loam; fine, granular structure; friable when moist; sticky and slightly plastic when wet; plentiful roots in upper portion; few, fine mica fragments that decrease in number with increasing depth; moderately micaceous; acid to very strongly acid; clear, smooth boundary. 15 to 24 inches thick.
- C1—30 to 40 inches, yellowish-red (5YR 4/6), light brown, very friable saprolite of loam texture; very thin bands of white, olive green, red, and slightly sticky; very few roots; very strong diffuse boundary. 8 to 20 inches thick.
- C2—40 to 60 inches +, weak-red (10YR 4/3), friable loam that consists almost entirely of mica; no roots; very strongly acid.

The thickness of the solum ranges from about 30 inches but is ordinarily no more than 2 feet. The depth to bedrock ranges from about 6 to 10 feet. In places the profile contains some mica. Angular fragments of hard, white quartz which are remnants of quartzite intrusions, are

dry soils. Linganore soils have a Bt horizon of clay accumulation, which Brandywine and Mt. Airy soils lack.

**Linganore channery loam, 3 to 8 percent slopes, moderately eroded (LnB2).**—The profile of this soil is the one described for the series. This soil has a thin solum and is moderately deep to bedrock. It is suited to cultivated crops, pasture, and trees. The hazard of erosion and the moderate depth severely limit the use of this soil. (Capability unit IIIe-10; woodland suitability group 51)

**Linganore channery loam, 8 to 15 percent slopes, moderately eroded (LnC2).**—Included in the areas mapped as this soil are some small spots that have impeded subsoil drainage. This soil is suited to pasture, trees, and an occasional cultivated crop. Droughtiness and the hazard of erosion are the main limitations. (Capability unit IVE-10; woodland suitability group 51)

**Linganore channery loam, 15 to 25 percent slopes, moderately eroded (LnD2).**—Included in the areas mapped as this soil are some spots that have impeded subsoil drainage.

This soil is not suited to cultivated crops but is suited to pasture, trees, and sodded orchards. The hazard of erosion is the main limitation. (Capability unit VIe-3; woodland suitability group 52)

**Linganore channery silt loam, 25 to 45 percent slopes (LnE).**—This soil has a thin solum. It is more easily eroded than the other Linganore soils. Many areas are already severely eroded, and the hazard of further erosion is severe.

This soil is suited to limited grazing and to woodland. It should have a permanent cover of vegetation, to keep it off from damaging areas downslope. (Capability unit VIIe-3; slopes that are exposed to the sun are in woodland suitability group 58, north slopes that are ordinarily shaded are in group 52)

## Made Land

Made land (Md) consists of areas that have been so disturbed or modified by grading or filling that the soils cannot be classified (fig. 5).

Most of the acreage originally consisted of Brandywine soils, but no characteristic soil profile can now be recognized. This land type is used for residential or commercial developments or other nonfarm purposes. Not in a capability unit; woodland suitability group 1)

## Manor Series

The Manor series consists of very deep, well-drained, somewhat excessively drained soils that are located on the nearly level to steep uplands of the Piedmont plateau. Most of these soils are in the east-central part of the county, and some are on the uplands above the Patuxent River. These soils formed in deep materials that weathered in place from soft, micaceous rocks and consequently contain large amounts of mica. The native vegetation is mixed upland hardwoods, mainly oaks; Virginia pine has invaded some areas.

These soils have a thin surface layer of dark-brown, crumbly loam. In cultivated areas, the plow layer is brown or reddish brown in color. The subsoil is yellowish-red to light-red, crumbly but slightly sticky loam that



Figure 5.—Aerial view of Made land on U.S. Highway No. 40 near St. Johns Lane.

contains much fine mica and some small, soft rock fragments. Below the subsoil is highly micaceous, very crumbly to loose, decomposed rock material that is dominantly red in color but in places is variegated with many colors. The depth to bedrock is 6 to more than 10 feet. The bedrock is rather soft and is not clearly differentiated from the decomposed rock material just above it. Some areas contain much gravel of hard, white quartzite. The gravel is mostly on or near the surface of the soil.

Manor soils have a high available moisture capacity. They are strongly acid to very strongly acid. Although highly susceptible to erosion, they are suitable for a variety of uses. Some farms consist almost entirely of Manor soils. Some areas, particularly some along or near U.S. Highway No. 29, have been used as building sites.

Profile of Manor loam, 0 to 3 percent slopes, in a wooded area on Folly Quarter Road.

O1—2 inches to 0, litter of hardwood leaves.

A1—0 to 6 inches, dark-brown (7.5YR 4/4) loam; weak, fine, granular structure; very friable when moist, slightly sticky and slightly plastic when wet; roots abundant; some tendency toward fine platiness; strongly acid to very strongly acid; gradual, smooth boundary. 4 to 6 inches thick.

B2—6 to 30 inches, yellowish-red (5YR 4/8) loam; weak, fine, granular structure; friable when moist, slightly sticky and slightly plastic when wet; common to plentiful roots in upper portion; few, fine, very friable schist fragments that decrease in number with increasing depth; moderately micaceous; strongly acid to very strongly acid; clear, smooth boundary. 15 to 24 inches thick.

C1—30 to 40 inches, yellowish-red (5YR 4/6), highly micaceous, very friable saprolite of loam texture; some very thin bands of white, olive green, red, and brown; slightly sticky; very few roots; very strongly acid; diffuse boundary. 8 to 20 inches thick.

C2—40 to 60 inches +, weak-red (10YR 4/3), slightly coherent loam that consists almost entirely of fine mica; no roots; very strongly acid.

The thickness of the solum ranges from about 15 to 30 inches but is ordinarily no more than 2 feet thick. The depth to bedrock ranges from about 6 to more than 10 feet. In places the profile contains some schist fragments. Angular fragments of hard, white quartzite, which are remnants of quartzite intrusions, are few to