



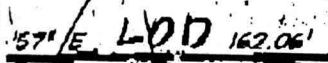

~~4/18/01~~
~~Date~~

Total linear feet of trench required 340

Width of trench(es)

Depth of trench(es)

Depth of stone, requi

dictated

Mar 15 01 04:20p VALUED CUSTOMER