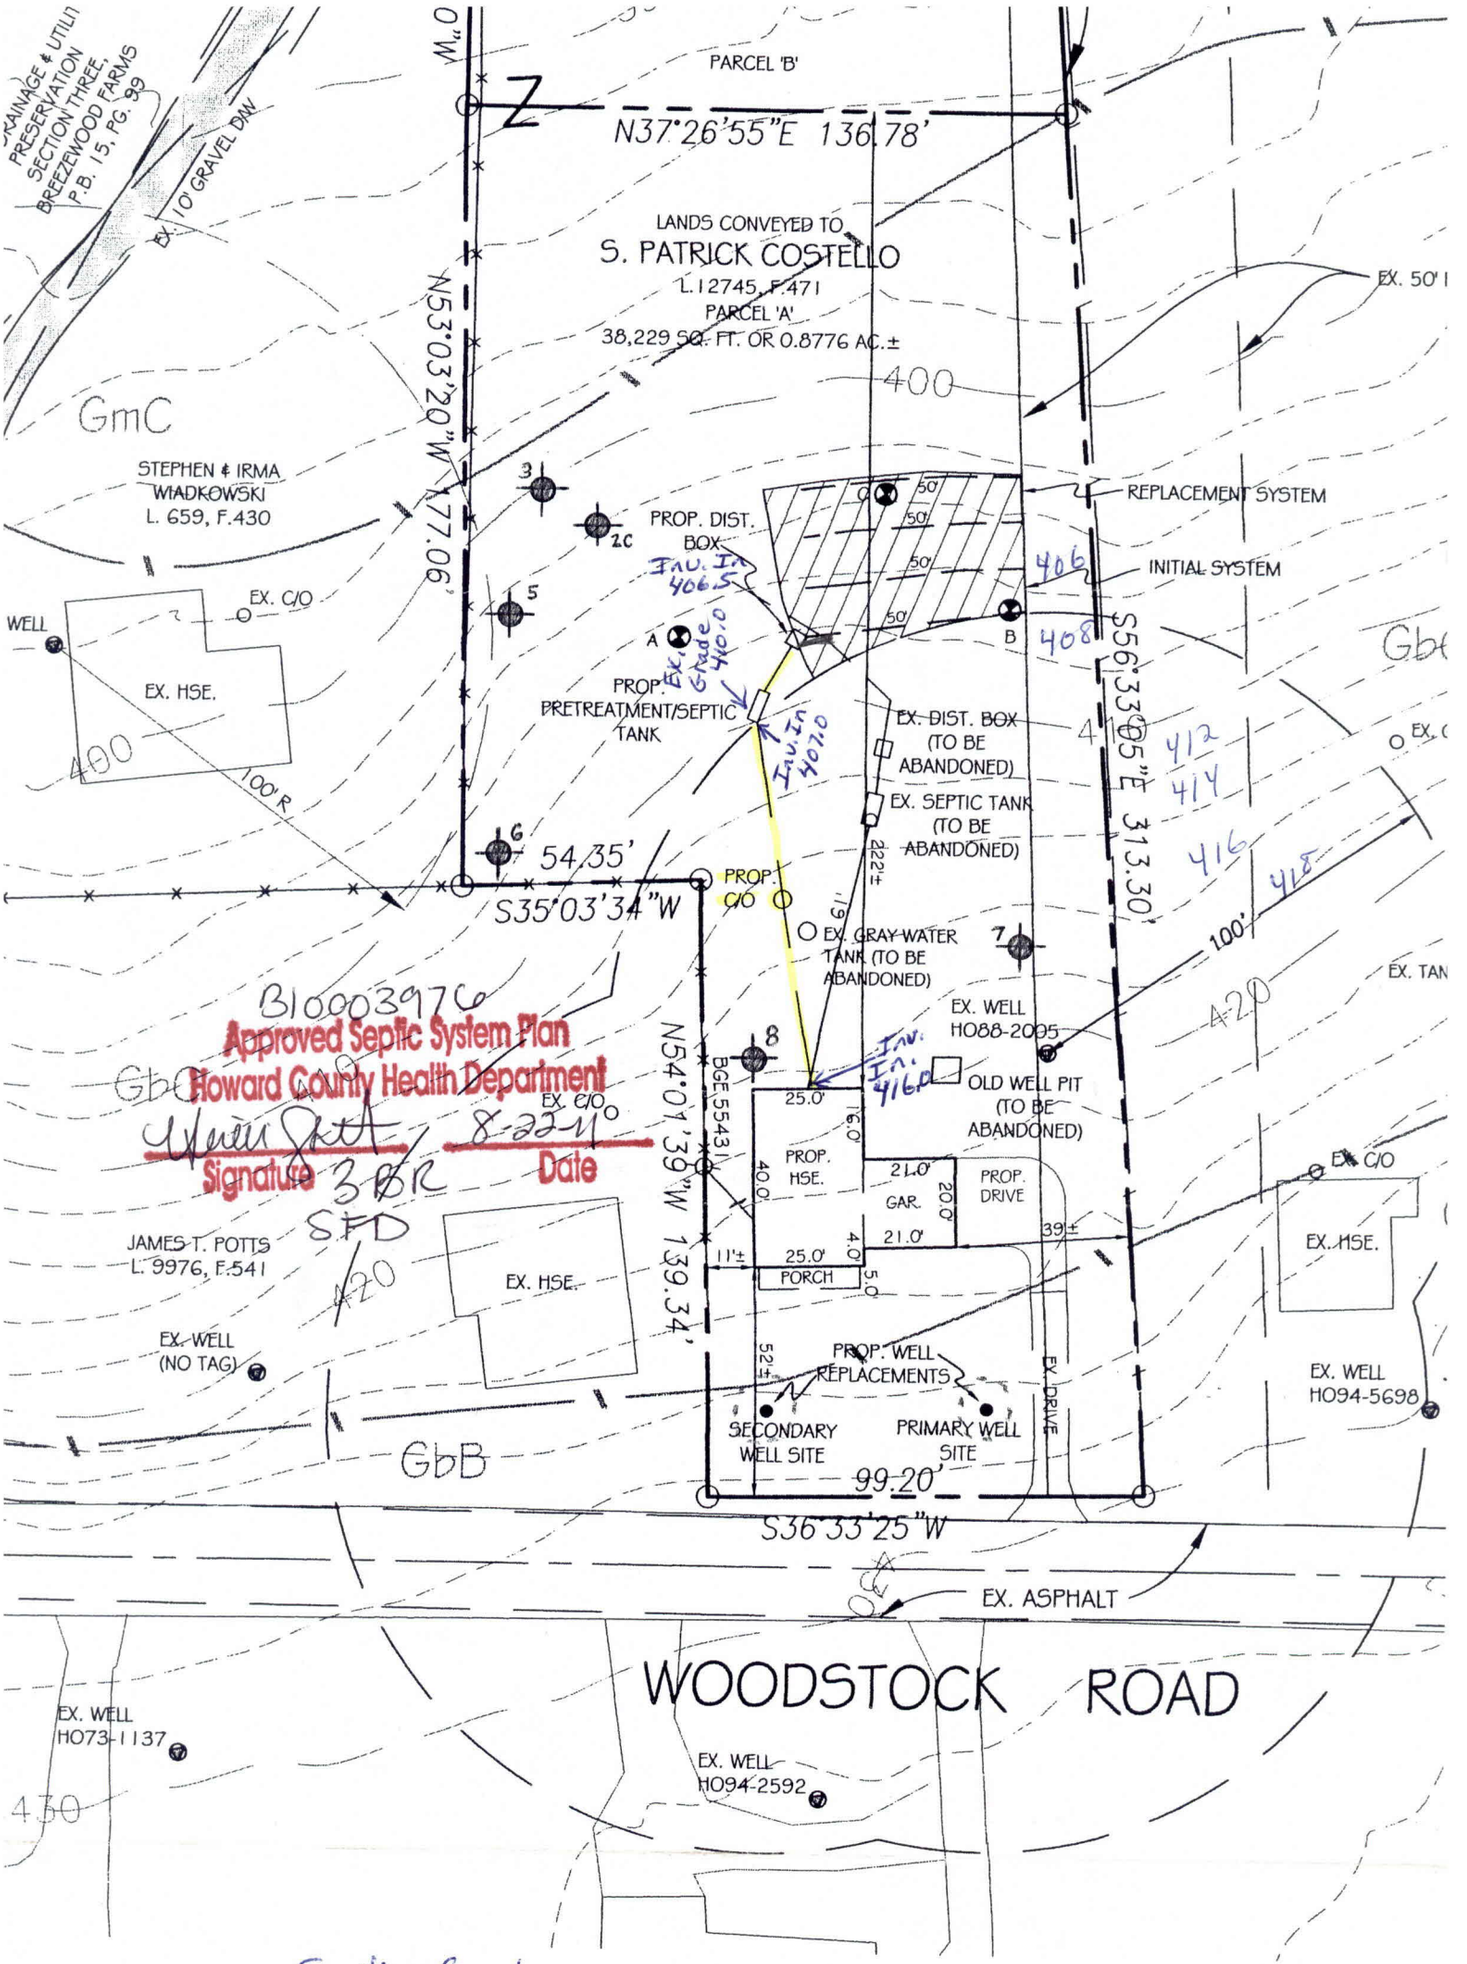

Septic Grades

Inv. at House 416.0

Inlet tank 407.0

Exist. grade tank 410.0

Inlet at D. Box 406.5

Exist. grade D. Box 408.0

Inlet at trench 406.0

1" = 40'

F.F. - 426.1

BSMT - 415.9

SEWERAGE SYSTEMS.
IENT

SURVEY(

I HEREBY CERTIFY THAT THESE DOC
RESPONSIBLE CHARGE, AND THAT I
SURVEYOR UNDER THE LAWS OF TH
EXPIRATION DATE SEPTEMBER 9, 2