

| <b>C1</b><br>3477   | SEQUENCE NO.<br>(DENY USE ONLY)        | <b>STATE OF MARYLAND</b><br><b>WELL COMPLETION REPORT</b><br>FILL IN THIS FORM COMPLETELY<br>PLEASE PRINT OR TYPE   | THIS REPORT MUST BE SUBMITTED WITHIN<br>45 DAYS AFTER WELL IS COMPLETED.<br>COUNTY NUMBER <u>1/2691</u> | |
|---|
| (THIS NUMBER IS TO BE PUNCHED<br>IN COLS. 3-8 ON ALL CARDS)   |                                        | PERMIT NO.<br><u>12-18-17947</u>   | |
| ST/CO USE ONLY<br>DATE RECEIVED   | DATE WELL COMPLETED<br><u>08-17-71</u> | Depth of Well<br><u>400</u> (NEAREST FOOT)   | |
| OWNER <u>SHINEMAN, A. L.</u>   | |
| STREET OR RFD <u>1765</u>   |                                        | TOWN <u>WELL 3/2</u>   | |
| SUBDIVISION   |                                        | SECTION   | |
| <b>WELL LOG</b><br>Not required for driven wells<br>STATE THE KIND OF FORMATIONS<br>PENETRATED, THEIR COLOR, DEPTH,<br>THICKNESS AND IF WATER BEARING   |                                        | <b>GRouting RECORD</b><br>WELL HAS BEEN GROUTED<br>(Circle Appropriate Box)<br>TYPE OF GROUTING MATERIAL<br>CEMENT <input checked="" type="checkbox"/> BENTONITE CLAY <input checked="" type="checkbox"/><br>NO. OF BAGS NO. OF POUNDS<br>GALLONS OF WATER<br>DEPTH OF GROUT SEAL (to nearest foot)<br>from <u>0</u> ft. to <u>400</u> ft.   | |
| <table border="1" style="width:100%; border-collapse: collapse;"> <thead> <tr> <th>DESCRIPTION (Use additional sheets if needed)</th> <th>FEET FROM</th> <th>TO</th> <th>Check water bearing</th> </tr> </thead> <tbody> <tr> <td>1. p.s.c.</td> <td>0</td> <td>3</td> <td></td> </tr> <tr> <td>Shale</td> <td>3</td> <td>8</td> <td></td> </tr> <tr> <td>Subs. rock</td> <td>8</td> <td>60</td> <td></td> </tr> <tr> <td>Hard rock</td> <td>60</td> <td>100</td> <td></td> </tr> </tbody> </table> |                                        | DESCRIPTION (Use additional sheets if needed)   | FEET FROM                                                                                               | TO  | Check water bearing | 1. p.s.c. | 0   | 3 |  | Shale | 3 | 8 |  | Subs. rock | 8 | 60 |  | Hard rock | 60 | 100 |  | <b>SCREEN RECORD</b><br>casing types insert appropriate code below<br><table border="1" style="width:100%; border-collapse: collapse;"> <tr> <td>STEEL</td> <td>CONCRETE</td> </tr> <tr> <td>PL</td> <td>OT</td> </tr> <tr> <td>PL</td> <td>OT</td> </tr> </table> MAIN CASING TYPE<br><table border="1" style="width:100%; border-collapse: collapse;"> <tr> <td>+</td> <td>+</td> <td>+</td> </tr> </table> Normal diameter top (main) casing (nearest inch)<br>Total depth of main casing (nearest foot)<br>OTHER CASING (if used)<br>diameter inch depth (feet) from to<br>screen type or open hole insert appropriate code below<br><table border="1" style="width:100%; border-collapse: collapse;"> <tr> <td>ST</td> <td>BR</td> <td>HO</td> </tr> <tr> <td>STEEL</td> <td>BRASS</td> <td>OPEN</td> </tr> <tr> <td>PL</td> <td>PL</td> <td>OT</td> </tr> <tr> <td>PL</td> <td>PL</td> <td>OT</td> </tr>
| NOTE:<br>3/4" PPM   |                                        | <b>C2</b><br>DEPTH (nearest ft.)<br><table border="1" style="width:100%; border-collapse: collapse;"> <tr> <td>400</td> <td>400</td> <td>400</td> <td>400</td> </tr> </table> SLOT SIZE 1 2 3<br>DIAMETER OF SCREEN (NEAREST INCH)<br>from to   |   | 400 | 400                 | 400       | 400 |   |  
| 400   | 400                                    | 400   | 400   | |
| CIRCLE APPROPRIATE LETTER<br><b>A</b> A WELL WAS ABANDONED AND SEALED WHEN THIS WELL WAS COMPLETED<br><b>E</b> ELECTRIC LOG OBTAINED<br><b>P</b> TEST WELL CONVERTED TO PRODUCTION WELL<br>I HEREBY CERTIFY THAT THIS WELL HAS BEEN CONSTRUCTED IN ACCORDANCE WITH COMAR 26.04.04 "WELL CONSTRUCTION" AND IN CONFORMANCE WITH ALL CONDITIONS STATED IN THE ABOVE CAPTIONED PERMIT, AND THAT THE INFORMATION PRESENTED HEREIN IS ACCURATE AND COMPLETE TO THE BEST OF MY KNOWLEDGE.                  |                                        | <b>C3</b><br><b>PUMPING TEST</b><br>HOURS PUMPED (nearest hour) <u>3</u><br>PUMPING RATE (gal. per min. to nearest gal.) <u>1</u><br>METHOD USED TO MEASURE PUMPING RATE <u>1</u><br>WATER LEVEL (distance from land surface) BEFORE PUMPING <u>4</u><br>WHEN PUMPING <u>4</u><br>TYPE OF PUMP USED (by test)<br><b>A</b> <b>P</b> <b>T</b><br><b>C</b> <b>R</b> <b>Q</b><br><b>J</b> <b>S</b><br><b>PUMP INSTALLER</b><br>DRILLER WILL INSTALL PUMP (CIRCLE) YES <input checked="" type="checkbox"/> NO <input type="checkbox"/><br>IF DRILLER INSTALLS PUMP, THIS SECTION MUST BE COMPLETED FOR ALL WELLS EXCEPT HOME USE TYPE OF PUMP INSTALLED PLACE (A-CAPITAL) IN BOX - SEE ABOVE.<br>CAPACITY: GALLONS PER MINUTE (to nearest gallon) <u>1</u><br>PUMP HORSE POWER <u>1</u><br>PUMP COLUMN LENGTH (nearest ft.) <u>1</u><br>CASING HEIGHT (circle appropriate box and enter casing height)<br><input checked="" type="checkbox"/> above LAND SURFACE <input type="checkbox"/> below (nearest foot)<br>LOCATION OF WELL ON LOT<br>SHOW PERMANENT STRUCTURE SUCH AS BUILDING, SEPTIC TANK, AND/OR LANDMARKS AND INDICATE NOT LESS THAN TWO DISTANCES (MEASUREMENTS TO WELL) | |
| DRILLERS IDENT NO <u>40</u><br>DRILLERS SIGNATURE (MUST MATCH SIGNATURE ON APPLICATION)<br>SITE SUPERVISOR (sign of driller or journeyman responsible for stewart if different from permittee)   |                                        | GRAVEL PACK IF WELL DRILLED WAS FLOWING WELL INSERT F IN BOX 66<br>OFF USE ONLY (NOT TO BE FILLED IN BY DRILLER)<br>T (E.F.O.S.) <u>1</u> <u>1</u> <u>1</u><br>TELESCOPE CASING LOG INDICATOR OTHER DATA   | |
| COUNTY   | |

## WELL ABANDONMENT REPORT

Date: 9-11-91

PERMIT NUMBER OF ABANDONED WELL (if any)

|    |     |   |  |  |  |  |
|----|-----|---|--|--|--|--|
| NO | Tag | - |  |  |  |  |
|----|-----|---|--|--|--|--|

DRILLER'S NAME

WeishaarJoseph

LAST

FIRST

OWNER'S NAME

SchneiderKarl

LAST

FIRST

WELL LOCATION:

COUNTY:

Howard

SUBDIVISION:

SECTION:

LOT:

NEAREST TOWN:

SYKESVILLE

ADDRESS:

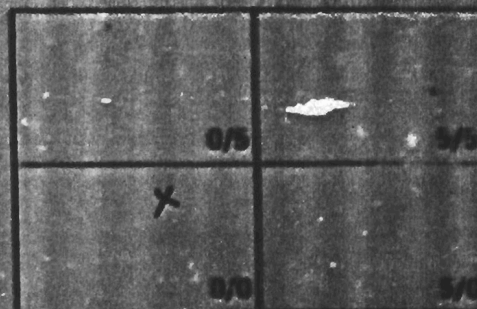
1765 Rt 32

MARYLAND GRID LOCATION:

E

810

N

540SHOW WELL LOCATION BY (X)  
WITHIN BOX

TYPE OF WELL

☒ DRILLED☐ JETTED☐ BORED OR AUGERED☐ OTHER, SPECIFYDEPTH OF WELL 200 FT.

TYPE OF CASING

☒ STEEL☐ PLASTIC☐ CONCRETE☐ OTHER, SPECIFYSIZE OF CASING 6 IN.WAS ANY CASING REMOVED ☒ YES ☐ NOIF YES, AMOUNT REMOVED 4 FT.WAS CASING RIPPED OR PERFORATED ☐ YES ☒ NO

LOG OF SEALING MATERIAL

| MATERIAL  | FEET |    |
|-----------|------|----|
|           | FROM | TO |
| Gravel    | 200  | 25 |
| Cement    | 25   | 3  |
| Back Fill | 3    | 0  |

DRILLER

Joe P. [Signature]

SIGNATURE

LICENSED

11111-452