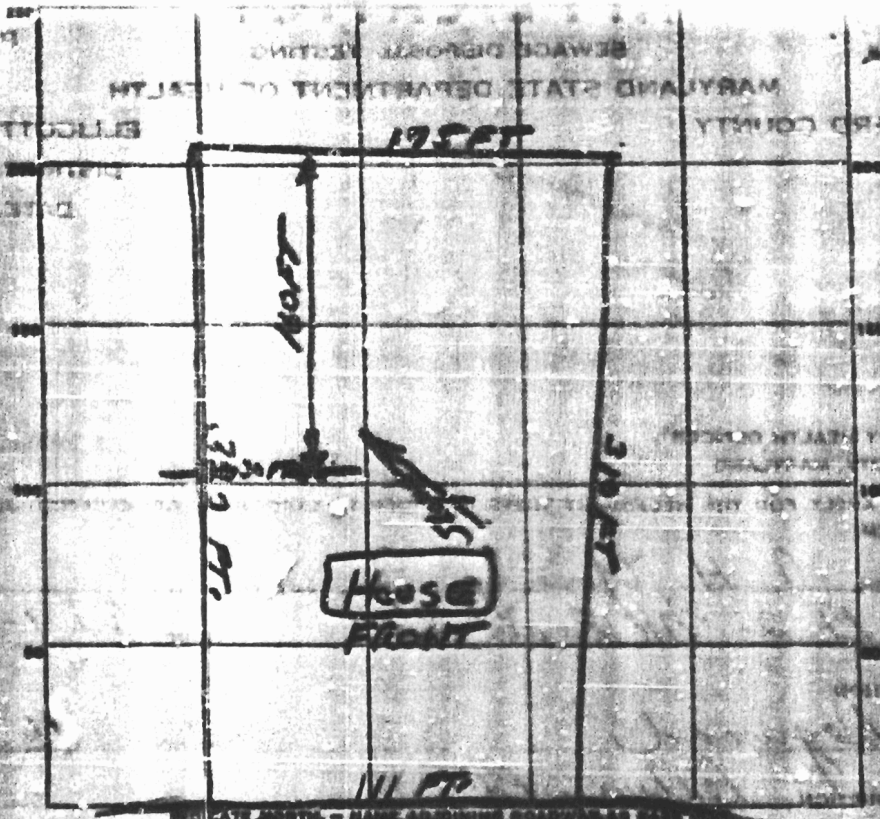

DATE	TEST NO.	DEPTH	PROJECT START	PROJECT STOP	INSPECTOR START	INSPECTOR STOP	TIME
4-21-59	1	10 ft	11:16	11:33	11:33	11:58	25 minutes

SOIL AUGER FINDING

TESTED BY J. H.

REMARKS

ALSO PRESENT [illegible] LOT NO. 16

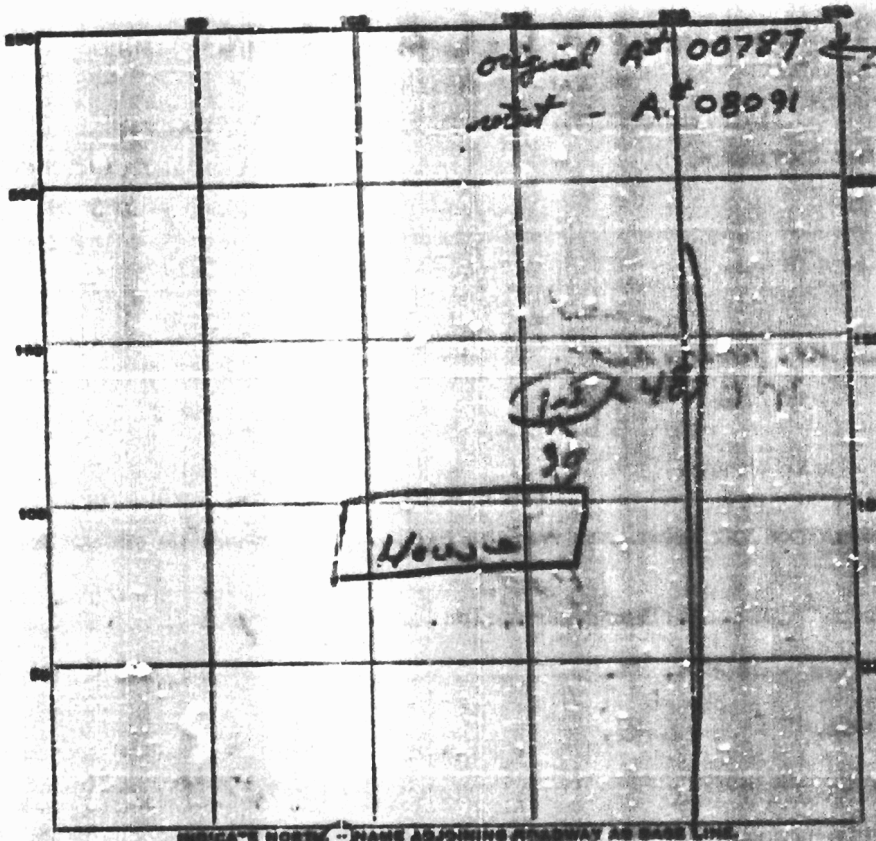

INDICATE NORTH — NAME ADJOINING ROADWAY AS BASE LINE.

DATE	TEST NO.	DEPTH	PRE-WET START	PRE-WET STOP	TEST - 1st DROP START	TEST - 1st DROP STOP	TIME
3/14/04	1	9	1119	1121	1121	1127	8 min.
	2	4	1130	1125	1125	1135	10 min

SOIL AUGER FINDING _____

TESTED BY D. McQ DI 11/04

REMARKS Ok

ALSO PRESENT Edward Lagg LOT NO. _____