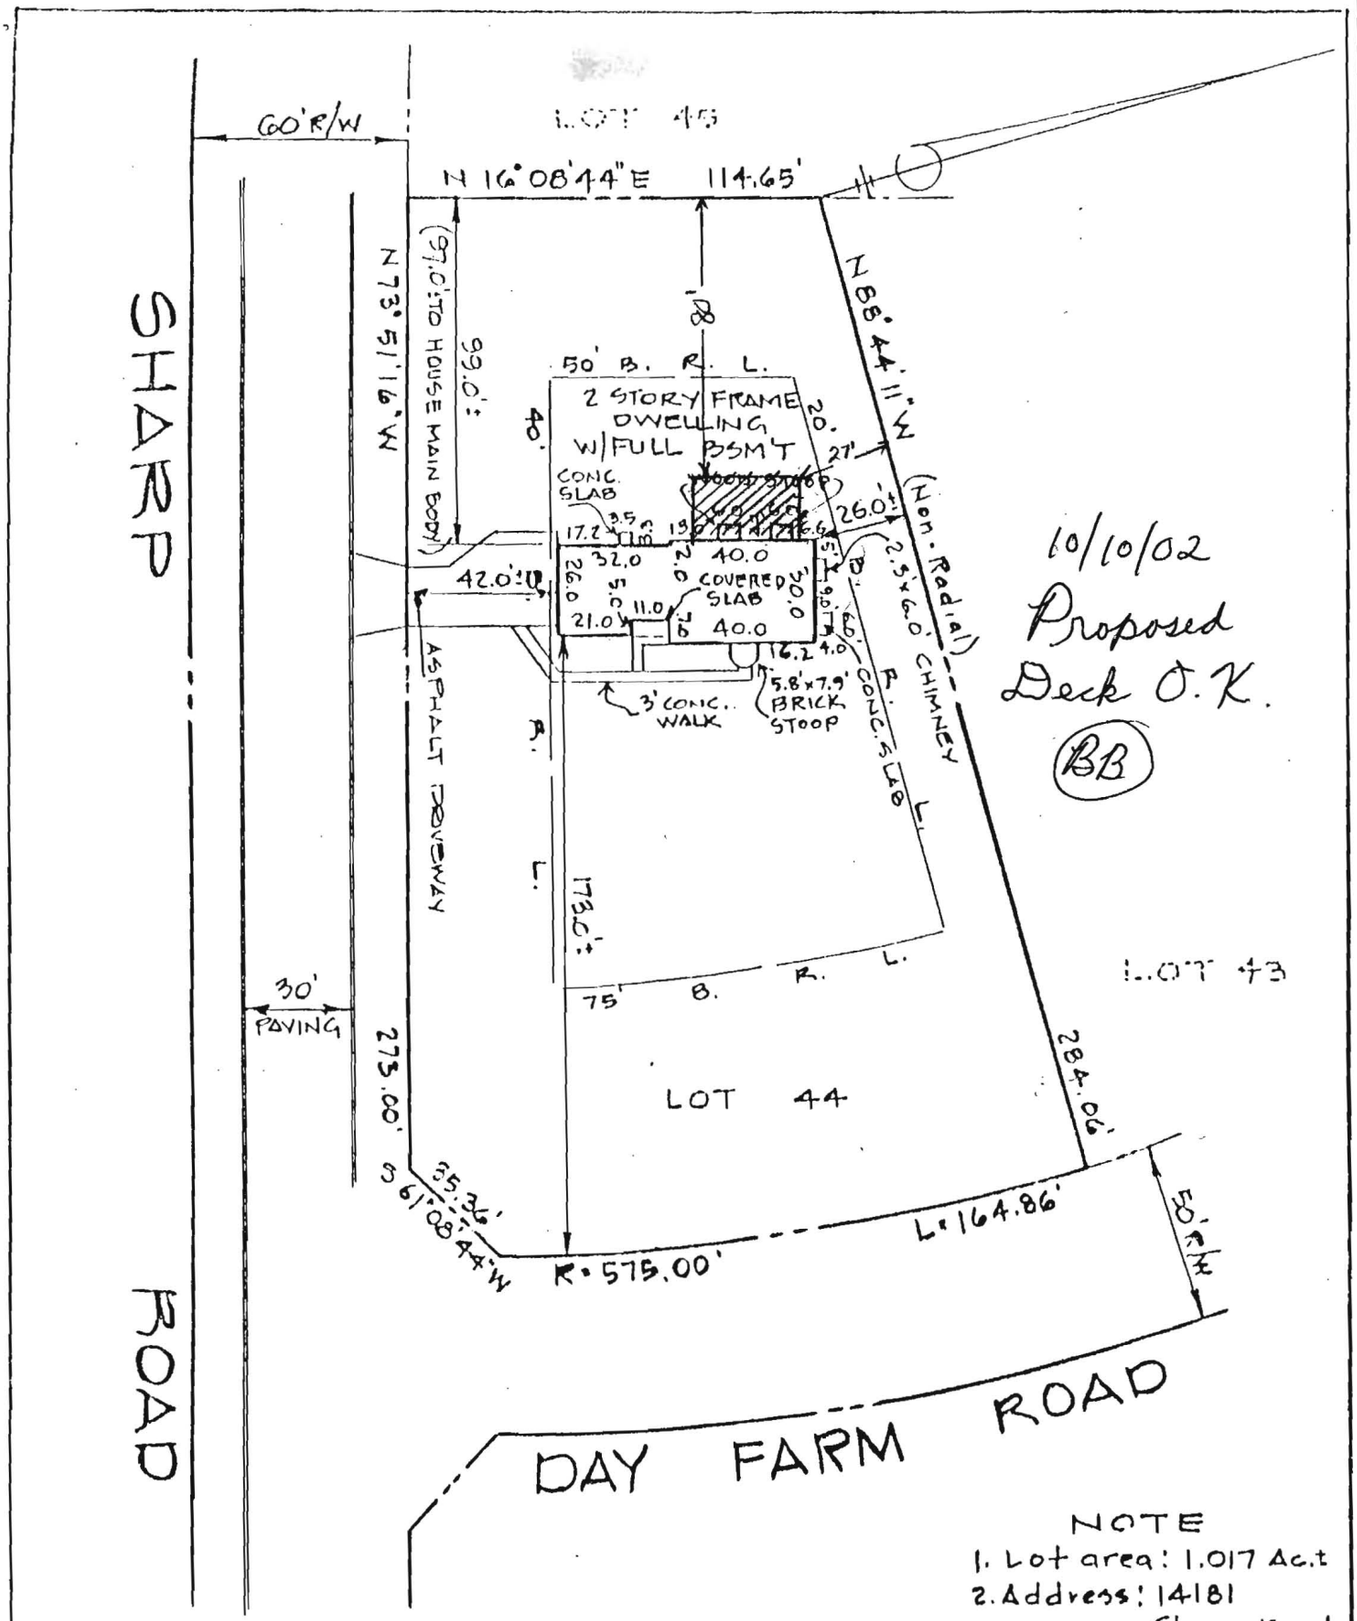

NOTE

1. Lot area: 1.017 Ac.±
2. Address: 14181 Sharp Road
3. This plat not intended for use in the establishment of property lines.

ENGINEER'S CERTIFICATE

I, John L. Schneider, P.E., hereby certify that the improvements to the property shown hereon do exist and all given dimensions are true & correct.

ENGINEER

John L. Schneider, P.E.
100 N. Rolling Road
Catonsville, Md. 21228
301-744-1945

FINAL LOCATION CERTIFICATION

LOT 44 SECTION 1 AREA 2

"THE HERITAGE"

FIFTH ELECTION DISTRICT
HOWARD COUNTY · MARYLAND

SCALE 1"=50'	AUGUST 13, 1986

STATE OF MARYLAND · JOHN L. SCHNEIDER · REGISTERED PROFESSIONAL ENGINEER