Demo B141988 — Call cont - mef

DEPARTMENT OF INSPECTIONS, LICENSES AND PERMITS
3430 COURT HOUSE DRIVE
ELLICOTT CITY, MD 21043
PERMITS (410)313-2455 INSPECTIONS (410)313-1810
AUTOMATED INFORMATION (410) 313-3800

HOWARD COUNTY PERMIT APPLICATION

PERMIT NUMBER B00142066

Building Address 625 River Rd
Sykesville, MD 21784
Suite/Apt. #: _____ SDP/WP/Petition #: _____
Census Tract 6070 Subdivision Janet L. Miller
Section — Area — Lot 2
Tax Map 04 Parcel 98 Grid 23
Zoning RR Map Coordinates 507 Lot size 1.50

Property Owner's Name mark miller
Address 625 River Rd
City Sykesville State MD Zip Code 21784
Home Phone 410 442-0253 Work Phone 410 489-0655
Applicant's Name & Mailing Address, (if other than stated hereon):
Phone Fax 410 489-0651

Existing Use Residential SF Home
Proposed Use Residential
Estimated Construction Cost $ 204,000
Description of Work Existing house to be 4/3BR Attached 2 car garage / unfinished basement removed. New house to be constructed/new Custom S/F/D

Contractor Company Thomas Fiore Contracting
Contact Person Tom Fiore
Address 327 South Drive
City Severna Park State MD Zip Code 21146
License No. 2739
Phone (410) 431-7057 ←Fax

Occupant or Tenant mark miller
Contact Name mark miller
Address 7433 Village Rd #22
City Sykesville State MD Zip Code 21784
Phone (410)442-0253 Fax (410)489-0651

Engineer or Architect Company FSH Associates
Contact Person Paul Sill
Address 8318 forrest Street
City Ellicott City State MD Zip Code 21043
Phone (410) 750-2251 Fax (410) 750-7350

BUILDING DESCRIPTION - *COMMERCIAL*

Building Characteristics

Height:
No. of stories:
Gross area, sq. ft. per floor:
Use group:
Construction type:
____ Reinforced Concrete
____ Structural Steel
____ Masonry
____ Wood Frame
____ State Certified Modular

Utilities

Water Supply:
____ Public
____ Private
Sewage Disposal:
____ Public
____ Private
Electric Yes ☐ No ☐
Gas Yes ☐ No ☐
Heating System:
Electric ☐ Oil ☐
Natural Gas ☐
Propane Gas ☐
Sprinkler system: N/A ☐
____ Full
____ Partial
____ Other Suppression
____ # of Heads

BUILDING DESCRIPTION - *RESIDENTIAL*

Building Characteristics

SF Dwelling ☑ SF Townhouse ☐

	Depth	Width
1st floor:	44'	60'
2nd floor:	~~33'~~	38'
Basement:	~~33'~~	~~38'~~

Finished Basement ☐ Unfinished Basement ☑
Crawl space ☐ Slab on Grade ☐
No. of Bedrooms 4

Multi-family dwellings:
No. of efficiency units: _____
No. of 1 BR units: _____
No. of 2 BR units: _____
No. of 3 BR units: _____

Other Structure: _____
Dimensions: _____
Footings: _____
Roof: _____

____ State Certified Modular
____ Manufactured Home

Utilities

Water Supply:
____ Public
☑ Private
Sewage Disposal:
____ Public
☑ Private
Electric Yes ☑ No ☐
Gas Yes ☐ No ☐
Heating System:
Electric ☑ Oil ☐
Natural Gas ☐
Propane Gas ☑
Sprinkler system: N/A ☑
____ NFPA #13D
____ NFPA #13R
____ Other:

THE UNDERSIGNED HEREBY CERTIFIES AND AGREES AS FOLLOWS: (1) THAT HE/SHE IS AUTHORIZED TO MAKE THIS APPLICATION; (2) THAT THE INFORMATION IS CORRECT; (3) THAT HE/SHE WILL COMPLY WITH ALL REGULATIONS OF HOWARD COUNTY WHICH ARE APPLICABLE THERETO; (4) THAT HE/SHE WILL PERFORM NO WORK ON THE ABOVE REFERENCED PROPERTY NOT SPECIFICALLY DESCRIBED IN THIS APPLICATION; (5) THAT HE/SHE GRANTS COUNTY OFFICIALS THE RIGHT TO ENTER ONTO THIS PROPERTY FOR THE PURPOSE OF INSPECTING THE WORK PERMITTED AND POSTING NOTICES.

Applicant's Signature — *Print Name* Thomas Fiore

Title/Company Pres. - Thomas Fiore Cont. Co. — Date 5/15/03 5-23-03

MR 6/6/03

Checks payable to: *DIRECTOR OF FINANCE OF HOWARD COUNTY*
** PLEASE WRITE NEATLY AND LEGIBLY. **

- FOR OFFICE USE ONLY -

AGENCY	DATE	SIGNATURE APPROVAL	DPZ SETBACK INFORMATION	PROPERTY ID#: 16543
Land Development, DPZ			Front:	Bldg:

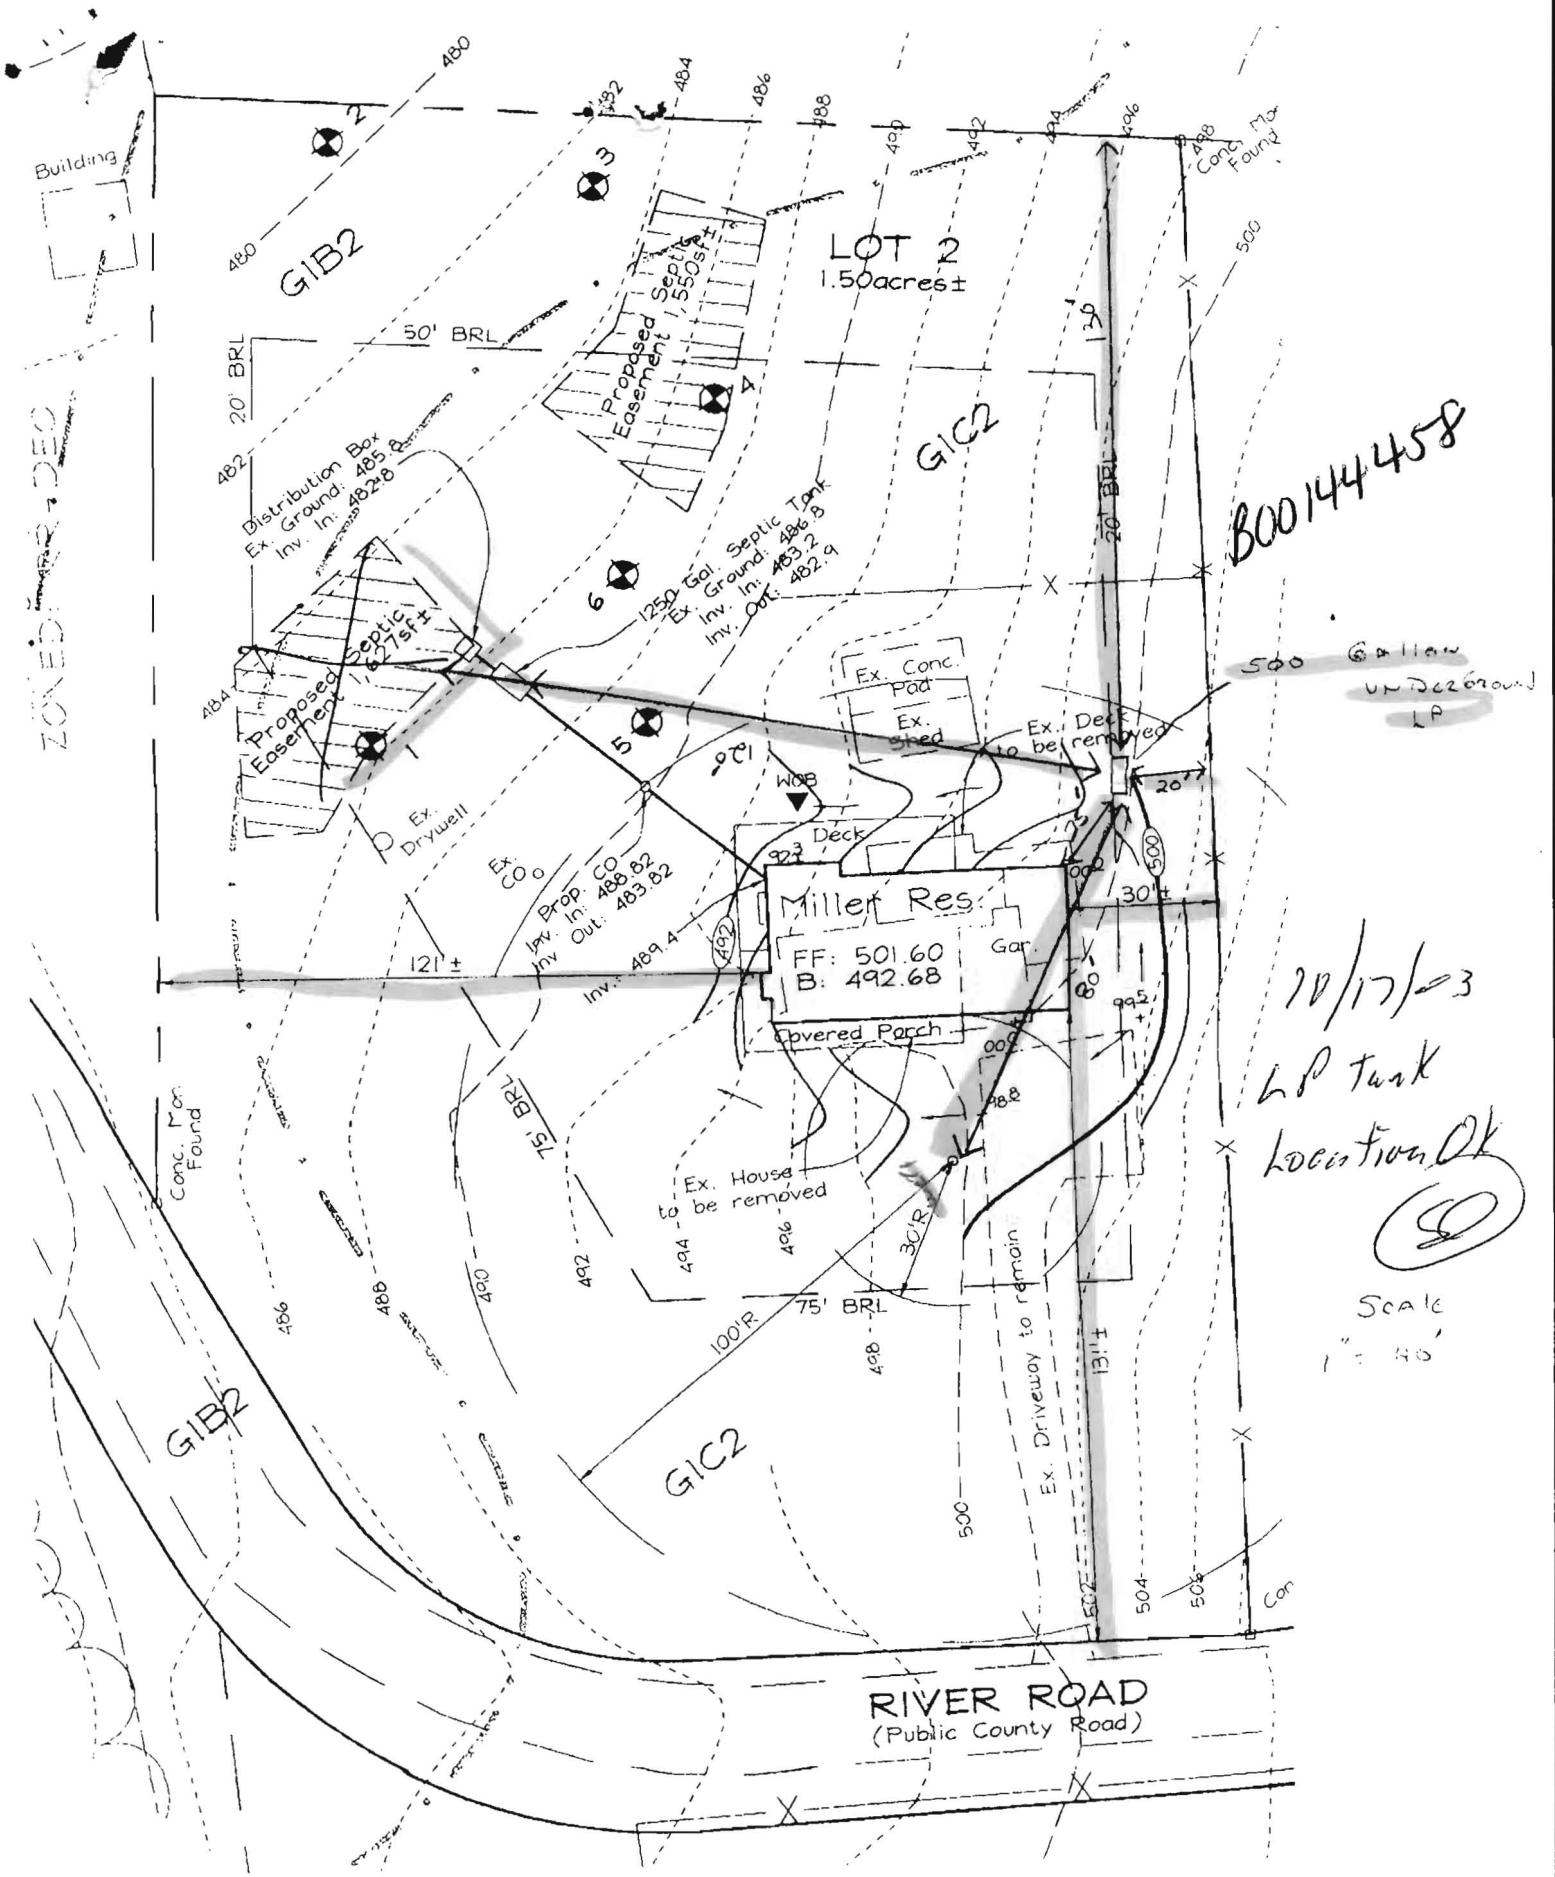

B00144458

10/17/03
LP Tank
Location OK

Scale
1" = 40'