G 9445

DEPARTMENT OF INSPECTIONS, LICENSES AND PERMITS
3430 COURT HOUSE DRIVE
ELLICOTT CITY, MD 21043
PERMITS (410) 313-2455 INSPECTIONS (410) 313-1810
AUTOMATED INFORMATION (410) 313-3800

HOWARD COUNTY PERMIT APPLICATION

PERMIT NUMBER B00156446

Building Address 3716 Sofia Ct
Glenwood MD 21738

Suite/Apt. #: 04-365968 SDP/WP/Petition #: Plat # 14835

Census Tract 604002 Subdivision Vineyards at Cattail

Section ______ Area ______ Lot 11

Tax Map 21 Parcel 225 Grid 8

Zoning RC-DEO Map Coordinates 8-9 Lot size 59,898

Property Owner's Name Rylea Homes Inc.

Address P.O. Box

City Glenwood State MD Zip Code 21738

Home Phone ______ Work Phone ______

Applicant's Name & Mailing Address, (if other than stated hereon):

Phone 410 489 6030 Fax 410 489 6032

Existing Use Vacant Lot

Proposed Use SFD

Estimated Construction Cost $ 750,000

Description of Work 4 Bedroom 5½ Bath, R.I. bsmt, Unfinished Basement 3 Car Attach Gar. 3 DP

Contractor Company Rylea Homes Inc.

Contact Person James P. Ryan Jr.

Address Same

City ______ State ______ Zip Code ______

License No. ______

Phone ______ Fax ______

Occupant or Tenant ______

Contact Name ______

Address ______

City ______ State ______ Zip Code ______

Phone ______ Fax ______

Engineer or Architect Company R. Taylor

Contact Person ______

Address ______

City Ellicott City State ______ Zip Code ______

Phone ______ Fax ______

BUILDING DESCRIPTION - *COMMERCIAL*

Building Characteristics

Height:

No. of stories:

Gross area, sq. ft. per floor:

Use group:

Construction type:
____ Reinforced Concrete
____ Structural Steel
____ Masonry
____ Wood Frame

____ State Certified Modular

Utilities

Water Supply:
____ Public
____ Private

Sewage Disposal:
____ Public
____ Private

Electric Yes ☐ No ☐
Gas Yes ☐ No ☐

Heating System:
Electric ☐ Oil ☐
Natural Gas ☐
Propane Gas ☐

Sprinkler system: N/A ☐
____ Full
____ Partial
____ Other Suppression
____ # of Heads

BUILDING DESCRIPTION - *RESIDENTIAL*

Building Characteristics

SF Dwelling ☑ SF Townhouse ☐

	Depth	Width
1st floor:		
2nd floor:		
Basement:		

Finished Basement ☐ Unfinished Basement ☑
Crawl space ☐ Slab on Grade ☐
No. of Bedrooms 4
Height:

Multi-family dwellings:
No. of efficiency units: ______
No. of 1 BR units: ______
No. of 2 BR units: ______
No. of 3 BR units: ______

Other Structure: ______
Dimensions: ______
Footings: ______
Roof Height: ______

____ State Certified Modular
____ Manufactured Home

Utilities

Water Supply:
____ Public
✓ Private

Sewage Disposal:
____ Public
✓ Private

Electric Yes ☑ No ☐
Gas Yes ☑ No ☐

Heating System:
Electric ☐ Oil ☐
Natural Gas ☐
Propane Gas ☑

Sprinkler system: N/A ☑
____ NFPA #13D
____ NFPA #13R
____ Other:

THE UNDERSIGNED HEREBY CERTIFIES AND AGREES AS FOLLOWS: (1) THAT HE/SHE IS AUTHORIZED TO MAKE THIS APPLICATION; (2) THAT THE INFORMATION IS CORRECT; (3) THAT HE/SHE WILL COMPLY WITH ALL REGULATIONS OF HOWARD COUNTY WHICH ARE APPLICABLE THERETO; (4) THAT HE/SHE WILL PERFORM NO WORK ON THE ABOVE REFERENCED PROPERTY NOT SPECIFICALLY DESCRIBED IN THIS APPLICATION; (5) THAT HE/SHE GRANTS COUNTY OFFICIALS THE RIGHT TO ENTER ONTO THIS PROPERTY FOR THE PURPOSE OF INSPECTING THE WORK PERMITTED AND POSTING NOTICES.

Applicant's Signature [signature]

Print Name James P. Ryan Jr.

Title/Company President / Rylea Homes Inc.

Date 11 Oct 05

Checks payable to: ***DIRECTOR OF FINANCE OF HOWARD COUNTY***

** PLEASE WRITE NEATLY AND LEGIBLY. **

53355

- FOR OFFICE USE ONLY -

AGENCY	DATE	SIGNATURE APPROVAL
Land Development, DPZ		
State Highways		
Building Official		
Dev. Engineering, DPZ		
Health	11/3/05	[signature]
Fire Protection		

Is Sediment Control approval required prior to issuance?
YES ☒ NO ☐

CONTINGENCY CONSTRUCTION START: ☐

ONE STOP SHOP: ☐

DPZ SETBACK INFORMATION

Front: 50'
Rear: 30'
Side: 10'
Side St: 30'

All minimum setbacks met?
YES ☐ NO ☐

Is Entrance Permit required?
YES ☐ NO ☐

Historic District?
YES ☐ NO ☐

Lot Coverage for New Town Zone ______

SDP/Red-line approval date ______

PROPERTY ID#:

Filing fee	$ 100.00
Permit fee	$
Excise tax	$
Add'l per. fee	$
TOTAL FEES	$
Sub-total paid	$
Balance due	$
Check	# 10175
Validation	# 100349

Accepted by ______

Distribution of Copies- White: Building Official Green: LDD, DPZ Yellow: DED, DPZ Pink: Health Gold: SHA

T:\forms\PERMIT.FRM

Rev. 11/4/04

DEPARTMENT OF INSPECTIONS, LICENSES AND PERMITS
3430 COURT HOUSE DRIVE
ELLICOTT CITY, MD 21043
PERMITS (410) 313-2455 INSPECTIONS (410) 313-1810
AUTOMATED INFORMATION (410) 313-3800

HOWARD COUNTY PERMIT APPLICATION

PERMIT NUMBER B07002328

Building Address 3710 Sofia Ct
Glenwood MD 21738

Suite/Apt. #: _____ SDP/WP/Petition #: _____

Census Tract _____ Subdivision _____

Section _____ Area _____ Lot _____

Tax Map _____ Parcel _____ Grid _____

Zoning Map Coordinates Lot size

Property Owner's Name Pines

Address 3710 Sofia Ct

City _____ State _____ Zip Code _____

Home Phone _____ Work Phone _____

Applicant's Name & Mailing Address, (if other than stated hereon):

Phone Fax

Existing Use Open

Proposed Use deck / screened porch

Estimated Construction Cost $ ~~$160,000.00~~

Description of Work deck / screened porch w/ steps to grade - 2nd deck no steps

Contractor Company Advanced Deck Designs

Contact Person Steve

Address 3317 Brookeville Rd

City Laytonsville State MD Zip Code 20882

License No# _____

Phone 301-947-5772 Fax 301-947-5774

Occupant or Tenant Pines

Contact Name Pines

Address 3710 Sofia Ct

City Glenwood State MD Zip Code 21738

Phone Fax

Engineer or Architect Company _____

Contact Person _____

Address _____

City _____ State _____ Zip Code _____

Phone Fax

BUILDING DESCRIPTION - *COMMERCIAL*

Building Characteristics

Height:

No. of stories:

Gross area, sq. ft. per floor:

Use group:

Construction type:
_____ Reinforced Concrete
_____ Structural Steel
_____ Masonry
_____ Wood Frame

_____ State Certified Modular

Utilities

Water Supply:
____ Public
____ Private
Sewage Disposal:
____ Public
____ Private

Electric Yes ☐ No ☐
Gas Yes ☐ No ☐

Heating System:
Electric ☐ Oil ☐
Natural Gas ☐
Propane Gas ☐

Sprinkler system: N/A ☐
____ Full
____ Partial
____ Other Suppression
____ # of Heads

BUILDING DESCRIPTION - *RESIDENTIAL*

Building Characteristics

SF Dwelling ☐ SF Townhouse ☐

	Depth	Width
1st floor:		
2nd floor:		
Basement:		

Finished Basement ☐ Unfinished Basement ☐
Crawl space ☐ Slab on Grade ☐
No. of Bedrooms _____
Height: _____
Multi-family dwellings:
No. of efficiency units: _____
No. of 1 BR units: _____
No. of 2 BR units: _____
No. of 3 BR units: _____

Other Structure: _____
Dimensions: _____
Footings: _____
Roof Height: _____

_____ State Certified Modular
_____ Manufactured Home

Utilities

Water Supply:
____ Public
____ Private
Sewage Disposal:
____ Public
____ Private

Electric Yes ☐ No ☐
Gas Yes ☐ No ☐

Heating System:
Electric ☐ Oil ☐
Natural Gas ☐
Propane Gas ☐

Sprinkler system: N/A ☐
_____ NFPA #13D
_____ NFPA #13R
_____ Other:

THE UNDERSIGNED HEREBY CERTIFIES AND AGREES AS FOLLOWS: (1) THAT HE/SHE IS AUTHORIZED TO MAKE THIS APPLICATION; (2)THAT THE INFORMATION IS CORRECT; (3) THAT HE/SHE WILL COMPLY WITH ALL REGULATIONS OF HOWARD COUNTY WHICH ARE APPLICABLE THERETO; (4) THAT HE/SHE WILL PERFORM NO WORK ON THE ABOVE REFERENCED PROPERTY NOT SPECIFICALLY DESCRIBED IN THIS APPLICATION; (5) THAT HE/SHE GRANTS COUNTY OFFICIALS THE RIGHT TO ENTER ONTO THIS PROPERTY FOR THE PURPOSE OF INSPECTING THE WORK PERMITTED AND POSTING NOTICES.

Colleen Smisher
Applicant's Signature

Colleen Smisher
Print Name

Title/Company

6/13/07
Date

Checks payable to: ***DIRECTOR OF FINANCE OF HOWARD COUNTY***
** PLEASE WRITE NEATLY AND LEGIBLY. **

- FOR OFFICE USE ONLY -

AGENCY	DATE	SIGNATURE APPROVAL
Land Development, DPZ		
State Highways		
Building Official		
Dev. Engineering, DPZ		
Health	6/13/07	
Fire Protection		

Is Sediment Control approval required prior to issuance?
YES ☐ NO ☐

CONTINGENCY CONSTRUCTION START: ☐
ONE STOP SHOP: ☐

DPZ SETBACK INFORMATION

Front: _____
Rear: _____
Side: _____
Side St.: _____
All minimum setbacks met?
YES ☐ NO ☐
Is Entrance Permit required?
YES ☐ NO ☐
Historic District?
YES ☐ NO ☐
Lot Coverage for NewTown Zone _____
SDP/Red-line approval date _____

PROPERTY ID#:

Filing fee	$
Permit fee	$
Excise tax	$
Add'l per. fee	$
TOTAL FEES	$
Sub-total paid	$
Balance due	$
Check	#
Validation	#

Accepted by _____

Distribution of Copies- White: Building Official Green: LDD, DPZ Yellow: DED, DPZ Pink: Health Gold: SHA

T:\forms\PERMIT.FRM

Rev. 11/4/04

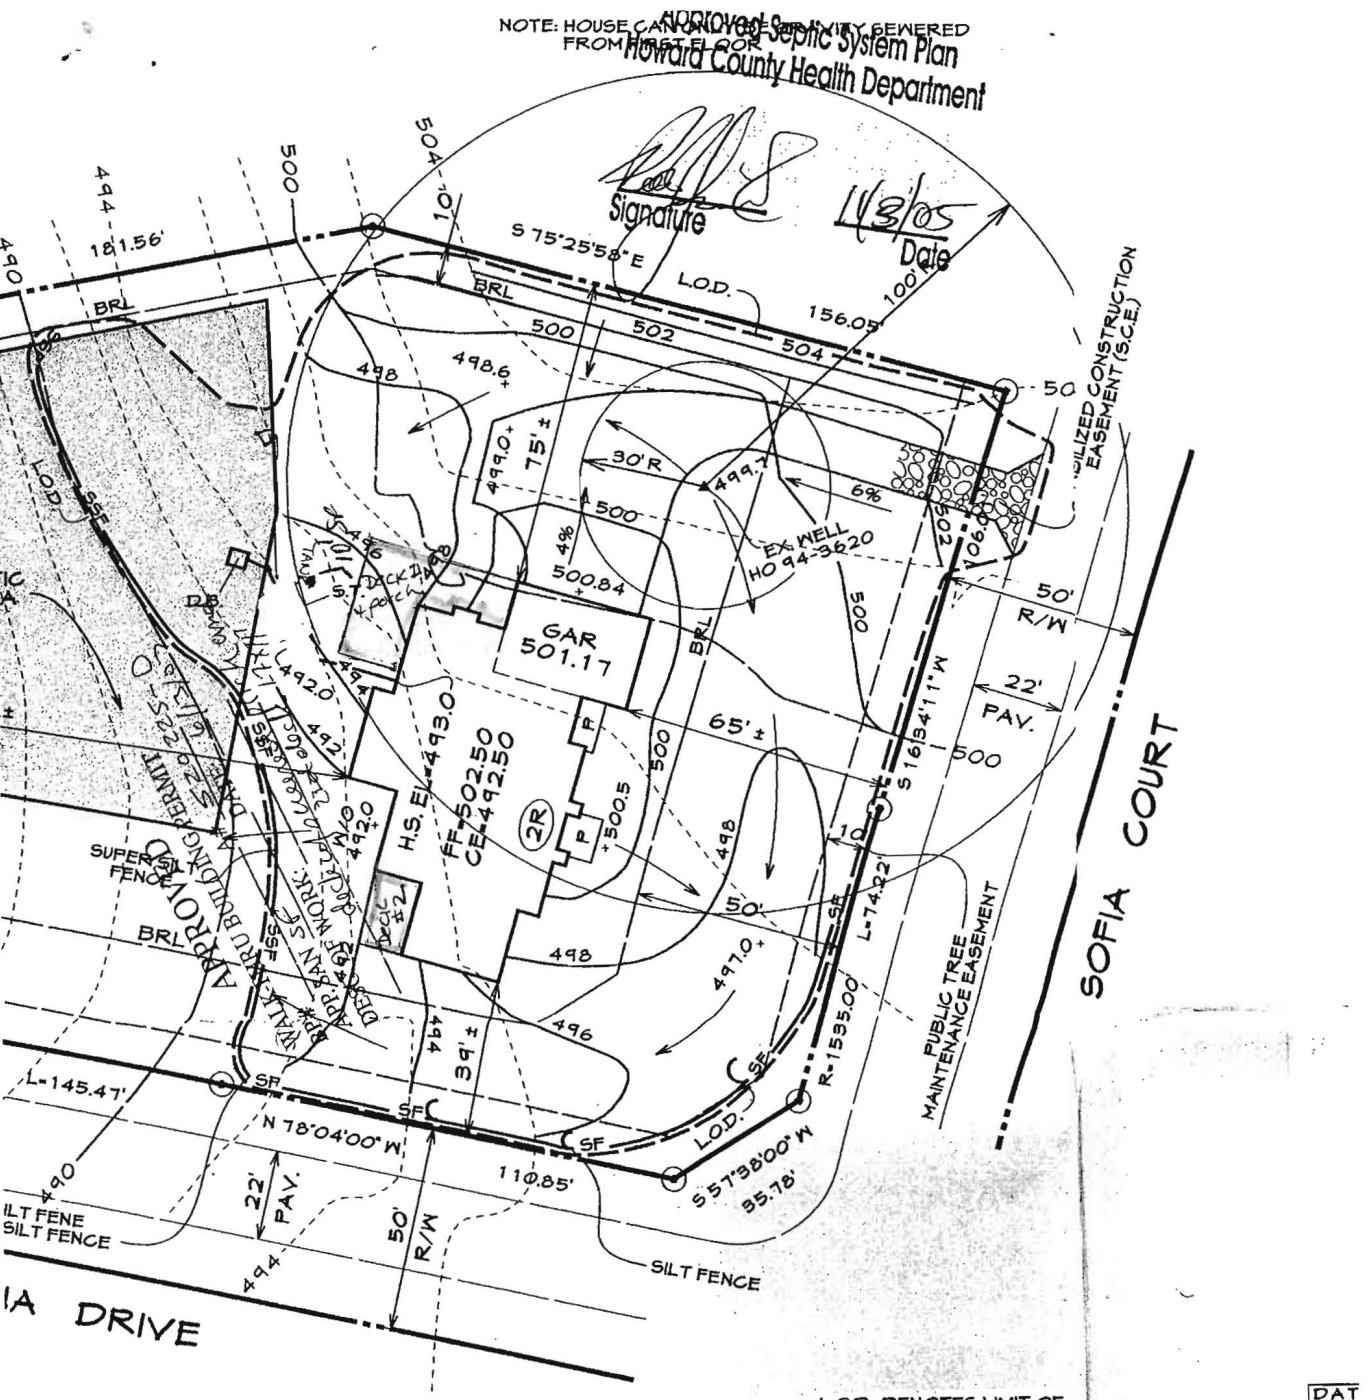

ADING AND HOUSE LOCATION PLAN

SCALE 1"=30'

L.O.D.-DENOTES LIMIT OF DISTURBANCE TOTAL AREA-33,650 S.F.

DAT
10/17

PLAN TO ACCOMPANY APPLICATION FOR BUILDING PERMIT

VINEYARDS AT CATTAIL CREEK

LOT 11

#3710 SOFIA COURT


TAX MAP:21 PARCEL:225

PLAT # 14835

he attached well tag
Land Services Inc.