

C1 8782

SEQUENCE NO.
(MDE USE ONLY)STATE OF MARYLAND
WELL COMPLETION REPORT
FILL IN THIS FORM COMPLETELY
PLEASE TYPETHIS REPORT MUST BE SUBMITTED WITHIN
45 DAYS AFTER WELL IS COMPLETED.1 2 3 6
(THIS NUMBER IS TO BE PUNCHED
IN COLS. 3-6 ON ALL CARDS)COUNTY
NUMBER 13 A517422ST/CO-USE ONLY
DATE Received
MM DD YY

DATE WELL COMPLETED

MM DD YY
3 26 2007

Depth of Well

22 90 26

(TO NEAREST FOOT)

PERMIT NO.
FROM "PERMIT TO DRILL WELL"

H0-95-0610

28 29 30 31 32 33 34 35 36 37

OWNER

STREET OR RFD

De Francis
Sweet Meadow Lane

first name

TOWN Clarksville

SUBDIVISION

Walnut Grove

SECTION

LOT 11

WELL LOG

Not required for driven wells

STATE THE KIND OF FORMATIONS PENETRATED, THEIR
COLOR, DEPTH, THICKNESS AND IF WATER BEARINGDESCRIPTION (Use
additional sheets if needed)FEET
FROM TOcheck
if water
bearing

Sand - clay

0 57

Gray mica
Rock

57 90 ✓

GROUTING RECORD

yes no

WELL HAS BEEN GROUTED
(Circle Appropriate Box)

Y N

TYPE OF GROUTING MATERIAL (Circle one)

CEMENT

CM

BENTONITE CLAY

BC

NO. OF BAGS

45 46

NO. OF POUNDS

45 46 38

GALLONS OF WATER

162

DEPTH OF GROUT SEAL (to nearest foot)

from 48 TOP 52 ft. to 54 BOTTOM 58 ft.
(enter 0 if from surface)casing
types
insert
appropriate
code
below

CASING RECORD

ST

STEEL

CO

CONCRETE

PL

PLASTIC

OT

OTHER

MAIN
CASING
TYPE

ST

Nominal diameter
top (main) casing
(nearest inch)

6

Total depth
of main casing
(nearest foot)

60

60 61

63 64

66 70

E
A
C
H
C
A
S
I
N
G

OTHER CASING (if used)

diameter
inchdepth (feet)
from toscreen type
or open hole

SCREEN RECORD

(insert
appropriate
code
below)

ST

STEEL

BR

BRASS

BRONZE

PL

PLASTIC

HO

OPEN
HOLE

OT

OTHER

C 2

DEPTH (nearest ft.)

1 2 

NUMBER OF UNSUCCESSFUL WELLS: 0

WELL HYDROFRACTURED

yes

Y

no

N

CIRCLE APPROPRIATE LETTER

A A WELL WAS ABANDONED AND SEALED

E ELECTRIC LOG OBTAINED

P TEST WELL CONVERTED TO PRODUCTION

WELL

I HEREBY CERTIFY THAT THIS WELL HAS BEEN CONSTRUCTED IN
ACCORDANCE WITH COMAR 26.04.04 "WELL CONSTRUCTION" AND
IN CONFORMANCE WITH ALL CONDITIONS STATED IN THE ABOVE
CAPTIONED PERMIT, AND THAT THE INFORMATION PRESENTED
HEREIN IS ACCURATE AND COMPLETE TO THE BEST OF MY
KNOWLEDGE.

DRILLERS LIC. NO. 1

M S D 024

DRILLER'S SIGNATURE

(MUST MATCH SIGNATURE ON APPLICATION)

LIC. NO. 1

D

SITE SUPERVISOR (sign. of driller or journeyman
responsible for sitework if different from permittee)GRAVEL PACK
IF WELL DRILLED
WAS FLOWING WELL
INSERT F IN BOX 68MDE USE ONLY
(NOT TO BE FILLED IN BY DRILLER)
T (E.R.O.S.) W Q

70

72

74 75 76

TELESCOPE
CASINGLOG
INDICATOR

OTHER DATA

C 3

1 2

PUMPING TEST

HOURS PUMPED (nearest hour)

3

PUMPING RATE (gal. per min.)

20

METHOD USED TO
MEASURE PUMPING RATE

Bucket

WATER LEVEL (distance from land surface)

15

BEFORE PUMPING

17 20 ft.

WHEN PUMPING

22 25 ft.

TYPE OF PUMP USED (for test)

A air

P piston

T turbine

C centrifugal

R rotary

O other
(describe
below)

J jet

S submersible

PUMP INSTALLED

DRILLER INSTALLED PUMP
(CIRCLE) (YES or NO)

YES NO

IF DRILLER INSTALLS PUMP, THIS SECTION
MUST BE COMPLETED FOR ALL WELLS.TYPE OF PUMP INSTALLED
PLACE (A,C,J,P,R,S,T,O)
IN BOX 29.CAPACITY:
GALLONS PER MINUTE
(to nearest gallon)

31 35

PUMP HORSE POWER

37 41

PUMP COLUMN LENGTH
(nearest ft.)

43 47

CASING HEIGHT (circle appropriate box
and enter casing height)

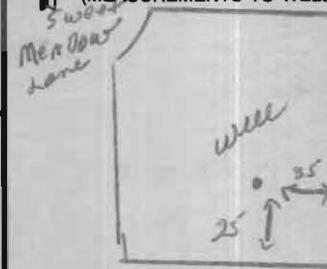
+ above

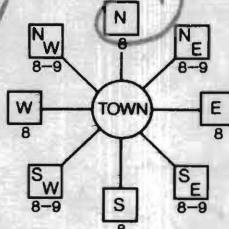
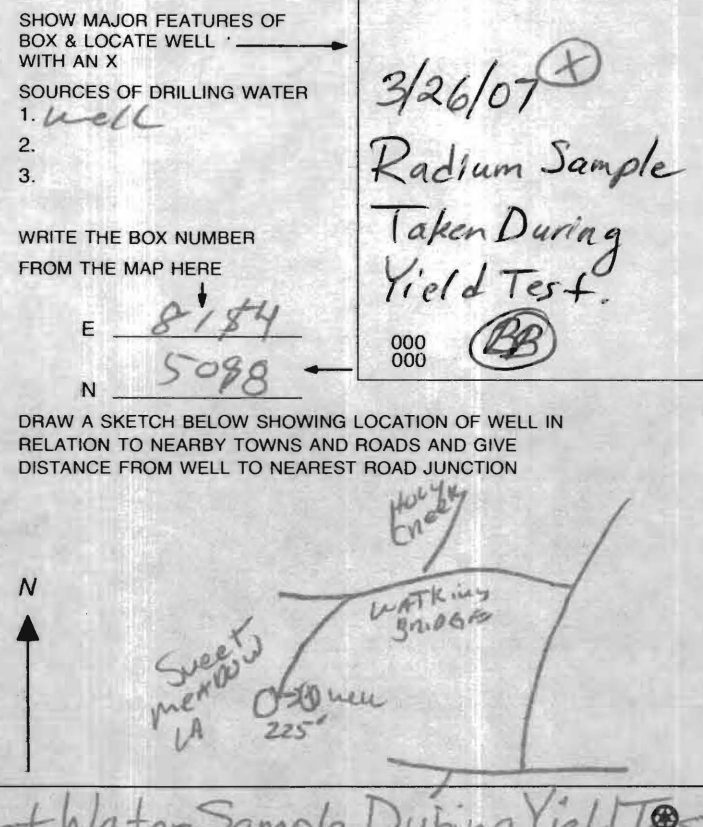
LAND SURFACE

- below

(nearest
foot)

LOCATION OF WELL ON LOT

SHOW PERMANENT STRUCTURE SUCH AS
BUILDING, SEPTIC TANKS, AND /OR
LANDMARKS AND INDICATE NOT LESS
THAN TWO DISTANCES
(MEASUREMENTS TO WELL)

B 1 0527 <small>1 2 3 6</small>	SEQUENCE NO. (MDE USE ONLY)	STATE OF MARYLAND APPLICATION FOR PERMIT TO DRILL WELL 525642 please type	STATE PERMIT NUMBER HO-95-0610 <small>70 fill in this form completely 79</small>
Date Received (APA) <small>8 MM DD YY 13</small> Landmarking Consultants <small>15 Last Name Owner First Name 34</small> 3060 Rt. 97 <small>36 Street or RFD 55</small> Glenwood MD 21771 <small>57 Town 70 State 72 Zip 76</small>		B 3 LOCATION OF WELL <small>8 COUNTY 21</small> Howard <small>23 SUBDIVISION 42</small> Walnut Grove <small>52 NEAREST TOWN 71</small> CLARKSVILLE <small>52 NEAREST TOWN 71</small> MILES FROM TOWN (enter 0 if in town) 2 <small>73 76 77 78</small>	
DRILLER INFORMATION Driller's Name Ralph E. Mayne <small>76</small> License No. M SD 117 <small>81</small> Firm Name Ralph E. Mayne INC Address 17024 Hardy Rd Mt. Airy MD 21771 Signature [Signature] <small>11-11-06 Date </small>		B 4 DIRECTION OF WELL FROM TOWN (CIRCLE BOX) 	
WELL INFORMATION APPROX. PUMPING RATE (GAL. PER MIN.) 5 <small>1 2</small> AVERAGE DAILY QUANTITY NEEDED (GAL. PER DAY) 500 <small>14 20</small>		ON WHICH SIDE OF ROAD (CIRCLE APPROPRIATE BOX) <small>11 NEAR WHAT ROAD 30</small> Sweet Meadow LA ON WHICH SIDE OF ROAD (CIRCLE APPROPRIATE BOX) <small>34 37</small> DISTANCE FROM ROAD 235 ENTER FT OR MI FT TAX MAP: 28 BLK: 18 PARCEL: 74	
USE FOR WATER (CIRCLE APPROPRIATE BOX) <input checked="" type="radio"/> DOMESTIC POTABLE SUPPLY & RESIDENTIAL IRRIGATION <input type="radio"/> FARMING (LIVESTOCK WATERING & AGRICULTURAL IRRIGATION) <input type="radio"/> INDUSTRIAL, COMMERCIAL, DEWATERING <input type="radio"/> PUBLIC WATER SUPPLY WELL <input type="radio"/> TEST, OBSERVATION, MONITORING <input type="radio"/> GEO-THERMAL		NOT TO BE FILLED IN BY DRILLER HEALTH DEPARTMENT APPROVAL COUNTY NAME Howard COUNTY NO. 13 STATE SIGNATURE Brian Baker INSERT S → DATE ISSUED 12/19/2006 EXP. DATE 12/19/2007 <small>43 MM DD YY 48</small> NORTH GRID 508 000 EAST GRID 814 000 <small>50 55 57 63</small>	
APPROXIMATE DEPTH OF WELL 150 FEET <small>24 28</small> APPROXIMATE DIAMETER OF WELL 6" NEAREST INCH		SHOW MAJOR FEATURES OF BOX & LOCATE WELL WITH AN X SOURCES OF DRILLING WATER 1. well 2. 3. WRITE THE BOX NUMBER FROM THE MAP HERE E 8184 N 5088	
METHOD OF DRILLING (circle one) BORED (or Augered) <input checked="" type="radio"/> JETTED <input type="radio"/> Jetted & DRIVEN <input type="radio"/> <small>30</small> AIR-ROTary <input checked="" type="radio"/> AIR-PERCussion <input type="radio"/> ROTARY (Hydraulic Rotary) <input type="radio"/> <small>37</small> CABLE <input type="radio"/> REVERSE-ROTary <input type="radio"/> DRIVE-POINT <input type="radio"/> other _____		DRAW A SKETCH BELOW SHOWING LOCATION OF WELL IN RELATION TO NEARBY TOWNS AND ROADS AND GIVE DISTANCE FROM WELL TO NEAREST ROAD JUNCTION 	
REPLACEMENT OR DEEPEMED WELLS (CIRCLE APPROPRIATE BOX) <input checked="" type="radio"/> THIS WELL WILL NOT REPLACE AN EXISTING WELL <input type="radio"/> THIS WELL WILL REPLACE A WELL THAT WILL BE ABANDONED AND SEALED <input type="radio"/> THIS WELL WILL REPLACE A WELL THAT WILL BE USED AS A STANDBY-CONTACT LOCAL APPROVING AUTHORITY FOR POLICY ON STANDBY WELLS <input type="radio"/> THIS WELL WILL DEEPEM AN EXISTING WELL PERMIT NUMBER OF WELL TO BE REPLACED OR DEEPEMED (IF AVAILABLE) <small>41</small> _____ <small>52</small>		Not to be filled in by driller (MDE OR COUNTY USE ONLY) APPROX. PERMIT NUMBER H02005G-006 PERMIT No. HO-95-0610 <small>70 71 72 73 74 75 76 77 78 79</small>	
SPECIAL CONDITIONS NOTE - APPROVING AUTHORITIES SHOULD USE SEPARATE SHEET IF NEEDED Health Dept. Needs to Get Water Sample During Yield Test			

Well Permit No. HO - 95-0610
Location of property (road) Sweet Meadow Lane
Subdivision Walnut Grove Lot 71 Block Plat Sec.
Well Driller Ralph Mayne Owner DeFrancis

Depth of well 90
Distance of measuring point (M.P.) above ground 1'
Static water level (S.W.L.) below M.P. 15'

Time pump started 10:15 Pumping rate 20 gpm.
Total time 0 min to reach pumping water level 15 ft. below M.P.

[illegible]

**HOWARD COUNTY HEALTH DEPARTMENT
BUREAU OF ENVIRONMENTAL HEALTH
WATER AND SEWERAGE PROGRAM
TEL: (410)313-2640 FAX: (410)313-2648**

Information Form for the Installation of the Well Pump, Pitless Adapter, and Supply Piping

NOTE: The installer is responsible for requesting an inspection prior to 9 am on the day of the desired inspection. No work is to be covered until approved by the Health Department. All installations must comply with the National Standard Plumbing Code (NSPC, as amended locally) and COMAR 26.04.04 (MD Well Construction Regulations). Submission of a complete form is required prior to Use and Occupancy approval.

Company Name: NATIONAL WATER SERVICE Telephone #: 301-854-1333
Address: P.O. Box 138
Ashton, MD 20841

(Must circle one) Licensed Plumber Licensed Well Driller Licensed Well Pump Installer

License # and name of individual responsible for the field installation:

Name (Print): DAVID RYCKE License# PI 0145

*A licensed individual must perform the actual installation. Apprentices must be under the direct supervision of a licensed journeyman or master plumber, pump installer or well driller. Licenses may be subjected to field verification.

Name of Property Owner: Sidridge Builders Telephone #: 410-531-8930

Subdivision: WALNUT GROVE Lot #: 71 Well Tag #: HO - -

Site Address: 5219 SWEET MEADOW LN
CLARKSVILLE

Submersible Pump Data

Make: GRUNDFOS
Model #: 1530607-1P0
Pump Capacity 15 GPM
Well Yield: 20 GPM

Pitless Adapter

Make: CAMPBELL
Model #: PA-100
Depth: 48 (36" min)
NSF approved: YES

Well Cap and Electric Conduit

Two piece watertight cap: ☒
Screened, vented well cap: ☒
Cap secured to casing: ☒
Conduit min 18" B.G.: ☒
Conduit secured to well cap: ☒

Depth of well encountered at time of pump installation: 90 (feet)

If pump capacity exceeds well yield, a low water cut off switch is required by NSPC 1990 Section 17.8.4

Torque arrestors or Cable guards are required - Must circle one CPS

Safety rope, if used, attached to inside of well casing with eye bolt N/A

Piping to house

Type: POLY
PSI: 160 (160 psi min)
Depth of supply line: 48 (36" min)

House Connection

PVC sleeved to undisturbed soil at wall penetration: Yes
Approximate length of sleeve: 48"
Sleeve caulked and sealed properly: Yes

The water supply line is required to be at least ten feet from the septic tank, pump chamber, sewage piping, distribution box, drainfields, and sewage reserve area. If this cannot be accomplished, contact this office for approval prior to installation.

Signature of company representative responsible for installation

date

11/24/09

For Health Department Use Only - Not to be completed by Installer

Date Insp. Requested: _____

Date Insp. Approved: 2/27/09 BB

Inspection Data: Pitless adapter and water supply line at least 36" below grade

Two piece cap installed and attached to casing securely

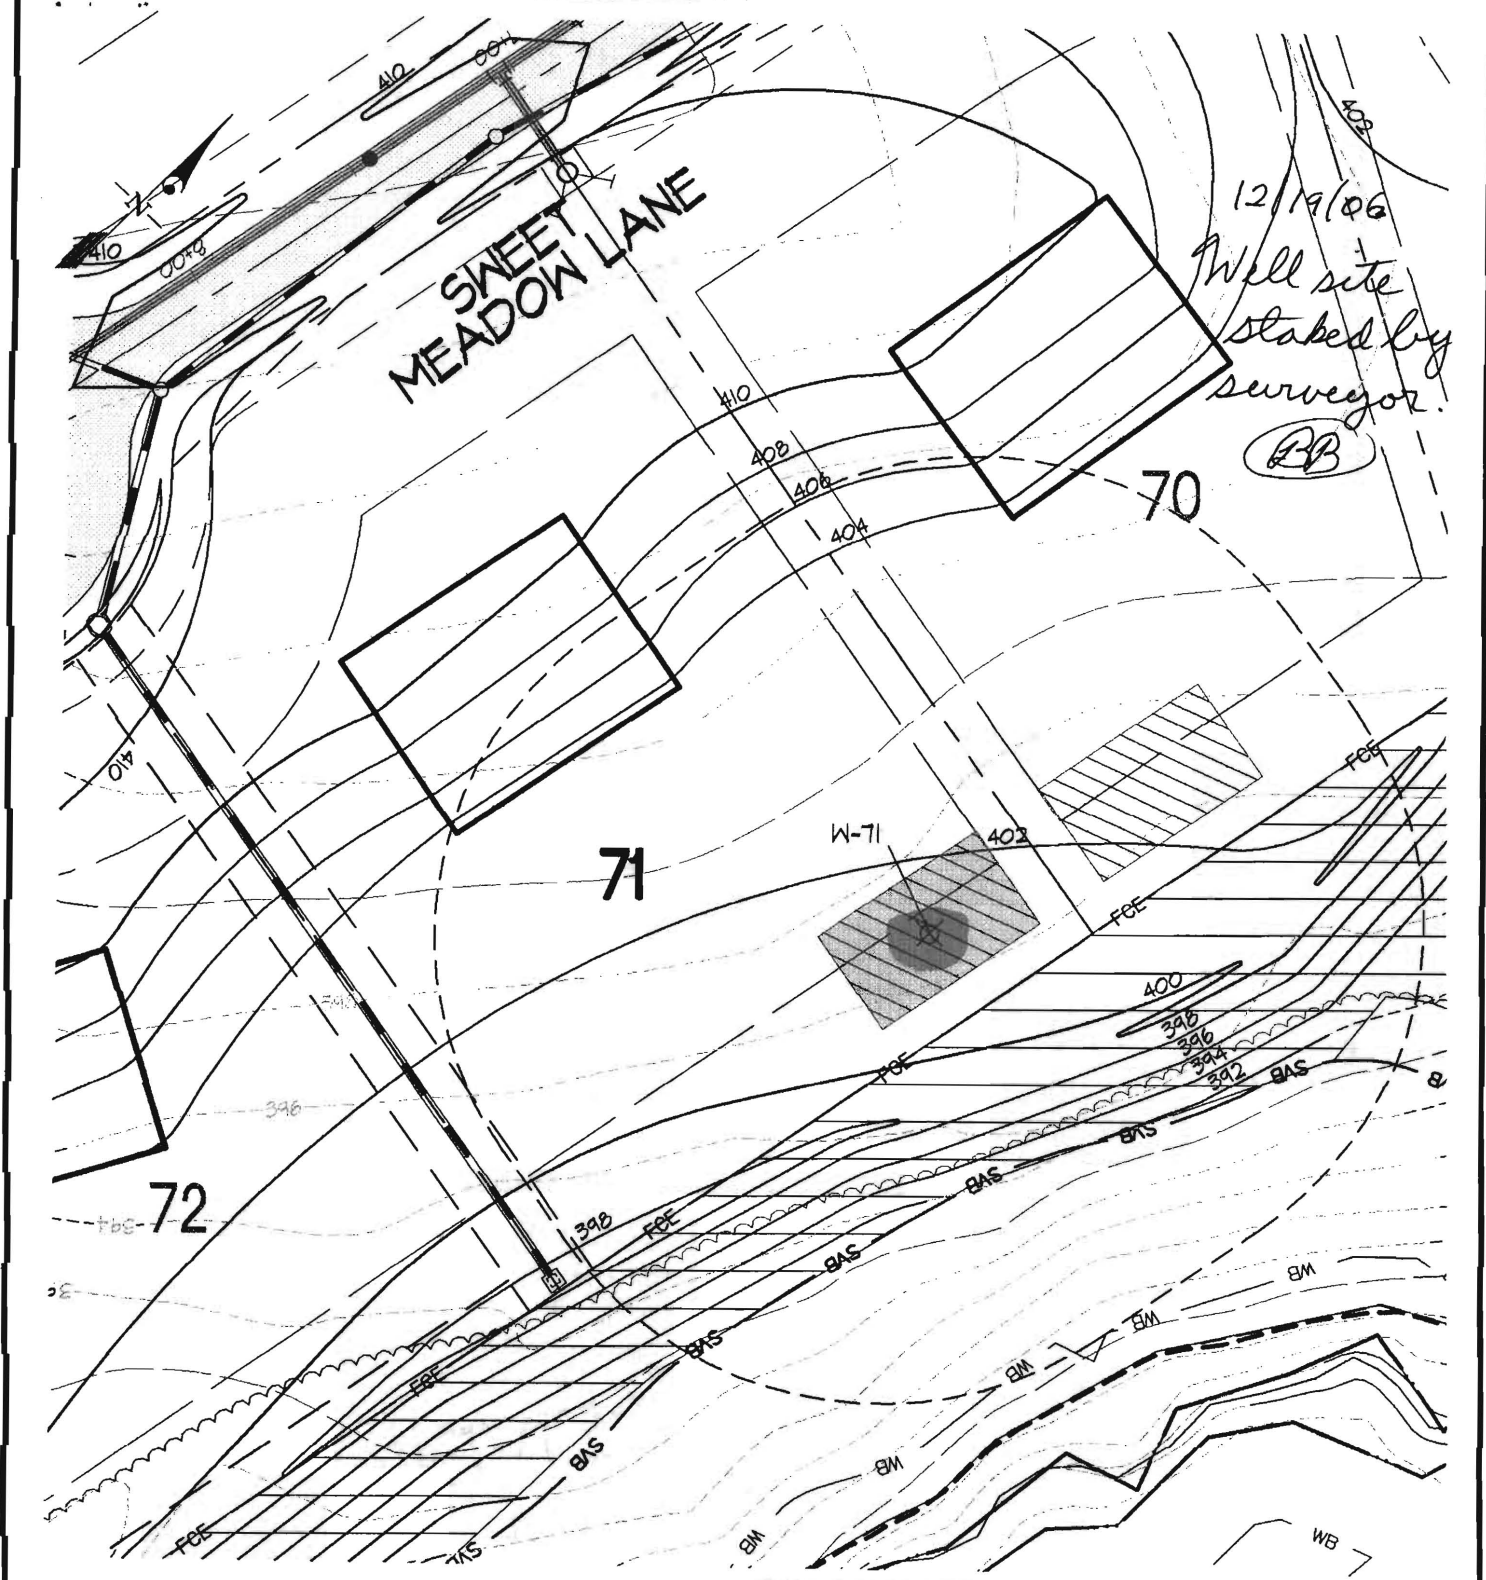
Elec. conduit extends at least 18" below grade/attached to cap properly

Safety rope installed inside of well casing

Correct well tag attached properly and casing 8" above finished grade

Water supply line sleeved adequately at house connection

Adequate grout observed below pitless adapter



LEGEND

- PROPOSED LPSS
- PROPOSED STORM DRAIN

HOUSE
BOX



WELL BOX

WELL
SURVEY POINT
W-05

WELL LOCATION EXHIBIT - LOT 71

WALNUT GROVE
Lots 1 thru 88, Buildable Preservation Parcel "A",
Non-Buildable Preservation Parcels "B" Thru "I" And
and Non-Buildable Bulk Parcel "J"

GLWGUTSCHICK LITTLE & WEBER, P.A.

CIVIL ENGINEERS, LAND SURVEYORS, LAND PLANNERS, LANDSCAPE ARCHITECTS
3909 NATIONAL DRIVE - SUITE 250 - BURTONSVILLE OFFICE PARK
BURTONSVILLE, MARYLAND 20866
TEL: 301-421-4024 BALT: 410-880-1820 DC/VA: 301-989-2524 FAX: 301-421-4186

SCALE: 1"=50'

ZONING: RC/RR-DEO

TAX MAP/GRID: 28-18/17

GLW JOB NO: 00153

OCT., 2006

1 OF 1



Howard County
Health Department

7178 Columbia Gateway Dr., Columbia, MD 21046
(410) 313-2640 Fax (410) 313-2648
TDD (410) 313-2323 Toll Free 1-866-313-6300
website: www.hchealth.org

Penny E. Borenstein, M.D., M.P.H., Health Officer

TO ALL INTERESTED PARTIES

When submitting a well application for a proposed well for new construction, please indicate one of the following:

Well Site Location:

Walnut Grove

71

Sweet Meadow Lane

Subdivision/Property Name

Lot #

Road Name

- ☒ Staking to take place after initial review (as discussed with Bob Weber).
- ☐ The well site has been staked by _____ ,
(professional land surveyor or company employing professional land surveyors)
on _____ (date) and does not require a site inspection.
- ☐ The well driller, builder or property owner will call the Health Department to schedule a time to meet in the field to verify the proposed well site location.

This sheet, along with two copies of an acceptable well site plan, must be attached to the green well permit application.

Revised 3/11/05



Howard County
Health Department

Bureau of Environmental Health
7178 Gateway Drive Columbia, MD 21046
(410) 313-2640 Fax (410) 313-2648
TDD (410) 313-2323 Toll Free 1-866-313-6300
website: www.hchealth.org

Peter Beilenson, M.D., M.P.H., Health Officer

March 15, 2010

Homeowner
5219 Sweet Meadow Lane
Clarksville, MD 21029

RE: Walnut Grove, Lot 71
5219 Sweet Meadow Lane
BP # B08003282
Well Tag: HO-95-0610

Dear Sirs:

This is to advise that the septic house connection and grinder pump installation for the referenced property has been installed and inspected. **Final approval was granted on 03/15/2010. Final approval of the well line connection to the dwelling was approved on 02/27/2009.**

The water sample results indicate that the water samples submitted for testing were free of coliform and fecal coliform bacteria at the time of sampling and are bacteriologically safe for drinking. The water sample results were found to be in compliance with COMAR water quality standards. Enclosed with this certificate is a copy of the septic permit and the as-built along with information on your well and how to keep your water supply safe.

Gross Alpha and Beta samples were also collected on 03/26/2007. Both findings were below the maximum limit suggested by the EPA. At the time of the testing and with respect to these parameters, the future well water supply appears safe for all uses. No additional testing **for these parameters** will be required to secure the future Use and Occupancy.

Enclosed with this certificate is a copy of the septic permit and the as-built along with important information regarding the use and maintenance of your septic system. Please read through carefully and thoroughly. Any questions regarding your well and/or septic, please call this office for guidance 410-313-1771.

INTERIM CERTIFICATE OF POTABILITY

This certifies that the **initial** sampling requirements of COMAR 26.04.04 "Well Regulations" have been met for the water supply system installed under well permit #HO-95-0610. Although the submitted sample results are in compliance with COMAR standards, the Health Department does not guarantee water supplies. Based upon satisfactory investigation and evaluation, the Howard County Health Department, as authorized by the Maryland Department of the Environment accepts this well system as required by COMAR 26.04.04.

This certificate may become final upon completion of the second bacteriological test, which is to be taken by the county health department within six months of receipt of this letter. **Please contact (410) 313-1773 to schedule a final water sample appointment. Currently, there is no charge for this final sampling.**

Date of Water Sample: 01/29/2010
Date of Gross Alpha and Gross Beta Samples: 03/26/2007
Date of Well Completion: 03/26/2007

Respectfully,

A handwritten signature in dark ink, appearing to read "Kevin Wolf", with a long horizontal flourish extending to the right.

Kevin Wolf, Sanitarian
Well and Septic Program

cc: Building Inspectors Office
Community Environmental Health
File



TRACE LABORATORIES, INC
A Methode Electronics, Inc. Company
5 North Park Drive
Hunt Valley, MD 21030 USA
Telephone: 410/584-9099 / Fax: 410/584-9117
Website: www.tracelabs.com / Email: info@tracelabs.com

Maryland State Certified Laboratory # 318

CERTIFICATE OF ANALYSIS

Requester:

James H. Selfridge Builders, Inc
Attn: Bob
4781 Ten Oaks Road
Dayton, Maryland 21036

S/O Number: 75563**Report Date:** February 1, 2010**Property Sampled:** 5219 Sweet Meadow Lane, 21036**County:** Howard**Subdivision:** Walnut Grove**Tax Map #:** 28**Lot #:** 71**Parcel #:** 74**Building Permit #:** B08003282**Date/Time Collected:** January 29, 2010 at 10:38 am**Date/Time Received:** January 29, 2010 at 2:00 pm**Sample Location:** Pressure Tank**Sampler ID:** 5745KC**Samples Iced:** Yes**Residual Cl₂ <0.1 mg/L:** Yes**Well Tag Number:** HO-95-0610**Well Condition:** 2-Piece Cap
Satisfactory**Water Conditioning/Treatment:** Neutralizer, Softener, Sediment Filter

PARAMETER	RESULT	METHOD	MCL/*SMCL	
Nitrate	9.7 mg/L as N	SM 4500D	10 mg/L as N	Pass
Turbidity	1.2 NTU	EPA 180.1	10 NTU	Pass
pH	7.7 Units	EPA 150.1	*6.5-8.5 Units	***
Sand	Negative		Negative	
Total Coliform	Absent	SM 9223B	Absent	Pass
E.coli	Absent	SM 9223B	Absent	Pass

Allison R. Milburn
Manager-Drinking Water Testing

MCL=Maximum Contamination Level

*SMCL=Secondary Maximum Contamination Level

***A non-enforceable parameter that may cause cosmetic effects or aesthetic effects (such as taste, color or odor) in drinking water.



Bureau of Environmental Health
7178 Columbia Gateway Drive, Columbia, MD 21046-2147
(410) 313-2640 Fax (410) 313-2648
TDD (410) 313-2323 Toll Free 1-866-313-6300
website: www.hchealth.org

Peter L. Beilenson, M.D., M.P.H., Health Officer

April 6, 2007

Walnut Grove, LLC
10705 Charter Drive
Suite 320
Columbia, Maryland 21044

RE: Walnut Grove Subdivision, Lot 71
Well Tag: HO - 95 - 0610

To Whom It May Concern:

A sample was collected during a yield test on March 26, 2007 and submitted to GPL Laboratories to assess the possible presence of **Gross Alpha** and **Gross Beta** in the future well water supply. **Gross Alpha** and **Gross Beta** (GAGB), measure the total alpha and beta particle activity in a water supply. These naturally occurring radioactive nuclides have been demonstrated to be present in a certain type of geologic formation known as the Baltimore Gneiss which exists in your area of development within the County.

Results from this screening revealed a **Gross Alpha** of 0.4 ± 0.5 picocuries/liter (pCi/L); while the **Gross Beta** level was 2.4 ± 0.9 pCi/L. The **Gross Alpha** result was below its maximum contaminant level (MCL) of 15 pCi/L, while the **Gross Beta** level was below its target value of 50 pCi/L (roughly equivalent to the annual dose rate of 4 millirem/year).

At the time of testing and with respect to these parameters, the future well water supply appears safe for all uses. No additional testing for these parameters will be required to secure the future Use & Occupancy. However, other standard (potability) testing will still be necessary.

A copy of the test results is enclosed for your information. Please call this office at (410) 313 - 1773 if you have any further questions or concerns.

Sincerely,

Bert Nixon, Deputy Director
Bureau of Environmental Health

cc: Eric Dougherty, MDE Water Mgmt., Groundwater
✓ Well & Septic property file

Send Report To:

State of Maryland
DHMH - Laboratories Administration
Division of Environmental Chemistry
RADIATION LABORATORY

201 W. Preston Street, Baltimore, Maryland 21201

John M. DeBoy, Dr. P.H., Director

LABORATORY ANALYSIS REQUEST

WG71BB950610

Sample Bottle No. A: _____ No. B: _____ Field Blank Bottle No. A: _____ No. B: _____

Plant/Site Name: Walnut Grove - Lot 71 County: _____

Sample Source: Sweet Meadow Lane Location: H0-95-0610
(well no., lab sink, sample tap, etc.)

County: ☐ ☐ Plant No. ☐ ☐ ☐ ☐ ☐ ☐ ☐ ☐ ☐ ☐

CHECK (one per box)

Drinking Water ☒
Landfill ☐
Stream ☐
Other ☐

Community ☐
Non-community ☐
Private ☒
Other ☐

Source (raw water) ☒
Distribution (treated) ☐
MCL ☐

Emergency ☐
Routine ☒
Recheck ☐
Special ☐

Collector: Brian Baker

Telephone No: x2643

Date Collected: 3 / 26 / 2007

Time Collected: _____ a.m. 1:00 p.m.

Nitric Acid Preserved: Yes ☒ No ☐

Iced: Yes ☐ No ☒

Submitters Code: ☐ ☐ Federal Project: ☐ Field Data: _____

Remarks: Sample Collected During Yield Test pH _____ Chlorine _____

✓	Test	EPA Code	Laboratory No.	Results (pCi/L)	Date Reported
✓	Gross Alpha	4000	<u>703208-008</u>	<u>0.4 ± 0.5</u>	<u>4/2/07</u>
✓	Gross Beta	4100		<u>2.4 ± 0.9</u>	
	Radon-222 Bottle A	4004			
	Radon-222 Bottle B	4004			
	Field Blank A	4004			
	Field Blank B	4004			
	Tritium				
	Ra - 226	4020			
	Ra - 228	4030			
	Total Uranium	4006			

Date Received: _____ / _____ / _____

Supervisor: _____

Analytical Summary Report

Client Name:	Howard County Health Department	Client Sample ID:	WG75BB950611
Receipt Date/Time:	3/15/2007	Lab Sample ID:	703105-007-007-1/1
Prepared Date/Time:	3/16/2007	Sample Matrix:	WATER
Analysis Date/Time:	3/19/2007 3:46:00 PM	Analytical Method:	ALPHA/BETA BY METHOD 900.0

Isotope	Result	Uncertainty 2σ	MDA	Q
Gross Alpha	1.37 pCi/L	± 0.7 pCi/L	0.88 pCi/L	
Gross Beta	2.9 pCi/L	± 0.88 pCi/L	1.55 pCi/L	