TAX ID 06-431437

DEPARTMENT OF INSPECTIONS, LICENSES AND PERMITS
3430 COURT HOUSE DRIVE
ELLICOTT CITY, MD 21043
PERMITS (410) 313-2455 INSPECTIONS (410) 313-1810
AUTOMATED INFORMATION (410) 313-3800

# HOWARD COUNTY PERMIT APPLICATION

PERMIT NUMBER B00156533

Building Address 9120 RIVERHILL RD Laurel, MD 20723

Suite/Apt. #: _____ SDP/WP/Petition #: _____

Census Tract _____ Subdivision _____

Section _____ Area _____ Lot _____

Tax Map 50 Parcel 429 Grid _____

Zoning RSC Map Coordinates Lot size

Property Owner's Name Kenneth & Lisa Ecker

Address 9120 RIVERHILL RD

City Laurel State MD Zip Code 20723

Home Phone 301-362-3301 Work Phone 301-466-4967

Applicant's Name & Mailing Address, (if other than stated hereon):

Phone Fax

Existing Use GRASS

Proposed Use FRONT PORCH

Estimated Construction Cost $ 2000.00

Description of Work FRONT Porch made w/ Concrete floor and covered.

Contractor Company _____

Contact Person _____

Address _____

City _____ State _____ Zip Code _____

License No. _____

Phone Fax

Occupant or Tenant Occupant

Contact Name Kenneth Ecker

Address 9120 RIVERHILL RD

City Laurel State MD Zip Code 20723

Phone 301-362-3301 Fax

Engineer or Architect Company _____

Contact Person _____

Address _____

City _____ State _____ Zip Code _____

Phone Fax

## BUILDING DESCRIPTION - *COMMERCIAL*

### Building Characteristics

Height:

No. of stories:

Gross area, sq. ft. per floor:

Use group:

Construction type:
_____ Reinforced Concrete
_____ Structural Steel
_____ Masonry
_____ Wood Frame

_____ State Certified Modular

### Utilities

Water Supply:
____ Public
____ Private
Sewage Disposal:
____ Public
____ Private

Electric Yes ☐ No ☐
Gas Yes ☐ No ☐

Heating System:
Electric ☐ Oil ☐
Natural Gas ☐
Propane Gas ☐

Sprinkler system: N/A ☐
____ Full
____ Partial
____ Other Suppression
____ # of Heads

## BUILDING DESCRIPTION - *RESIDENTIAL*

### Building Characteristics

SF Dwelling ☐ SF Townhouse ☐

| | Depth | Width |
|---|---|---|
| 1st floor: | | |
| 2nd floor: | | |
| Basement: | | |

Finished Basement ☐ Unfinished Basement ☐
Crawl space ☐ Slab on Grade ☐
No. of Bedrooms _____
Height: _____
Multi-family dwellings:
No. of efficiency units: _____
No. of 1 BR units: _____
No. of 2 BR units: _____
No. of 3 BR units: _____

Other Structure: _____
Dimensions: _____
Footings: _____
Roof Height: _____

_____ State Certified Modular
_____ Manufactured Home

### Utilities

Water Supply:
____ Public
____ Private
Sewage Disposal:
____ Public
____ Private

Electric Yes ☐ No ☐
Gas Yes ☐ No ☐

Heating System:
Electric ☐ Oil ☐
Natural Gas ☐
Propane Gas ☐

Sprinkler system: N/A ☐
_____ NFPA #13D
_____ NFPA #13R
_____ Other:

THE UNDERSIGNED HEREBY CERTIFIES AND AGREES AS FOLLOWS: (1) THAT HE/SHE IS AUTHORIZED TO MAKE THIS APPLICATION; (2)THAT THE INFORMATION IS CORRECT; (3) THAT HE/SHE WILL COMPLY WITH ALL REGULATIONS OF HOWARD COUNTY WHICH ARE APPLICABLE THERETO; (4) THAT HE/SHE WILL PERFORM NO WORK ON THE ABOVE REFERENCED PROPERTY NOT SPECIFICALLY DESCRIBED IN THIS APPLICATION; (5) THAT HE/SHE GRANTS COUNTY OFFICIALS THE RIGHT TO ENTER ONTO THIS PROPERTY FOR THE PURPOSE OF INSPECTING THE WORK PERMITTED AND POSTING NOTICES.

Kenneth Ecker
*Applicant's Signature*

Kenneth Ecker
*Print Name*

*Title/Company*

10/13/05
*Date*

Checks payable to: ***DIRECTOR OF FINANCE OF HOWARD COUNTY***

** PLEASE WRITE NEATLY AND LEGIBLY. **

***- FOR OFFICE USE ONLY -***

| AGENCY | DATE | SIGNATURE APPROVAL |
|---|---|---|
| Land Development, DPZ | | |
| State Highways | | |
| Building Official | | |
| Dev. Engineering, DPZ | | |
| Health | 10/13/05 | |
| Fire Protection | | |

Is Sediment Control approval required prior to issuance?
YES ☐ NO ☐

CONTINGENCY CONSTRUCTION START: ☐
ONE STOP SHOP: ☐

**DPZ SETBACK INFORMATION**

Front: _____
Rear: _____
Side: _____
Side St.: _____

All minimum setbacks met?
YES ☐ NO ☐

Is Entrance Permit required?
YES ☐ NO ☐

Historic District?
YES ☐ NO ☐

Lot Coverage for NewTown Zone _____

SDP/Red-line approval date _____

| PROPERTY ID#: | |
|---|---|
| Filing fee | $ |
| Permit fee | $ |
| Excise tax | $ |
| Add'l per. fee | $ |
| TOTAL FEES | $ |
| Sub-total paid | $ |
| Balance due | $ |
| Check | # |
| Validation | # |

Accepted by _____

Distribution of Copies- White: Building Official Green: LDD, DPZ Yellow: DED, DPZ Pink: Health Gold: SHA

T:\forms\PERMIT.FRM

Rev. 11/4/04

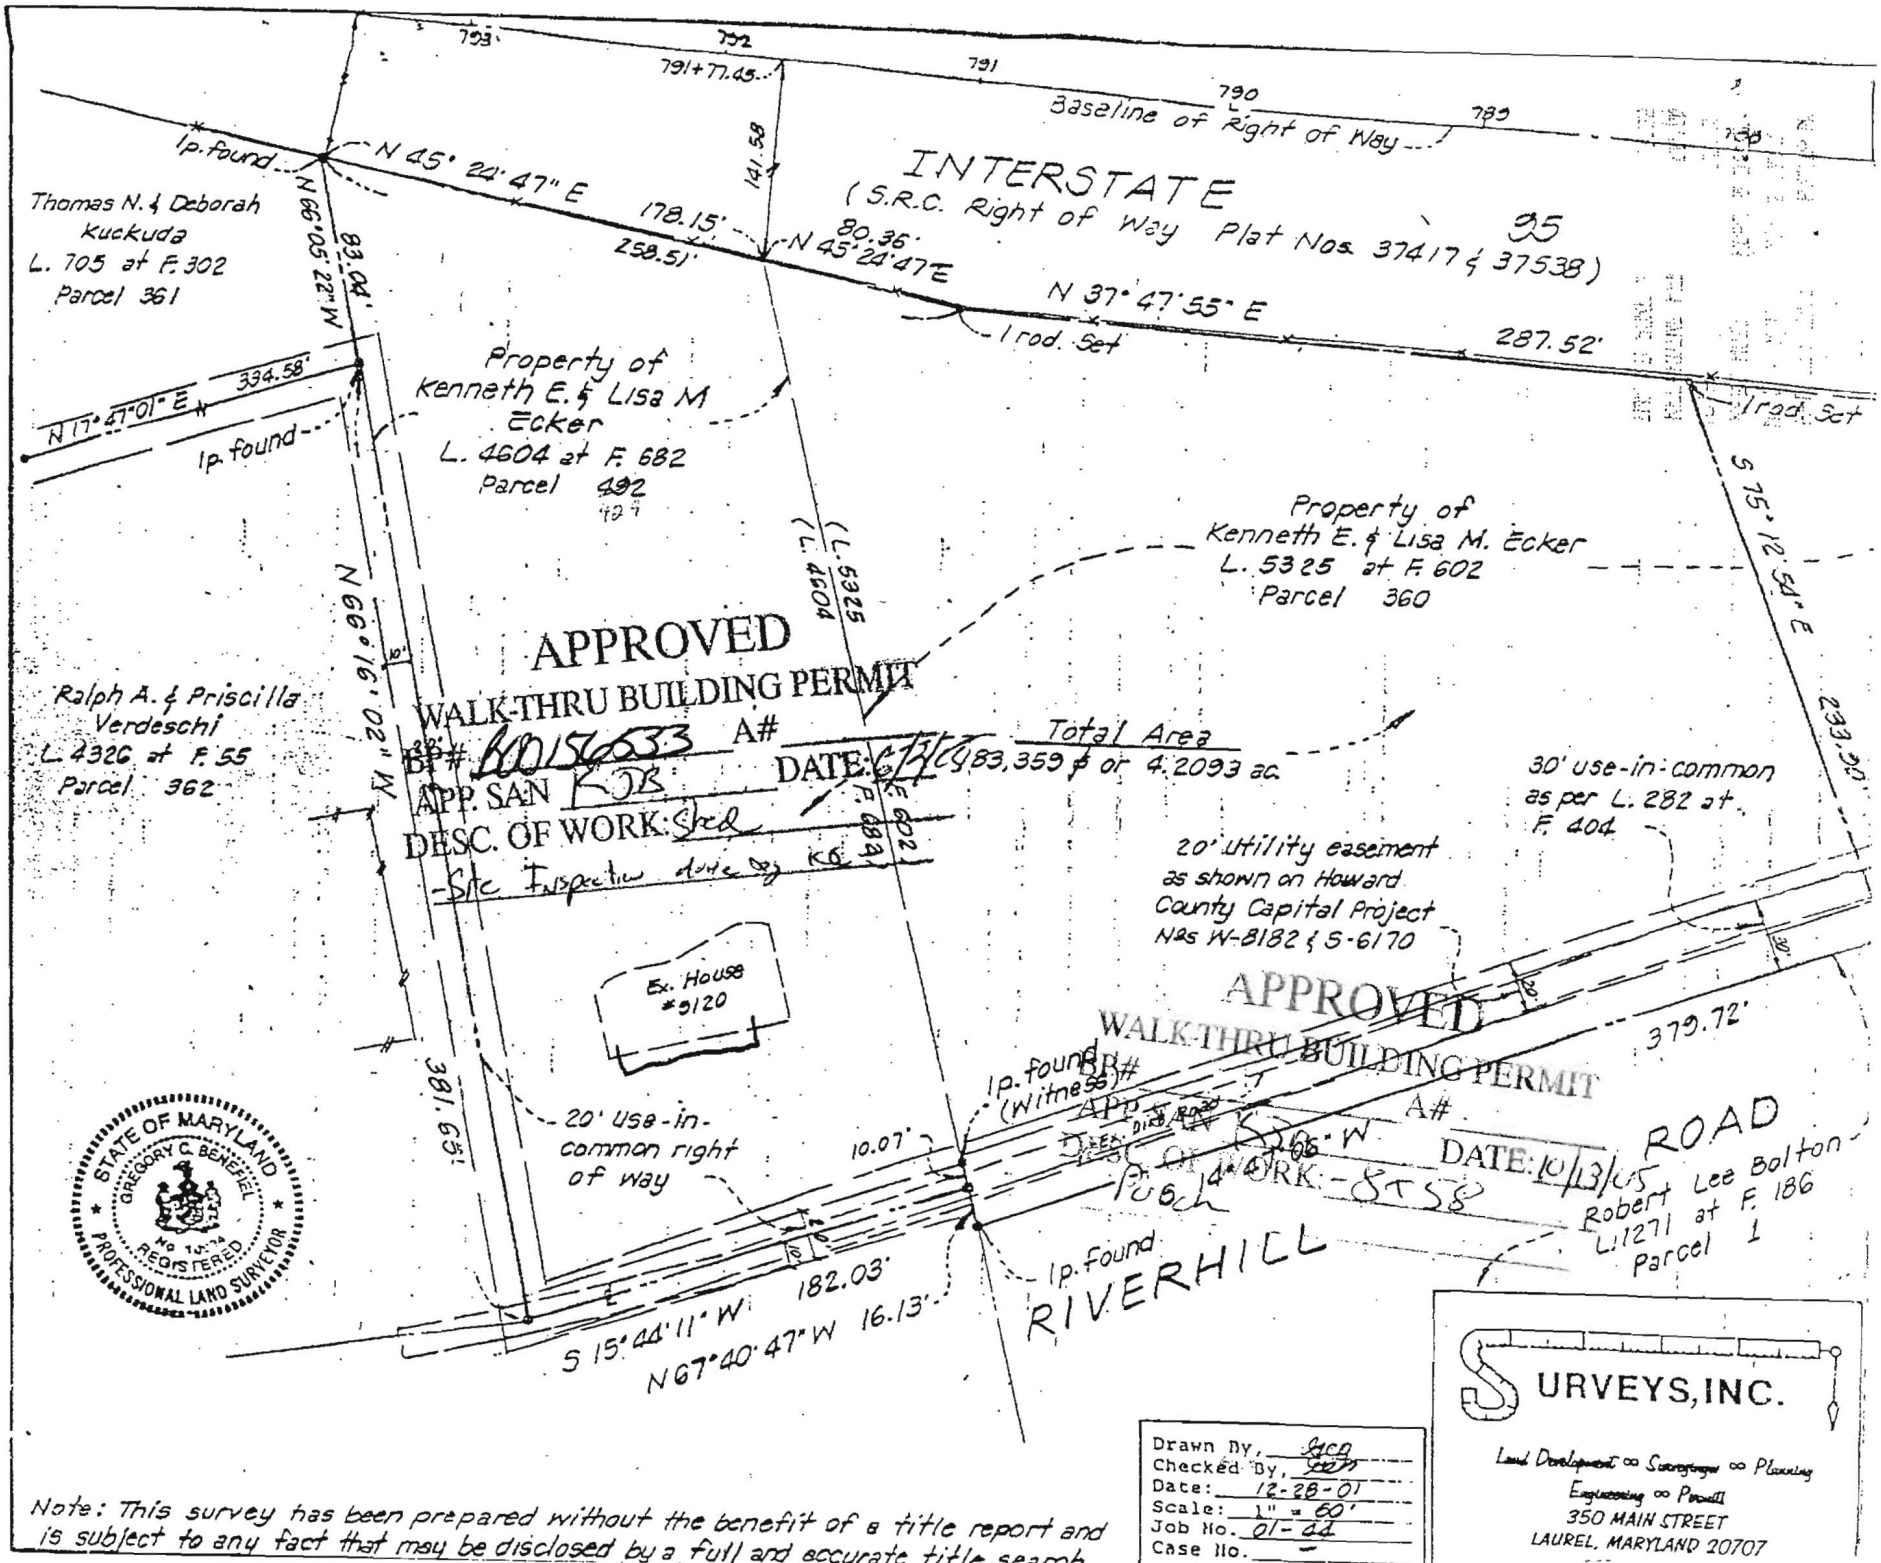


Drawn By: GCB
Checked By: GCB
Date: 12-28-01
Scale: 1" = 60'
Job No. 01-44
Case No. —

SURVEYS, INC.

Land Development ∞ Surveying ∞ Planning
Engineering ∞ Permits
350 MAIN STREET
LAUREL, MARYLAND 20707

Note: This survey has been prepared without the benefit of a title report and is subject to any fact that may be disclosed by a full and accurate title search.

EB 1169 PG 596