PRELIMINARY

APPLICATION

18534
A XXXXXX

P_____

SEWAGE DISPOSAL TESTING

STATE OF MARYLAND - DEPARTMENT OF HEALTH AND MENTAL HYGIENE

HOWARD COUNTY HEALTH DEPARTMENT
ENVIRONMENTAL HEALTH SERVICES
P. O. BOX 476, ELLICOTT CITY, MARYLAND 21043
TELEPHONE: 465-5000, EXT. 356

DISTRICT 3rd

DATE 5/25/73

TO: THE COUNTY HEALTH OFFICER
ELLICOTT CITY, MARYLAND

I, HEREBY, APPLY FOR THE NECESSARY TEST IN ORDER TO CONSTRUCT (OR RECONSTRUCT) A SEWAGE DISPOSAL SYSTEM.

PROPERTY OWNER Mr. Ray Bateman

ADDRESS 5525 Green Bridge Road, Dayton, Md. 21036 PHONE 531-5543

PROPERTY LOCATION:

SUBDIVISION _____ LOT NO. Parcel 2

ROAD AND DESCRIPTION Triadelphia Road

SIZE OF LOT 7 acres TYPE BLDG. 3 or 4 bedrooms
NUMBER OF BEDROOMS

IF NOT SINGLE RESIDENCE DESCRIBE _____

THE SYSTEM INSTALLED UNDER THIS APPLICATION IS ACCEPTABLE ONLY UNTIL PUBLIC FACILITIES BECOME AVAILABLE.

SIGNATURE OF APPLICANT /s/ Carolyn Bateman

APPROVED BY _____ FOR _____ DATE _____
(KIND OF SYSTEM)

REJECTED BY _____ FOR _____ DATE _____
(KIND OF SYSTEM)

HOLD PENDING FURTHER TESTS _____ DATE _____

REASONS FOR REJECTION OR HOLDING _____

THIS IS NOT A PERMIT

APPLICATION

	3			

INDICATE NORTH. — NAME ADJOINING ROADWAY AS BASE LINE.

DATE	TEST NO.	DEPTH	PRE-WET START	PRE-WET STOP	TEST - 1" DROP START	TEST - 1" DROP STOP	TIME
6/20/73	1	4½	10:27	10:30	10:30	10:42	12
	2	11	10:28	10:32	10:32	10:41	15
	3	10½	7/				
	4	4	10:44	10:45	10:48	10:57	9
	5	10½	10:39	10:41	10:41	10:48	7
DW site →	6	10½					

t = 11 min
125 #/ft
Inlet 3-41
Eff max @ H'

REMARKS

TYPE OF SOIL

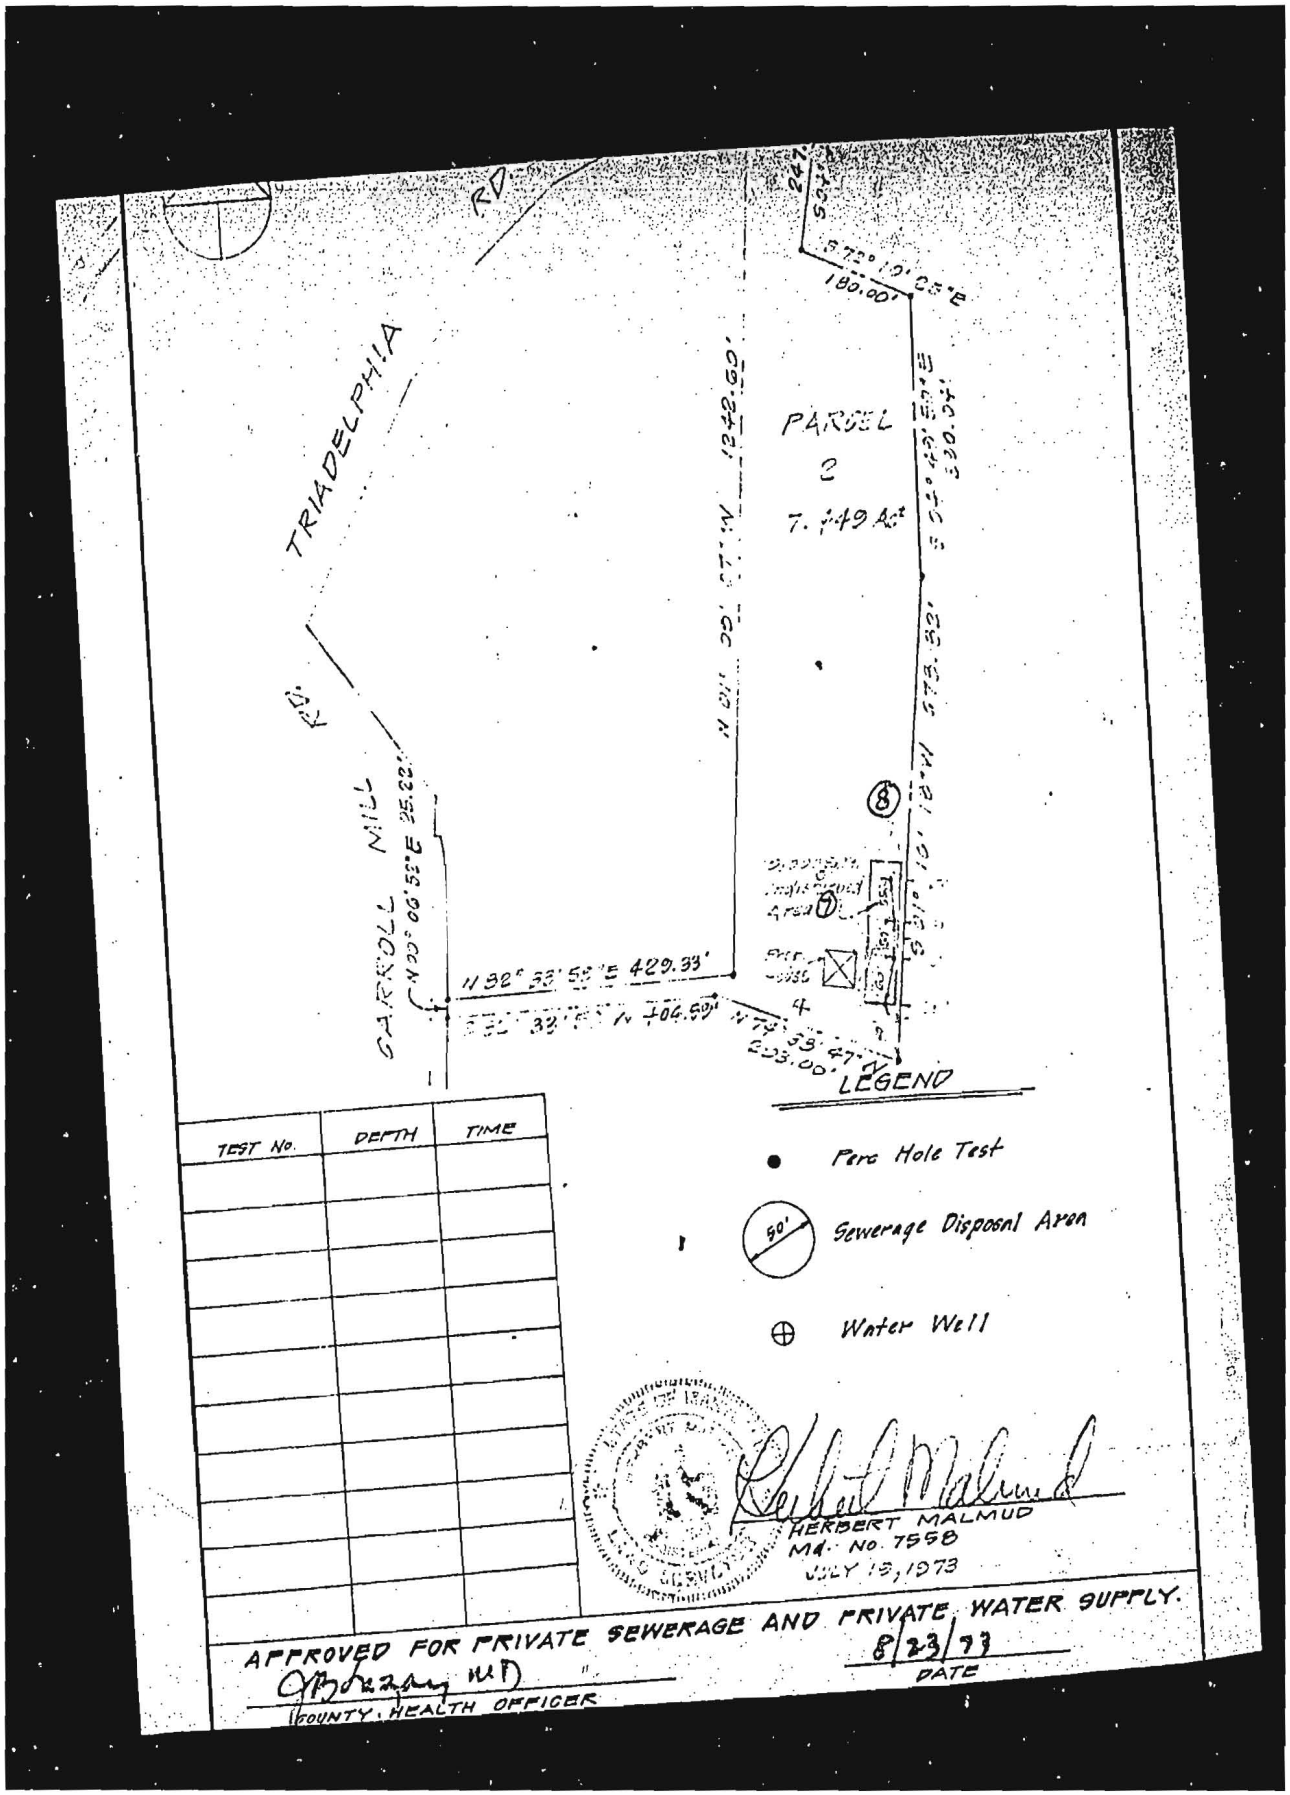

TEST No.	DEPTH	TIME

HERBERT MALMUD
MD. No. 7558
JULY 19, 1973

APPROVED FOR PRIVATE SEWERAGE AND PRIVATE WATER SUPPLY.

8/23/73
DATE

COUNTY HEALTH OFFICER