


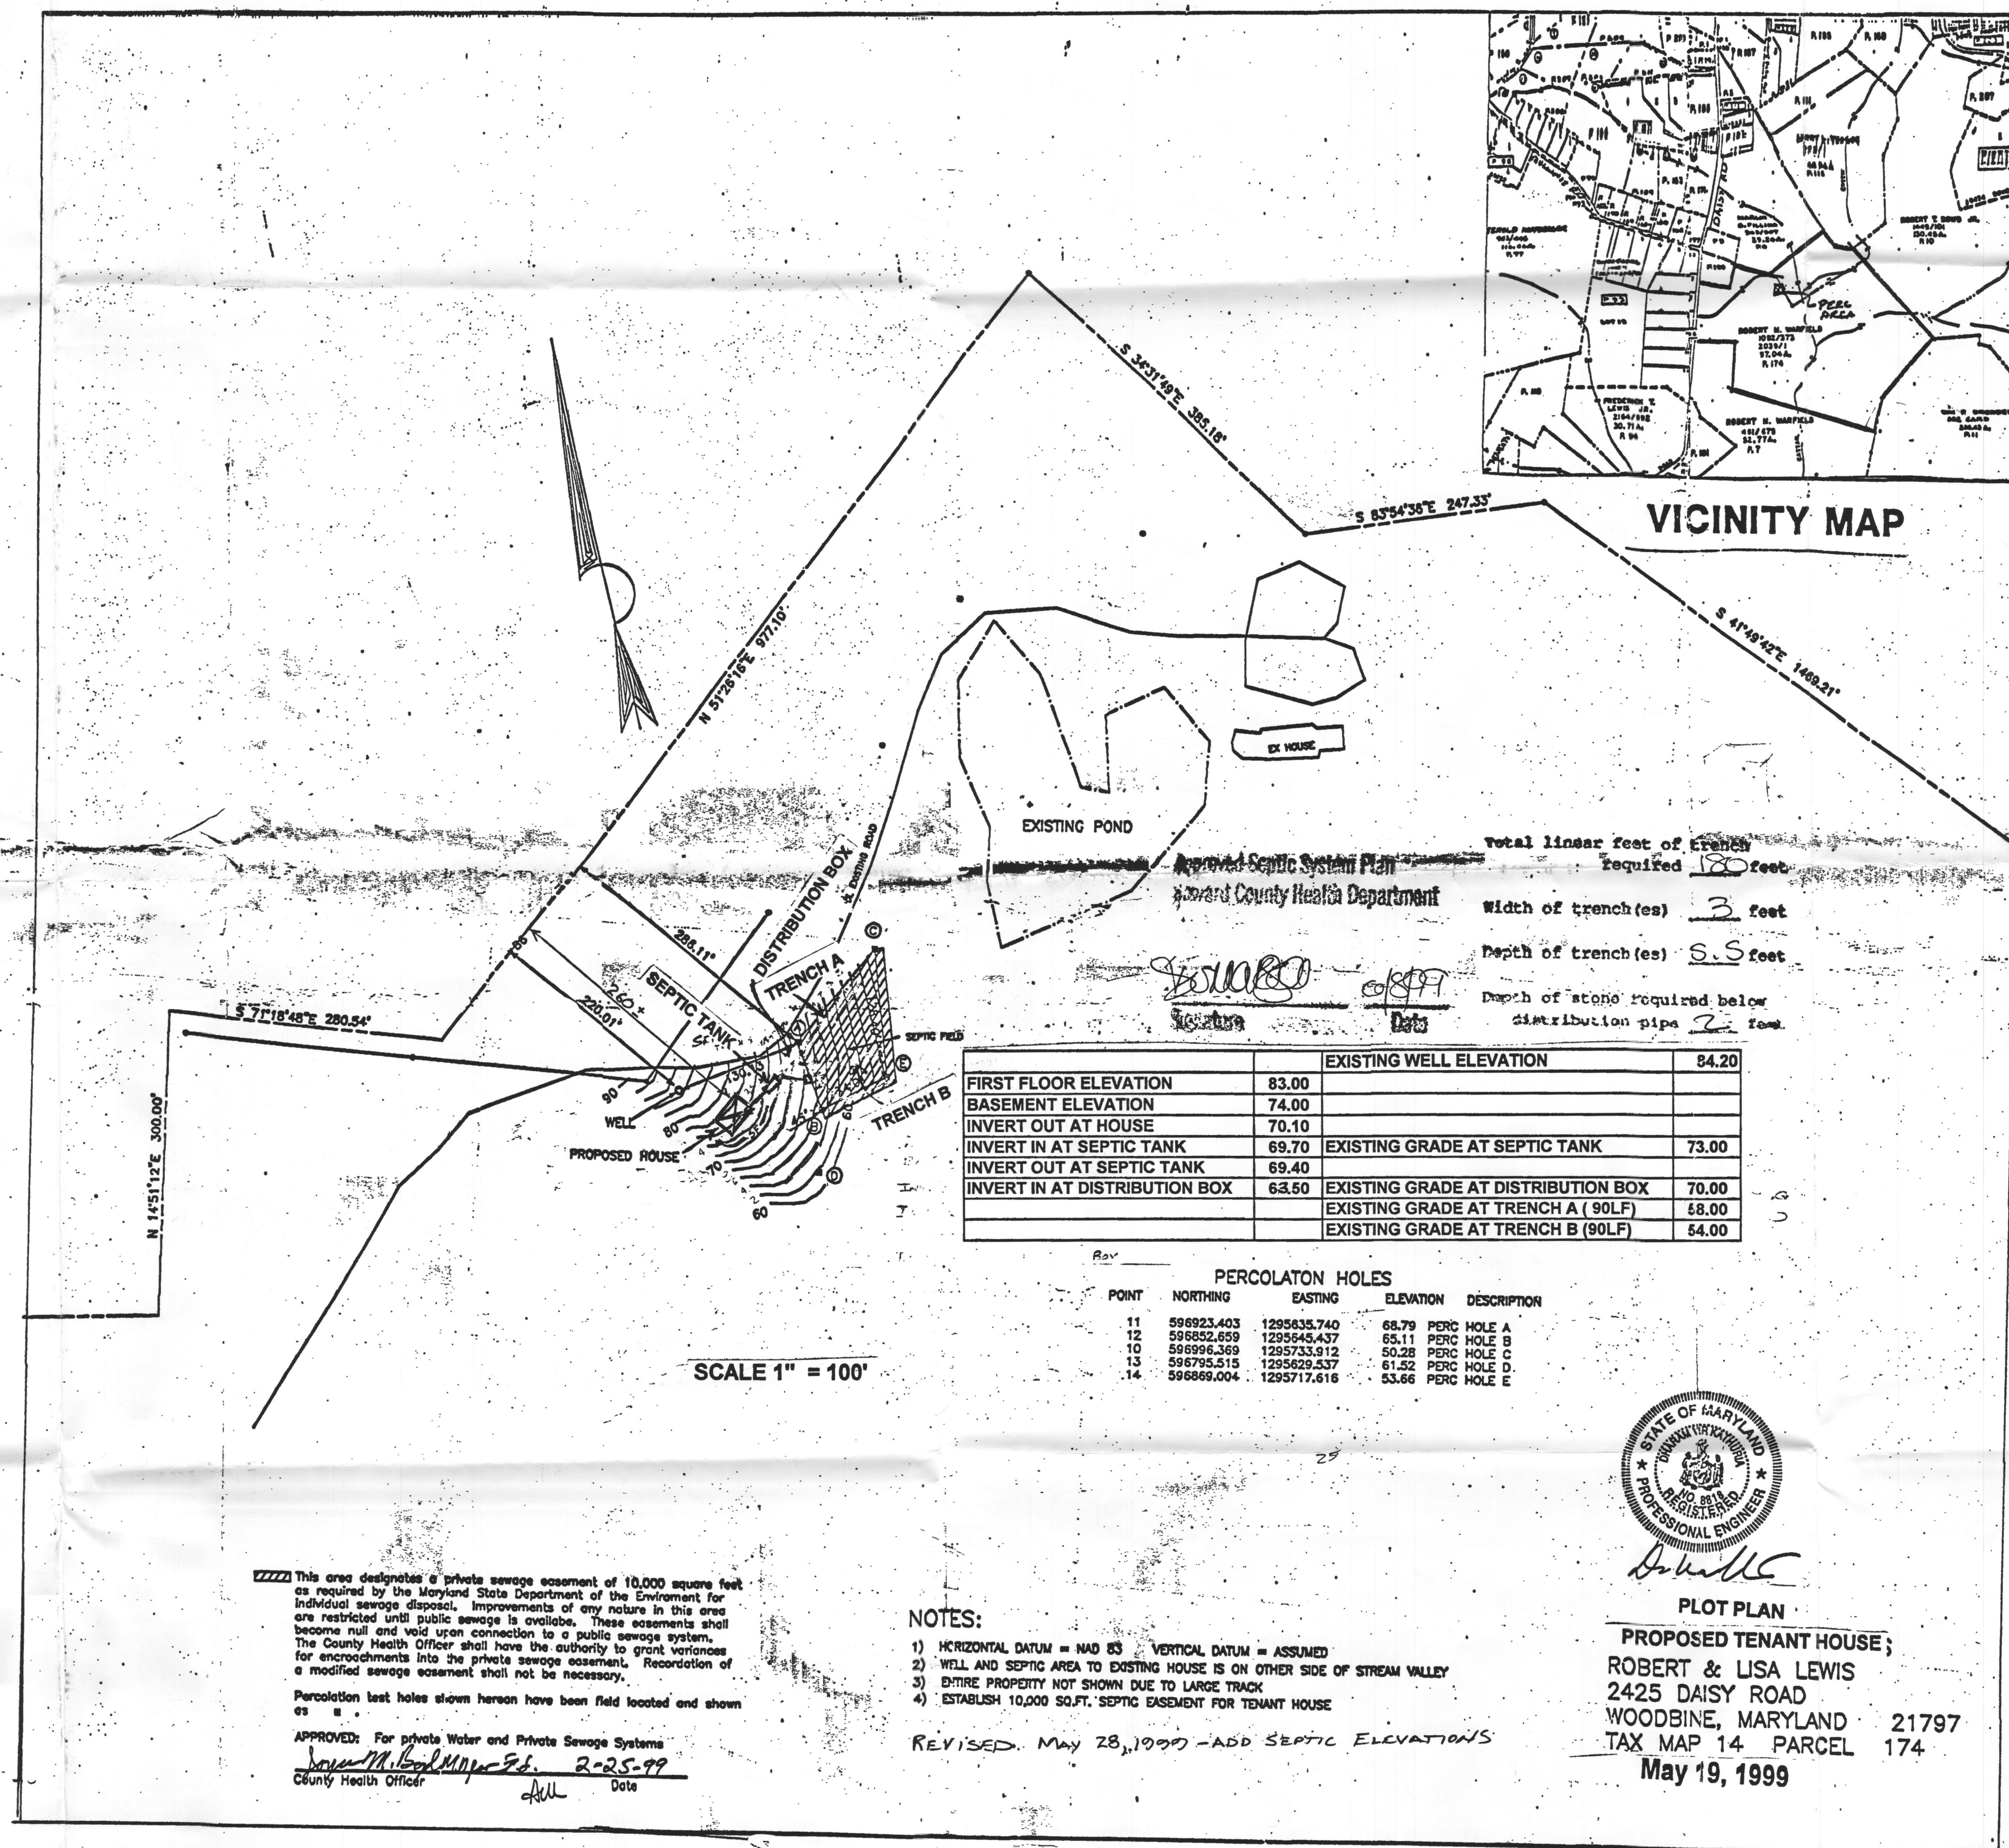

There is no approved