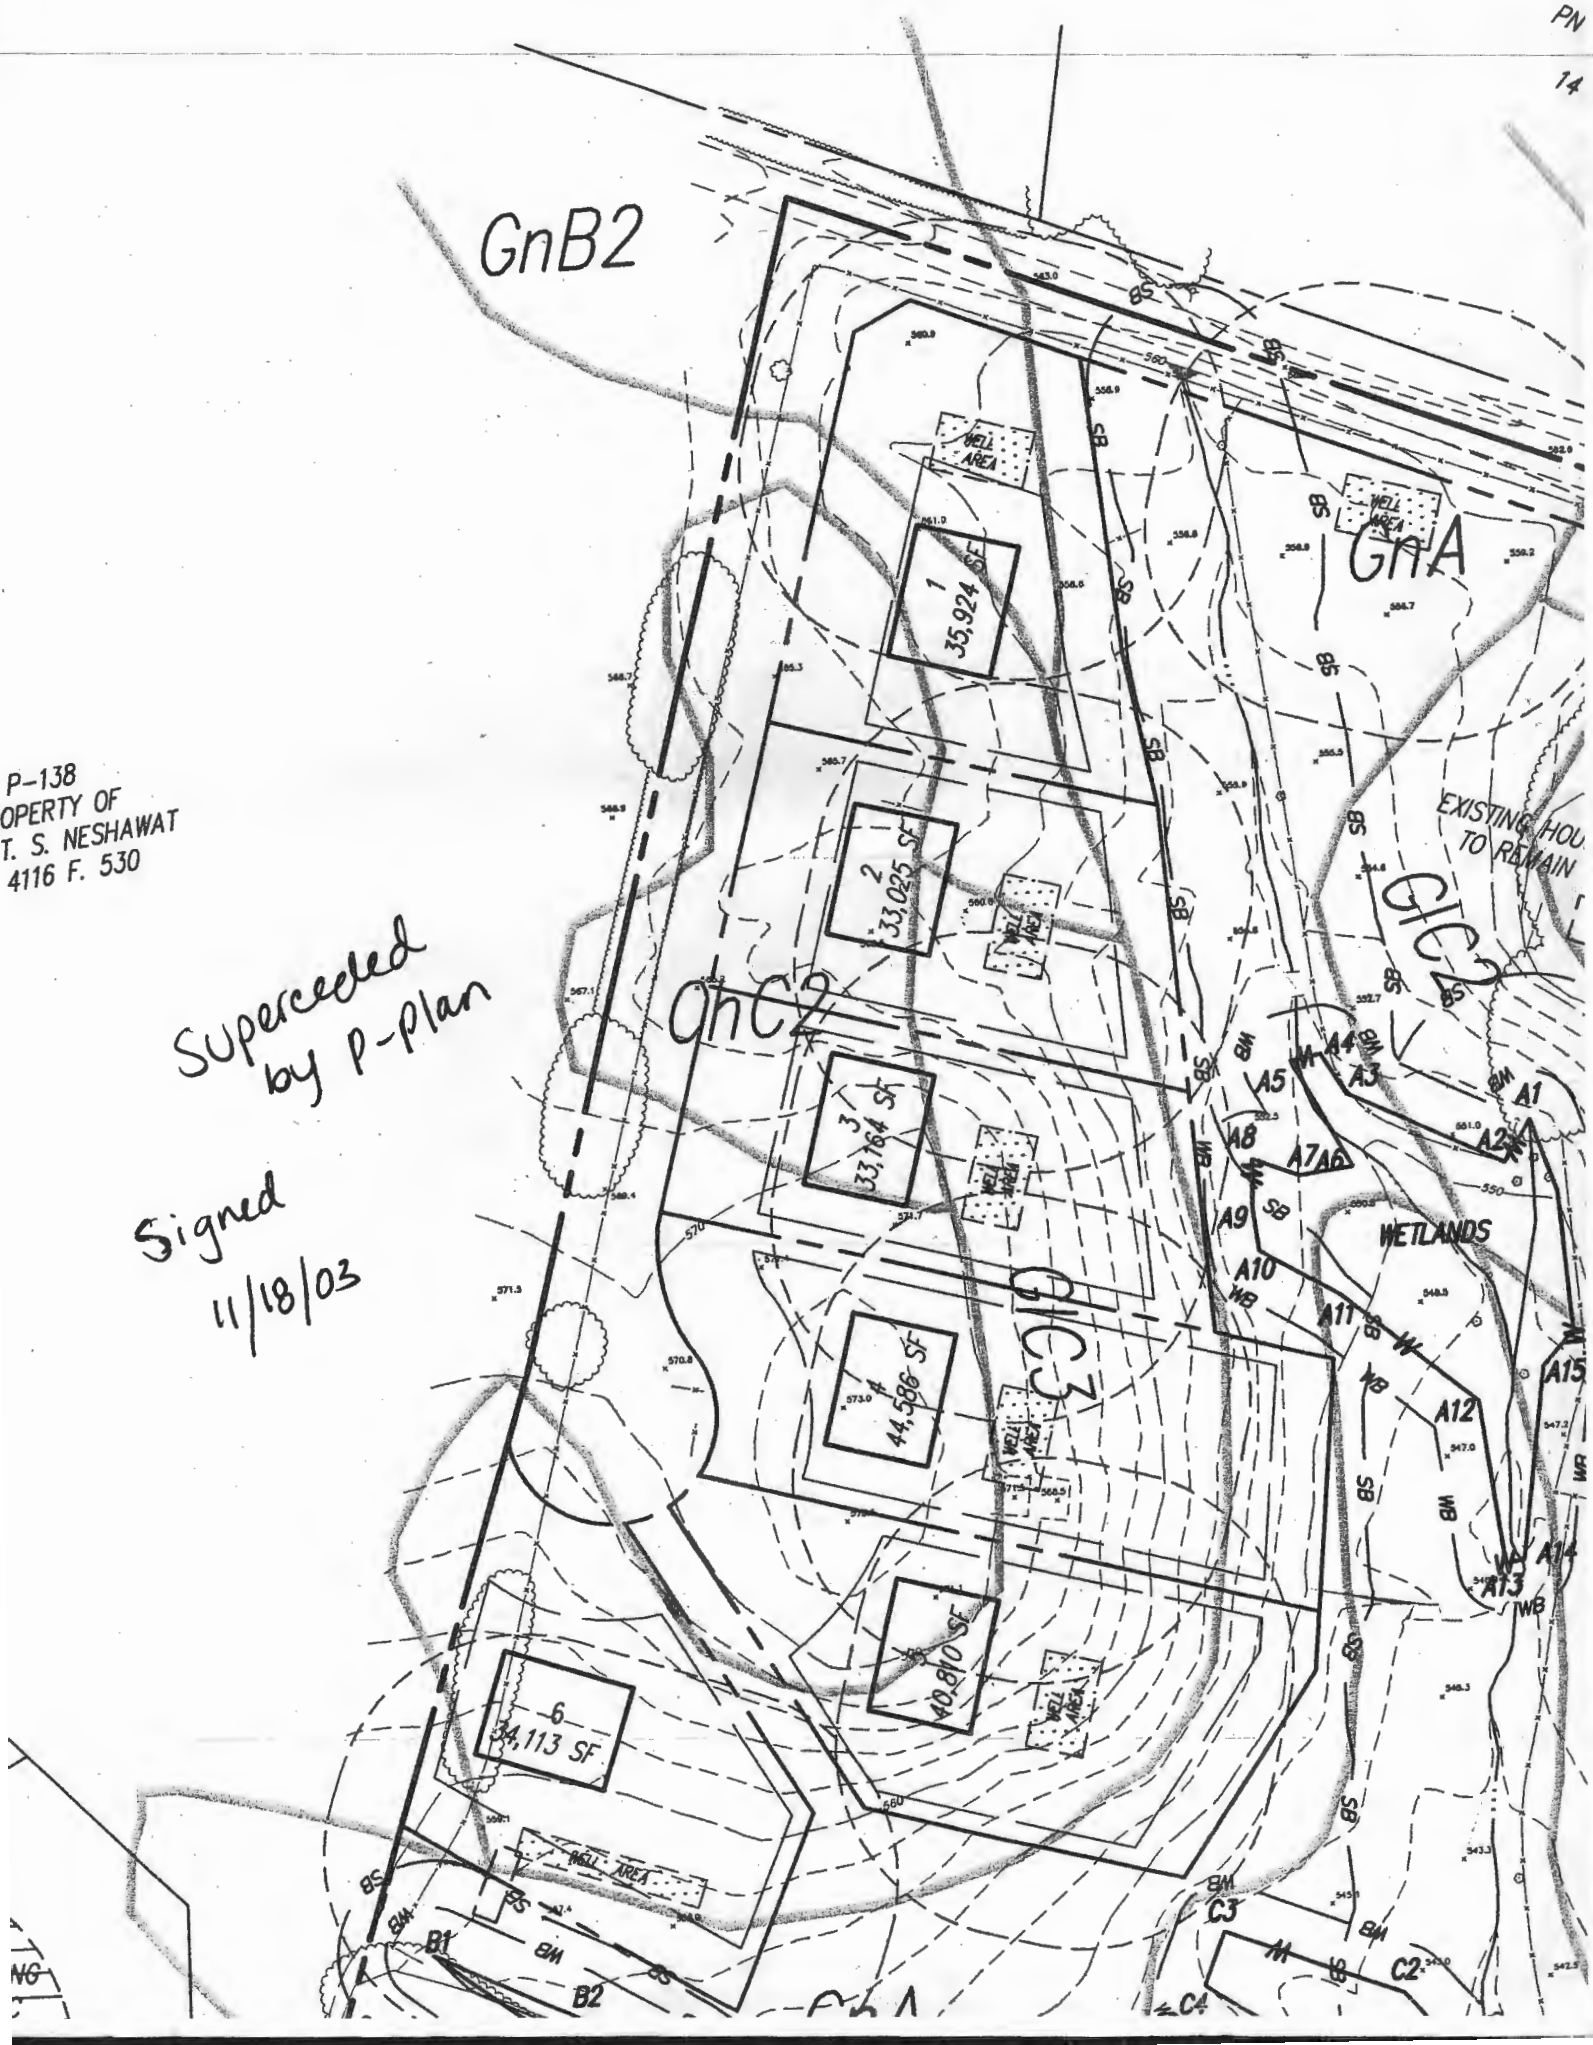

P-138
PROPERTY OF
T. S. NESHAWAT
4116 F. 530

Superceded
by P-Plan

Signed
11/18/03