

MARYLAND DEPARTMENT OF THE ENVIRONMENT, WATER MANAGEMENT ADMINISTRATION
1800 Washington Blvd., Baltimore, Maryland 21230 (410) 537-3784

WATER WELL ABANDONMENT-SEALING REPORT FORM

SUBMIT COPIES OF COMPLETED FORM TO:

- * COUNTY ENVIRONMENTAL AGENCY (contact MDE, WMA if address needed)
- * WELL OWNER
- * MDE, WATER MANAGEMENT ADMINISTRATION, WELL PROGRAM

OK
3/24/19 SC

DATE WELL ABANDONED: 3-8-19 (month/day/year)

* PERMIT NUMBER OF ABANDONED WELL (if any)


* PERMIT NUMBER OF REPLACEMENT WELL:

* PERSON ABANDONING WELL: Maurice Dixon WELL DRILLER'S LICENSE NUMBER: 0666

CIRCLE: MWD / MSD / MGS

* OWNER'S NAME: Dennis Liu

SITE LOCATION MAP

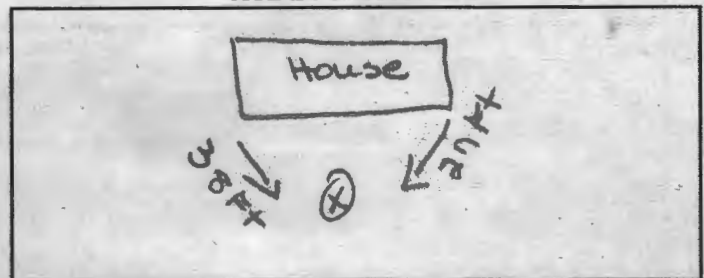

* WELL LOCATION:
COUNTY: Howard
NEAREST TOWN: Laurel
TAX MAP BLOCK PARCEL
SUBDIVISION:
SECTION: LOT:
STREET ADDRESS: 10674 Scaggsville Rd

LATITUDE 39.13807N

LONGITUDE 76.88235W

LOG OF SEALING MATERIAL

MATERIAL	FEET	
	FROM	TO
Stone	40	5
Concrete	5	0

* TYPE OF WELL BEING ABANDONED:

☐ DRILLED ☐ JETTED
☐ BORED ☒ HAND DUG
☐ OTHER (specify)

USE CODE:

☒ DOMESTIC ☐ MUNICIPAL/PUBLIC
☐ IRRIGATION ☐ INDUSTRIAL
☐ TEST/OBSERVATION ☐ GEOTHERMAL

VOLUME OF MATERIAL USED

1/2 ton stone 38 Bags Concrete

* TYPE OF CASING:

☐ STEEL ☐ PLASTIC
☒ CONCRETE ☐ OTHER (specify)

SIZE OF CASING: 3 FT INCHES IN DIAMETER

DEPTH OF WELL: 40 FEET DEEP

WAS ANY CASING REMOVED? ☒ YES ☐ NO

If yes, length removed, in feet: 1

WAS CASING RIPPED OR PERFORATED? ☐ YES ☒ NO

SIGNATURE-MASTER WELL DRILLER OR SUPERVISING SANITARIAN Maurice Dixon LICENSE# 0666

MWD / MSD / MGS

CIRCLE ONE

3-8-19

DATE

COUNTY

38 yds
per
Brian
Smith
out Carroll
Water

Pursuant to § 10-624 of the State Govt. Article of the Maryland Code, personal info requested on this form is used in processing this form pursuant to COMAR 26.04.04. Failure to provide the info may result in this form not being processed. You have the right to inspect, amend, or correct this form. The Maryland Department of the Environment is subject to the Maryland Public Information Act. This form may be made available on the Internet via MDE's website and is subject to inspection or copying, in whole or in part, by the public and other governmental agencies, if not protected by federal or State Law.