Building Permit Application

Howard County Maryland
Department of Inspections, Licenses and Permits
3430 Court House Drive
Permits: 410-313-2455
www.howardcountymd.gov

Health

Date Received: _____

Permit No.: B19003579

Building Address: 2929 Summer hill drive
City: West Friendship State: MD Zip Code: 21794
Suite/Apt. # _____ SDP/WP/BA #: _____
Subdivision: _____
Lot: _____ Tax Map: _____ Parcel: _____

Existing Use: ~~Recreational~~ Single
Proposed Use: ~~Recreational~~ SFD
Estimated Construction Cost: $ 40000.00
Description of Work: Finish basement for Recreational, Game room, Laundry room, Mechanical ~~Living~~ room, recreation, Media room, Bathroom
Occupant/Tenant Name: _____
Was tenant space previously occupied? ☐Yes ☐No
Contact Name: _____
Address: _____
City: _____ State: _____ Zip Code: _____
Phone: _____ Fax: _____
Email: _____

Property Owner's Name: MARUTHI PRASAD VEERAMARCHNANI
Address: 2929 Summer hill drive
City: W. Friendship State: MD Zip Code: 21794
Phone: 612-270-2221 Fax: _____
Email: MARUTHI PRASAD 2006@gmail.com
Applicant's Name & Mailing Address, (if other than stated herein) Same
Applicant's Name: Owner
Address: _____
City: _____ State: _____ Zip Code: _____
Phone: _____ Fax: _____
Email: _____

Contractor Company: Owner
Contact Person: _____ N/A
Address: _____
City: _____ State: _____ Zip Code: _____
License No.: _____
Phone: _____ Fax: _____
Email: _____

Engineer/Architect Company: _____
Responsible Design Prof.: _____
Address: _____
City: _____ State: _____ Zip Code: _____
Phone: _____ Fax: _____
Email: _____

Commercial Building Characteristics	Residential Building Characteristics
Height:	☑SF Dwelling ☐ SF Townhouse
No. of stories:	Depth / Width
Gross area, sq. ft./floor:	1st floor:
	2nd floor:
Area of construction (sq. ft.): 1900	Basement:
	☑ Finished Basement
Use group: Recreation	☐ Unfinished Basement
	☐ Crawl Space
Construction type:	☐ Slab on Grade
☐ Reinforced Concrete	No. of Bedrooms:
☐ Structural Steel	**Multi-family Dwelling**
☐ Masonry	No. of efficiency units:
☑ Wood Frame	No. of 1 BR units:
☐ State Certified Modular	No. of 2 BR units:
	No. of 3 BR units:
	Other Structure:
	Dimensions:
Roadside Tree Project Permit	Footings:
☐Yes ☑No	Roof:
Roadside Tree Project Permit #	☐ State Certified Modular
	☐ Manufactured Home

Utilities	
Electric: ☑Yes ☐ No	
Gas: ☑Yes ☐ No	
Water Supply	
☐ Public	
☑ Private	
Sewage Disposal	
☐ Public	
☑ Private	
Heating System	
☐ Electric ☐ Oil	
☑ Natural Gas ☐ Propane Gas	
☐ Other:	
Sprinkler System:	
☐ Yes ☑ No	
Grading Permit Number:	
Building Shell Permit Number:	

THE UNDERSIGNED HEREBY CERTIFIES AND AGREES AS FOLLOWS: (1) THAT HE/SHE IS AUTHORIZED TO MAKE THIS APPLICATION; (2) THAT THE INFORMATION IS CORRECT; (3) THAT HE/SHE WILL COMPLY WITH ALL REGULATIONS OF HOWARD COUNTY WHICH ARE APPLICABLE THERETO; (4) THAT HE/SHE WILL PERFORM NO WORK ON THE ABOVE REFERENCED PROPERTY NOT SPECIFICALLY DESCRIBED IN THIS APPLICATION; (5) THAT HE/SHE GRANTS COUNTY OFFICIALS THE RIGHT TO ENTER ONTO THIS PROPERTY FOR THE PURPOSE OF INSPECTING THE WORK PERMITTED AND POSTING NOTICES.

Owner — MARUTHI PRASAD VEERAMARCHNANI
Applicant's Signature *Print Name*

MARUTHIPRASAD2006@gmail.com — 10/22/2019
Email Address *Date*

Owner
Title/Company

Checks Payable to: DIRECTOR OF FINANCE OF HOWARD COUNTY
PLEASE WRITE NEATLY & LEGIBLY
-FOR OFFICE USE ONLY-

AGENCY	DATE	SIGNATURE OF APPROVAL
State Highways		
Building Officials		
PSZA (Zoning)		
PSZA (Engineering)		
[illegible]	11/18/19	[signature]

Is Sediment Control approval required for issuance? ☐ Yes ☐ No
☐ CONTINGENCY CONSTRUCTION START

DPZ SETBACK INFORMATION	
Front:	
Rear:	
Side:	
Side St.:	
All minimum setbacks met?	☐ Yes ☐No
Is Entrance Permit Required?	☐ Yes ☐No
Historic District?	☐ Yes ☐No
Lot Coverage for New Town Zone:	
SDP/Red-line approval date:	

Filing Fee	$	135.00
Permit Fee	$	
Tech Fee	$	
Excise Tax	$	
PSFS	$	
Guaranty Fund	$	
Add'l per Fee	$	
Total Fees	$	
Sub- Total Paid	$	
Balance Due	$	
Check	#	702

Distribution of Copies: White: Building Officials Green: PSZA,Zoning Yellow: PSZA,Engineering Pink: Health Gold: SHA

T:\Operations\Updated Forms\BuildingPermitApplication03.29.2018.docx

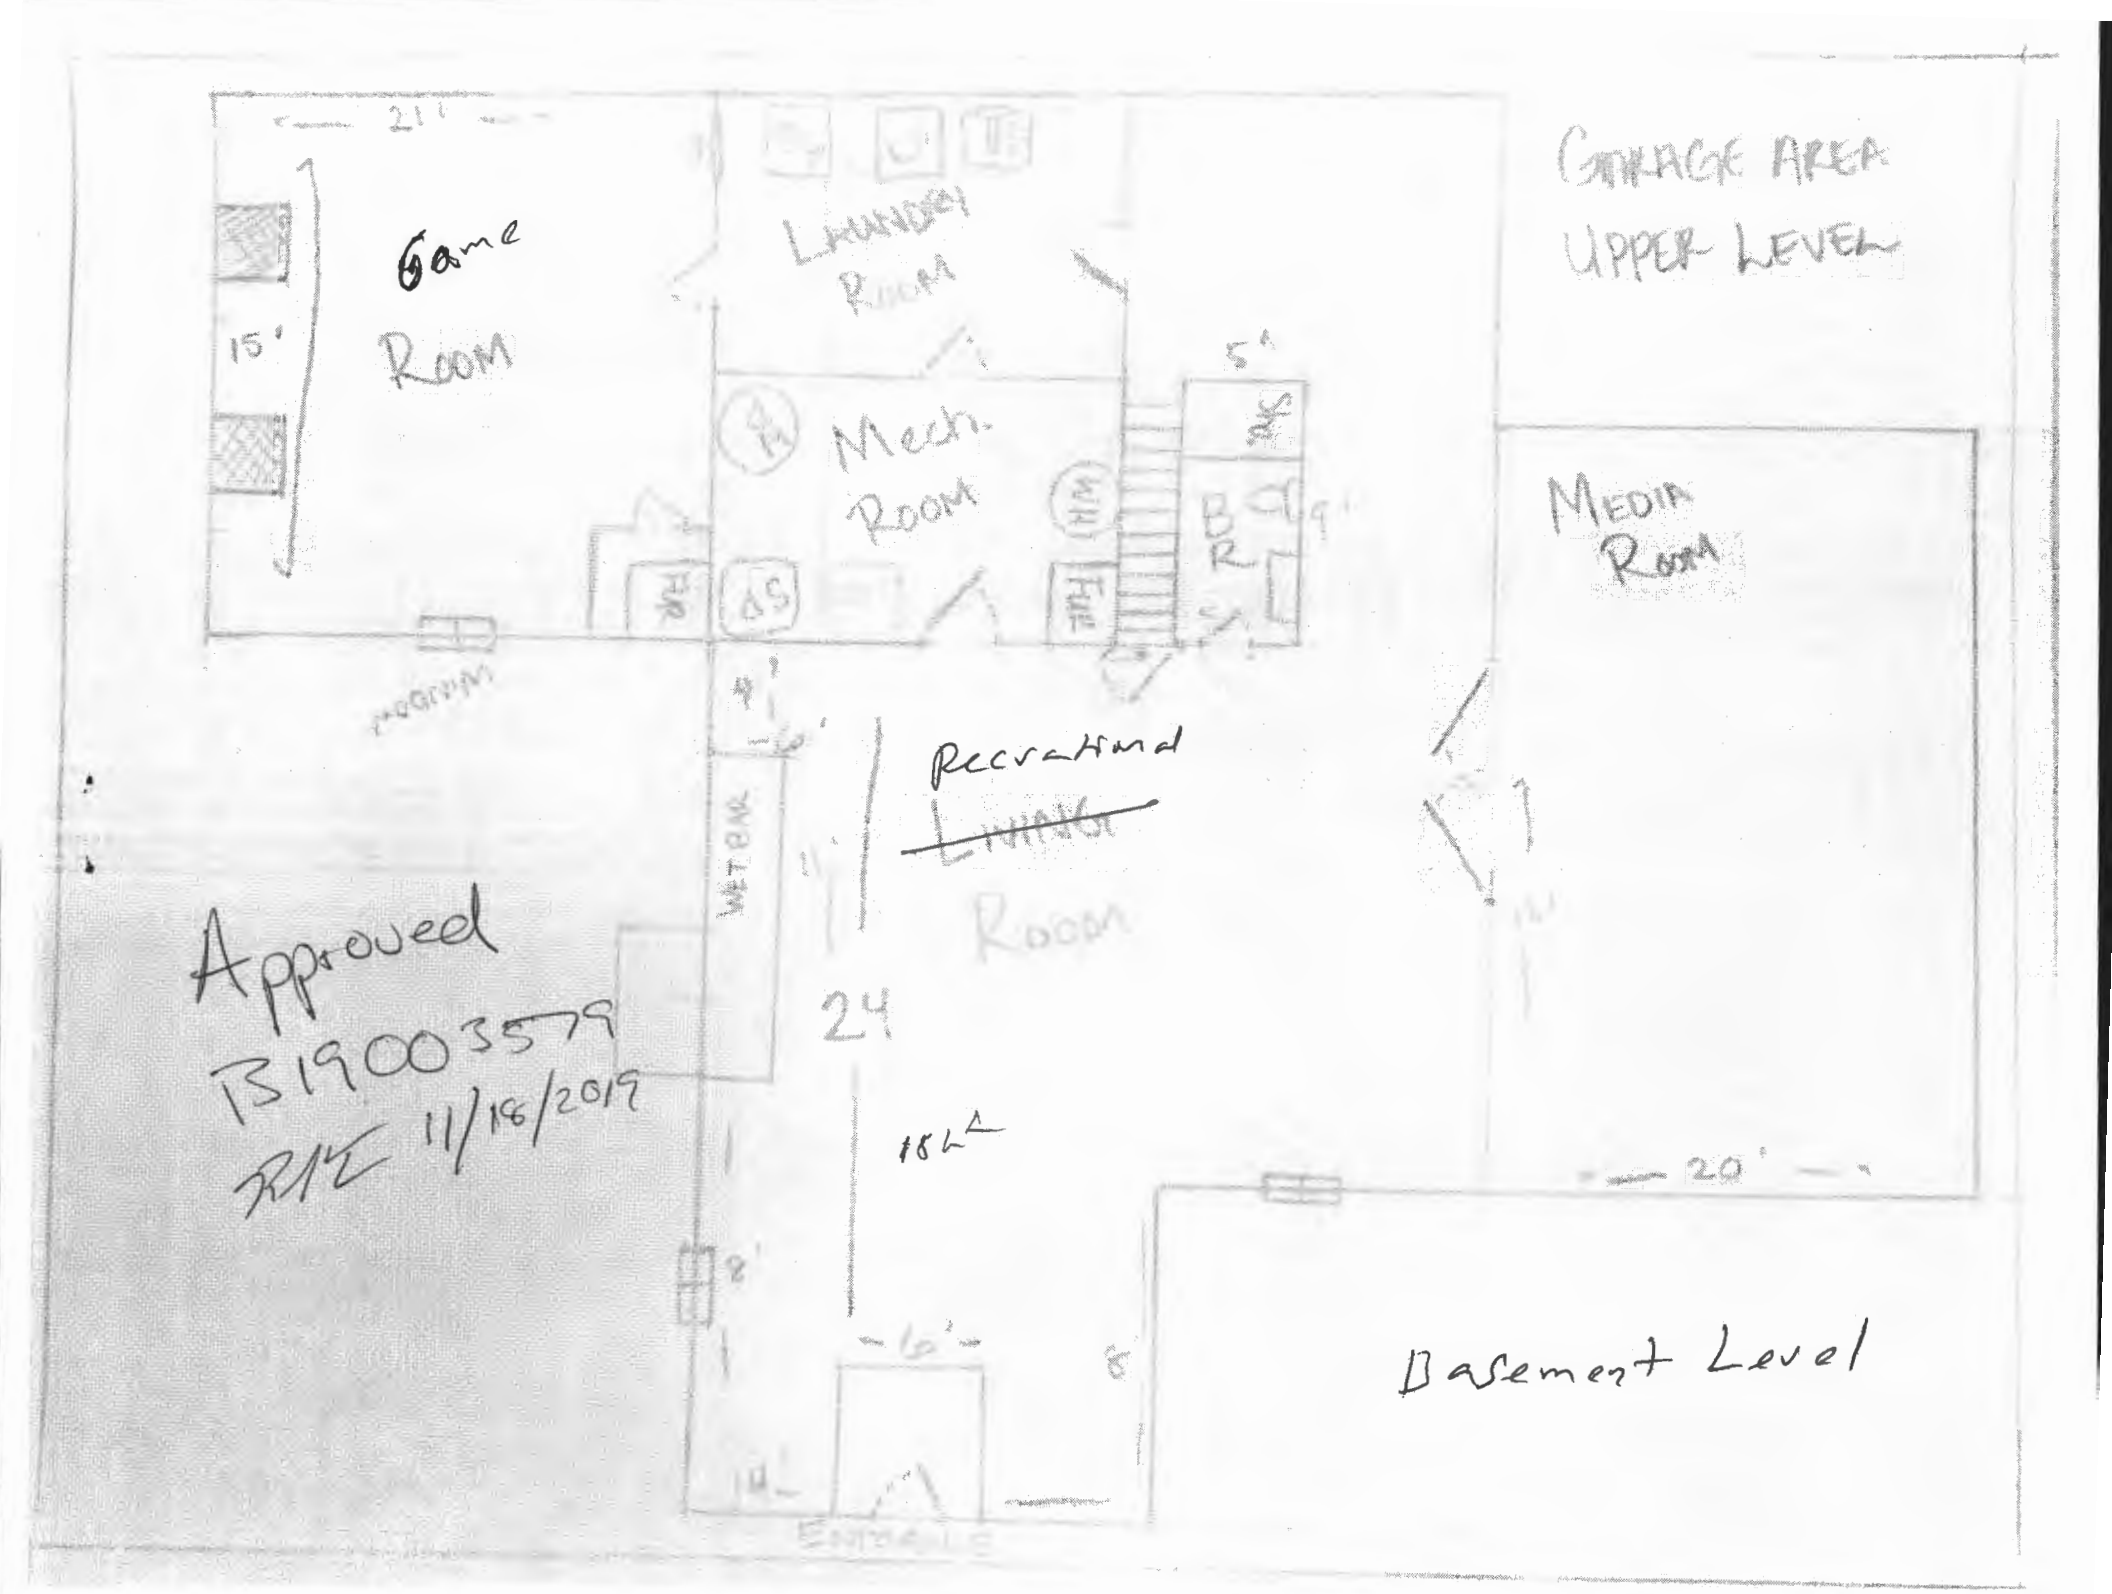
21'
Game Room
15'
Laundry Room
Mech. Room
5'
BR
9'
Garage Area
Upper Level
Media Room
Recreational
Room
WET BAR
24
18'
20'
6'
8'
Basement Level
Approved
B1900379
11/18/2019
RE