Building Permit Application

Howard County Maryland
Department of Inspections, Licenses and Permits
3430 Court House Drive
Permits: 410-313-2455
www.howardcountymd.gov

DILP 2019 JAN 16 PM 1:13
Date Received: _____

Permit No.: B19000152

Health

Building Address: 13845 MILL CREEK COURT
City: CLARKSVILLE State: MD Zip Code: 21029
Suite/Apt. #: _____ SDP/WP/BA #: _____
Census Tract: _____ Subdivision: CRAWFORD SUB
Section: _____ Area: _____ Lot: 19
Tax Map: _____ Parcel: _____ Grid: _____
Zoning: _____ Map Coordinates: _____ Lot Size: _____

Existing Use: SFD
Proposed Use: SFD W/PROPANE TANK
Estimated Construction Cost: $ 4,000
Description of Work:
INSTALL 1000 GAL UNDERGROUND PROPANE TANK

Occupant/Tenant Name: OWNER
Was tenant space previously occupied? ☐Yes ☐No
Contact Name: _____
Address: _____
City: _____ State: _____ Zip Code: _____
Phone: _____ Fax: _____
Email: _____

Property Owner's Name: ESC MILL CREEK INC
Address: 1355 BEVERLY ROAD STE 240
City: MCLEAN State: VA Zip Code: 22101
Phone: _____ Fax: _____
Email: _____

Applicant's Name & Mailing Address, (If other than stated herein)
Applicant's Name: MICHELLE CLANCY
Address: PO BOX 310
City: PERRY HALL State: MD Zip Code: 21128
Phone: 443-610-7514 Fax: _____
Email: MICHELLE@APPLIEDANDAPPROVED.COM

Contractor Company: TECH AIR
Contact Person: DENNIS FEAGA
Address: 1560 A-D CATON CENTER DRIVE
City: BALTIMORE State: MD Zip Code: 21227
License No. : 81215
Phone: 410-984-5681 Fax: _____
Email: _____

Engineer/Architect Company: CONTRACTOR
Responsible Design Prof.: _____
Address: _____
City: _____ State: _____ Zip Code: _____
Phone: _____ Fax: _____
Email: _____

Commercial Building Characteristics	*Residential Building Characteristics*
Height:	☒ SF Dwelling ☐ SF Townhouse
No. of stories:	Depth Width
Gross area, sq. ft./floor:	1st floor:
	2nd floor:
Area of construction (sq. ft.):	Basement:
	☐ Finished Basement
Use group:	☐ Unfinished Basement
	☐ Crawl Space
Construction type:	☐ Slab on Grade
☐ Reinforced Concrete	No. of Bedrooms:
☐ Structural Steel	*Multi-family Dwelling*
☐ Masonry	No. of efficiency units:
☐ Wood Frame	No. of 1 BR units:
☐ State Certified Modular	No. of 2 BR units:
	No. of 3 BR units:
	Other Structure:
	Dimensions:
➢ Roadside Tree Project Permit	Footings:
☐Yes ☒No	Roof:
Roadside Tree Project Permit #	☐ State Certified Modular
	☐ Manufactured Home

Utilities	
Electric: ☐ Yes ☒ No	
Gas: ☒ Yes ☐ No	
Water Supply	
☐ Public	
☒ Private	
Sewage Disposal	
☐ Public	
☒ Private	
Heating System	
☐ Electric ☐ Oil	
☐ Natural Gas ☐ Propane Gas	
☐ Other:	
Sprinkler System:	
☐ Yes ☐ No	
Grading Permit Number:	
Building Shell Permit Number:	

THE UNDERSIGNED HEREBY CERTIFIES AND AGREES AS FOLLOWS: (1) THAT HE/SHE IS AUTHORIZED TO MAKE THIS APPLICATION; (2) THAT THE INFORMATION IS CORRECT; (3) THAT HE/SHE WILL COMPLY WITH ALL REGULATIONS OF HOWARD COUNTY WHICH ARE APPLICABLE THERETO; (4) THAT HE/SHE WILL PERFORM NO WORK ON THE ABOVE REFERENCED PROPERTY NOT SPECIFICALLY DESCRIBED IN THIS APPLICATION; (5) THAT HE/SHE GRANTS COUNTY OFFICIALS THE RIGHT TO ENTER ONTO THIS PROPERTY FOR THE PURPOSE OF INSPECTING THE WORK PERMITTED AND POSTING NOTICES.

Applicant's Signature

MICHELLE@APPLIEDANDAPPROVED.COM
Email Address

PERMITS
Title/Company

MICHELLE CLANCY
Print Name

1/15/19
Date

RECEIVED
JAN 16 2019
LICENSES & PERMITS DIVISION

Checks Payable to: **DIRECTOR OF FINANCE OF HOWARD COUNTY**
PLEASE WRITE NEATLY & LEGIBLY

FOR OFFICE USE ONLY

AGENCY	DATE	SIGNATURE OF APPROVAL
State Highways		
Building Officials		
PSZA (Zoning)		
PSZA (Engineering)		
Health	2/11/19	

Is Sediment Control approval required for issuance? ☐ Yes ☐ No
☐ CONTINGENCY CONSTRUCTION START

DPZ SETBACK INFORMATION	
Front:	
Rear:	
Side:	
Side St.:	
All minimum setbacks met?	☐ Yes ☐No
Is Entrance Permit Required?	☐ Yes ☐No
Historic District?	☐ Yes ☐No
Lot Coverage for New Town Zone:	
SDP/Red-line approval date:	

Filing Fee	$
Permit Fee	$ 100
Tech Fee	$ 10
Excise Tax	$
PSFS	$
Guaranty Fund	$
Add'l per Fee	$
Total Fees	$ 110.00
Sub-Total Paid	$
Balance Due	$
Check	# 6987

Distribution of Copies: White: Building Officials Green: PSZA,Zoning Yellow: PSZA,Engineering Pink: Health Gold: SHA

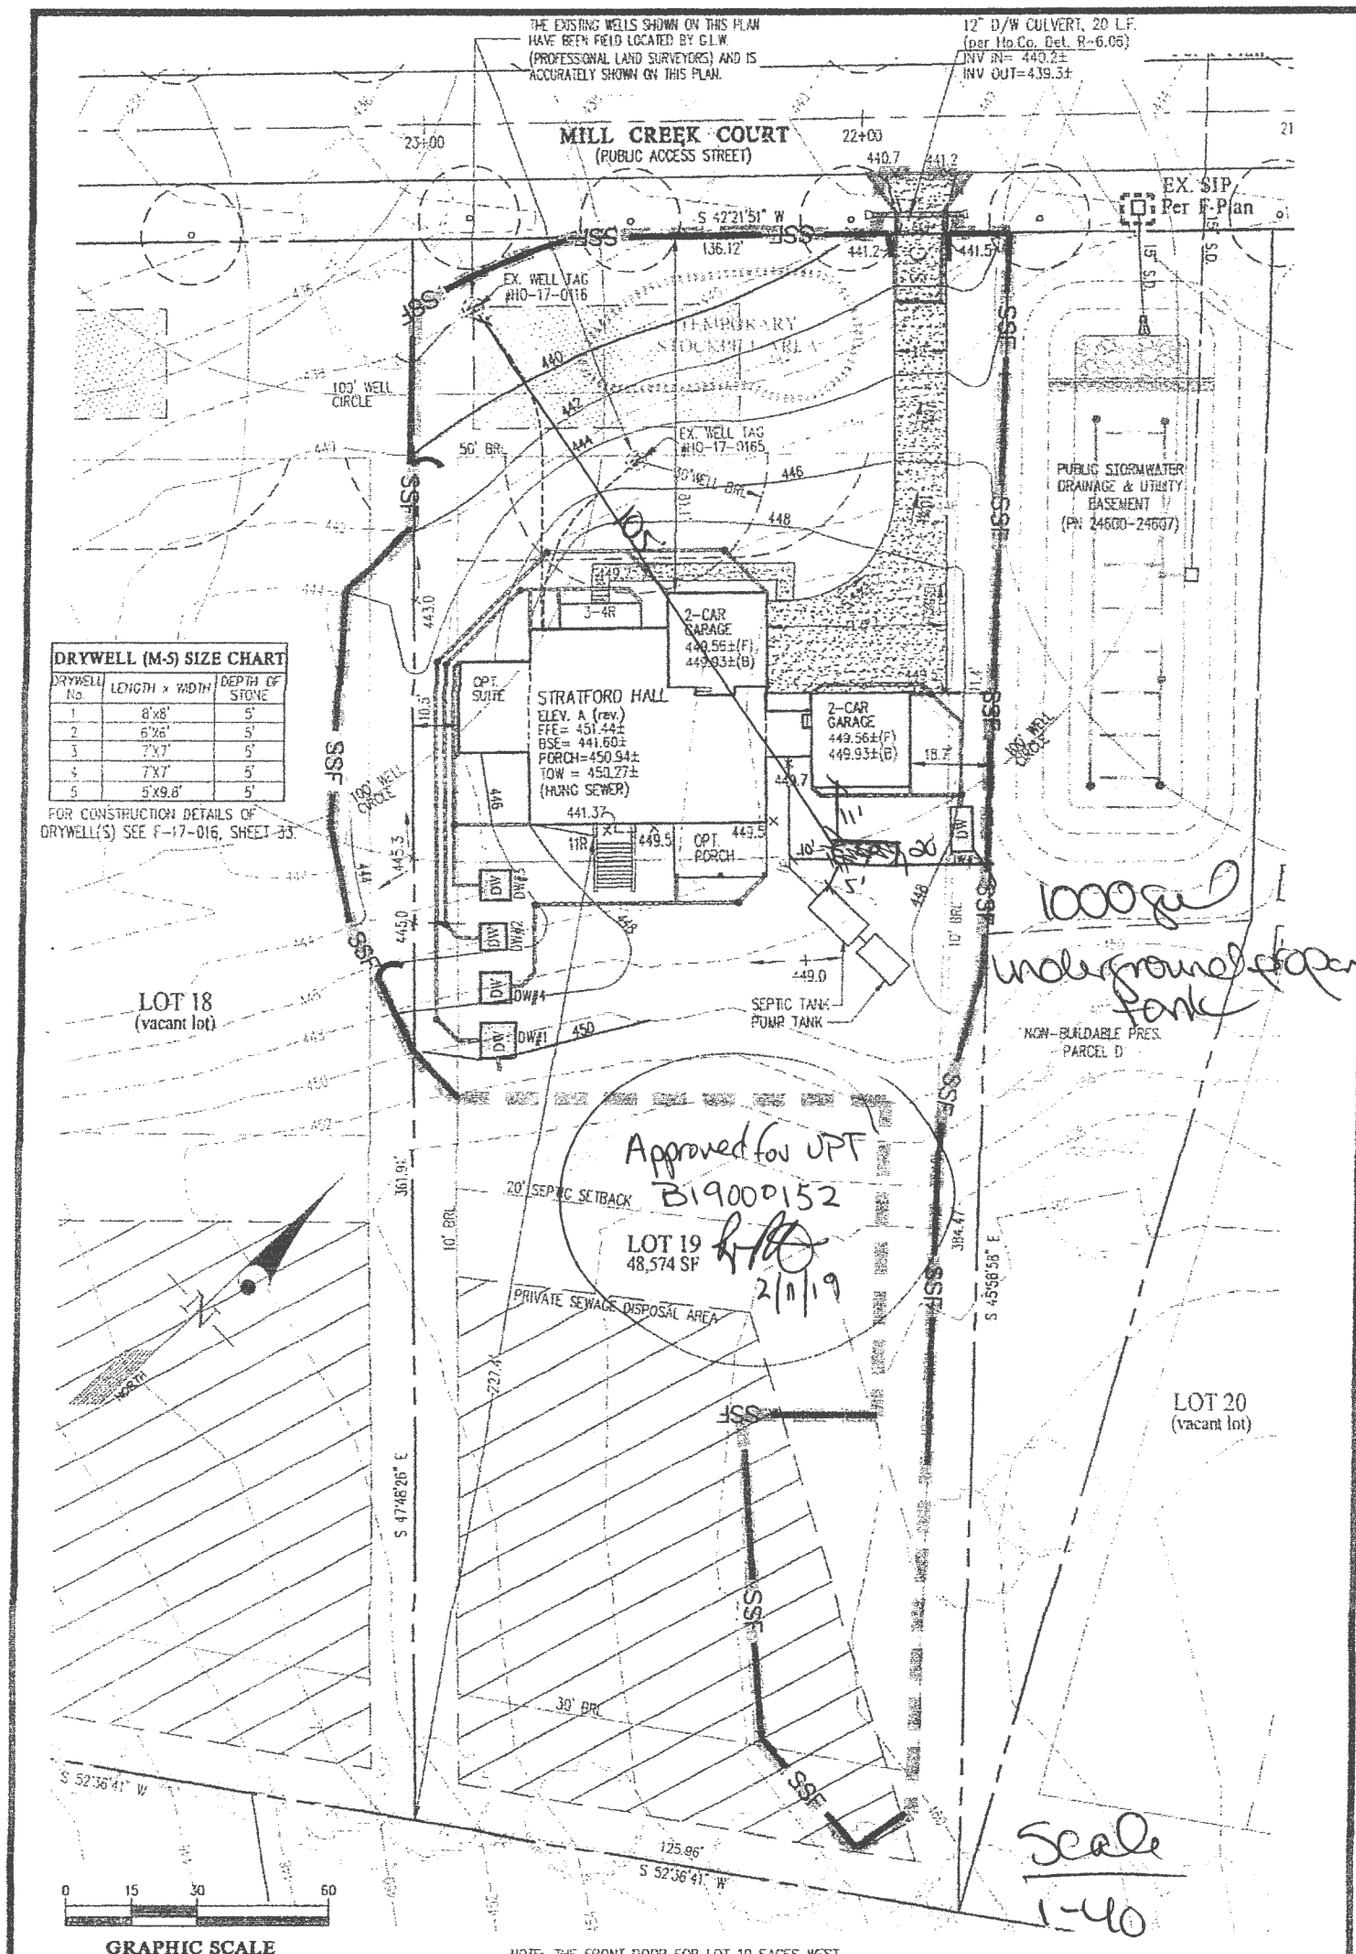

BUILDING PERMIT PLOT PLAN

GLW PLANNING | ENGINEERING | SURVEYING

DES.
DRN.
CHK.

PREPARED FOR :
NVR INC.
9720 PATUXENT WOODS DRIVE
COLUMBIA, MD 21045
PH: 410-379-5956

CRAWFORD SUBDIVISION
LOT 19 (13845 MILL CREEK CT.)
Plat No. 24600-24607

G. L. W. No.	17071
ZONING	RR-DEO
TAX MAP/GRID	34&30-19&6
DATE	OCT. 2018
SCALE	1"=30'
SHEET	1 OF 1

D:\CAD\PLANS\17071\PLANS ST SUB\PLOT PLANS\LOT 19\17071 MC_LOT 19 PLOT PLAN.dwg