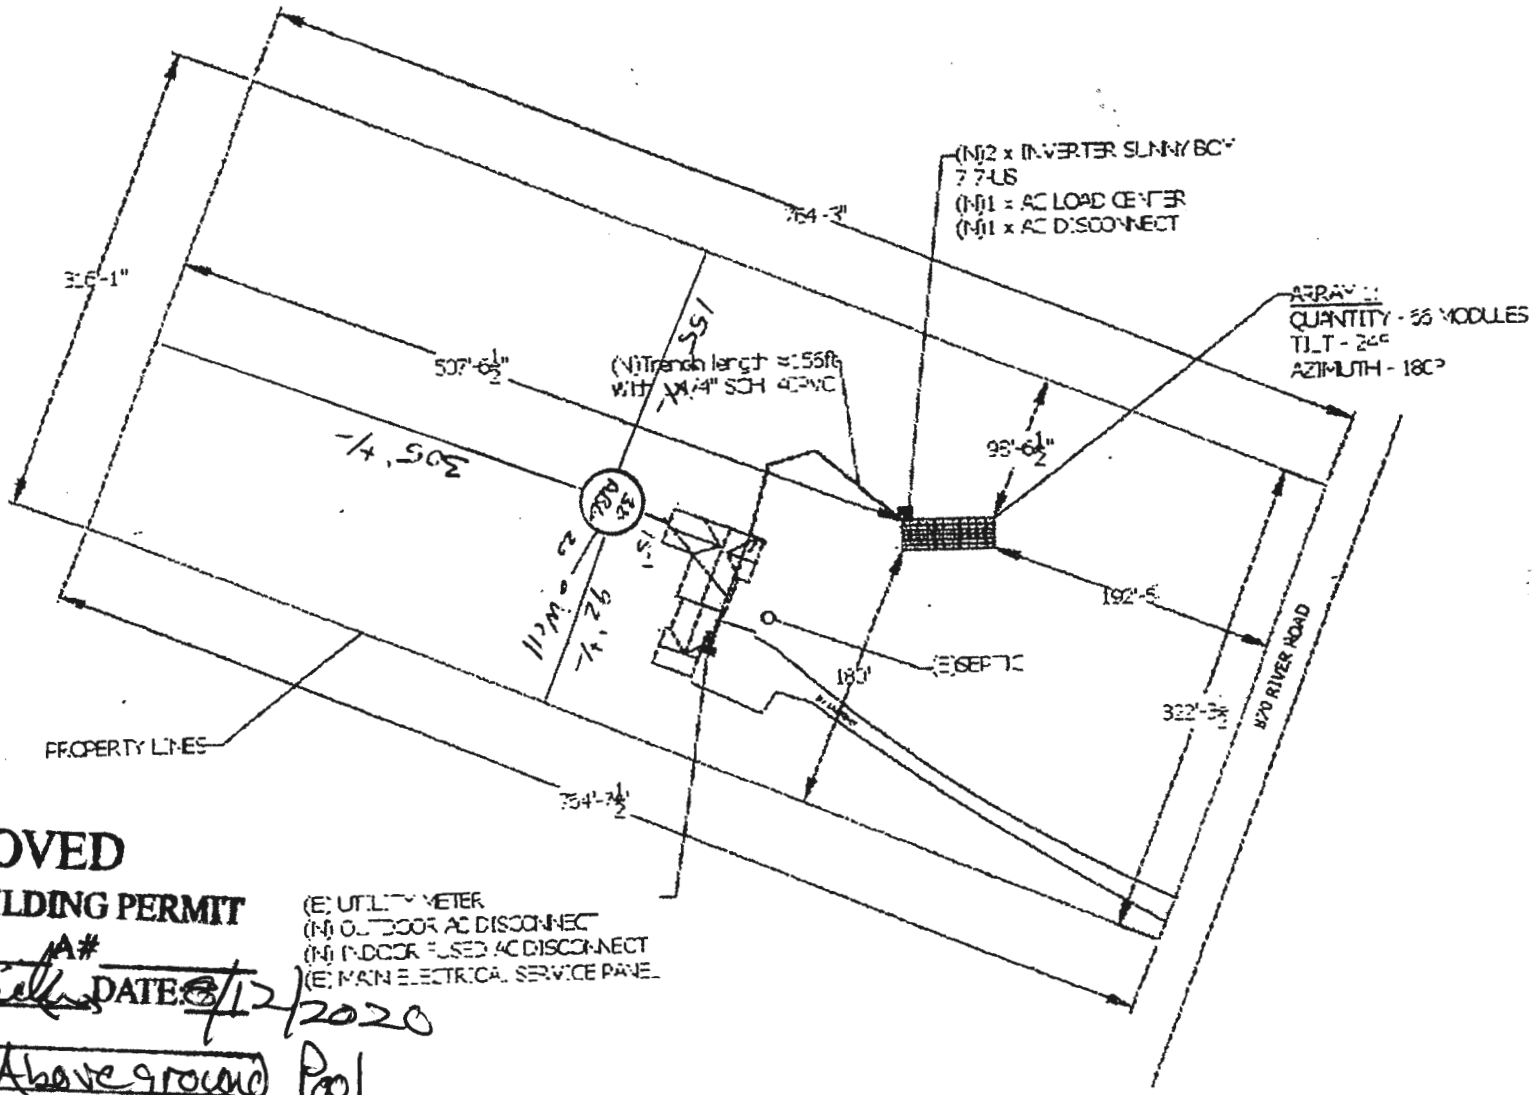


**APPROVED**

**WALK-THRU BUILDING PERMIT**

**BP#** _____ **A#** _____

**APP. SAN** _____ **DATE:** 8/12/2020

**DESC. OF WORK:**

32 Round, Above ground Pool

B20002641

870 River Rd.
Sykesville, MD

Menu Save Reset Cancel Help

**Record Detail** * *(This section is required.)*

| Permit Type | Permit Number | Opened Date |
|---|---|---|
| Building/Residential/Misc/Pool Spa | B20002641 | 08/11/2020 |

**Description of Work**

SFD/ INSTALL 32' RD STEEL ABOVEGROUND SWIMMING POOL, DEPTH 4'; NO FENCE NECESSARY

check spelling

'OK' RCB 8/12/2020 B20002641

**Address** * *(This section is required.)*

Search Reset Clear Get Parcel & Owner

| Street # | Street Name | Street Type |
|---|---|---|
| 870 | RIVER | RD |

| Unit Type | Unit # | X Coordinate | Y Coordinate |
|---|---|---|---|
| --Select-- | | -76.95043 | 39.34397 |

| City | State | Zip Code | Primary |
|---|---|---|---|
| SYKESVILLE | MD | 21784 | Yes |

**Parcel** * *(This section is required.)*

Search Reset Clear Get Address & Owner

| GIS ID * | Parcel | Parcel Area | Land Value | Improved Value | Exemption Value | Plan Area |
|---|---|---|---|---|---|---|
| 830828 | 230 | 5.03 | 240200 | 568100 | 327900 | RURAL |

**Legal Description**

IMPSLOT 8 5.038 ACRES[ ]870 RIVER RD[ ]SYKESVILLE

check spelling

| Block | Lot | Census Tract | Council Dist | Inspection Dist | Supervisor Dist | Map # | DAP Zone |
|---|---|---|---|---|---|---|---|
| | 8 | 603000 | 5 | | | | |

| Plan Area | State Tax Id | Subdivision Name |
|---|---|---|
| | 1403289400 | |

| Section | Area | Tax Map |
|---|---|---|
| | | 9 |

| Grid | Zoning District | ADC Map |
|---|---|---|
| 9-5 | RR-DEO | 4693-H5 |

| SDP No. | Final Plan No. | WP File No. | Primary |
|---|---|---|---|
| | | | Yes |

| Record Plat No. | WS Contract No. | FDP No. |
|---|---|---|
| | | |

| Owner Occupied | Year Built | Historic District |
|---|---|---|
| ○ Yes ○ No | 1979 | ○ Yes ◉ No |

| Historic District Registry No. | Stat Area | Flood Plain |
|---|---|---|
| | 3-01 | ○ Yes ◉ No |

Building No

**Owner** * *(This section is required.)*

**Search** **Reset** **Clear**

**Name** *
ORCHARD DOROTHY M
**Address Line 1**
870 RIVER RD
**Address Line 2**
**Address Line 3**
**Mail City** | **Mail State** | **Mail Zip Code**
SYKESVILLE | MD | 21784
**Phone** | **Primary**
410-570-4029 | Yes
**E-mail**
**Cell Number** | **Fax Number**

**Professionals** *(This section is not required.)*

**Search** **Reset** **Clear**

**License #** * | **Business Name**
08010013041 | VAN DORN POOLS INC
**License Type** * | **First Name** | **Middle Name** | **Last Name**
MHIC Ind | CHARLES | | STAFFORD
**Primary** | **Address Line 1**
Yes | 107 MAIN STREET
**Address Line 2**
**City** | **State** | **ZIP Code**
REISTERSTOWN | MD | 21136-1211
**Phone 1** | **Phone 2** | **Fax**
4105269207 | | 4105269304
**E-mail**
CHUCK@VANDORNPOOLSANDSPAS.COM

**Applicant** *(This section is not required.)*

**Search** **As Owner** **As Lic. Prof** **As Contact**

**Type** * | **First Name** | **MI** | **Last Name**
Applicant | Mara | | Hooper
**Relationship** | **Full Name**
Applicant | MARA HOOPER
**Primary** | **Organization Name**
Yes | Van Dorn Pools & Spas
**Street Address**
107 Main St
**Address Line 2**
**City** | **State** | **Zip Code**



https://avprod64.hcgov.hc.howardcountymd.gov/portlets/cap/CapBySingle.do?mode=edit... 8/12/2020

Reisterstown | MD | 21136

**Phone** 410-526-9990 **Cell** **Fax**

**E-mail** *
reisterstown@vandornpoolsandspas.com

**Addtl Info**

**Est Construction Cost** * 13000 **Housing Units** * 0 **Number of Buildings** * 0 **Public Owned** No

**Construction Type**
--Select--

**POOL INFORMATION**

**MISCELLANEOUS POOL INFORMATION**

**Capital Project-No Fee** * ○ Yes ◉ No **Capital Project Number** **Fee Exempt** * ○ Yes ◉ No **Water Supply** * Private **Sewage Disposal** * Private

**Existing Use** SFD **Type of Pool or Spa** * Above Ground Pool **Electrical Permit Number** **Expiration Date** 2/7/2021

**PAYMENT INFORMATION**

**Check 1** **Payee 1** **SAP Doc No** **SAP Entered**

**Submit** **Cancel**