

MARYLAND DEPARTMENT OF THE ENVIRONMENT, WATER MANAGEMENT ADMINISTRATION
1800 Washington Blvd., Baltimore, Maryland 21230 (410) 537-3784

WATER WELL ABANDONMENT-SEALING REPORT FORM

SUBMIT COPIES OF COMPLETED FORM TO:

- * COUNTY ENVIRONMENTAL AGENCY (contact MDE, WMA if address needed)
- * WELL OWNER
- * MDE, WATER MANAGEMENT ADMINISTRATION, WELL PROGRAM

DATE WELL ABANDONED: 1-21-21 (month/day/year)

* PERMIT NUMBER OF ABANDONED WELL (if any) _____


* PERMIT NUMBER OF REPLACEMENT WELL: _____

* PERSON ABANDONING WELL: John Hess WELL DRILLER'S LICENSE NUMBER: 553

* OWNER'S NAME: SHA CIRCLE: MWD / MSD / MGD

SITE LOCATION MAP

* WELL LOCATION:
COUNTY: Howard
NEAREST TOWN: West Friendship
TAX MAP 15 BLOCK PARCEL 126
SUBDIVISION: 2003
SECTION: _____ LOT: _____
STREET ADDRESS: 2885 Rt 30

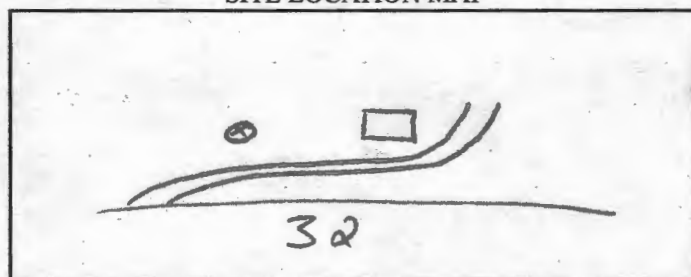

LATITUDE 39.291265

LONGITUDE 76.953619

LOG OF SEALING MATERIAL

MATERIAL	FEET	
	FROM	TO
<u>H/c Plus</u>	<u>10</u>	<u>2</u>

VOLUME OF MATERIAL USED

10 Bags H/c Plus

* TYPE OF WELL BEING ABANDONED:

☒ DRILLED ☐ JETTED
☐ BORED ☐ HAND DUG
☐ OTHER (specify) _____

* USE CODE:

☒ DOMESTIC ☐ MUNICIPAL/PUBLIC
☐ IRRIGATION ☐ INDUSTRIAL
☐ TEST/OBSERVATION ☐ GEOTHERMAL

* TYPE OF CASING:

☐ STEEL ☐ PLASTIC
☐ CONCRETE ☒ OTHER (specify)
Terra cotta

SIZE OF CASING: 10 INCHES IN DIAMETER

DEPTH OF WELL: 10 FEET DEEP

WAS ANY CASING REMOVED? ☒ YES ☐ NO

If yes, length removed, in feet: 2

WAS CASING RIPPED OR PERFORATED? ☐ YES ☒ NO

SIGNATURE-MASTER WELL DRILLER OR SUPERVISING SANITARIAN LICENSE#

553 CIRCLE ONE MWD / MSD / MGS

1-21-21

CIRCLE ONE

DATE

COUNTY

Pursuant to § 10-624 of the State Govt. Article of the Maryland Code, personal info requested on this form is used in processing this form pursuant to COMAR 26.04.04. Failure to provide the info may result in this form not being processed. You have the right to inspect, amend, or correct this form. The Maryland Department of the Environment is subject to the Maryland Public Information Act. This form may be made available on the Internet via MDE's website and is subject to inspection or copying, in whole or in part, by the public and other governmental agencies, if not protected by federal or State Law.