

MARYLAND DEPARTMENT OF THE ENVIRONMENT, WATER MANAGEMENT ADMINISTRATION
1800 Washington Blvd., Baltimore, Maryland 21230 (410) 537-3784

WATER WELL ABANDONMENT-SEALING REPORT FORM

SUBMIT COPIES OF COMPLETED FORM TO:

- * COUNTY ENVIRONMENTAL AGENCY (contact MDE, WMA if address needed)
- * WELL OWNER
- * MDE, WATER MANAGEMENT ADMINISTRATION, WELL PROGRAM

DATE WELL ABANDONED: 11-13-19 (month/day/year)

* PERMIT NUMBER OF ABANDONED WELL (if any) _____

* PERMIT NUMBER OF REPLACEMENT WELL: _____

* PERSON ABANDONING WELL: Robert Copey WELL DRILLER'S LICENSE NUMBER: 161


* OWNER'S NAME: BROOKDALE HOMES LLC CIRCLE: MWD / MSD / MGD

* WELL LOCATION:
COUNTY: Howard Co
NEAREST TOWN: ELLICOTT CITY
TAX MAP 0018 BLOCK _____ PARCEL 0047
SUBDIVISION: 8003
SECTION: _____ LOT: _____
STREET ADDRESS: 8438 W HIGH RIDGE RD

LATITUDE 39.292973

LONGITUDE 76.804129

SITE LOCATION MAP

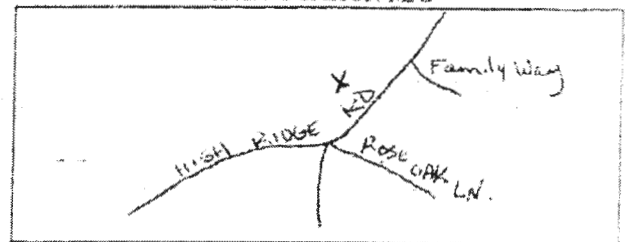

LOG OF SEALING MATERIAL

MATERIAL	FEET	
	FROM	TO
Bentonite clay	119	5
clean fill	5	0

VOLUME OF MATERIAL USED

1575 lbs 3/8 Bentonite pellets

* TYPE OF WELL BEING ABANDONED:
☒ DRILLED ☐ JETTED
☐ BORED ☐ HAND DUG
☐ OTHER (specify) _____

* USE CODE:
☒ DOMESTIC ☐ MUNICIPAL/PUBLIC
☐ IRRIGATION ☐ INDUSTRIAL
☐ TEST/OBSERVATION ☐ GEOTHERMAL

* TYPE OF CASING:
☒ STEEL ☐ PLASTIC
☐ CONCRETE ☐ OTHER (specify) _____

SIZE OF CASING: 6 INCHES IN DIAMETER

DEPTH OF WELL: 119 FEET DEEP

WAS ANY CASING REMOVED? YES ☒ NO
If yes, length removed, in feet: _____

WAS CASING RIPPED OR PERFORATED? YES ☒ NO

SIGNATURE MASTER WELL DRILLER OR SUPERVISING SANITARIAN Robert Copey LICENSE# 161

OWNER

CIRCLE ONE MWD / MSD / MGS

DATE 11/13/19

Pursuant to § 10-624 of the State Govt. Article of the Maryland Code, personal info requested on this form is used in processing this form pursuant to COMAR 26.04.04. Failure to provide the info may result in this form not being processed. You have the right to inspect, amend, or correct this form. The Maryland Department of the Environment is subject to the Maryland Public Information Act. This form may be made available on the Internet via MDE's website and is subject to inspection or copying, in whole or in part, by the public and other governmental agencies, if not protected by federal or State Law.