EMERGENCY/TEMP NO. IF ANY

B 1 .9767 SEQUENCE NO. (DP USE ONLY)
(THIS NUMBER IS TO BE PUNCHED IN COLS. 3-6 ON ALL CARDS)

STATE OF MARYLAND PERMIT TO DRILL WELL

please print or type

STATE PERMIT NUMBER: HO-BR-0316

fill in this form completely

Date Received (APA): 12 12 87

OWNER INFORMATION

BANEY RALPH R
Last Name — Owner — First Name

1 R SULPHUR SPRING
Street or RFD

BALTIMORE MD 21227
Town — State — Zip

DRILLER INFORMATION

George F. Easterday — License No. 40
Driller's Name

L. Franklin Easterday, Inc.
Firm Name

9265 Brown Church Rd., Mt.Airy, Md. 21771
Address

George F. Easterday 10-14-88
Signature — Date

B 2 WELL INFORMATION

APPROX. PUMPING RATE (GAL. PER MIN.) 5

AVERAGE DAILY QUANTITY NEEDED (GAL. PER DAY) 500

USE FOR WATER (CIRCLE APPROPRIATE BOX)

- D HOME (SINGLE OR DOUBLE HOUSEHOLD UNIT ONLY)
- F FARMING (LIVESTOCK WATERING & AGRICULTURAL IRRIGATION)
- I INDUSTRIAL, COMMERCIAL, STATE AND FEDERAL GOV. OTHER (REQUIRES APPROPRIATION PERMIT)
- P PUBLIC OR PRIVATE WATER COMPANY (REQUIRES APPROPRIATION PERMIT AND STATE HEALTH DEPARTMENT APPROVAL)
- T TEST, OBSERVATION, MONITORING (MAY REQUIRE APPROPRIATION PERMIT)

APPROXIMATE DEPTH OF WELL 200 FEET

APPROXIMATE DIAMETER OF WELL 6 NEAREST INCH

METHOD OF DRILLING (circle one)

BORED (or Augered) — JETTED — Jetted & DRIVEN
AIR-ROTary — AIR-PERcussion — ROTARY (Hydraulic Rotary)
CABLE — REVerse-ROTary — DRive-POINT

other

REPLACEMENT OR DEEPENED WELLS (CIRCLE APPROPRIATE BOX)

- N THIS WELL WILL NOT REPLACE AN EXISTING WELL
- Y THIS WELL WILL REPLACE A WELL THAT WILL BE ABANDONED AND SEALED
- S THIS WELL WILL REPLACE A WELL THAT WILL BE USED AS A STANDBY
- D THIS WELL WILL DEEPEN AN EXISTING WELL

PERMIT NUMBER OF WELL TO BE REPLACED OR DEEPENED (IF AVAILABLE)

Not to be filled in by driller (OEP USE ONLY)

APPROP. PERMIT NUMBER GAP

FORCE — WRITE INITIALS IN BOX — PERMIT No. HO-BR-0316

B 3 LOCATION OF WELL

R-42849 40-rd 10/25/88

HOWARD — 8 COUNTY

FAIRBOTS LAST SHIFT — 23 SUBDIVISION

SECTION 4 — LOT 12

EFFICOFT CITY — 52 NEAREST TOWN

MILES FROM TOWN (enter 0 if in town) 4 MI

B 4

DIRECTION OF WELL FROM TOWN (CIRCLE BOX)

NW N NE W TOWN E SW S SE

TALBOT'S LANDING — NEAR WHAT ROAD

ON WHICH SIDE OF ROAD (CIRCLE APPROPRIATE BOX): NORTH N, W 32 E, WEST, EAST, S SOUTH

DISTANCE FROM ROAD 350 ENTER FT or MI FT

NOT TO BE FILLED IN BY DRILLER
HEALTH DEPARTMENT APPROVAL

COUNTY NAME — COUNTY NO.

STATE SIGNATURE — INSERT'S

DATE ISSUED 5-7-89

CO SIGNATURE — EXP. DATE

NORTH GRID 0800 — EAST GRID 6400

SHOW MAJOR FEATURES OF BOX & LOCATE WELL WITH AN X

SOURCES OF DRILLING WATER
1. WELL
2.
3.

WRITE THE BOX NUMBER FROM THE MAP HERE

E 860 4
N 510

000
000

DRAW A SKETCH BELOW SHOWING LOCATION OF WELL IN RELATION TO NEARBY TOWNS AND ROADS AND GIVE DISTANCE FROM WELL TO NEAREST ROAD JUNCTION

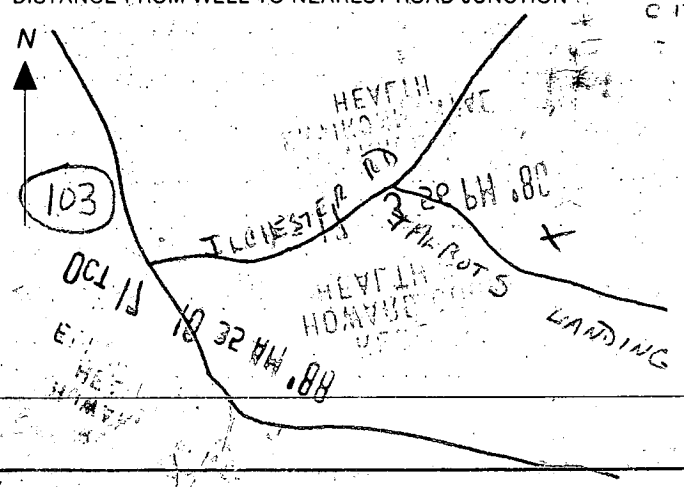

SPECIAL CONDITIONS

COUNTY