DNR-131 (7/73) EMERGENCY NO. (If any) – File

B 1 4121 SEQUENCE NO. (WRA USE ONLY)
1 2 3 (SEQ. NO.) 6 (THIS NUMBER IS TO BE PUNCHED IN COLS. 3-6 ON ALL CARDS)

STATE OF MARYLAND
WATER RESOURCES ADMINISTRATION
TAWES STATE OFFICE BLDG., ANNAPOLIS, MARYLAND 21401
APPLICATION FOR PERMIT TO DRILL WELL

WRA PERMIT NUMBER ?
HO-73-0062 V ok
FILL IN THIS FORM COMPLETELY

DATE RECEIVED (WRA USE ONLY) 5/14/74 2nd

OWNER LINE LARRY A# 00797
COL 15 LAST NAME FIRST NAME COL. 54
STREET OR RFD COL 36 COL. 55
POST OFFICE RISON MD 20, 31
COL 57 COL. 75

B 1 CONTINUED (SEQ. NO.)

DRILLER INFORMATION
DATE 4/5/74 LICENSE NUMBER 309 (77–80)
HOWARD (FIRST NAME) Dillon (DRILLER) (LAST NAME)
SIGNATURE Howard Dillon

B 2 (SEQ. NO.)

WELL INFORMATION
MAXIMUM PUMPING RATE (GALLONS PER MINUTE) 5 (8–12)
AVERAGE DAILY QUANTITY NEEDED (GALLONS PER DAY) 300 (14–20)

USE FOR WATER (CIRCLE APPROPRIATE BOX)
(D) HOME (SINGLE OR DOUBLE HOUSEHOLD UNIT ONLY)
(F) FARMING, AGRICULTURE, IRRIGATION
(I) INDUSTRIAL, COMMERCIAL, STATE AND FEDERAL GOVERNMENT
22
(M) MUNICIPAL WATER SUPPLY
(P) PRIVATE WATER COMPANY
} MUST HAVE STATE HEALTH DEPT. APPROVAL
(T) TEST

APPROXIMATE DEPTH OF WELL 50 (24–28) FEET
APPROXIMATE DIAMETER OF WELL 6 (NEAREST INCH)

METHOD OF DRILLING USED (CIRCLE APPROPRIATE METHOD)
BORED (OR AUGERED) JETTED DRIVEN
30-37 AIR-ROTARY AIR-PERCUSSION ROTARY (HYDRAULIC ROTARY)
CABLE REVERSE-ROTARY DRIVE-POINT
OTHER (DESCRIBE)

REPLACEMENT OR DEEPENED WELLS (CIRCLE APPROPRIATE BOX)
(N) THIS WELL WILL NOT REPLACE AN EXISTING WELL
(Y) THIS WELL WILL REPLACE A WELL THAT WILL BE ABANDONED AND SEALED
39
(S) THIS WELL WILL REPLACE A WELL THAT WILL BE USED AS A STANDBY
(D) THIS WELL WILL DEEPEN AN EXISTING WELL
PERMIT NUMBER OF WELL TO BE REPLACED OR DEEPENED (IF AVAILABLE)
(41–52)

NOT TO BE FILLED IN BY DRILLER (WRA USE ONLY)
APPROPRIATION PERMIT NUMBER G A P (54–63) ENGINEER REVIEW DISTRICT NO. (65)
FORCE (67–68) WRITE INITIALS IN BOX
CONDITIONS A E N S G W Q C L U (70–79)

B 4 CONTINUED (SEQ. NO.)

HEALTH DEPARTMENT APPROVAL
41 (S) STATE HEALTH (CIRCLE BOX) Howard 10760
COUNTY NAME COUNTY NO.
DATE MO. 05 DAY 17 YR. 74 (43–48)
APPROVED BY Palmer F. Wine, Director

B 5 (SEQ. NO.)

SPECIAL CONDITIONS 8-63 (WRA USE ONLY)

743 – 75 GS HEALTH 5

B 3 (SEQ. NO.)

LOCATION OF WELL
COUNTY HOWARD (8–21) (DO NOT ABBREVIATE COUNTY NAME)
SUBDIVISION (23–42)
SECTION (44–46) LOT (48–50)
NEAREST TOWN CLARKSVILLE (52–71)
MILES FROM TOWN (ENTER 0 IF IN TOWN) 3 (73–76) M I

B 4 (SEQ. NO.)

DIRECTION FROM TOWN (CIRCLE APPROPRIATE BOX)
(N) NORTH (E) EAST (NE) NORTHEAST (SE) SOUTHEAST
(S) SOUTH (W) WEST (NW) NORTHWEST (SW) SOUTHWEST
8 8 8 9 8 9
NEAR WHAT ROAD RED BERRY (11–30)
ON WHICH SIDE OF ROAD (CIRCLE APPROPRIATE BOX) NORTH (N) SOUTH (S) EAST (E) WEST (W) (32)
DISTANCE FROM ROAD (ENTER DISTANCE AND CIRCLE APPROPRIATE BOX) 100 (34–37) F T M I
38 39

DRAW A SKETCH BELOW SHOWING LOCATION OF WELL IN RELATION TO NEARBY TOWNS, ROADS AND STREAMS WITH NORTH IN THE DIRECTION OF THE ARROW, AND GIVE DISTANCE FROM WELL TO NEAREST ROAD JUNCTION OR STREAM CROSSING SHOWN ON THE SKETCH. ALSO SHOW, BY MEANS OF AN "X", THE WELL LOCATION IN THE BOX BELOW, AND THE BOX NUMBER FROM THE WELL LOCATION MAP.

N

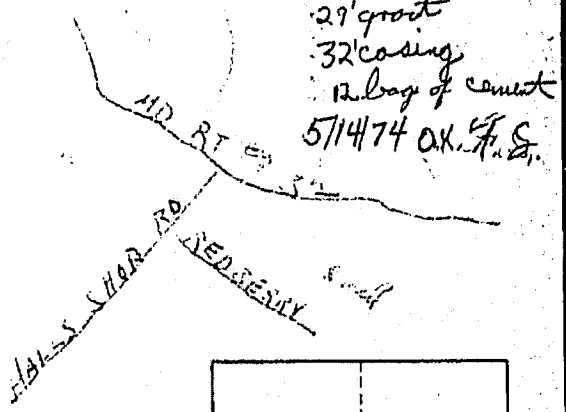

29' grout
32' casing
12 bag of cement
5/14/74 OK. H. S.

BOX NUMBER E 820 N 490

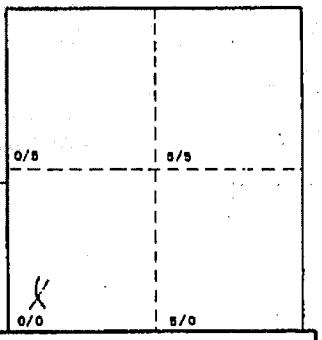

NORTH COORDINATE (50–55)
EAST COORDINATE (57–63)
ELEVATION AT WELL HEAD (FEET) (65–68)