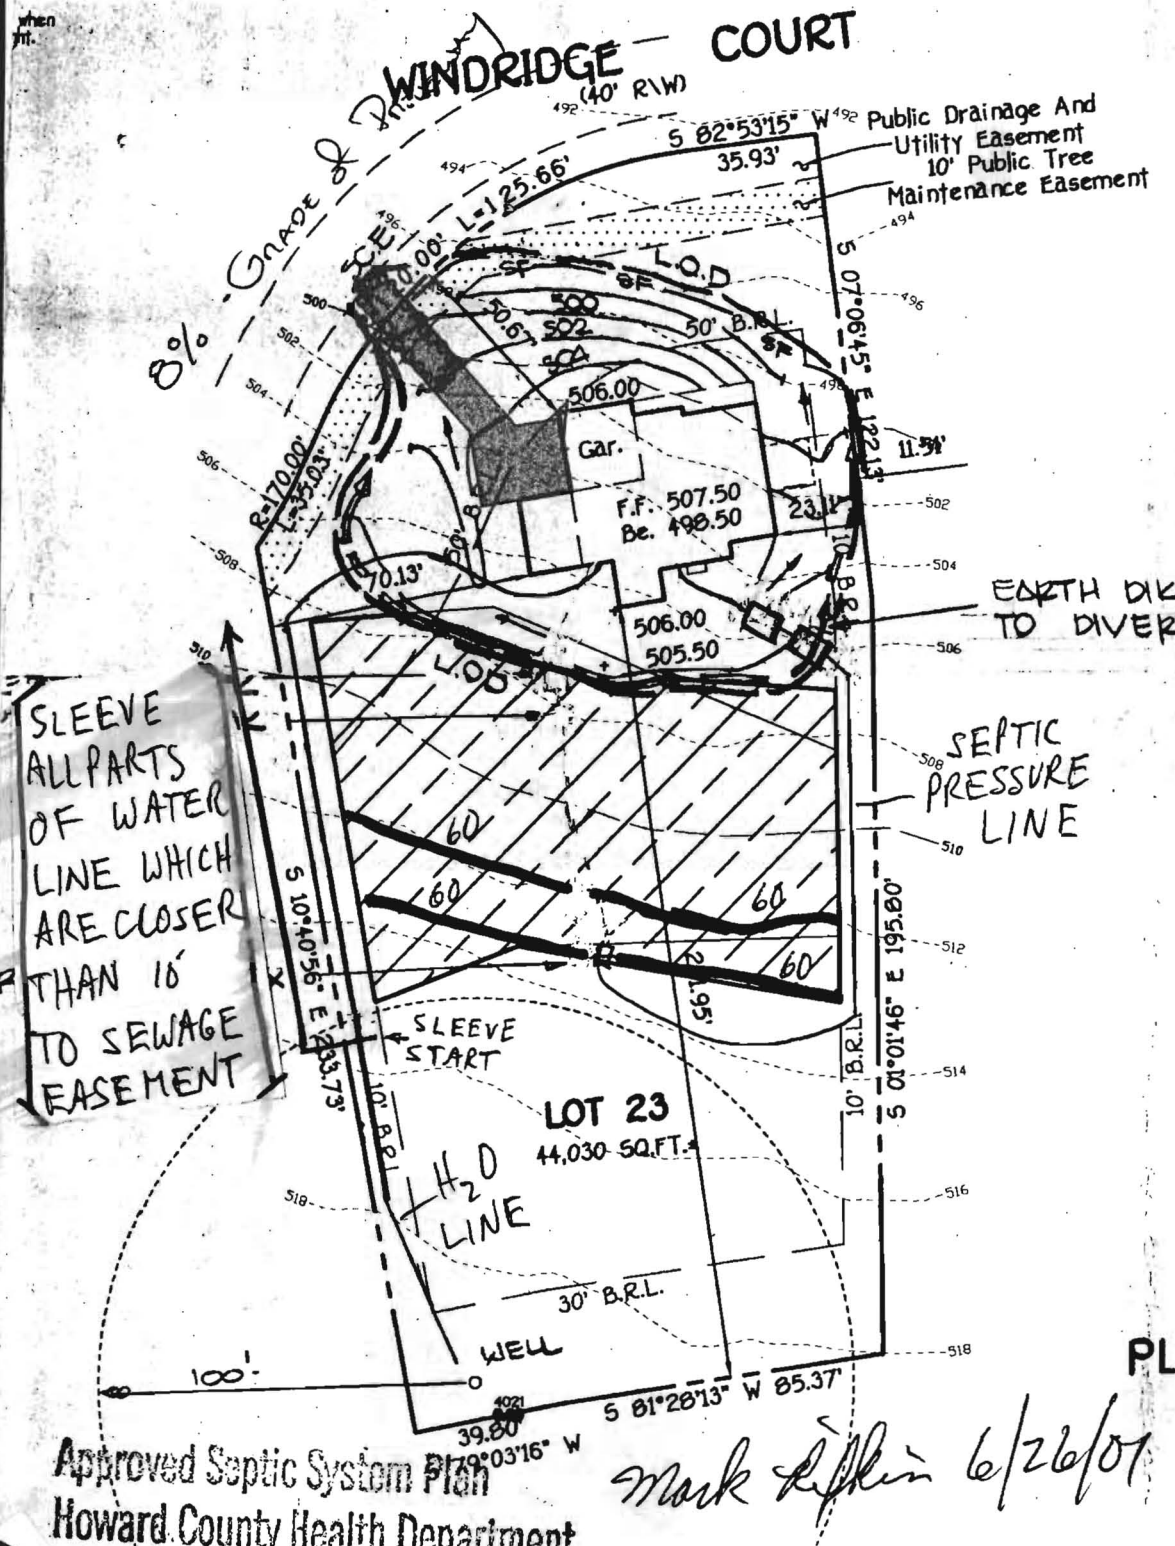

Total linear feet of trench required 240 feet

Width of trench(es) 3 feet

Depth of trench(es) 5 feet

Depth of stone required below distribution pipe 2 feet

2. PROPOSED 1500 GALLON SEPTIC TANK.
3. A. FIRST FLOOR ELEVATION: 507.50
   B. BASEMENT ELEVATION: 498.50
   C. INVERT OF SEPTIC SYSTEM AT HOUSE: 503.50
   D. INVERT IN AT SEPTIC TANK: 503.10
   E. INVERT OUT AT SEPTIC TANK: 502.80
   F. PROPOSED GRADE OVER SEPTIC TANK: ~~505.00~~ 505.60
   G. INVERT AT DISTRIBUTION BOX: 510.00
   H. EXISTING GROUND OVER DISTRIBUTION BOX: 513.00
4. LENGTH OF TRENCH TO BE DETERMINED AT TIME OF SEPTIC PERMIT ISSUANCE.
5. CONTRACTOR / BUILDER TO VERIFY ELEVATIONS IN FIELD BEFORE BEGINNING ANY CONSTRUCTION.
6. THERE IS NO BASEMENT SERVICE TO SEPTIC SYSTEM.

owner/ builder: Hamilton Reed LLC
8000 Main St.
Ellicott City MD 21043

Date: 5/15/01

Address: 14517 Windridge Ct.
Glenwood MD 21738

61380

PLAN TO ACCOMPANY APPLICATION FOR BUILDING PERMIT

WINDRIDGE FARMS

SECTION 2 AREA 2

Approved Septic System Plan
Howard County Health Department

Mark Rifkin 6/26/01