20933

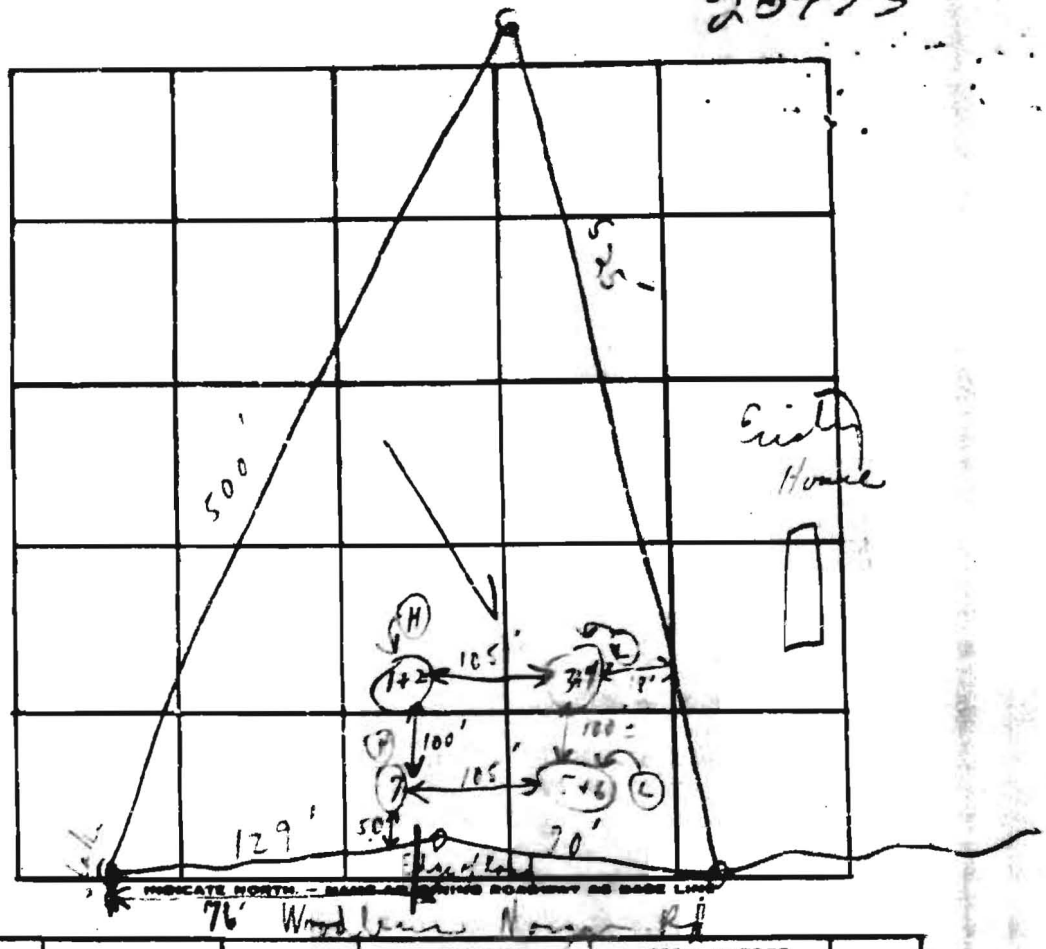

DATE	TEST NO.	DEPTH	PRE-WET START	PRE-WET STOP	TEST - 1" DROP START	TEST - 1" DROP STOP	TIME
1/4/74	(H) 1	4'	10:29	10:32	10:32	10:35	4 min
	2	11½'	10:29	10:35	10:35	10:43	8 min
	3	4½'	10:25	10:27	10:27	10:30	3 min
	(L) 4	11'	10:24	10:26	10:26	10:31	5 min
	5	4½'	10:41	10:44	10:44	10:49	5 min
	(L) 6	11½'	10:42	10:44	10:44	10:47	3 min
	7	9½'	(Visual	[illegible]	[illegible]	[illegible])	(Bogg [illegible])
						6	28	15 min

REMARKS

TYPE OF SOIL Shale + Clay

TESTED BY C B [illegible] ALSO PRESENT: P Bra[illegible] + Men