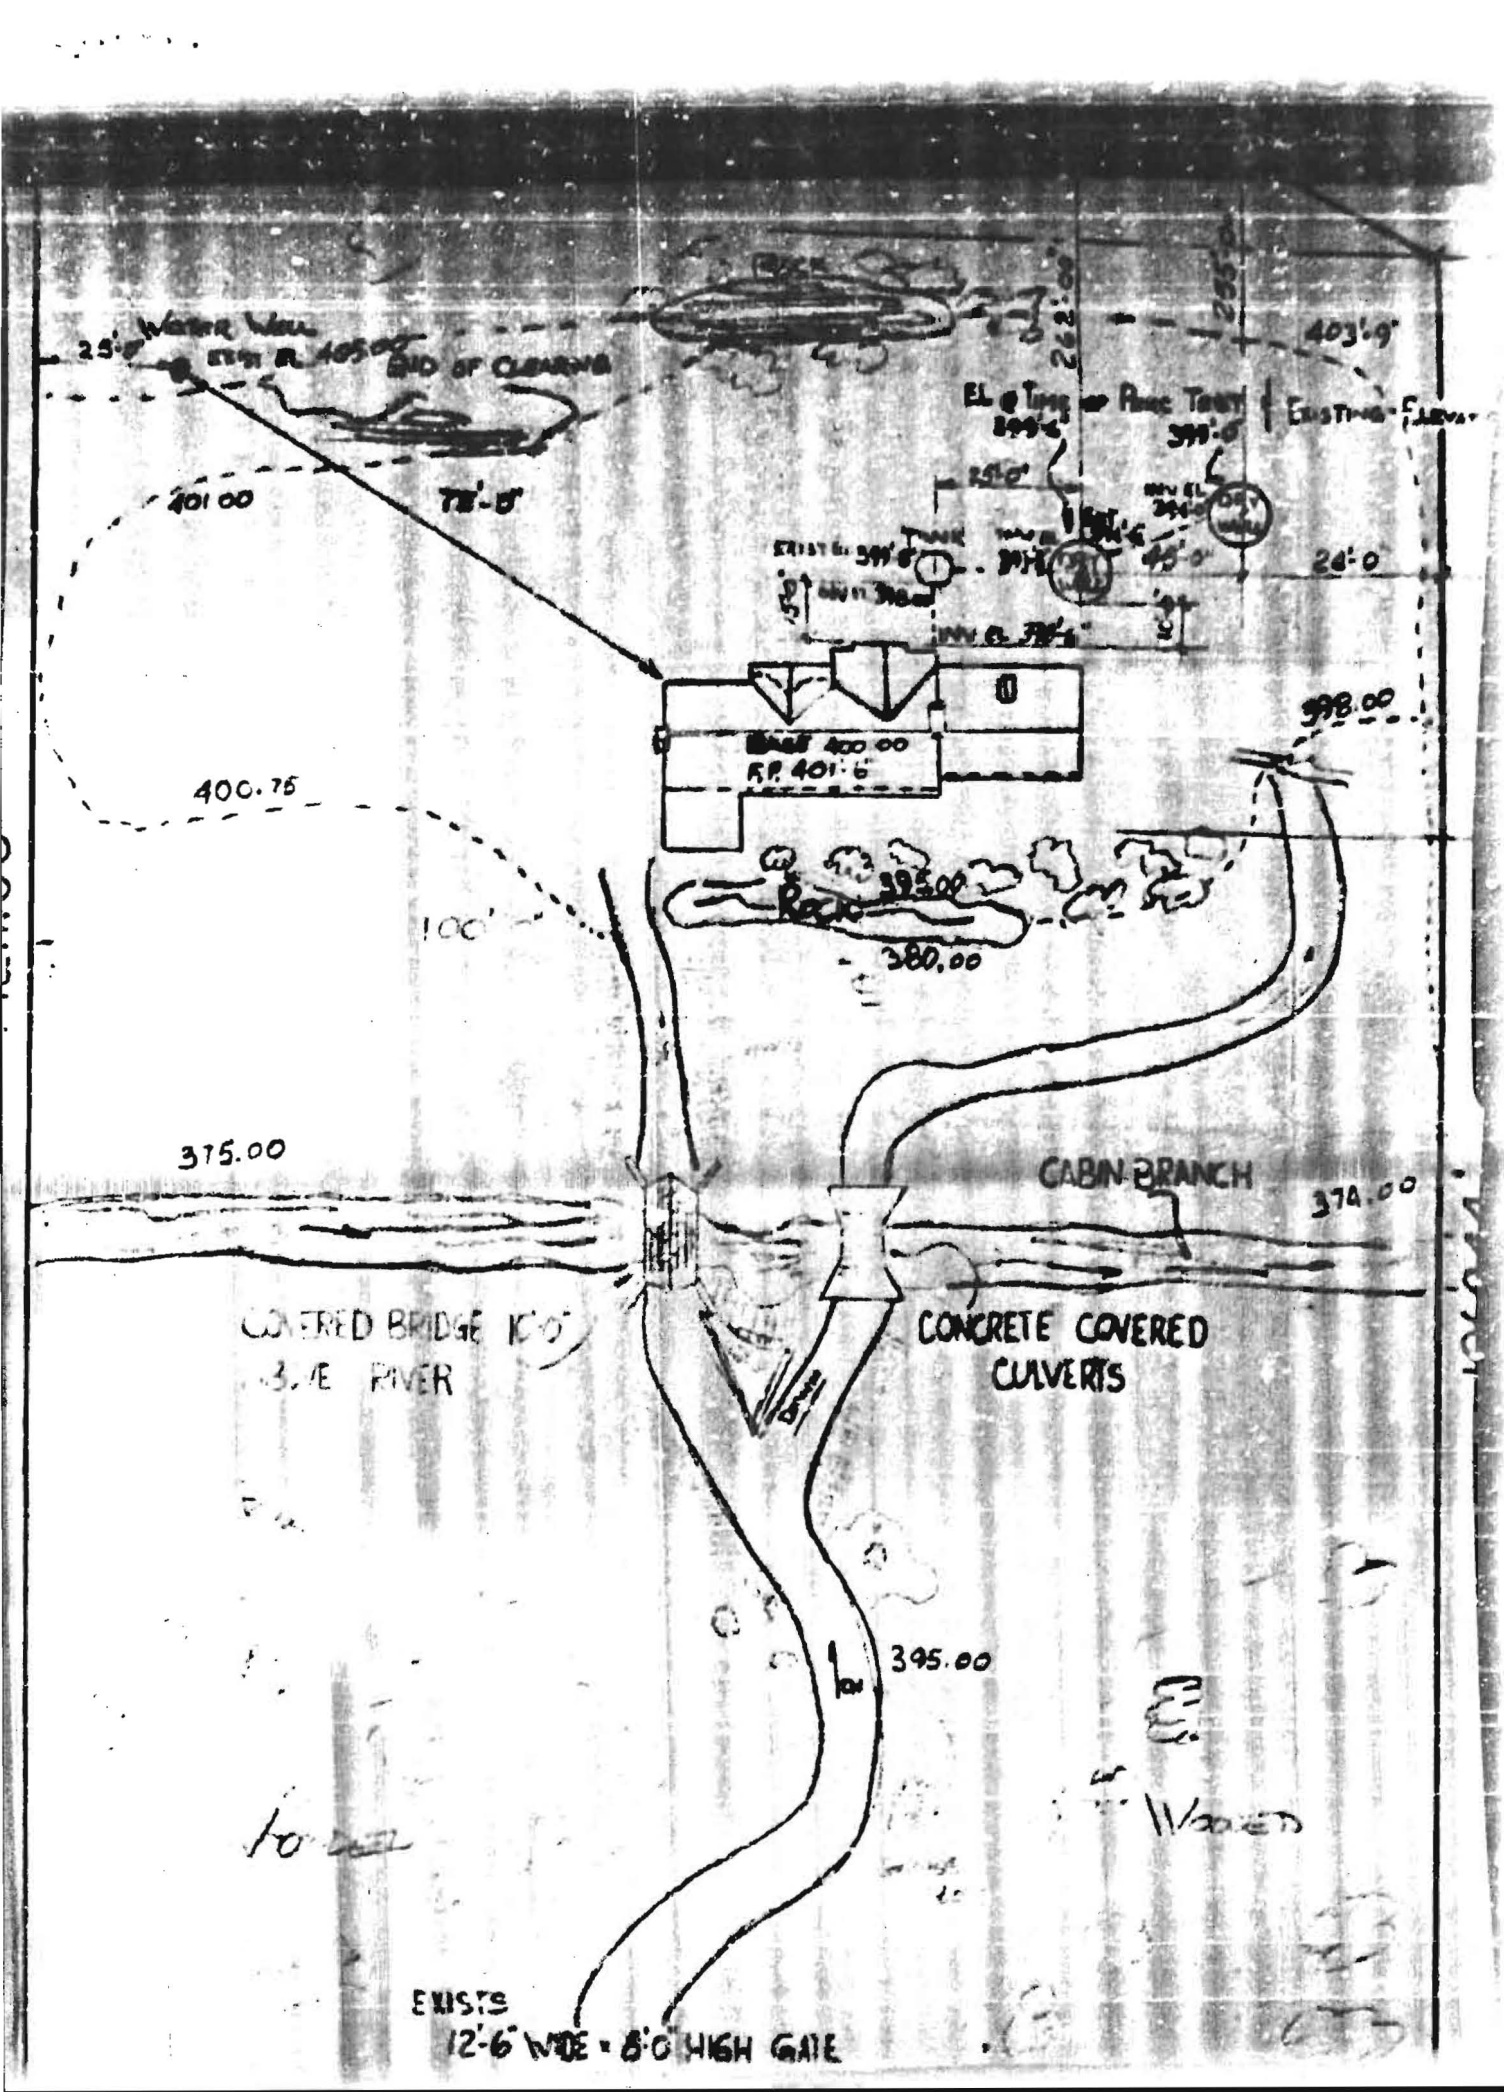

Water Well
25'-0"
END OF CLEARING
403'-9"
401.00
78'-0"
24'-0"
398.00
400.75
395.00
Rock
380.00
100'
375.00
CABIN BRANCH
374.00
COVERED BRIDGE 10'-0"
RIVER
CONCRETE COVERED
CULVERTS
395.00
EXISTS
12'-6" WIDE × 8'-0" HIGH GATE