


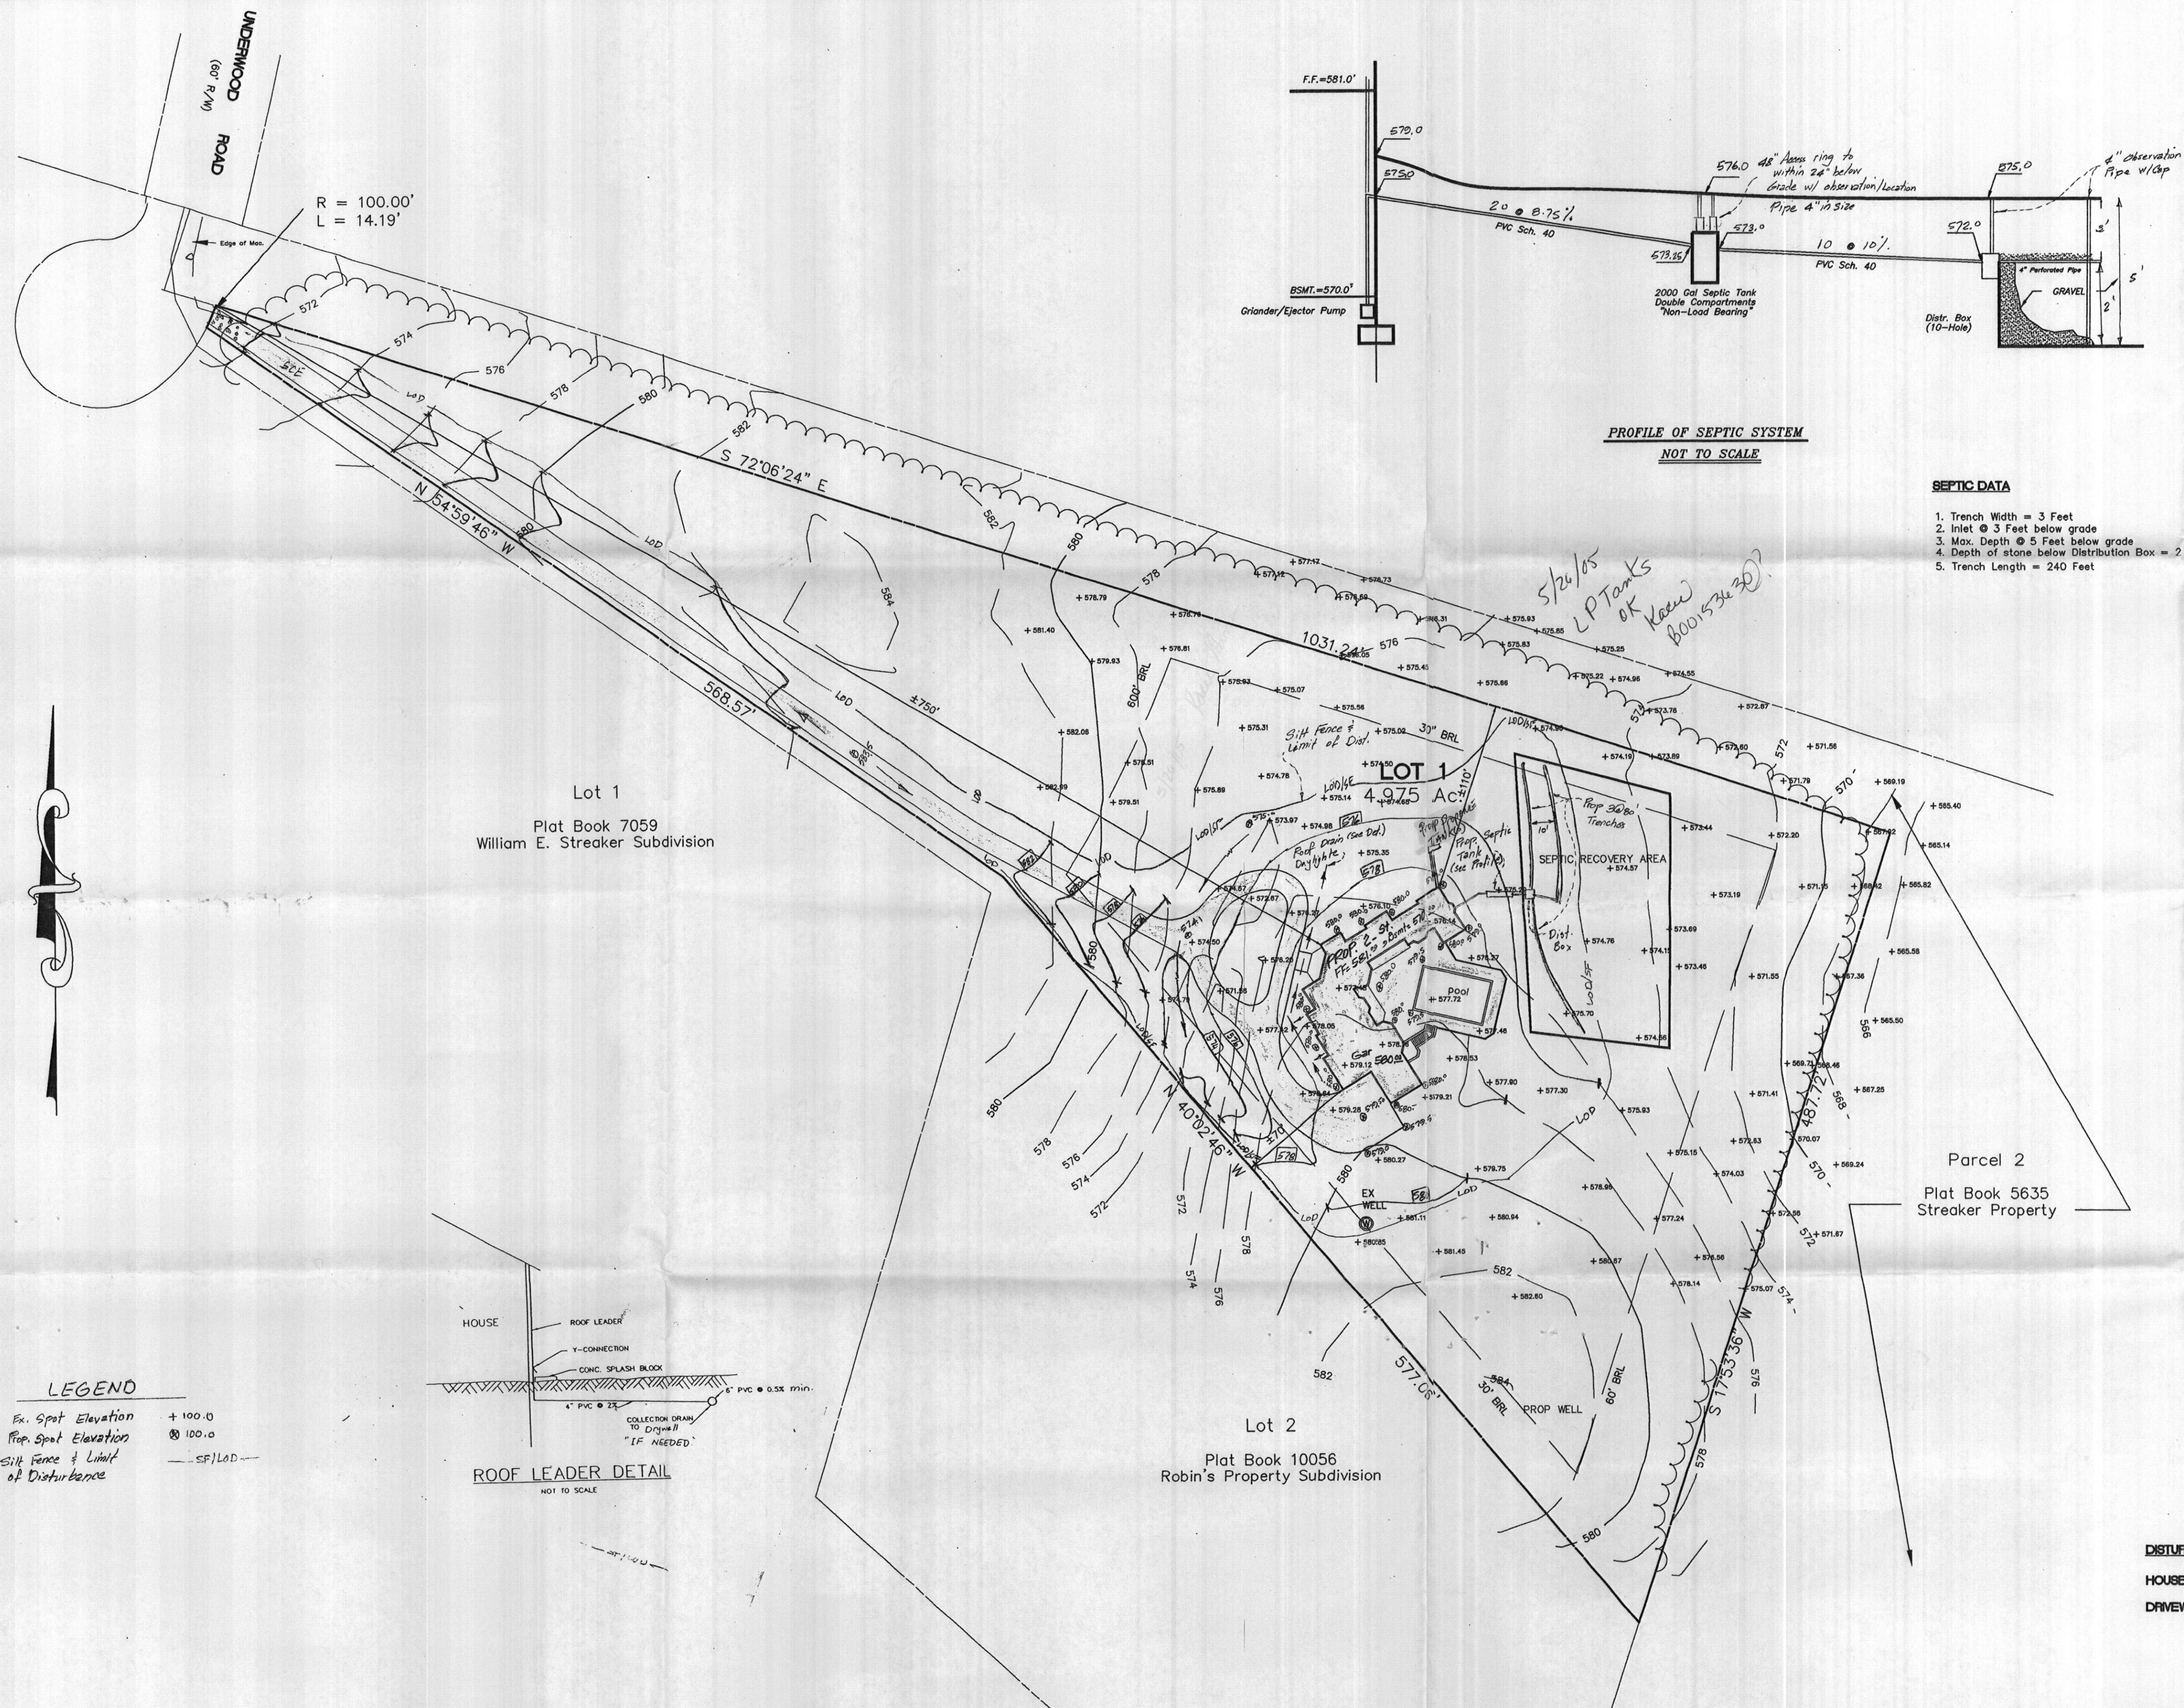

DESIGNED:	DATE:	BY:	REVISIONS
ZMS	June 00		
DRAWN:	DATE:		
CHECKED:	DATE:		
APPROVED:	DATE:		

APPLIED CIVIL ENGINEERING INC.

ENGINEERING * PLANNING * SURVEYING * LAND DEVELOPMENT & PERMIT PROCESSING

9470 ANNAPOLIS ROAD, SUITE 414
LANHAM, MARYLAND 20706
TEL. (301) 459-5932

OWNER/APPLICANT/DEVELOPER

KEN & DORISCINE BROWN
P.O. Box 130
Lanham, MD 20706
(301) 352-9830

SCALE: 1" = 50'

SITE DEVELOPMENT PLAN

Underwood Road
Lot 1

ROBIN'S PROPERTY

Third Election District
Howard County, Maryland

CONTRACT No.: 00-15
SHEET 1 OF 1