WELL COMPLETION REPORT

(THIS NUMBER IS TO BE PUNCHED IN COLS. 3-6 ON ALL CARDS)

FILL IN THIS FORM COMPLETELY
PLEASE PRINT OR TYPE

COUNTY NUMBER A09446

DATE Received

DATE WELL COMPLETED C 11 16 84

Depth of Well 200 (TO NEAREST FOOT)

PERMIT NO. FROM "PERMIT TO DRILL WELL" W0-81-0814

OWNER L.EBLING (last name) DICK (first name)

STREET OR RFD LOCHRIDGE RD TOWN COLUMBIA

SUBDIVISION BRAE BURN SECTION LOT 43

WELL LOG
Not required for driven wells

STATE THE KIND OF FORMATIONS PENETRATED, THEIR COLOR, DEPTH, THICKNESS AND IF WATER BEARING

DESCRIPTION (Use additional sheets if needed)	FEET FROM	FEET TO	Check if water bearing
Top Soil	0	2	
Clay	2	4	
Shale	4	12	
Sand Stone	12	22	
Granite	22	32	
Sand Stone	32	35	
Granite	35	38	1
Sandstone	38	40	
Granite	40	80	1
Sand stone	80	82	
Granite	82	210	

Approx pump test 3hrs 1-16-85

CIRCLE APPROPRIATE LETTER
- A A WELL WAS ABANDONED AND SEALED WHEN THIS WELL WAS COMPLETED
- E ELECTRIC LOG OBTAINED
- P TEST WELL CONVERTED TO PRODUCTION WELL

I HEREBY CERTIFY THAT THIS WELL HAS BEEN CONSTRUCTED IN ACCORDANCE WITH COMAR 10.17.13 "WELL CONSTRUCTION" AND IN CONFORMANCE WITH ALL CONDITIONS STATED IN THE ABOVE CAPTIONED PERMIT, AND THAT THE INFORMATION PRESENTED HEREIN IS ACCURATE AND COMPLETE TO THE BEST OF MY KNOWLEDGE.

DRILLERS IDENT. NO. 40

DRILLERS SIGNATURE (MUST MATCH SIGNATURE ON APPLICATION)

SITE SUPERVISOR (sign. of driller or journeyman responsible for sitework if different from permittee)

GROUTING RECORD

WELL HAS BEEN GROUTED (Circle Appropriate Box) YES (Y) NO (N)

TYPE OF GROUTING MATERIAL

CEMENT (CM) BENTONITE CLAY (BC)

NO. OF BAGS 6 NO. OF POUNDS 600

GALLONS OF WATER 55

DEPTH OF GROUT SEAL (to nearest foot)

from 0 (TOP) ft. to 24 (BOTTOM) ft.

(enter 0 if from surface)

CASING RECORD

casing types Insert appropriate code below

ST STEEL CO CONCRETE PL PLASTIC OT OTHER

MAIN CASING TYPE	Nominal diameter top (main) casing (nearest inch)	Total depth of main casing (nearest foot)
ST	6	26

OTHER CASING (if used) — EACH CASING

diameter inch	depth (feet) from	to

SCREEN RECORD

screen type or open hole Insert appropriate code below

ST STEEL BR BRASS BRONZE HO OPEN HOLE PL PLASTIC OT OTHER

C 2

DEPTH (nearest ft.) — EACH SCREEN

1	110	240 to 200
2		
3		

SLOT SIZE 1 ____ 2 ____ 3 ____

DIAMETER OF SCREEN ____ (NEAREST INCH)

GRAVEL PACK from ____ to ____

IF WELL DRILLED WAS FLOWING WELL INSERT F IN BOX 68

OEP USE ONLY (NOT TO BE FILLED IN BY DRILLER)

T TELESCOPE CASING (E.R.O.S.) LOG INDICATOR WO OTHER DATA

C 3

PUMPING TEST

HOURS PUMPED (nearest hour) 3

PUMPING RATE (gal. per min. to nearest gal.) 4

METHOD USED TO MEASURE PUMPING RATE BUCKET

WATER LEVEL (distance from land surface)

BEFORE PUMPING 31

WHEN PUMPING 103

TYPE OF PUMP USED (for test)

A air P piston T turbine C centrifugal R rotary O other (describe below) J jet S submersible

PUMP INSTALLED

DRILLER WILL INSTALL PUMP (CIRCLE) (YES or NO) YES (NO)

IF DRILLER INSTALLS PUMP, THIS SECTION MUST BE COMPLETED FOR ALL WELLS EXCEPT HOME USE

TYPE OF PUMP INSTALLED PLACE (A,C,J,P,R,S,T,O) IN BOX - SEE ABOVE:

CAPACITY: GALLONS PER MINUTE (to nearest gallon)

PUMP HORSE POWER

PUMP COLUMN LENGTH (nearest ft.)

CASING HEIGHT (circle appropriate box and enter casing height) + above / − below LAND SURFACE 2 (nearest foot)

LOCATION OF WELL ON LOT

SHOW PERMANENT STRUCTURE SUCH AS BUILDING, SEPTIC TANKS, AND/OR LANDMARKS AND INDICATE NOT LESS THAN TWO DISTANCES (MEASUREMENTS TO WELL)

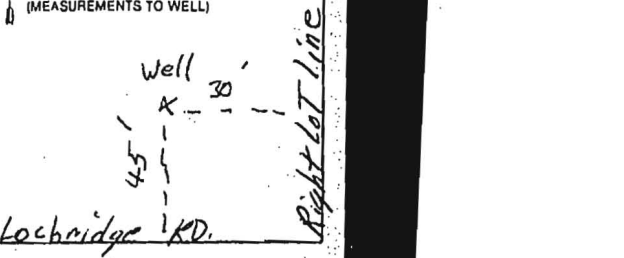

ORIGINAL