PUB. SEWER STATUS VERIFIED BY _____

ISSUE DATE: 4/14/05

APPROVAL DATE: 5/5/05

PERMIT

INDEXED

03285464

P 522093

522093

A REPAIR

ON-SITE SEWAGE DISPOSAL SYSTEM
HOWARD COUNTY HEALTH DEPARTMENT
BUREAU OF ENVIRONMENTAL HEALTH

Fyock Septic Service IS PERMITTED TO INSTALL ☐ ALTER ☒

ADDRESS: PO Box 89, Glenelg 21737 PHONE NUMBER: 410-988-9270

SUBDIVISION: Woodmark LOT NUMBER: _____

ADDRESS: 12249 Carroll Mill Road PROPERTY OWNER: French

SEPTIC TANK CAPACITY (GALLONS): 1500 - 2 Comp.

PUMP CHAMBER CAPACITY (GALLONS): N/A

NUMBER OF BEDROOMS: 4

SQUARE FEET PER BEDROOM: 210

LINEAR FEET OF TRENCH REQUIRED: 130'

Trench 2' Wide
Inlet 4.5'
Bottom 9'
2-65' Trenches


TRENCHES:	Trench to be feet wide. Inlet feet below original grade. Bottom maximum depth feet below original grade. Effective area begins at feet below original grade. feet of stone below distribution pipe.
LOCATION:	
PURPOSE:	Existing septic system has failed. Call for inspection when ground is opened so sanitarian can recommend repair.

PLANS APPROVED: _____ DATE: _____

NOTE: PERMIT VOID AFTER 2 YEARS
NOTE: CONTRACTOR RESPONSIBLE FOR SCHEDULING A PRE-CONSTRUCTION INSPECTION FOR ALL INSTALLATIONS
NOTE: WATERTIGHT SEPTIC TANKS REQUIRED
NOTE: ALL PARTS OF SEPTIC SYSTMEM SHALL BE 100 FEET FROM ANY WATER WELL
NOTE: MANHOLE RISERS REQUIRED ON ALL SEPTIC TANKS AND PUMP CHAMBERS

NEITHER THE HOWARD COUNTY COUNCIL OR THE HEALTH DEPARTMENT IS RESPONSIBLE FOR THE SUCCESSFUL OPERATION OF ANY SYSTEM
PERMITTEE RESPONSIBLE FOR OBTAINING FINAL APPROVAL ON THIS PERMIT
CALL 410-313-2640 FOR INSPECTION OF SEPTIC SYSTEM

NOT TO SCALE

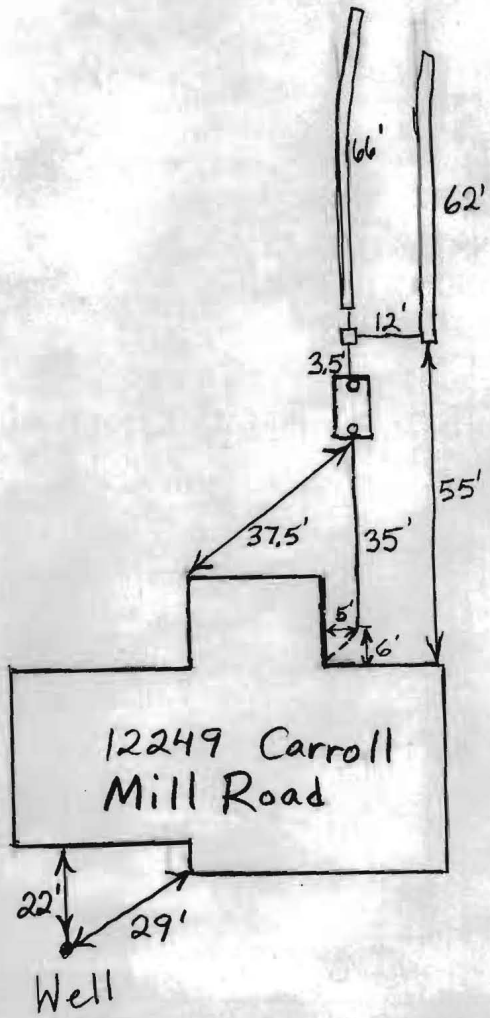

Carroll Mill ROAD

TRENCH/DRAINFIELD DATA

WIDTH	INLET	BOTTOM
2'	4.5'	9'

NUMBER OF TRENCHES 2
TOTAL LENGTH 128'
ABSORPTION AREA 576 sq. ft.
DISTRIBUTION BOX LEVEL Yes
DISTRIBUTION BOX BAFFLE Bricks
DISTRIBUTION BOX PORT No

SEPTIC TANK DATA

SEPTIC TANK 1 LEVEL Yes
2-Comp. CAPACITY 1500 GAL
SEAM LOC Top
TANK LID DEPTH 1.5'-2'
BAFFLES Yes
BAFFLE FILTER No
MANHOLE LOC None
6" PORT LOC Front+Rear
WATERTIGHT TEST No
SEPTIC TANK 2 LEVEL N/A
CAPACITY _____ GAL
SEAM LOC _____
TANK LID DEPTH _____
BAFFLES _____
BAFFLE FILTER _____
MANHOLE LOC _____
6" PORT LOC _____
WATERTIGHT TEST _____

PRE-CONSTRUCTION 4/19/05 Start the first trench directly downhill of the perc test hole. Run 2 trenches on
INSTALLATION contour into the woods (BB) 5/4/05 Drywell and tank pumped out per Robert Fryock. Tank and dist. box and 1 trench done. (BB) 5/5/05 Second trench done, O.K. to cover everything (BB)

FINAL INSPECTOR B Baker DATE OF APPROVAL 5/5/05