Final Approved C.B.D.

INDEXED

PERMIT

P 1646

A 12972

SEWAGE DISPOSAL SYSTEM

MARYLAND STATE DEPARTMENT OF HEALTH

HOWARD COUNTY ELLICOTT CITY

DISTRICT 3

DATE 10/27/71

Jack Fyock IS PERMITTED TO INSTALL X ALTER

ADDRESS Ten Oaks Road, Glenelg, Maryland PHONE 286-2939

A SEWAGE DISPOSAL SYSTEM LOCATED AT

12249

SUBDIVISION Woodmark, Inc. ROAD Carrollhill Rd. LOT 14, Blk. B Sec. 2

PROPERTY OWNER Mark Wakefield, Jr. Mr. Fessel

ADDRESS 231 Chatham Rd., Ellicott City, Md.

SPECIFICATIONS 4 Bedrooms

GRAIN FIELD ____ DEPTH ____ FEET, BOTTOM AREA ____ SQ. FT.

SEEPAGE PITS ____ ABSORBENT SIDE-WALL AREA ____ SQ. FT.

SEPTIC TANK CAPACITY 1250 GALLONS

FOR GARBAGE GRINDER, INCREASE DISPOSAL AREA 25% & TANK CAPACITY 50%.


OTHER Dry Well - 112 sq. ft. absorbent sidewall area per bedroom to begin below inlet pipe. Inlet pipe 4 ft. below original grade. Max. depth permitted for dry well below original grade is 11 ft.
Place dry well about 165 ft. from front lot line and about 40 ft. from ~~right sideline as seen when facing from Carroll Hill Road.~~
NOTE: ALL PIPE FROM HOUSE TO SEPTIC TANK MUST BE CAST IRON.
~~PERMIT VOID AFTER THREE YEARS.~~
NOTE: INSTALL STAND PIPE ON SEPTIC TANK AND DRY WELL.

PLANS APPROVED BY D. W. Monaghan DATE 3/12/68

FILL SEPTIC TANK AND DISTRIBUTION BOX WITH WATER BEFORE CALLING FOR AN INSPECTION. COVER NO WORK UNTIL INSPECTED AND APPROVED.

NEITHER THE HOWARD COUNTY COMMISSIONERS NOR THE HEALTH DEPARTMENT IS RESPONSIBLE FOR THE SUCCESSFUL OPERATION OF ANY SYSTEM.

A-12972

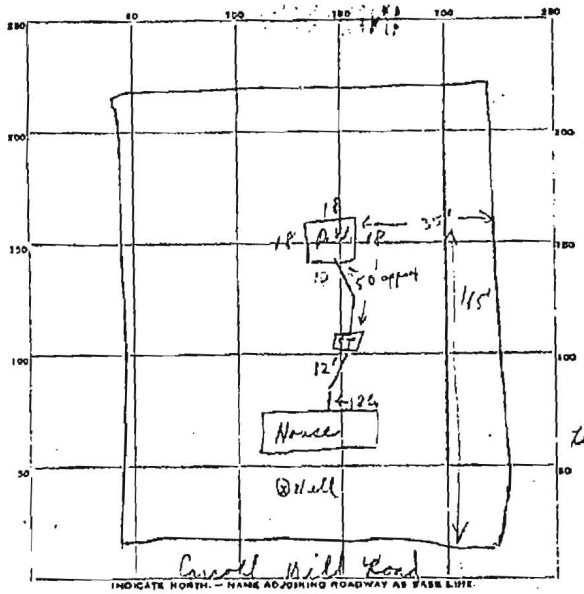

PERMIT CARD Signed

SEPTIC TANK, LEVEL OK

CLEANOUTS ST. OK | R.W. OK

DISTRIBUTION BOX, LEVEL

TILE FIELD, DEPTH ____ FT. TRENCH WIDTH ____ FT.

GRAVEL DEPTH ____ IN. TOTAL LENGTH ____ FT.

NUMBER OF TRENCHES ____ TOTAL BOTTOM AREA ____

SEEPAGE PITS, INSIDE DIAMETER 72 FT. DEPTH BELOW INLET 7 FT.

ABSORBENT AREA 504 SQ. FT.

REMARKS

DATE SYSTEM APPROVED 11/16/01 INSPECTOR C. Strecker