

<b>C1</b> <b>506</b>		SEQUENCE NO. (MDE USE ONLY)		<b>STATE OF MARYLAND</b> <b>WELL COMPLETION REPORT</b> FILL IN THIS FORM COMPLETELY PLEASE TYPE				THIS REPORT MUST BE SUBMITTED WITHIN 45 DAYS AFTER WELL IS COMPLETED.					
1 2 3 6 (THIS NUMBER IS TO BE PUNCHED IN COLS. 3-6 ON ALL CARDS)								COUNTY NUMBER		A514193			
ST/CO USE ONLY DATE Received MM DD YY		DATE WELL COMPLETED MM DD YY		Depth of Well 22 245 26 514/05 (TO NEAREST FOOT)				PERMIT NO. FROM "PERMIT TO DRILL WELL" 10-94-4174					
8 13		15 20						28 29 30 31 32 33 34 35 36 37					
OWNER last name first name		Toll Brus		TOWN				Chesley					
STREET OR RFD		Tridelpia Rd		SECTION				21/23/97					
SUBDIVISION		Tweed Cross		LOT				25					
<b>WELL LOG</b> Not required for driven wells				<b>GROUTING RECORD</b>				<b>C3</b>					
STATE THE KIND OF FORMATIONS PENETRATED, THEIR COLOR, DEPTH, THICKNESS AND IF WATER BEARING				WELL HAS BEEN GROUTED (Circle Appropriate Box)				PUMPING TEST					
DESCRIPTION (Use additional sheets if needed)				TYPE OF GROUTING MATERIAL (Circle one)				HOURS PUMPED (nearest hour)					
CEMENT <b>C</b> BENTONITE CLAY <b>B</b>				NO. OF BAGS 15 NO. OF POUNDS 1245				PUMPING RATE (gal. per min.) 5					
GALLONS OF WATER 85				DEPTH OF GROUT SEAL (to nearest foot)				METHOD USED TO MEASURE PUMPING RATE Time/Back					
FROM TO				from 48 TOP 52 ft. to 54 BOTTOM 58 ft. (enter 0 if from surface)				WATER LEVEL (distance from land surface)					
Dir + 0 53				casing types insert appropriate code below				BEFORE PUMPING 46 ft.					
Hard Clay 53 157				STEEL <b>ST</b> CONCRETE <b>CO</b>				WHEN PUMPING 138 ft.					
Chips 157 160				PLASTIC <b>PL</b> OTHER <b>OT</b>				TYPE OF PUMP USED (for test)					
Hard Clay 160 225				MAIN CASING TYPE				<b>A</b> air <b>P</b> piston <b>T</b> turbine					
Chips 225 230				Nominal diameter top (main) casing (nearest inch) 6				<b>C</b> centrifugal <b>R</b> rotary <b>O</b> other (describe below)					
Hard Clay 230 245				Total depth of main casing (nearest foot) 55				<b>J</b> jet <b>S</b> submersible					
				OTHER CASING (if used)				PUMP INSTALLED					
				EACH CASING diameter inch depth (feet) from to				DRILLER INSTALLED PUMP YES NO					
				PL 4 1/2 145 165				IF DRILLER INSTALLS PUMP, THIS SECTION MUST BE COMPLETED FOR ALL WELLS.					
				PL 4 1/2 220 240				TYPE OF PUMP INSTALLED PLACE (A,C,J,P,R,S,T,O) IN BOX 29.					
				SCREEN RECORD				CAPACITY: GALLONS PER MINUTE (to nearest gallon)					
				screen type or open hole insert appropriate code below				PUMP HORSE POWER					
				STEEL <b>ST</b> BRASS <b>BR</b> OPEN HOLE <b>HO</b>				PUMP COLUMN LENGTH (nearest ft.)					
				BRONZE <b>PL</b> OTHER <b>OT</b>				CASING HEIGHT (circle appropriate box and enter casing height)					
				DEPTH (nearest ft.)				LAND SURFACE					
				1 2 below (nearest foot)					
				SLOT SIZE 1 2 3				LOCATION OF WELL ON LOT					
				DIAMETER OF SCREEN (NEAREST INCH)				SHOW PERMANENT STRUCTURE SUCH AS BUILDING, SEPTIC TANKS, AND /OR LANDMARKS AND INDICATE NOT LESS THAN TWO DISTANCES (MEASUREMENTS TO WELL)					
				GRAVEL PACK IF WELL DRILLED WAS FLOWING WELL INSERT F IN BOX 68									
				MDE USE ONLY (NOT TO BE FILLED IN BY DRILLER)									
				T (E.R.O.S.) W Q									
				70 72 74 75 76									
				TELESCOPE CASING LOG INDICATOR OTHER DATA									
DRILLERS LIC. NO. M D 355				DRILLERS SIGNATURE									
LIC. NO. M D 553				SITE SUPERVISOR (sign. of driller or journeyman responsible for sitework if different from permittee)									

<b>B 1</b> <div style="border: 1px solid black; padding: 2px; font-size: 24px; font-weight: bold;">5316</div>	SEQUENCE NO. (MDE USE ONLY)	<b>STATE OF MARYLAND</b> <b>APPLICATION FOR PERMIT TO DRILL WELL</b> please type <div style="font-size: 24px; font-weight: bold;">521975</div>	STATE PERMIT NUMBER <div style="font-size: 24px; font-weight: bold;">HD-94-4174</div>
Date Received (APA) <div style="border: 1px solid black; padding: 2px;">           8 MM DD YY 13  <div style="font-size: 24px; font-weight: bold;">Toll Bros Inc</div> <div style="font-size: 24px; font-weight: bold;">7164 Columbia Gateway Dr</div> <div style="font-size: 24px; font-weight: bold;">Columbia MD 21046</div> </div>		<b>B 3</b> <b>LOCATION OF WELL</b> <div style="border: 1px solid black; padding: 2px;">           8 COUNTY <u>Howard</u> 21            23 SUBDIVISION <u>Teradaphia Crossing</u> 42            SECTION <u>2</u> 44 46 LOT <u>25</u> 48 50            52 NEAREST TOWN <u>Glenely</u> 27439            MILES FROM TOWN (enter 0 if in town) <u>1/2</u> M 73 76 77 78         </div>	
<b>OWNER INFORMATION</b> <div style="border: 1px solid black; padding: 2px;">           15 Last Name <u>Toll</u> Owner First Name <u>Bros Inc</u> 34            36 Street or RFD <u>7164 Columbia Gateway Dr</u> 55            57 Town <u>Columbia</u> 70 State <u>MD</u> 72 Zip <u>21046</u> 76         </div>		<b>B 4</b> <b>WELL INFORMATION</b> <div style="border: 1px solid black; padding: 2px;">           1 Driller's Name <u>Michael Barlow</u> 76 License No. <u>M D 355</u> 81            2 Firm Name <u>Michael Barlow Well Drilling Inc</u>            Address <u>523 Underwood Lane, Bel Air MD</u>            Signature <u>[Signature]</u> Date <u>1/18/05</u> 21014         </div>	
<b>DRILLER INFORMATION</b> <div style="border: 1px solid black; padding: 2px;">           1 APPROX. PUMPING RATE (GAL. PER MIN.) <u>5</u> 8 12            AVERAGE DAILY QUANTITY NEEDED (GAL. PER DAY) <u>500</u> 14 20         </div>		<div style="border: 1px solid black; padding: 2px;">           11 NEAR WHAT ROAD <u>Teradaphia Rd</u> 30            ON WHICH SIDE OF ROAD (CIRCLE APPROPRIATE BOX)  <div style="display: flex; justify-content: space-around;"> <div style="text-align: center;">             NORTH N W 8-9 E 8-9 W 8 E 8 S 8-9 S 8-9 S 8           </div> <div style="text-align: center;">             TOWN  </div> <div style="text-align: center;">             SOUTH N 8-9 E 8-9 W 8 E 8 S 8-9 S 8-9 S 8           </div> </div>           34 DISTANCE FROM ROAD <u>17</u> 37 FT 38 39            ENTER FT OR MI            TAX MAP: <u>21</u> BLK: <u>23</u> PARCEL <u>92</u> </div>	
<b>USE FOR WATER (CIRCLE APPROPRIATE BOX)</b> <div style="border: 1px solid black; padding: 2px;"> <input checked="" type="radio"/> D DOMESTIC POTABLE SUPPLY &amp; RESIDENTIAL IRRIGATION  <input type="radio"/> F FARMING (LIVESTOCK WATERING &amp; AGRICULTURAL IRRIGATION)  <input type="radio"/> I INDUSTRIAL, COMMERCIAL, DEWATERING  <input type="radio"/> P PUBLIC WATER SUPPLY WELL  <input type="radio"/> T TEST, OBSERVATION, MONITORING  <input type="radio"/> G GEO-THERMAL         </div>		<b>NOT TO BE FILLED IN BY DRILLER HEALTH DEPARTMENT APPROVAL</b> <div style="border: 1px solid black; padding: 2px;">           COUNTY NAME <u>Howard</u> COUNTY NO <u>1514193</u>            STATE SIGNATURE _____ INSERT S →            DATE ISSUED <u>4/21/05</u> 41            43 MM DD YY 48 CO SIGNATURE <u>[Signature]</u> EXP. DATE <u>4/21/06</u>            NORTH GRID <u>519 000</u> 55 EAST GRID <u>797 000</u> 57 63         </div>	
APPROXIMATE DEPTH OF WELL <u>300</u> FEET 24 28 APPROXIMATE DIAMETER OF WELL <u>12</u> INCH 30 32		SHOW MAJOR FEATURES OF BOX & LOCATE WELL WITH AN X <div style="border: 1px solid black; padding: 2px;">           SOURCES OF DRILLING WATER            1. _____            2. _____            3. _____            WRITE THE BOX NUMBER FROM THE MAP HERE            E <u>797</u>            N <u>519</u>            000            000         </div>	
<b>METHOD OF DRILLING (circle one)</b> <div style="border: 1px solid black; padding: 2px;">           BORED (or Augered) _____ JETTED _____ Jetted &amp; DRIVEN _____            30 AIR-ROTary _____ AIR-PERCussion _____ ROTARY (Hydraulic Rotary) _____            37 CABLE _____ REVERSE-ROTary _____ DRIVE-POINT _____            other _____         </div>		DRAW A SKETCH BELOW SHOWING LOCATION OF WELL IN RELATION TO NEARBY TOWNS AND ROADS AND GIVE DISTANCE FROM WELL TO NEAREST ROAD JUNCTION <div style="border: 1px solid black; padding: 2px;"> </div>	
<b>REPLACEMENT OR DEEPEMED WELLS (CIRCLE APPROPRIATE BOX)</b> <div style="border: 1px solid black; padding: 2px;"> <input checked="" type="radio"/> N THIS WELL WILL NOT REPLACE AN EXISTING WELL  <input type="radio"/> Y THIS WELL WILL REPLACE A WELL THAT WILL BE ABANDONED AND SEALED            39 <input type="radio"/> S THIS WELL WILL REPLACE A WELL THAT WILL BE USED AS A STANDBY-CONTACT LOCAL APPROVING AUTHORITY FOR POLICY ON STANDBY WELLS  <input type="radio"/> D THIS WELL WILL DEEPEMED AN EXISTING WELL            PERMIT NUMBER OF WELL TO BE REPLACED OR DEEPEMED (IF AVAILABLE) 41 _____ 52         </div>		Not to be filled in by driller (MDE OR COUNTY USE ONLY) APPROP. PERMIT NUMBER <u>HD 2004-G005</u> PERMIT No. <u>HD-94-4174</u> 70 71 72 73 74 75 76 77 78 79	
<b>SPECIAL CONDITIONS</b> NOTE - APPROVING AUTHORITIES SHOULD USE SEPARATE SHEET IF NEEDED			

**MICHAEL BARLOW WELL DRILLING & SERVICE, INC.**  
**522 Underwood Lane**                      **Bel Air, Maryland 21014**  
**(410) 838-6910**                                **Fax (410) 838-3582**

## WELL YIELD REPORT

Date Test Completed:

May 2, 2005

**Well Depth:**

245 feet

Customer	TOLL BROTHERS, INC.
Road	TRIDELPHIA ROAD
City	GLENELG
State	MARYLAND 21737

Permit #	HO-94-4174
Subdivision	TRIADELPHIA CROSSING
Section	21/23/97
Lot #	25

[illegible]



Well Permit No. HO - 94-4134  
Location of property (road) Trindolphia Rd  
Subdivision Trindolphia Crossing Lot 25 Block 23 Plat 21 Sec. 97  
Well Driller Barber Owner Tom Barber

I. High rate pumping -- reservoir drawdown

II. Recovery pump test data - observations to be recorded every 15 minutes

[illegible]

HOWARD COUNTY HEALTH DEPARTMENT  
BUREAU OF ENVIRONMENTAL HEALTH  
WATER AND SEWERAGE PROGRAM  
TEL: (410)313-2640 FAX: (410)313-2648

Information Form for the Installation of the Well Pump, Pitless Adapter, and Supply Piping

NOTE: The installer is responsible for requesting an inspection prior to 9 am on the day of the desired inspection. No work is to be covered until approved by the Health Department. All installations must comply with the National Standard Plumbing Code (NSPC, as amended locally) and COMAR 26.04.04 (MD Well Construction Regulations). Submission of a complete form is required prior to Use and Occupancy approval.

Company Name: Barlow Well Drilling Telephone #: 410-838-6910  
Address: 322 Lindenwood Ln  
Beltair MD 21014

(Must circle one) Licensed Plumber Licensed Well Driller Licensed Well Pump Installer  
License # and name of individual responsible for the field installation:

Name (Print): Michael Barlow License# MJD 355

\*A licensed individual must perform the actual installation. Apprentices must be under the supervision of a licensed journeyman or master plumber, pump installer or well driller. Licenses may be subjected to field verification. Unlicensed individuals may be reported to the appropriate licensing agency.

Name of Property Owner: Toll Brothers Telephone #: 410-489-2275  
Subdivision: Triadelphia Crossing Lot #: 25 Well Tag #: HO-94-4174  
Site Address: \_\_\_\_\_

Submersible Pump Data

Make: STA Rite  
Model #: 53P4002+L  
Pump Capacity: 5 GPM  
Well Yield: 5 GPM

Pitless Adapter

Make: Cummins  
Model #: PA 500  
Depth: 42" (36" min)  
NSF/WSC approved: yes

Well Cap and Electric Conduit

Two piece watertight cap: yes  
Screened, vented well cap: yes  
Cap secured to casing: yes  
Conduit min 18" B.G.: yes  
Conduit secured to well cap: yes

Depth of well encountered at time of pump installation: 24.5 (feet)

If pump capacity exceeds well yield, a low water cut-off switch is required by NSPC 1990 Section 17.8.4

Torque arrestors, Cable guards, or other acceptable method used - Must circle one

Safety rope, if used, attached to brass rope adapter or other acceptable method inside of well casing

Piping to house

Type: Polyethylene  
PSI: 160 (160 psi min)  
Depth of supply line: 42" (36" min)

House Connection

PVC sleeve to undisturbed soil at wall penetration: yes  
Approximate length of sleeve: 10'  
Sleeve caulked and sealed properly: yes

The water supply line is required to be at least ten feet from the septic tank, pump chamber, sewage piping, distribution box, drainfields, and sewage reserve area. If this cannot be accomplished, contact this office for approval prior to installation.

Signature of company representative responsible for installation

5/31/06  
date

For Health Department Use Only - Not to be completed by Installer

Date Insp. Requested: \_\_\_\_\_ Date Insp. Approved: 6/1/06 Inspector: BB


Inspection Data: Pitless adapter watertight & water supply line at least 36" below grade ✓  
Two piece cap installed and attached to casing securely ✓  
Elec. conduit extends at least 18" below grade/attached to cap properly ✓  
Safety rope not seen outside of well cap/casing ✓  
Correct well tag attached properly and casing 8" above finished grade ✓  
Water supply line sleeved adequately at house connection ✓  
Adequate grout observed below pitless adapter ✓

VELD: ...

NON-BUILDABLE  
PRESERVATION PARCEL E  
PRIVATELY OWNED  
PRESERVATION EASEMENT  
HOLDERS ASSOCIATION EASEMENT HOLDER  
WARD COUNTY EASEMENT HOLDER

EXISTING  
FOREST CON  
EASEMENT  
PLAT NO.

N53°08'46"E 564.94'

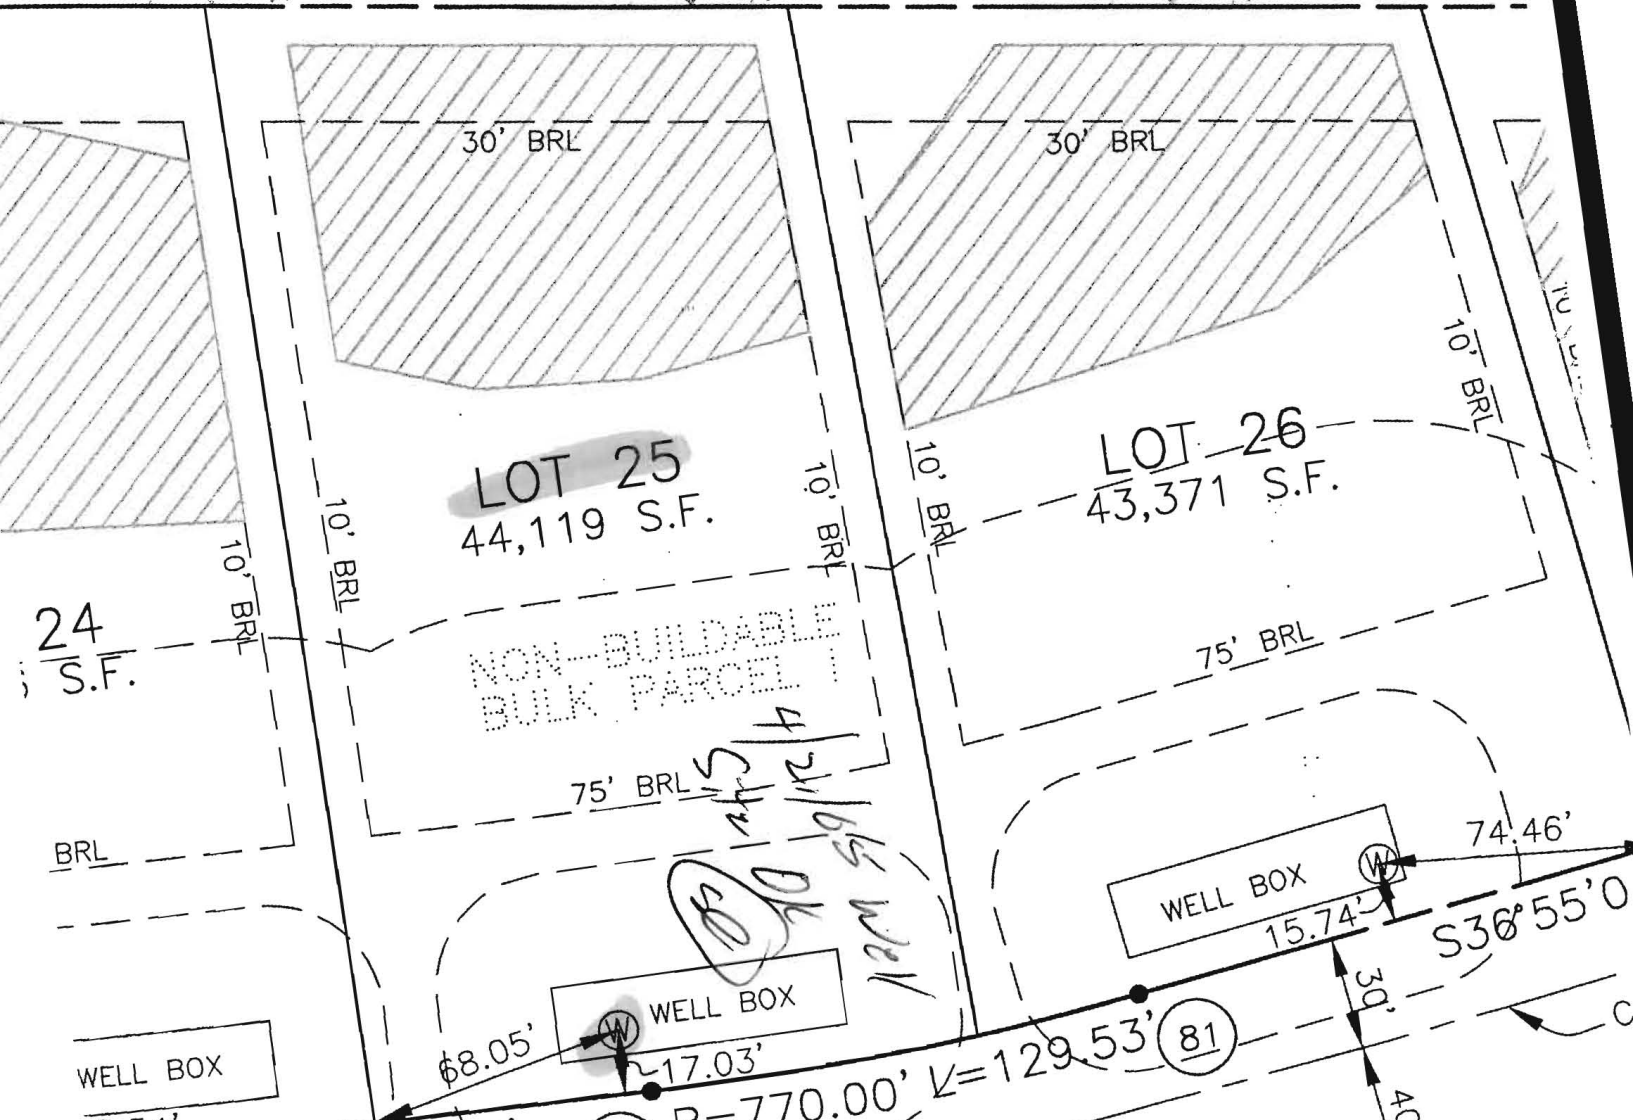

24  
S.F.

LOT 25  
44,119 S.F.

LOT 26  
43,371 S.F.

NON-BUILDABLE  
BULK PARCEL

BRL

WELL BOX

WELL BOX

WELL BOX

TRIADELPHIA ROAD  
(MINOR COLLECTOR)

205

ALLINX  
IND. WF

579.75


1,309.250

PARCEL T78  
N/F  
BOBBY A BLAKE

THE

EXISTING FOREST CONSERVATION EASEMENT # 6  
NON-BUILDABLE PRESERVATION PARCEL E  
PRIVATELY OWNED  
PRESERVATION EASEMENT  
HOMEOWNERS ASSOCIATION EASEMENT HOLDER  
HOWARD COUNTY EASEMENT HOLDER

5/2/06  
Well site  
located  
by surveyor  
(SEE SITE PLAN)  
(KN)

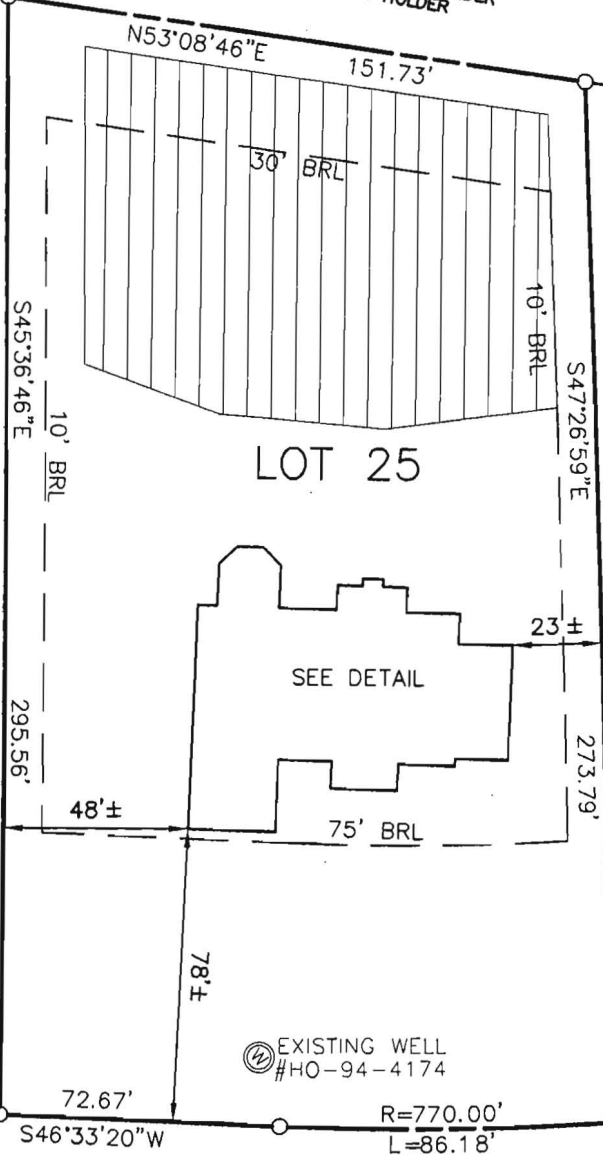

FIRST FLOOR ELEVATION = 584.7'  
OFFSET DIMENSIONS TO PROPERTY LINES ARE ± 1'

SURVEYOR'S CERTIFICATE

I HEREBY CERTIFY TO THE BEST OF MY PROFESSIONAL KNOWLEDGE, INFORMATION AND BELIEF, THAT THE DIMENSIONS OF THE BUILDING WALLS SHOWN HEREON ARE CORRECT; THAT THEY ARE BASED ON A FIELD RUN SURVEY PERFORMED BY BENCHMARK ENGINEERING, INC. ON 04/11/06 ; AND THAT THE PROPERTY OUTLINE SHOWN HEREON IS BASED ON THE PLAT PREPARED BY BENCHMARK ENGINEERING, INC. ENTITLED " TRIADELPHIA CROSSING PHASE TWO LOTS 23-27 ", AND RECORDED AMONG THE LAND RECORDS OF HOWARD COUNTY AS PLAT No.17723


*David M. Harris*

DAVID M. HARRIS  
REGISTERED PROFESSIONAL LAND SURVEYOR  
MD REG. No. 10978  
FOR BENCHMARK ENGINEERING, INC.  
MD REG. No. 351  
RECORD PLAT No. 17723  
FEMA FIRM No. 240044 0020 B  
ZONE: C  
DATED: 12/04/86

**BENCHMARK**  
ENGINEERS • LAND SURVEYORS • PLANNERS  
**ENGINEERING, INC.**

8480 BALTIMORE NATIONAL PIKE & SUITE 418  
ELLCOTT CITY, MARYLAND 21043

Phone: 410-465-5105 & 410-465-5544  
FAX: 410-465-5544  
PA1792 TRIADPHIA CROSSING.dwg, 4/13/2006 11:50:06 AM, cwf,  
[U]

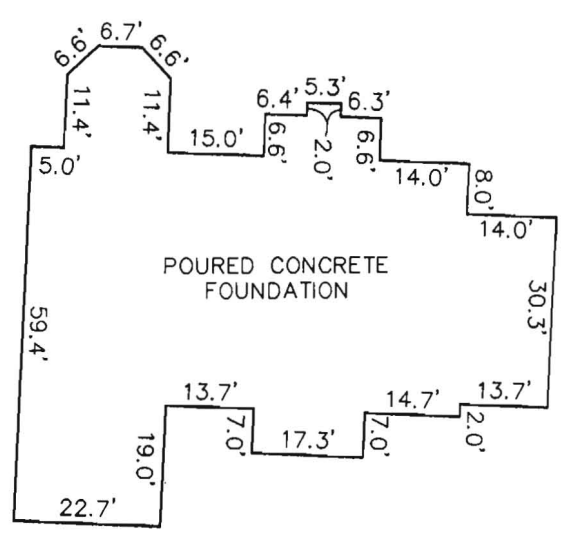

~FOUNDATION DETAIL~  
SCALE: 1" = 30'

WALL CHECK  
**TRIADELPHIA CROSSING**  
**PHASE TWO LOTS 23-27**  
LOT No. 25

14340 TRIADELPHIA ROAD

4TH ELECTION DISTRICT  
HOWARD COUNTY, MARYLAND

SCALE: 1" = 50' DATE: 04/11/06





Howard County  
Health Department

3525 H Ellicott Mills Drive, Ellicott City, MD 21043  
(410) 313-1771 Fax (410) 313-2648  
TDD (410) 313-2323 Toll Free 1-866-313-6300  
website: www.hchealth.org

Penny E. Borenstein, M.D., M.P.H., Health Officer

August 29, 2006

Toll Brothers, Inc.  
7164 Columbia Gateway Drive, #230  
Columbia, MD 21046

RE: Triadelphia Crossing, Lot 25  
14340 Triadelphia Road  
Glenelg, MD 21737  
BP #: B00156719  
Well Permit # HO-94-4174

Dear Sirs:

This is to advise you that the septic system for the above referenced property has been installed and inspected. **Final approval of the septic system was granted on 05/16/2006. Final approval of the well line connection to the dwelling was approved on 06/01/2006.**

The water sample results indicate that the water samples submitted for testing were free of coliform and fecal coliform bacteria at the time of sampling and are bacteriologically safe for drinking. The water sample results were found to be in compliance with COMAR water quality standards.

#### INTERIM CERTIFICATE OF POTABILITY

This certifies that the initial sampling requirements of COMAR 26.04.04 "Well Regulations" have been met for the water supply system installed under well permit #HO-94-4174. Although the submitted sample results are in compliance with COMAR standards, the Health Department does not guarantee water supplies. Based upon satisfactory investigation and evaluation, the Howard County Health Department as authorized by the Maryland Department of the Environment accepts this well system as required by COMAR 26.04.04.

This certificate may become final upon completion of the second bacteriological test, which is to be taken by the county health department within six months of receipt of this letter. **Please contact (410) 313-1773 to schedule a final water sample appointment. Currently, there is no charge for this final sampling.**

Date of Water Sample(s): 08/09/2006 & 08/28/2006  
Date of Well Completion: 05/02/2005

Approving Authority,

Brian Baker, R. S.  
Well & Septic Program

cc: Building Inspector's Office  
Community Health Services  
File



**FOUNTAIN VALLEY ANALYTICAL LABORATORY, INC.**

1413 Old Taneytown Rd. Westminster, MD (410) 848-1014 (410) 876-4554 FAX (410) 848-0298

**REPORT OF ANALYSIS**

Laboratory ID #:	63724	Account #:	1930
Reference:	Toll Brothers Lot 25	Company:	Fogle's Well Drilling
Location:	14340 Triadelphia Road	Requested By:	Dave Fogle
	Glenelg, MD 21737	Source:	Well Water
Date/ Time Collected:	6/15/2007 1030	Site:	Kitchen Sink Tap
Date/Time Rec'd:	6/15/2007 1205	Treatment:	Neutralizer/Softener
Chlorine ppm:	Free: ND Total: ND	pH:	7.1
Collected By:	V.M. Fadoul 6804VF-FS	Well #:	HO-94-4174

PARAMETERS	RESULTS	UNITS	REFERENCE	METHOD	DATE/TIME ANALYST
Bacteria, Coliform, Total, MPN	<1.0	MPN/ 100 ml	<1.0	SM18 9223 B.	6/16/2007 / 1000 / AD/BD
Bacteria, E. coli, MPN	<1.0	MPN/ 100 ml	<1.0	SM18 9223 B.	6/16/2007 / 1000 / AD/BD
Nitrate	3.83	mg/L	10	601	6/15/2007 / 1525 / AD/BD
Turbidity	1.03	NTU	<10	SM18 2130B	6/15/2007 / 1400 / AD/BD
Sand	NS	mg/l.	5	Visual/Gravimetr	6/15/2007 / 1400 / AD/BD

**NOTES:**


- 1 mg/L = milligrams per liter (also, parts per million)
- 2 MPN/ 100 ml = Most Probable Number [of viable bacteria] per 100 ml of sample.
- 3 NS = None Seen (NS indicates less than 5 mg/L)
- 4 NTU = Nephelometric Turbidity Units
- 5 Results less than or within the reference range are considered satisfactory and within potable water limits at the time of sampling.
- 6 ND:None Detected
- 7 Sample collected by client, analyzed as received
- 8 pH tested on-site

Reason for Test : Client's Information

Date Reported: 6/18/2007

Mar 02 05 03:15p

p. 2

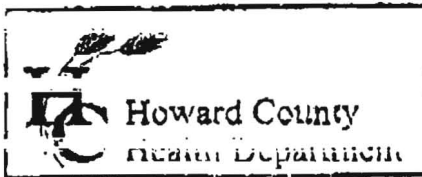

3525 H Ellicott Mills Drive, Ellicott City MD 21043  
 (410) 313-2640 Fax (410) 313-2648  
 TDD (410) 313-2373 Toll Free 1-866-213-4300  
 website: www.hchealth.org

Penny E. Borenstein, M.D., M.P.H., Health Officer

### TO ALL INTERESTED PARTIES

When submitting a well permit application for a proposed well for new construction, please indicate one of the following:

- ☒ The well site has been staked by ESE Eastern States Eng  
 (professional land surveyor or company employing professional land surveyors)  
 on Feb 22, 2005 (date) and does not require a site inspection.
- ☐ The well driller, builder or property owner will call the Health Department to schedule a time to meet in the field to verify the proposed well site location.

This sheet, along with two copies of an acceptable well site plan, must be attached to the green well permit application

Revised 6/10/03

Post-It® Fax Note	7671	Date	7 Mar 05	# of pages	1
To	Stuart	From	David Camer		
Co./Dept.		Co.			
Phone #		Phone #	410 872 9105		
Fax #	410 313 2648	Fax #			

For  
 Triadelphia  
 Crossing

Toll Bros

**FOUNTAIN VALLEY ANALYTICAL LABORATORY, INC.**

1413 Old Taneystown Rd. Westminster, MD (410) 848-1014 (410) 876-4554 FAX (410) 848-0298

**REPORT OF ANALYSIS**

Laboratory ID #:	60127	Account #:	1930
Reference:	Toll Brothers Lot 25	Company:	Fogle's Well Drilling
Location:	14340 Triadelphia Road	Requested By:	Dave Fogle
	Glenelg, MD 21737	Source:	Well Water
Date/ Time Collected:	8/9/2006 1200	Site:	Kitchen Sink Tap
Date/Time Rec'd:	8/9/2006 1355	Treatment:	None
Chlorine ppm:	Free: ND Total: ND	pH:	6.5
Collected By:	M. Dodd 6244MD	Well #:	HO-94-4174

PARAMETERS	RESULTS	UNITS	REFERENCE	METHOD	DATE/TIME/ANALYST
Bacteria, Coliform, Total, MPN	3.1	MPN/ 100 ml	<1.0	SM18 9223 B.	8/10/2006 / 0915 / BCD
Bacteria, E. coli, MPN	<1.0	MPN/ 100 ml	<1.0	SM18 9223 B.	8/10/2006 / 0915 / BCD
Nitrate	5.07	mg/L	10	601	8/9/2006 / 1400 / GN
Turbidity	0.96	NTU	<10	SM18 2130B	8/9/2006 / 1400 / GN
Sand	NS	mg/L	5	Visual/Gravimetric	8/10/2006 / 1400 / GN

**NOTES:**

- 1 mg/L = milligrams per liter (also, parts per million)
- 2 MPN/ 100 ml = Most Probable Number [of viable bacteria] per 100 ml of sample.
- 3 NS = None Seen (NS indicates less than 5 mg/L)
- 4 NTU = Nephelometric Turbidity Units
- 5 Results less than or within the reference range are considered satisfactory and within potable water limits at the time of sampling.
- 6 ND:None Detected
- 7 Sample collected by client, analyzed as received
- 8 pH tested on-site

Reason for Test : Use & Occupancy  
 Building Permit # : 156719

Date Reported: 8/14/2006

**FOUNTAIN VALLEY ANALYTICAL LABORATORY, INC.**

1413 Old Taneytown Rd. Westminster, MD (410) 848-1014 (410) 876-4554 FAX (410) 848-0298

**REPORT OF ANALYSIS**

Laboratory ID #:	60380	Account #:	1930
Reference:	Toll Brothers Lot 25	Company:	Fogle's Well Drilling
Location:	14340 Triadelphia Road	Requested By:	Dave Fogle
	Glenelg, MD 21737	Source:	Well Water
Date/ Time Collected:	8/28/2006 0900	Site:	Kitchen Sink Tap
Date/Time Rec'd:	8/28/2006 1620	Treatment:	None
Chlorine ppm:	Free: ND Total: ND	pH:	6.6
Collected By:	M. Dodd 6244MD	Well #:	HO-94-4174

PARAMETERS	RESULTS	UNITS	REFERENCE	METHOD	DATE/TIME ANALYST
Bacteria, Coliform, Total, MPN	<1.0	MPN/ 100 ml	<1.0	SM18 9223 B.	8/29/2006 / 1030 / AMD/BCD
Bacteria, E. coli, MPN	<1.0	MPN/ 100 ml	<1.0	SM18 9223 B.	8/29/2006 / 1030 / AMD/BCD

**NOTES:**

- 1 MPN/ 100 ml = Most Probable Number [of viable bacteria] per 100 ml of sample.
- 2 Results less than or within the reference range are considered satisfactory and within potable water limits at the time of sampling.
- 3 ND:None Detected
- 4 Sample collected by client, analyzed as received
- 5 pH tested on-site

Reason for Test : Use & Occupancy retest 60127  
 Building Permit # : 156719

Date Reported: 8/29/2006