EMERGENCY/TEMP NO. IF ANY M12000959

B 1 | 18602 | SEQUENCE NO. (MDE USE ONLY)

STATE OF MARYLAND
APPLICATION FOR PERMIT TO DRILL WELL
please type

5346

STATE PERMIT NUMBER: Ho-95-2398

fill in this form completely

Date Received (APA): 01312

OWNER INFORMATION

Scott (Last Name) Charlie (First Name)

5312 Aerie Ct (Street or RFD)

Clarksville (Town) MD (State) 21029 (Zip)

DRILLER INFORMATION

Michael Bowlus MD D355 (Driller's Name, License No.)

Bowlus Well Drilling (Firm Name)

522 Underwood Lane 21784 (Address)

Signature 9/4/12 (Date)

B 2 WELL INFORMATION

APPROX. PUMPING RATE (GAL. PER MIN.): 0

AVERAGE DAILY QUANTITY NEEDED (GAL. PER DAY): 0

USE FOR WATER (CIRCLE APPROPRIATE BOX)

- D DOMESTIC POTABLE SUPPLY & RESIDENTIAL IRRIGATION
- F FARMING (LIVESTOCK WATERING & AGRICULTURAL IRRIGATION)
- I INDUSTRIAL, COMMERCIAL, DEWATERING
- P PUBLIC WATER SUPPLY WELL
- T TEST, OBSERVATION, MONITORING
- O OPEN LOOP GEOTHERMAL
- C CLOSED LOOP GEOTHERMAL 6 bores x 320

APPROXIMATE DEPTH OF WELL: 320 FEET

APPROXIMATE DIAMETER OF WELL: 6 NEAREST INCH

METHOD OF DRILLING (circle one)

BORED (or Augered) | JETTED | Jetted & DRIVEN

AIR-ROTary | AIR-PERcussion | ROTARY (Hydraulic Rotary)

CABLE | REVerse-ROTary | DRive-POINT

other

REPLACEMENT OR DEEPENED WELLS (CIRCLE APPROPRIATE BOX)

- N THIS WELL WILL NOT REPLACE AN EXISTING WELL
- Y THIS WELL WILL REPLACE A WELL THAT WILL BE ABANDONED AND SEALED
- S THIS WELL WILL REPLACE A WELL THAT WILL BE USED AS A STANDBY-CONTACT LOCAL APPROVING AUTHORITY FOR POLICY ON STANDBY WELLS
- D THIS WELL WILL DEEPEN AN EXISTING WELL

PERMIT NUMBER OF WELL TO BE REPLACED OR DEEPENED (IF AVAILABLE)

Not to be filled in by driller (MDE OR COUNTY USE ONLY)

APPROP. PERMIT NUMBER ------G--

PERMIT No. Ho-95-2398

B 3 LOCATION OF WELL

Howard (COUNTY)

Eagle Point Landing (SUBDIVISION)

SECTION LOT 6

DATA (NEAREST TOWN)

B 4

SOURCES OF DRILLING WATER
1. Well
2.
3.

5312 Aerie ct (STREET ADDRESS)

ON WHICH SIDE OF ROAD (CIRCLE APPROPRIATE BOX): NORTH N, WEST W, EAST E, SOUTH S — 5, E

DISTANCE FROM ROAD: 350 ENTER FT OR MI: F

TAX MAP: 28 BLK: 15 PARCEL: 388

NOT TO BE FILLED IN BY DRILLER
HEALTH DEPARTMENT APPROVAL

Howard (13) A537379 (COUNTY NAME, COUNTY NO.)

STATE SIGNATURE _____ INSERT S

DATE ISSUED 9/24/2012 Bruce Butler 9/26/2013 (CO SIGNATURE, EXP. DATE)

PROPOSED LOCATION OF WELL ON LOT
SHOW PERMANENT STRUCTURES SUCH AS BUILDINGS, SEPTIC SYSTEM, ROADS AND/OR LANDMARKS AND INDICATE NOT LESS THAN TWO DISTANCE MEASUREMENTS TO WELL

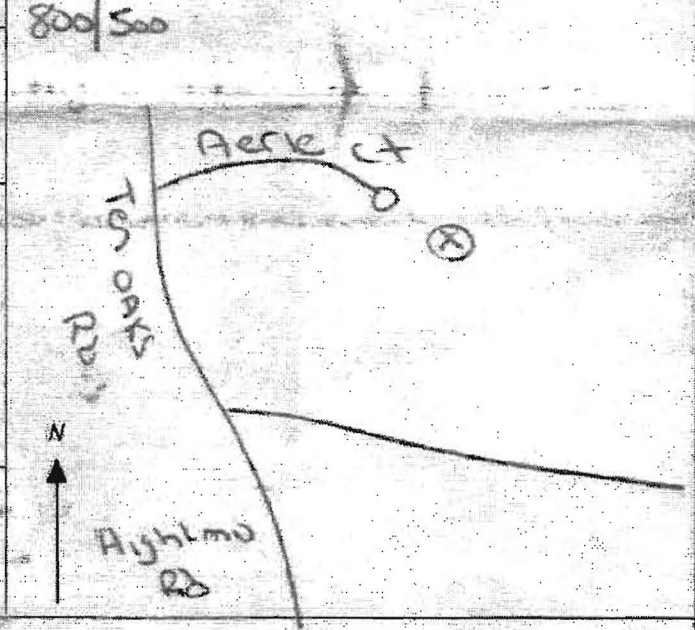

SPECIAL CONDITIONS
NOTE: APPROVING AUTHORITIES SHOULD USE SEPARATE SHEET IF NEEDED

MDE/WMA/PER:071

DRILLER

M12000959

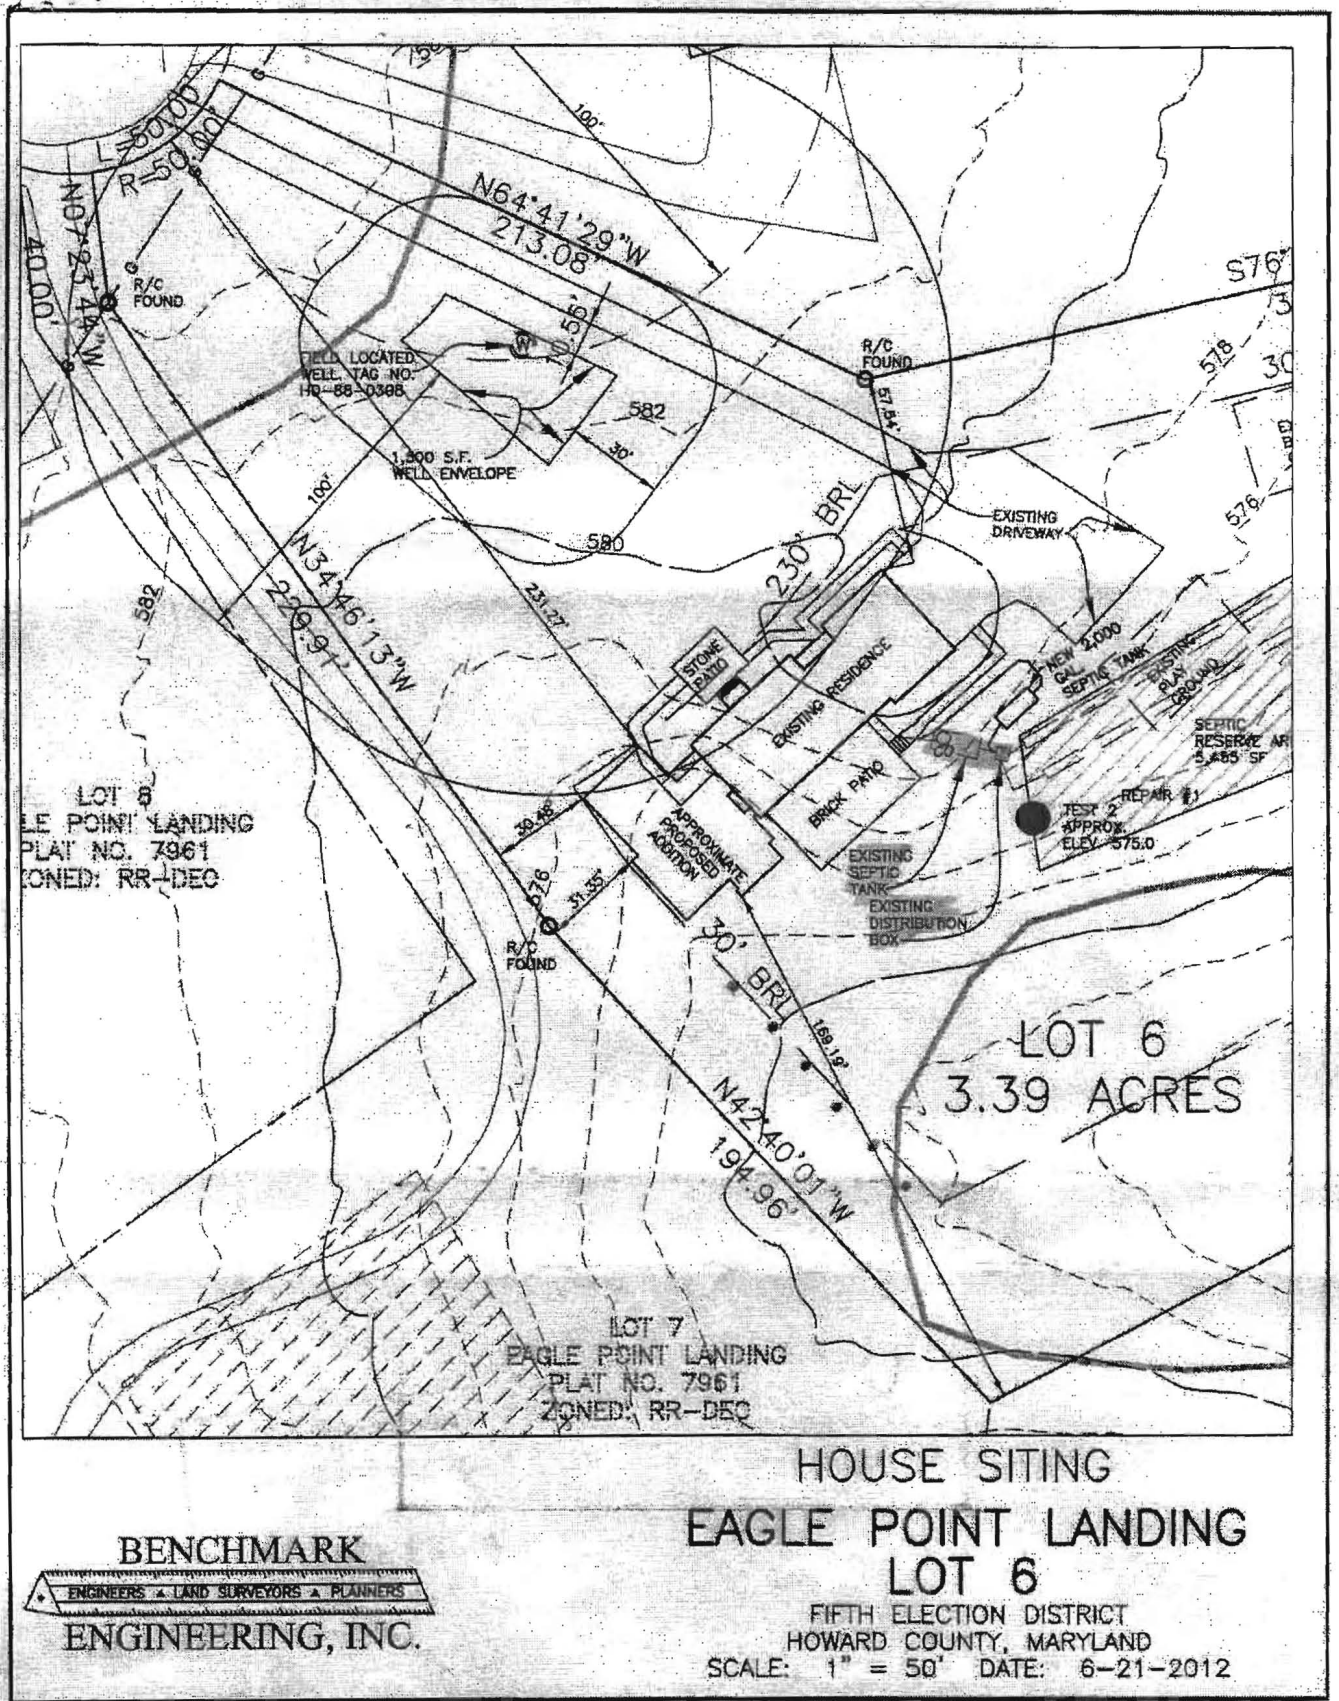

HOUSE SITING

EAGLE POINT LANDING

LOT 6

FIFTH ELECTION DISTRICT
HOWARD COUNTY, MARYLAND
SCALE: 1" = 50' DATE: 6-21-2012

BENCHMARK
ENGINEERS ▲ LAND SURVEYORS ▲ PLANNERS
ENGINEERING, INC.

Geo bores