PRELIMINARY

APPLICATION

A 20271

P

SEWAGE DISPOSAL TESTING

STATE OF MARYLAND - DEPARTMENT OF HEALTH AND MENTAL HYGIENE

HOWARD COUNTY HEALTH DEPARTMENT
ENVIRONMENTAL HEALTH SERVICES
P. O. BOX 476, ELLICOTT CITY, MARYLAND 21043
TELEPHONE: 465-5000, EXT. 336

DISTRICT 1st

DATE 6/28/74

Uphill Neighbor 4835 Wharf Lane

TO: THE COUNTY HEALTH OFFICER
ELLICOTT CITY, MARYLAND

I, HEREBY, APPLY FOR THE NECESSARY TEST IN ORDER TO CONSTRUCT (OR RECONSTRUCT) A SEWAGE DISPOSAL SYSTEM.

PROPERTY OWNER Earl H. Heckman

ADDRESS 4688 Beechwood Road, Ellicott City, Md. PHONE 744-8726

PROPERTY LOCATION:

SUBDIVISION _____ LOT NO. Parcel #2

ROAD AND DESCRIPTION Wharff Lane

SIZE OF LOT 5 acres ± TYPE BLDG. 3 or 4 bedrooms
NUMBER OF BEDROOMS

IF NOT SINGLE RESIDENCE DESCRIBE _____

THE SYSTEM INSTALLED UNDER THIS APPLICATION IS ACCEPTABLE ONLY UNTIL PUBLIC FACILITIES BECOME AVAILABLE.

SIGNATURE OF APPLICANT X /s/ Bettie J. Heckman

APPROVED BY _____ FOR _____ DATE _____
(KIND OF SYSTEM)

REJECTED BY _____ FOR _____ DATE _____
(KIND OF SYSTEM)

HOLD PENDING FURTHER TESTS _____ DATE _____

REASONS FOR REJECTION OR HOLDING _____

THIS IS NOT A PERMIT

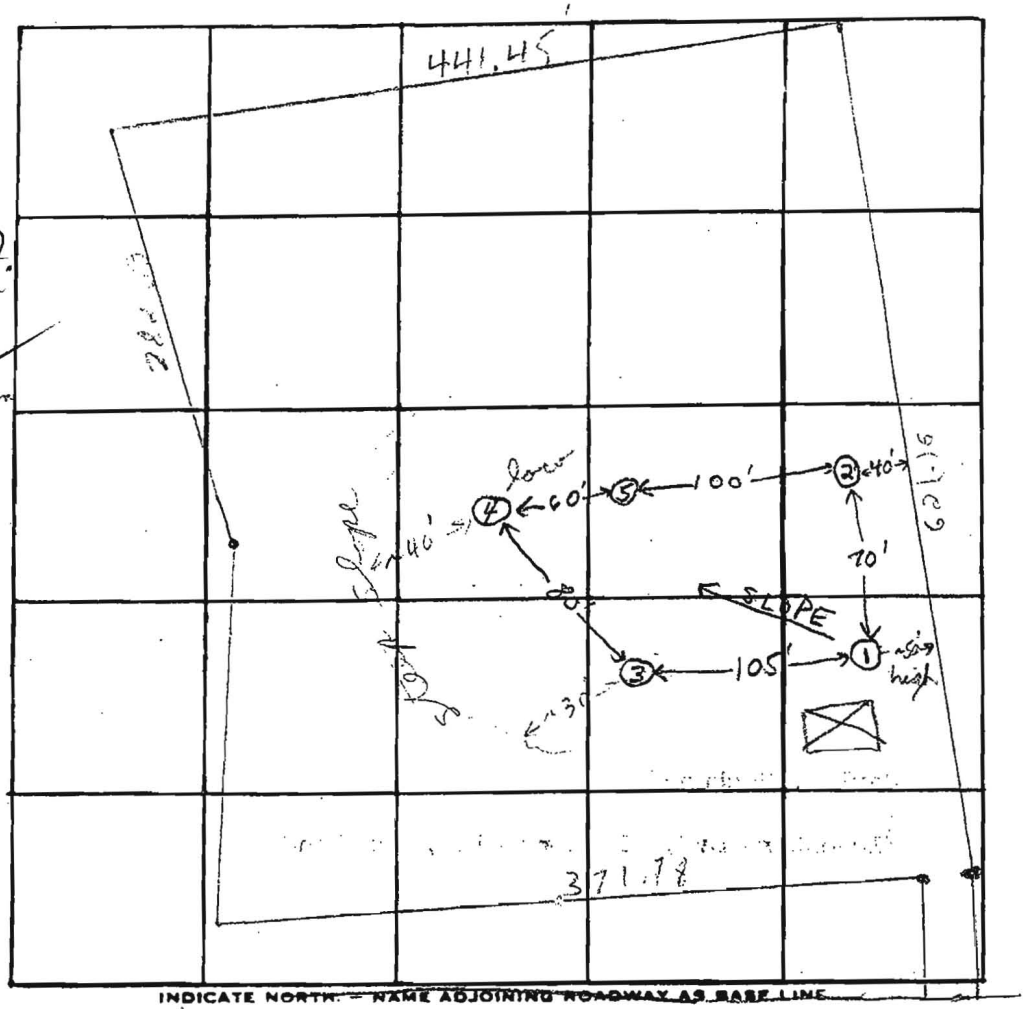

4831 Wharfe Lane

DATE	TEST NO.	DEPTH	PRE-WET START	PRE-WET STOP	TEST - 1" DROP START	TEST - 1" DROP STOP	TIME
	1	4½'	11:20	11:21	11:21	11:24	3 min
	1A	11'	11:26	11:33	11:33	11:44	11 min
	2	4	Visual	clay to 4½'			7 min org
	3	3'	11:48	11:49	11:49	11:54	2 min
	3A	11½	11:48	11:58	11:58	12:15	17 min
	4 lower	3½"	11:58	12:00	12:00	12:02	2 min
	4A	2'	12:07	12:11	12:11	12:18	7 min
	5	4½					

Inlet 4½'

REMARKS ⑤ elevation 9' lower than ② · ⑤ is 3' lower than 4 Hold for certified hole

TYPE OF SOIL Sandy loam ? top 3' clayey

TESTED BY E.S. & H.Z. ALSO PRESENT: R. Lowe