



PLOT PLAN

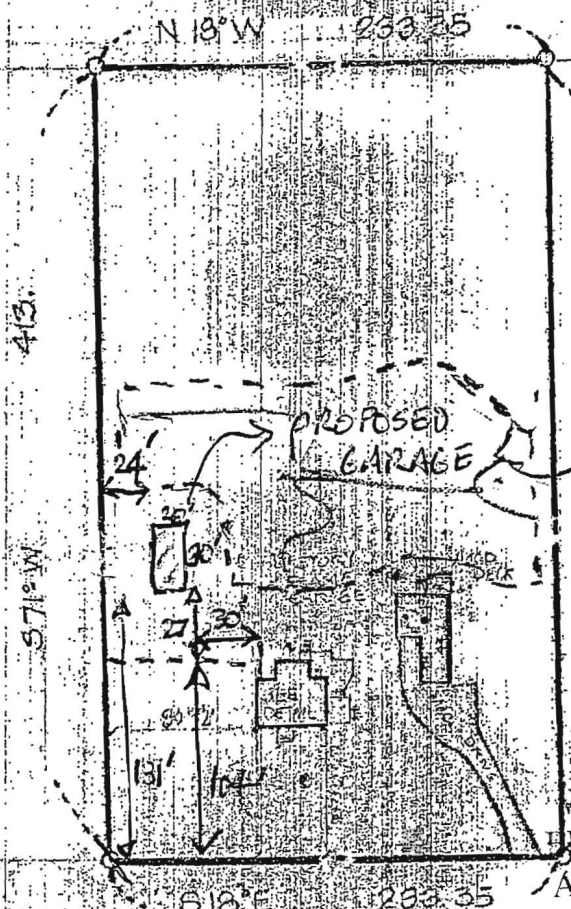

Potential Area for proposed Septic Tank

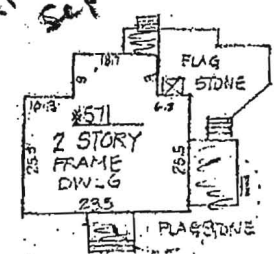

HOUSE DETAIL
1" = 40'

APPROVED
WALK-THRU BUILDING PERMIT

APP. SAN # Bucher DATE: 12/2/2010
DESC. OF WORK: 20' x 30' Garage
(detached) approved as shown

DEER HILL ROAD

Subject property is shown in Zone _____
on the National Flood Insurance Program
Flood Insurance Rate Map of _____
County, Maryland. Parcel # 9 OF 45
Continuity Parcel # QUADQU 60091B
Effective Date: 1/1/96

LIBERTY 2218 FOLIO 361
PROPERTY SUBJECT TO SAVINGS & EXCEPTING SHOWING ON STATE ROADS COMMISSION PLATS NO. _____
#1729 AND #18800

- 1) The plat is of benefit to a consumer only insofar as it is required by a lender or a title insurance company or its agent in connection with contemplated transfer, financing or re-financing;
- 2) The plat is not to be relied upon for the establishment or location of fences, garages, building, or other existing or future improvements;
- 3) The plat does not provide for the accurate identification of property boundary lines, but such identification may not be required for the transfer of title or securing financing or re-financing.

CASE NO. 63783 LL



LOCATION DRAWING		SCALE: <u>1"=100'</u>
#571 DEER HILL ROAD, HOWARD CO. MD.		DATE: <u>2-27-01</u>
JOHN C. MELLEMA SR., INC. LAND SURVEYORS		JOB NO: <u>0158</u>
5409 EAST DRIVE · BALTIMORE, MARYLAND 21227 · (410)247-7488		