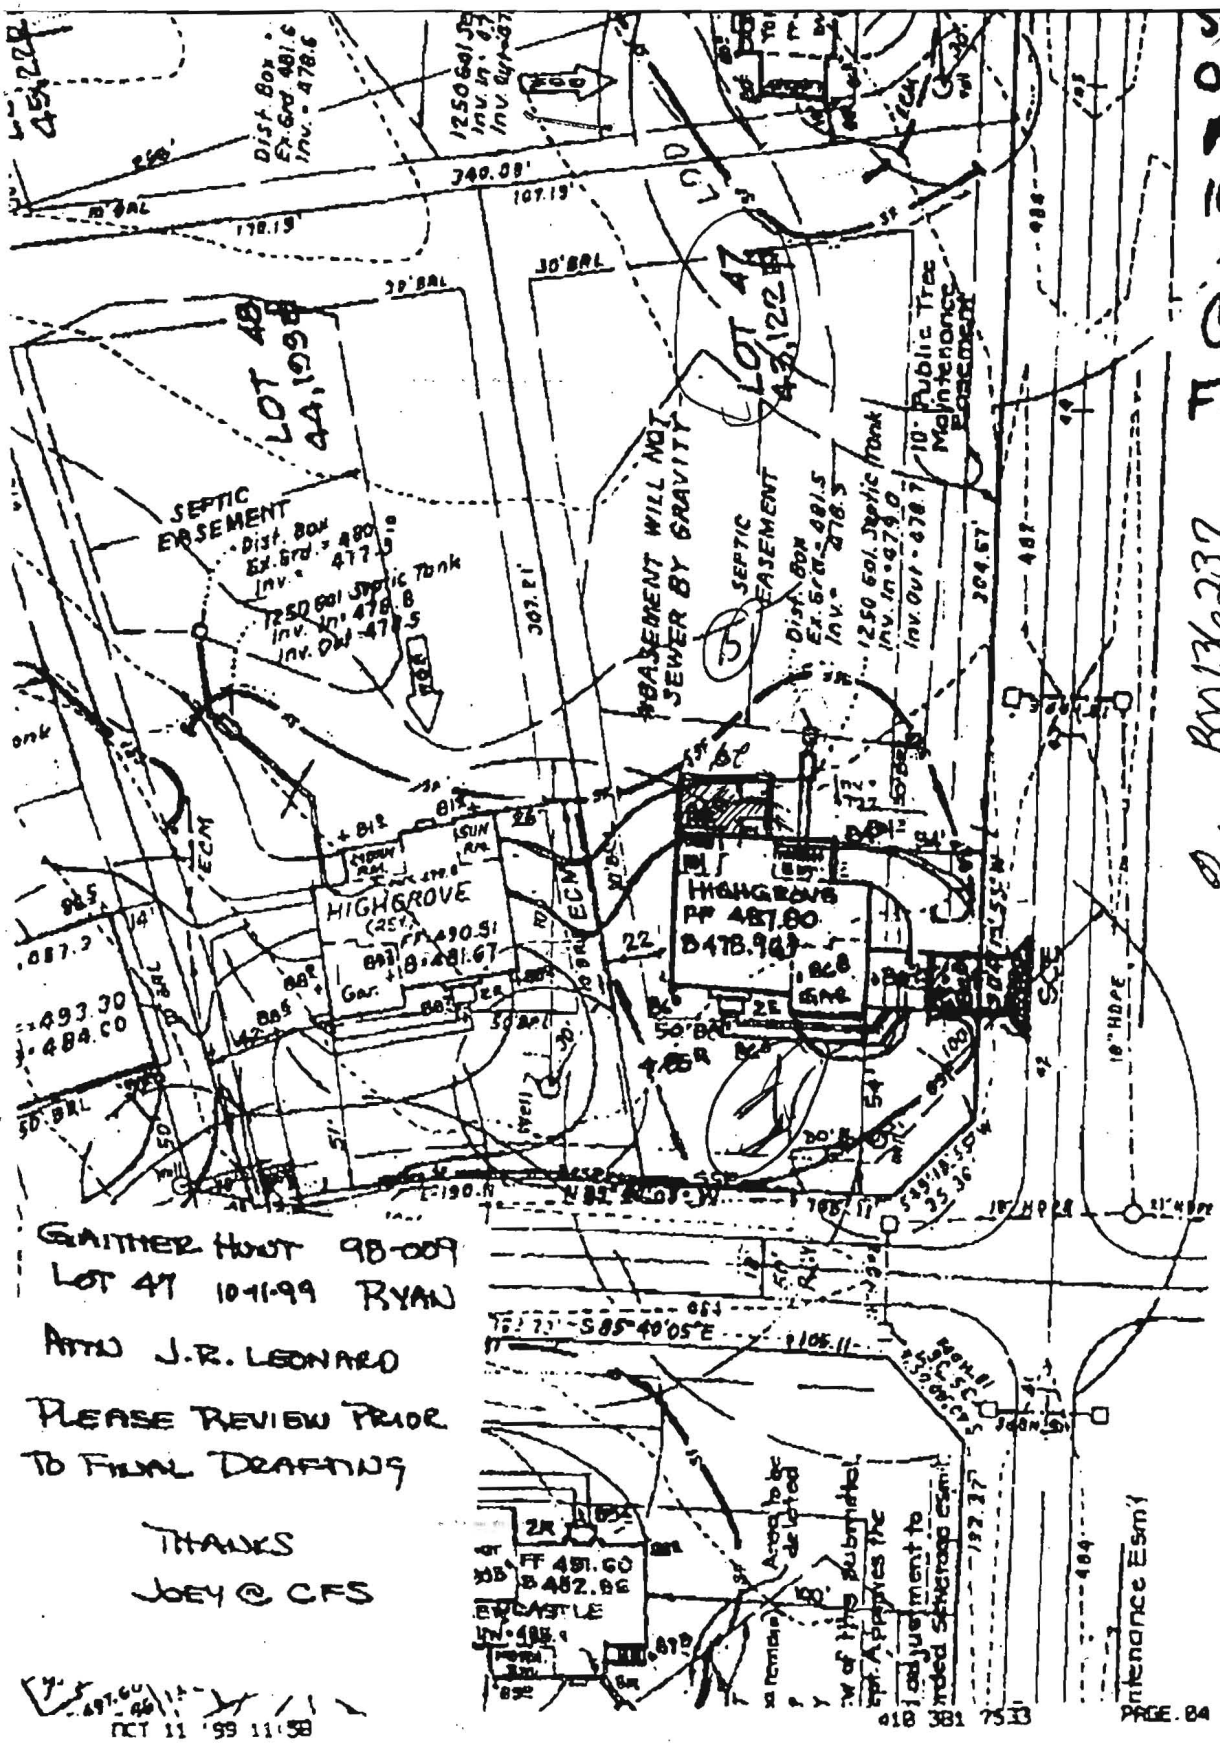

SIGNED OFF MAP 10/12/99

Cust FILE

BOO 136 237
DEED OK'D
GM 5/16/02

GAITHER HUNT 98-009
LOT 47 10-11-99 RYAN
ATTN J.R. LEONARD
PLEASE REVIEW PRIOR
TO FINAL DRAFTING
THANKS
JOEY @ CFS

OCT 11 '99 11:58 618 381 7533 PAGE.04

** TOTAL PAGE.02 **

TOTAL P.02

MAY-08-2002 11:18 V. H. YOUN 618 561 0001 P.01