MEIJER RESIDENCE
3541 HIPSLEY MILL RD

PRECISION POOLS

1\60 SCALE

NOTES

1. ALL EXISTING WELLS ON THE SUBJECT PROPERTY AND WITHIN 100 FEET OF SUBJECT PROPERTY BOUNDARIES ARE REPRESENTED TO THE BEST OF MY KNOWLEDGE AND BELIEF.
2. THE EXISTING WELL ON THE SUBJECT PROPERTY (HO-95-1919) WAS FIELD LOCATED BY CHARLES R. CROCKEN & ASSOCIATES, INC., IS ACCURATELY SHOWN.
3. TOPOGRAPHY IS FROM SURVEY CONDUCTED BY CHARLES R. CROCKEN & ASSOCIATES, INC. (CA. 2010 - 2012) AND PRESENTED ON THIS PLAT SUBMITTED AS A PLOT PLAN FOR CONSTRUCTION OF THE RESIDENCE IN 2012. THE TOPOGRAPHY PRESENTED ON THIS PLAN ACCURATELY REPRESENTS THE RELATIVE ELEVATION CHANGES ON AND NEAR THE SUBJECT PROPERTY.
4. THE LOT SHOWN HEREON COMPLIES WITH THE MINIMUM OWNERSHIP WIDTH AND LOT AREA AS REQUIRED BY THE MARYLAND DEPARTMENT OF ENVIRONMENT.
5. ANY CHANGES TO A PRIVATE SEWAGE EASEMENT SHALL REQUIRE A REVISED PERCOLATION CERTIFICATION PLAN.
6. THE PURPOSE FOR THIS PERCOLATION CERTIFICATION PLAN IS TO CERTIFY THE RELOCATION FOR ONE OF TWO ALTERNATE WELL LOCATIONS, AND THE ABANDONMENT OF A PREVIOUSLY APPROVED ALTERNATE WELL LOCATION, IN ANTICIPATION OF A PROPOSAL TO CONSTRUCT AN INGROUND POOL AT 3541 HIPSLEY MILL ROAD.

AS I HAVE EDITED THE PLOT PLAN PREPARED BY CHARLES R. CROCKEN AND ASSOCIATES, INC., I CERTIFY THAT THE ADDITIONAL INFORMATION SHOWN HEREON IS BASED ON WORK PERFORMED IN MY PRESENCE OR BY MY DIRECTION, AND IS CORRECT TO THE BEST OF MY KNOWLEDGE AND BELIEF.

Daren Harlamp 9/20/15

(SIGNATURE) (DATE)

APPROVED FOR PRIVATE WATER AND PRIVATE SEWERAGE SYSTEMS
HOWARD COUNTY HEALTH DEPARTMENT

BWilson for Maura Rossman 10/9/2015

(SIGNATURE) (DATE)

TITLE: PERCOLATION CERTIFICATION PLAN, "3541 HIPSLEY MILL ROAD"

OWNER
ADDRESS
PHONE
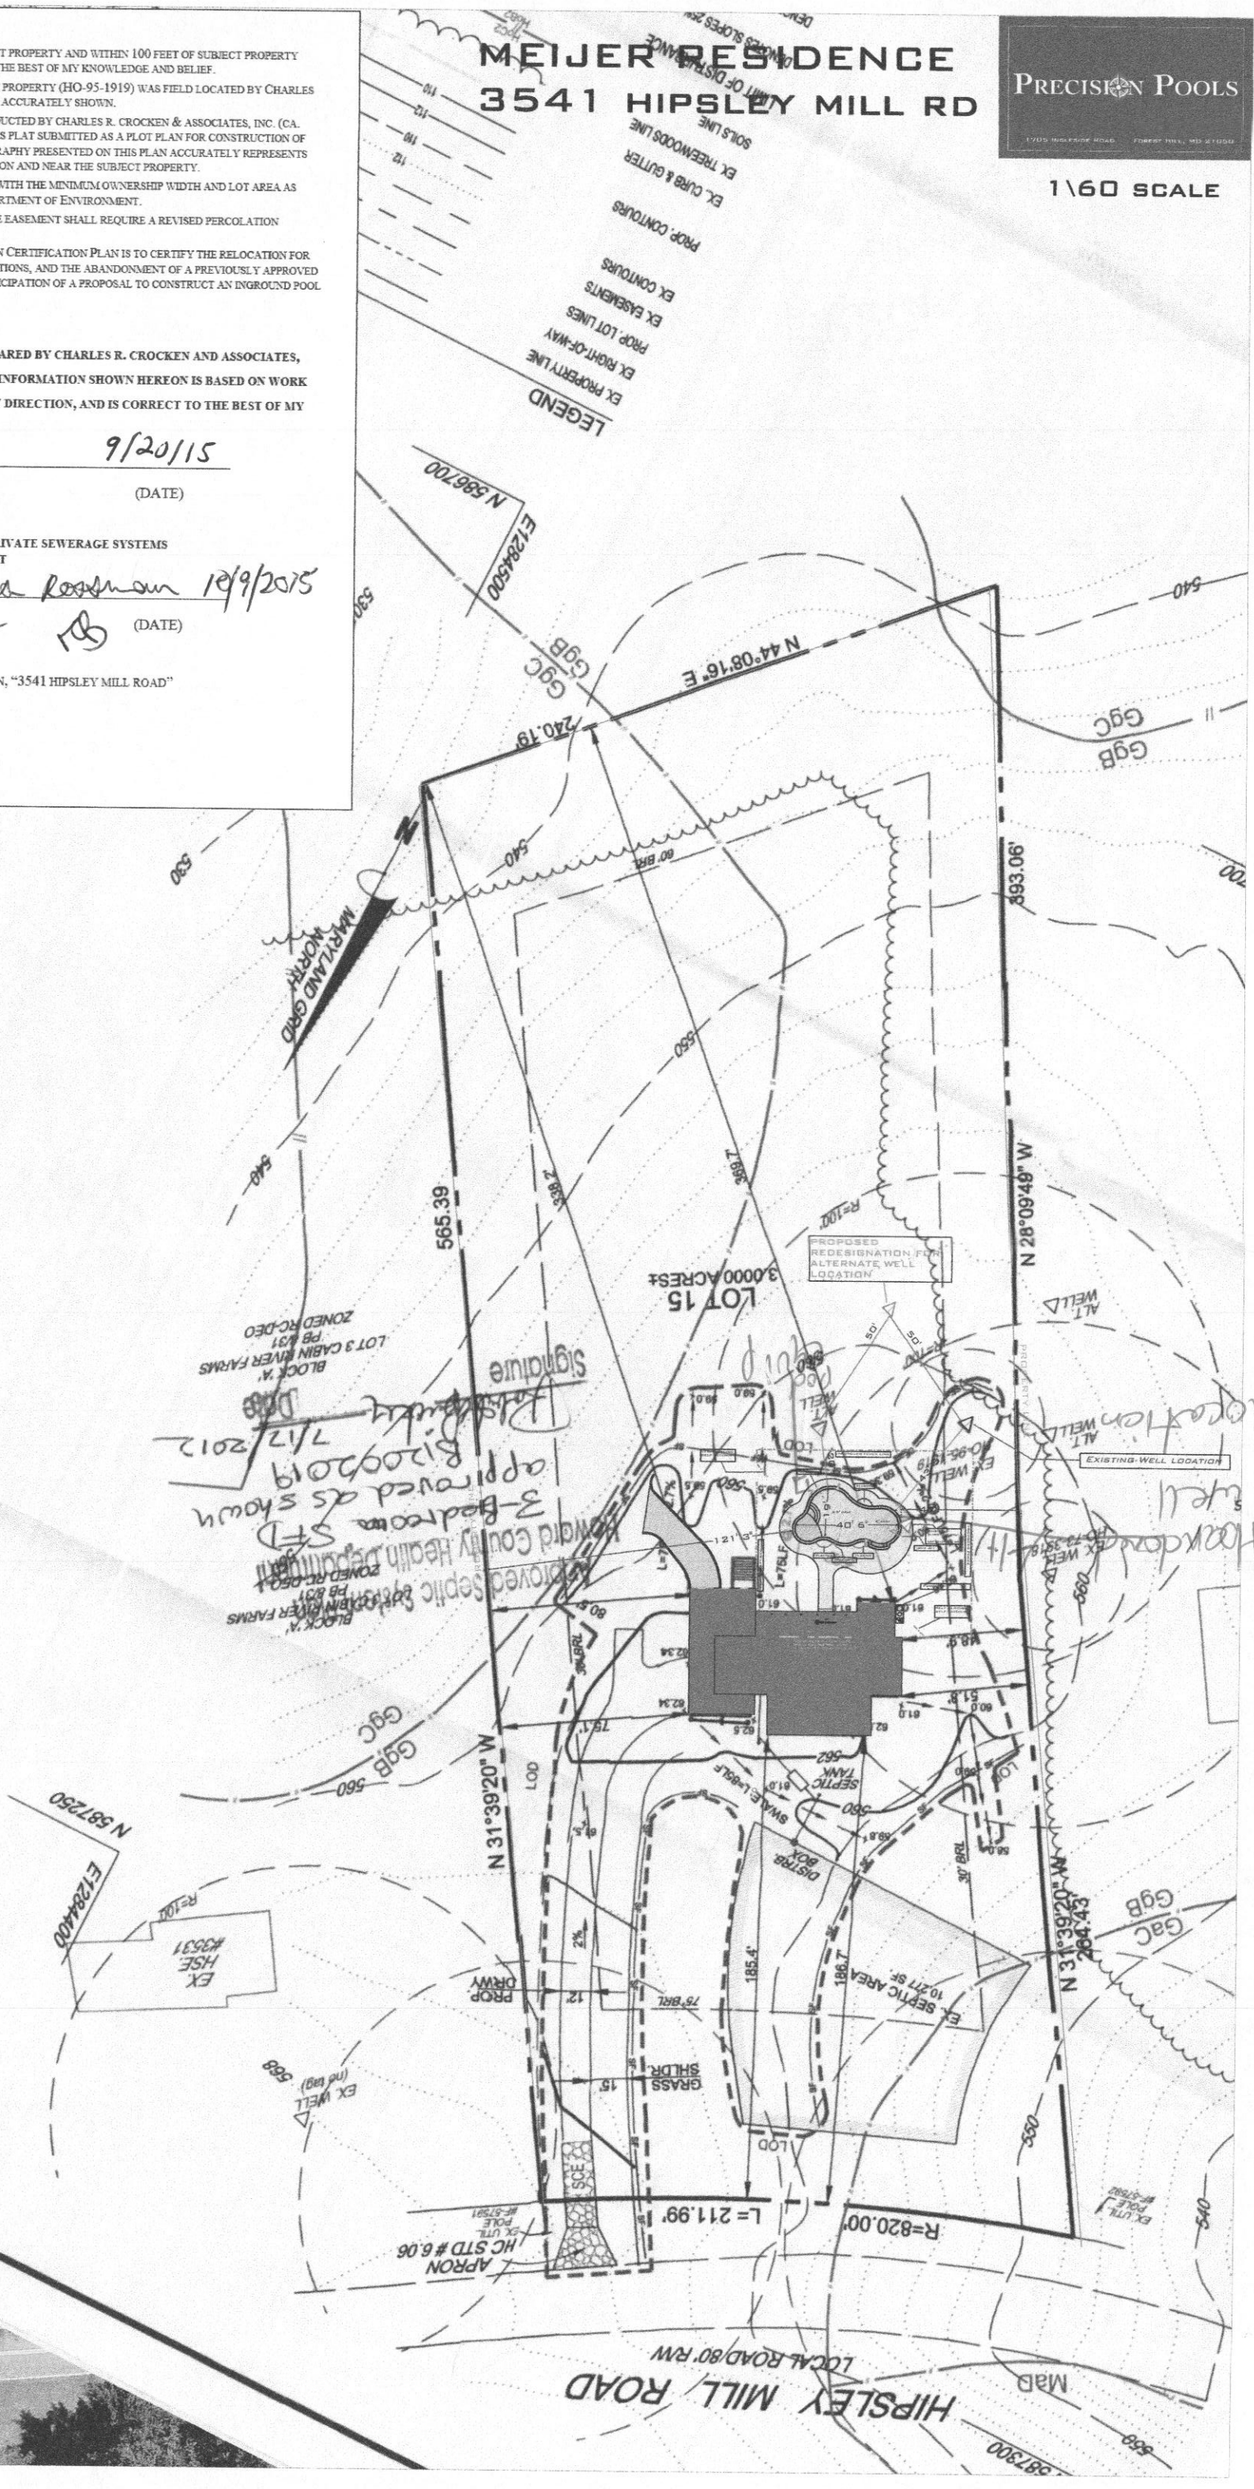
LEGEND